

WEST MILFORD HEALTH DEPARTMENT


1480 Union Valley Road - West Milford NJ 07480

Tel: 973-728-2720

Fax: 973-728-2847

APPLICATION FOR HEALTH DEPARTMENT REVIEW
OF BUILDING DEPARTMENT PERMIT FOR
EXISTING RESIDENTIAL DWELLING

Homeowner's Name Odafalla Amad Odafalla Tel# [REDACTED]
Location 1108 Macopin Road West Milford NJ
Block 10202 Lot 1 Single family X Multiple units
Existing number of bedrooms 2
* Number of proposed additional bedrooms 0 (CR)
** Proposed expansion attic? yes no X
Are any cantilevers proposed? yes no
Describe proposed work New Kitchen, Bathroom
Floors, Painting, and Deck Step

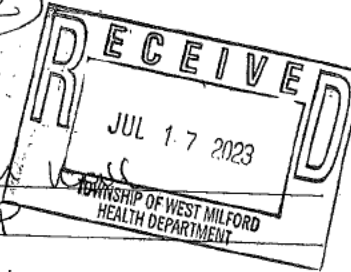

Please attach the existing and proposed floor plan and a site plan locating the existing septic tank, septic field and existing well.

* Per N.J.A.C. 7:9A-2.1 defines a bedroom as "any room within a dwelling unit, finished or unfinished, which may reasonably be expected to serve primarily as a bedroom or dormitory. The term bedroom shall be considered to include any room or rooms within an expansion attic." This reasonable definition has been expanded to include definitions used by the Dept. of Community Affairs in various building codes. Additional information may be obtained from the Dept. of Community Affairs website at <http://www.state.nj.us/dca/codes/rehab/>. Therefore, any room that the administrative authority feels can reasonably be used as a bedroom, can be required to be counted for the determination of the volume of sanitary sewage for design flow purposes, regardless of what the room is labeled on engineering or architectural plans.

** Per N.J.A.C. 7:9A-2.1; "Expansion attic means that part of a dwelling unit left unfinished but which is capable of being finished as a bedroom or bedrooms and which is accessible by permanent stairways or designed so that stairways can be installed."

Homeowner's signature [Signature] Date 07/17/2023

FOR AGENCY USE ONLY

☒ Application Approved

☐ Application Denied

Reason for Denial

Date of Action 7/25/23 Signature of Authorized Agent [Signature]

Name & Title Angelee Wedderburn REHS

VIII. PRIOR APPROVALS CHECKLIST (office use only)	LOCAL APPROVAL		COUNTY APPROVAL		REGIONAL APPROVAL		STATE APPROVAL		COMMENTS
	Prelimin. Initial	Final Date	Prelimin. Initial	Final Date	Prelimin. Initial	Final Date	Prelimin. Initial	Final Date	
☐ Zoning Officer									
☐ Planning Board									
☐ Zoning Board									
☐ Sewer Authority									
☐ Water Authority									
☐ Police Department									
☒ Health Department	AW	7/25/23	Approved for new kitchen, Bathroom, Wall floor, Painting, and deck steps only.						
☐ Soil Conservation									
☐ N.J. Department of Community Affairs									
☐ N.J. Department of Transportation									
☐ N.J. Department of Environmental Protection									
☐ Utility Dig No.									
☐									
☐									

IX. SUBCODES AND SPECIAL REGULATIONS APPLICABLE (office use only—optional)

Name of Code & Edition

Name of Code & Edition

Building _____

Energy _____

Other _____

Electrical _____

Barrier Free _____

Plumbing _____

Flood Hazard _____

Fire Protection _____

As Built Elevation Cert. _____

Mechanical _____

Other _____


X. CERTIFICATES ISSUED (office use only)

	No.	DATE ISSUED	DATE EXPIRED	DATE REISSUED	DATE EXPIRED
☐ Temporary Certificate of Occupancy	_____	_____	_____	_____	_____
☐ Temporary Certificate of Compliance	_____	_____	_____	_____	_____
☐ Continued Certificate of Occupancy	_____	_____	_____	_____	_____
☐ Certificate of Compliance	_____	_____	_____	_____	_____
☐ Certificate of Occupancy	_____	_____	_____	_____	_____
☐ Certificate of Approval	_____	_____	_____	_____	_____
☐ Lead Abatement Clearance Certificate	_____	_____	_____	_____	_____

BUILDING OFFSETS NOT TO BE USED FOR CONSTRUCTION OF FENCES OR OTHER PERMANENT STRUCTURES.
LOCATION SURVEY - STAKES NOT REQUESTED. SUBJECT TO ALL EASEMENTS AND RIGHT OF WAYS OF RECORD.

PLANNING DEPARTMENT
WEST MILFORD TOWNSHIP

NEW LOT 1
NEW BLOCK 10202

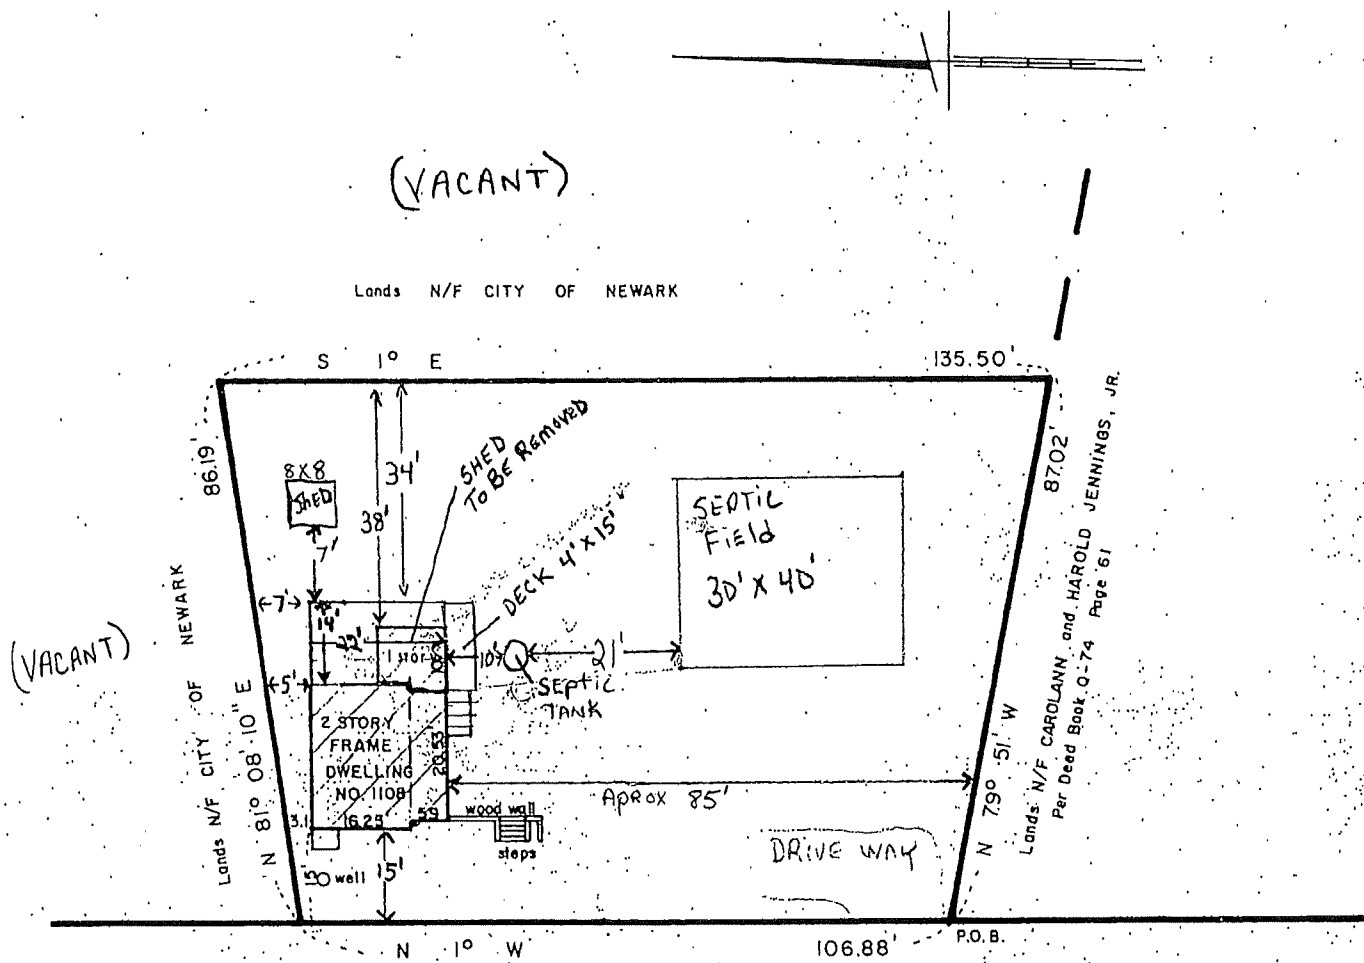


MACOPIN ROAD

TO ALL PARTIES IN CURRENT INTEREST IN TITLE TO THESE PREMISES TICOR TITLE INSURANCE COMPANY, COLONIAL TITLE AND ABSTRACT SERVICE, NATHANIEL F. BEDFORD, ESQ., AND MORTGAGE SERVICES OF AMERICA, and/or its Assignees.		SURVEY MAP PREPARED FOR AND CERTIFIED TO	
THIS IS TO CERTIFY THAT THIS SURVEY IS ACCURATE, AND THAT THIS DRAWING IS A TRUE REPRESENTATION OF ACTUAL CONDITIONS EXISTING ON THE PROPERTY. THIS SURVEY IS PREPARED SPECIFICALLY FOR THE INDIVIDUAL(S) IN THE TITLE AND/OR THE CERTIFICATION. THE UNDERSIGNED WILL NOT BE RESPONSIBLE OR LIABLE FOR ANY ASSIGNMENT OF THIS SURVEY, THROUGH A SURVEY AFFIDAVIT TO ANY PERSON NOT SO NAMED.		ALVIN G. PALMER AND ANGELINA PALMER	
DATED JUNE 13, 1984 Checked To Date 4-9-88.		TOWNSHIP OF WEST MILFORD PASSAIC COUNTY NEW JERSEY	
JOHN HOOYMAN, JR. N.J. LICENSED LAND SURVEYOR NO. 13921		SCALE 1" = 30'	
		BOOK H 79 PAGE 15	
		JOHN HOOYMAN, JR. HOOYMAN SURVEYING ASSOCIATES 15 WALNUT STREET MAHWAH, N.J. 201-891-4340	




S1°00'00"E 135.50'

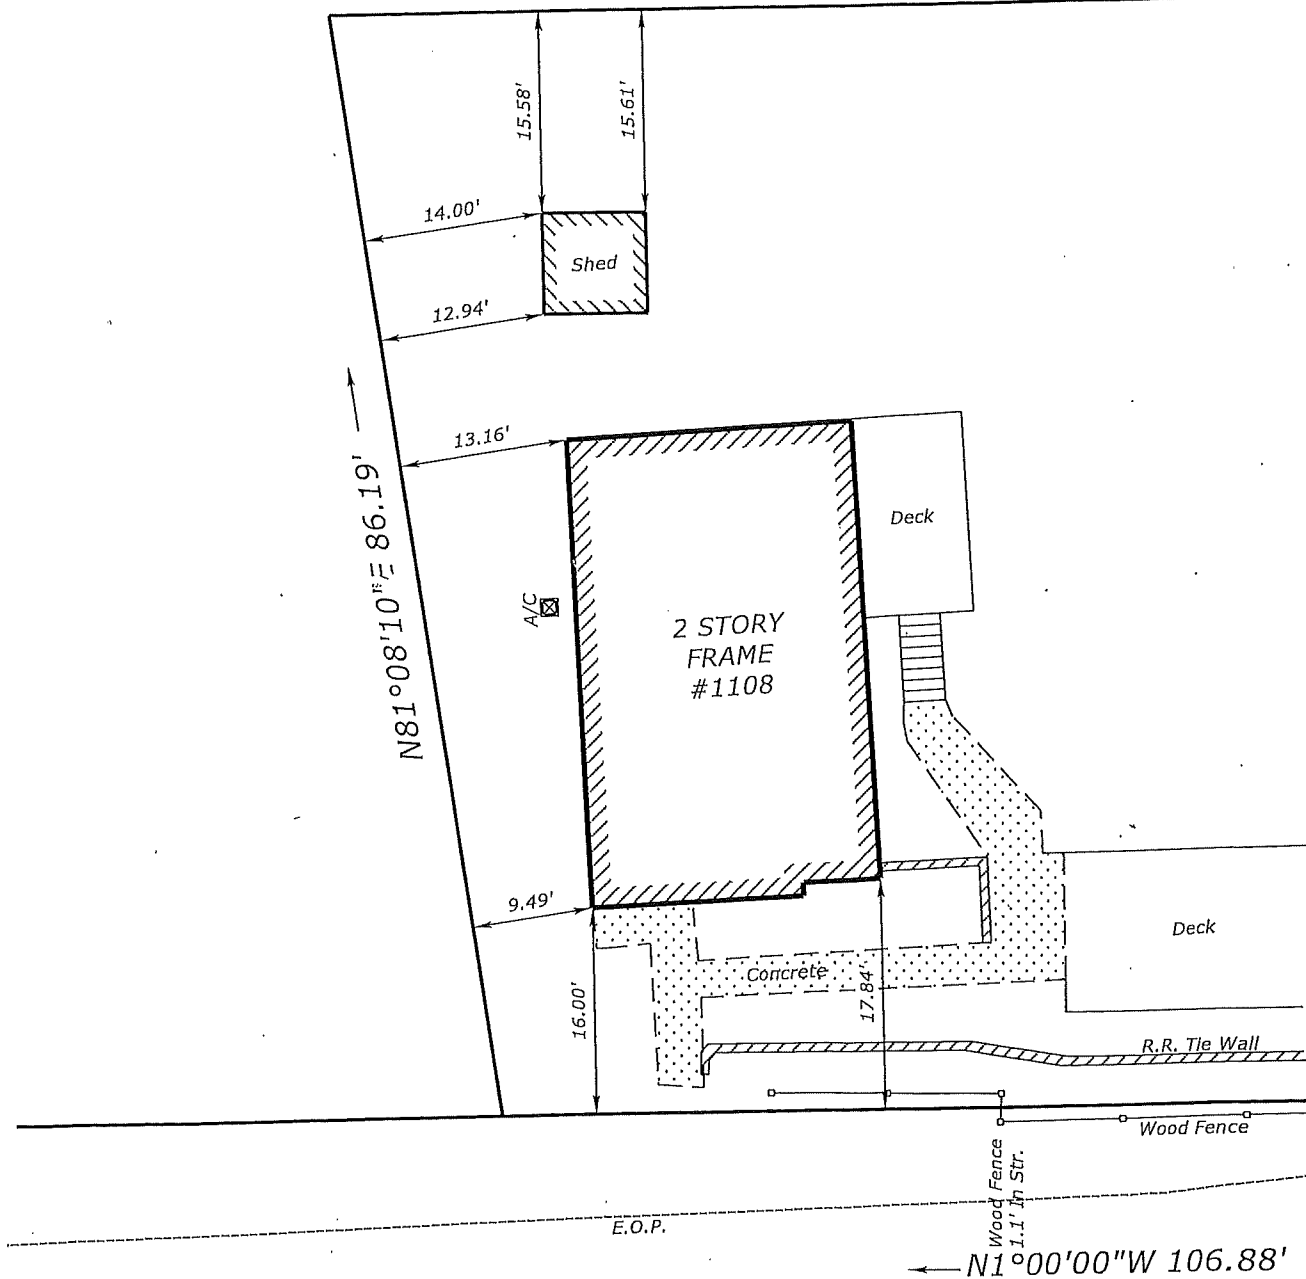

This certification is made only to the named parties for purchase and/or mortgage or herein delineate property by the named purchaser/owner. No responsibility is assumed by the Surveyor for use of survey for any other purpose including, but not limited to use of survey for survey affidavit, resale of property, or to any other person listed in certification, either directly or indirectly.

MACOPIN

(50' R.O.)

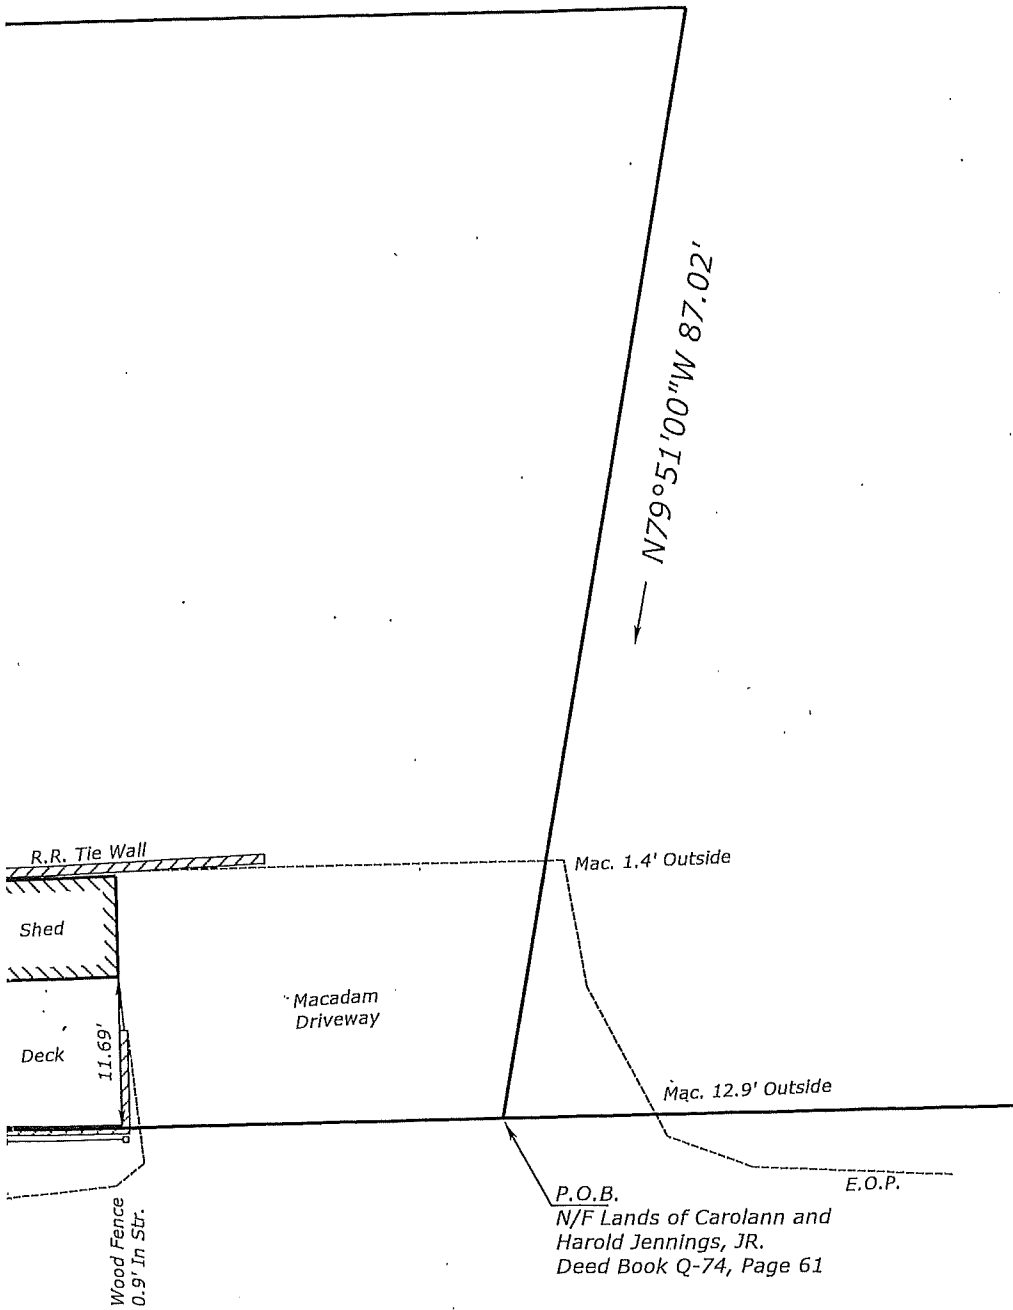

ROAD

Property Corners Omitted By Contractual Agreement
 Certified to: 349 Lakeview Ave, LLC

Lot 1 Block 10202 on the Township of West Milford Tax Map
 Date - Location Survey - May 16, 2022
 Drawn By - PC
 Scale - 1" = 15'
 Checked By - GJA

Map Of Property Situated At:
 1108 Macopin Road in the Township of
 West Milford, Passaic County, New Jersey



P.O. Box 430 Saddle Brook, NJ 07663
 O - 201.291.0950 F - 201.291.0953
 bullseyesurveying@gmail.com

George J. Anderson
 GEORGE J. ANDERSON
 LIC. No. 36706
 NJ COA 24GA28142500