

NOTE:
Halfway of setting corner
markers obtained from ultimate
user, pursuant to the Board of
Professional Engineers and Land
Surveyors regulation, N.J.A.C.
13:40-5.1(d).

FRANK J. FALCONE
N.J. LICENSED LAND SURVEYOR # 32112 & P.E. PLANNER # 3760



PRINCETON JCT. ENGINEERING P.C.
PROFESSIONAL ENGINEERS & LAND SURVEYORS
P.O. BOX 223 NORTH POST RD.
PRINCETON JUNCTION, NEW JERSEY 08550
(609) 799 1906 (609) 799 1963

BYRON M. RITTENHOUSE
ARNOLD RYDEN JR.
D. GEOFFREY BROWN
WESLEY J. LANE
FRANK J. FALCONE
P.E. P.L.S.
P.L.S.
P.L.S.
NO. 13453
NO. 21223
NO. 24327
NO. 30747
NO. 32112
DATE 5/11/94
FRANK J. FALCONE: N.J.L.C. 5-#32112 & P.E. #3760

DRAWN 7/14
CHECK
REV.
SCALE 1" = 30'

ASBUILT GRADING PLAN
OF LOT 86, BLOCK 8, FOR:
DAVID & GAIL CAMPBELL

SITUATED IN:
WASHINGTON TWP., MERCER CO., NEW JERSEY.

I hereby certify, this survey was performed under my
direct supervision and I hereby declare, to the best of
my knowledge, information, and belief, and in my
professional opinion this survey to be accurate to:


THIS PLAN IS FOR ENGINEERING
APPROVAL ONLY.

SHEET 5 **BLOCK** 8 **LOT** 86

+112.9 BE NOTED ASBUILT SPOT ELEV.
BE NOTED ASBUILT SURFACE FLOW

TINDALL ROAD
(46.5 FT. WIDE)

B.M.: SS 44
B.M.: 110.22

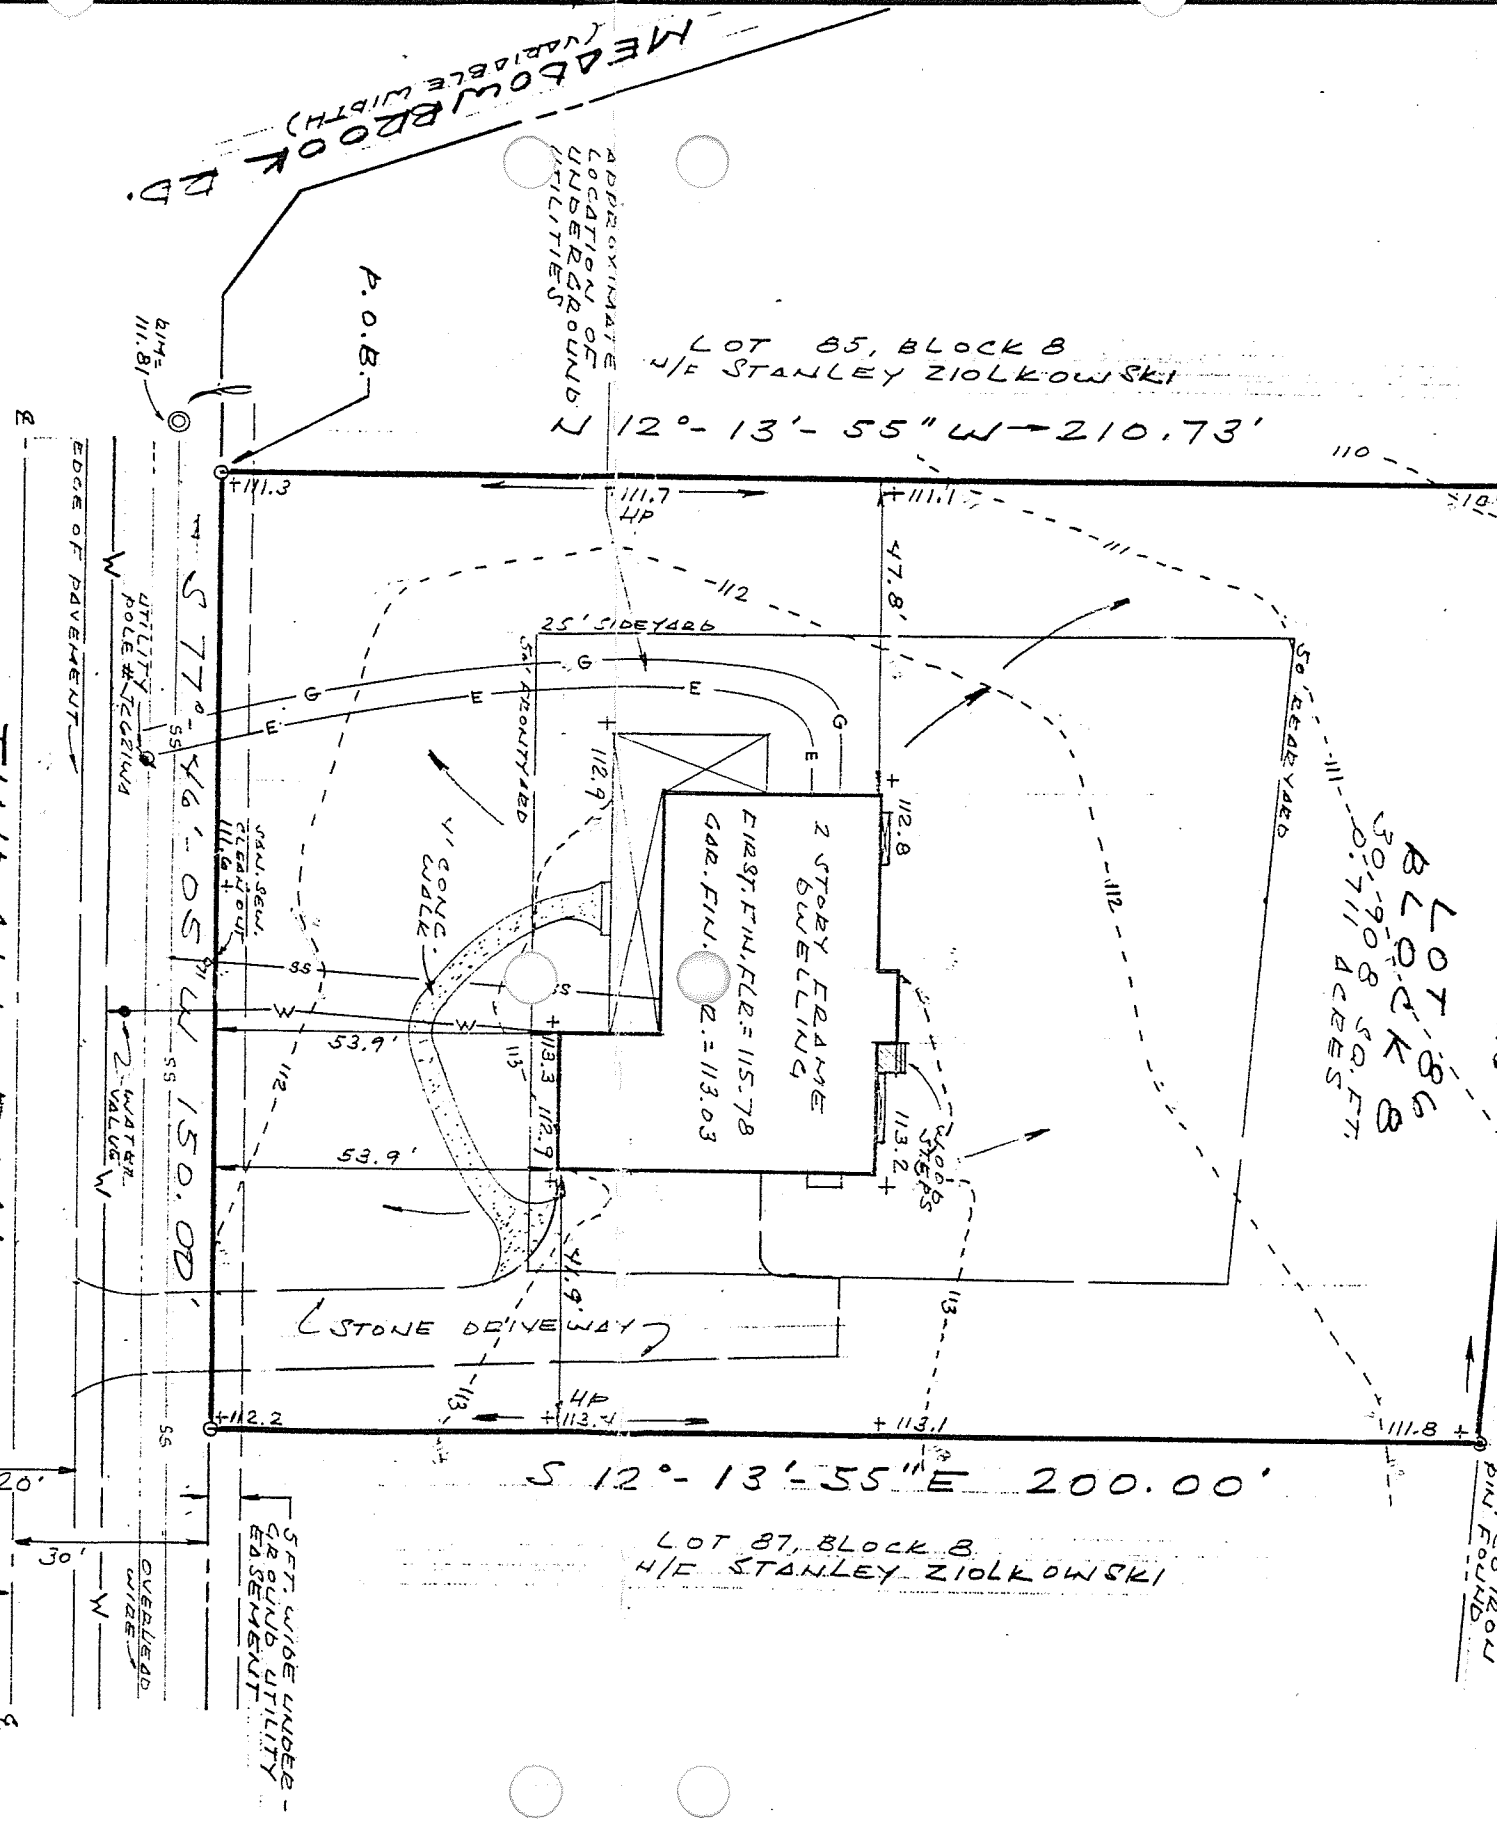

LOT 86
BLOCK 8
30.708 ACRES
0.711 ACRES

LOT 83, BLOCK 8
N/E SEVEN PLUS ONE

LOT 84, BLDG. 8
N/E PLUS ONE

LOT 85, BLOCK 8
N/E STANLEY ZIOLKOWSKI
12°-13'-55" W - 210.73'

LOT 87, BLOCK 8
N/E STANLEY ZIOLKOWSKI
S 12°-13'-55" E 200.00'