


MS 15
Diagram

BLE32 Lot 53-5
RIGHT SIDE of System

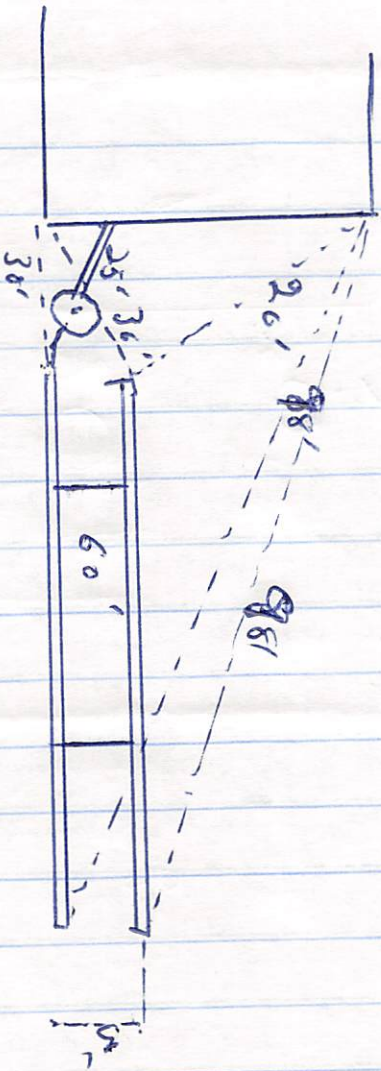

RIGHT Assoc.
4-2-79

Diode
PC 12


Green 205
PC 35
23-2

4-5-11
B511
1200

Left Side System

R1232 & 1 S3-5

ROAD INSIDE

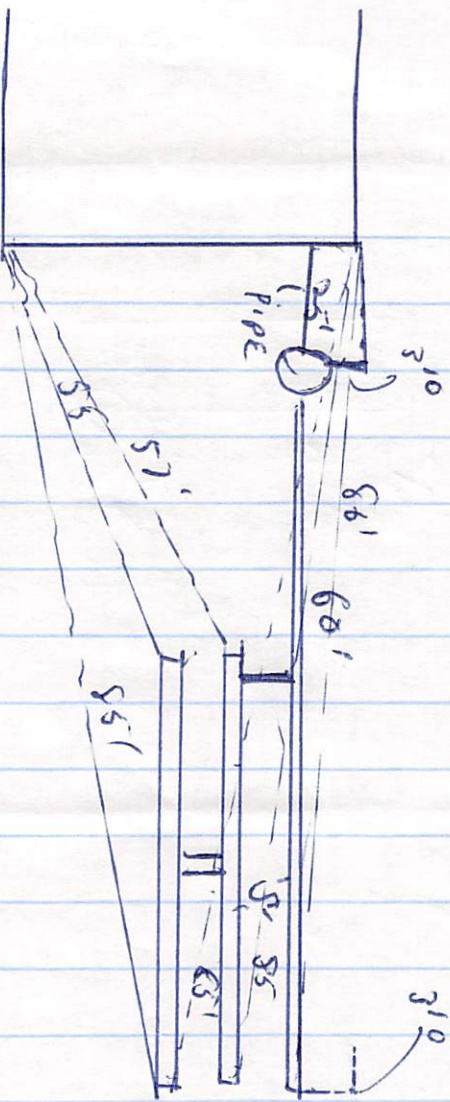

1991 2100 2121100 151531 801 23-2



50151 12240