

12-6-85
Date

No. S-749-85

BOARD OF HEALTH OF Manchester

CERTIFICATE OF COMPLIANCE

Issued to SALVATORE PACE

(Owner of Contractor)

THIS IS TO CERTIFY That the

INDIVIDUAL SEWAGE SYSTEM

INDIVIDUAL WATER SYSTEM

INDIVIDUAL PLUMBING SYSTEM

Installed at Block No. 1-284

Lot. No. 5 is in compliance with the

Application for Permit to Locate and Construct or

Alter Such Systems.

No. 749 dated 12-1-85

The issuance of this certification shall not be construed as a guarantee that the system will function satisfactorily nor shall it in any way restrict the powers or responsibilities of the Board of Health in the enforcement of any law or ordinance relating to public health.

Mary Lou Longwell

1/6/86
Date

No. S-749-85

BOARD OF HEALTH OF Manchester

CERTIFICATE OF COMPLIANCE

Issued to Pace

(Owner of Contractor)

THIS IS TO CERTIFY That the

INDIVIDUAL SEWAGE SYSTEM

INDIVIDUAL WATER SYSTEM pending analysis

Installed at Block No. 1-284

Lot. No. 5 is in compliance with the

Application for Permit to Locate and Construct or

Alter Such Systems.

No. 749 dated 12-1-85

The issuance of this certification shall not be construed as a guarantee that the system will function satisfactorily nor shall it in any way restrict the powers or responsibilities of the Board of Health in the enforcement of any law or ordinance relating to public health.

see attached divider key

Mary Lou Longwell

S-749-85

MUNICIPALITY

Manchester

OCEAN COUNTY

HEALTH DEPARTMENT

COPY

John J. Murphy

William J. Murphy

William J. Murphy

APPLICATION FOR A PERMIT:

to locate and construct an individual Sewage System
to alter or supplement an existing Sewage System

OFFICE USE ONLY

NOV 10 1985
INSPECTION

LOCATION - ADDRESS LAURENCE AVE. BLK. 1-284 LOT SECTION

OWNER Salvatore & Kathryn Pace PHONE 929-8022

PRESENT ADDRESS 1971 Stagewood Road - Jones River

GENERAL CONTRACTOR Marie Pace PHONE 793-2136

DIRECTIONS AND LANDMARKS TO LOCATION CORNER OF LAURENCE & BURNSIDE

TYPE OF BUILDING TO BE SERVED RESID. (OTHER THAN RESIDENTIAL CONSULT HEALTH DEPT.)

DWELLING UNIT: NO. OF BEDROOMS 3 EXPANSION ATTIC, DEN OR REC. ROOM, YES NO

DIMENSIONS OF PROPERTY: 100' X 100' SQUARE FT. OR ACRES 10,000 S.F.

SEPTIC TANK: Shape Round Material Reinf. Conc.

Capacities: Required Gal. 900 Designed for 900 Gals.

DISPOSAL TRENCHES: Width Min. & Max. N/A Depth Min. & Max.

Lineal Ft. of Trenches Distance between Trenches Type of Pipe

Required Square Footage Designed Square Footage

Amount of Stone(in inches) below Above Disposal Pipe

DISPOSAL BED: Width 12' length 30' Disposal Area Sq. Ft. 360

Ft. of Pipe 90 Type of Pipe 4" PERF. Distance between pipe 3.5'

Min. & Max. Depth of Bed 24" Amt. of Stone(in inches) below 18" Above 6" Disposal Pipe

Required Square Ft. 345 Designed Square Ft. 360

SEEPAGE PIT: Number N/A Shape Material

Diameter or Width Liquid Depth Single unit Sq. Ft.

Total Required Sq. Ft. Total Designed Sq. Ft. Amt. Size & Type of Soil

PERCOLATION TESTS

SOIL BORING LOG

HOLE NO.	NO. OF SATURATIONS	DEPTH	PERC. RATE MIN PER IN.
1	2	30"	4

Date Submitted to Health Dept. 9/25/85

Performed by C.B. Rush License No. 21904

Address 805 Main St. Jones River Phone (201) 240-1200

If Witnessed, by whom OCEAN COUNTY HEALTH DEPT.

Date of Tests 9/25/85 Weather Conditions to be Considered FAIR

Installing CONTRACTOR Bruce Sepic Co Phone # 349-0901

OWNERS Signature (Acknowledging design & installer)

OCT 4 1985
OF THE MANCHESTER
BOARD OF HEALTH

SEE
ACCOMPAVING
PLOT

S-749-85

M. Chester Township Health Department
Mailing Address: **1 Colonial Drive**
Lakehurst, New Jersey 08733
(201) 657-8121
Located at: **NO**
Harry Wright Annex
Whiting, N.J. 08759 10-10-85

APPLICATION FOR PUBLIC NON-COMMUNITY & NON-PUBLIC WATER SUPPLY SYSTEMS AS PER N.J.A.C., TITLE 7, AS PROMULGATED UNDER N.J.S.A. 58:11-23, ALSO AS DIRECTED BY THE COMMISSIONER OF THE DEPT. OF ENVIRONMENTAL PROTECTION AND MUNICIPAL ORDINANCE.

OWNER Salvatore Pace Tel. # 793-2136
MAILING ADDRESS, PRESENT: 1971 Hagedorn Road, Toms River NJ 08753
MAILING ADDRESS OF PROPOSED WATER SUPPLY: _____
Property location and directions to proposed supply Pine Lake Park, Lawrence Ave & Riverside
Blk. 1-284 Lot 5

PURPOSE OF WELL: New Supply ✓ Replacement _____ Supplement _____
To be used as: Individual Potable supply ✓ Other (explain) _____
Estimated depth of well Min. 70 Max 80 Size of casing (ID) 4"

TYPE OF CASING: Material Black Steel Grade API Weight 40 Thickness 1/4"
Type & Method of Joints Couplings Method of Installation Cable Tool

If rotary or power auger, size of hole: 2 1/2"
Material and method of sealing sides of hole: 2 1/2"
Type, depth & Method of grouting: 2 1/2"

Type, size (diameter & length) of well screen: 4" X 3' Johnson 12 S67
Method of disinfecting well, lines, pump, & tank: 3 cups of Bleach
Method of sealing well and drop lines: Sanitary Well Seal

Tank capacity, drawdown, type: Well - 4-Tel Seal - To old 40 gal gas tank
Type & H.P. ratings of pump: 1/2 Mfg. capacity rating GPM 12 at 30 ft. lift
Type & size of suction, jet or submersible pump lines 1" Riser Line


Number of plumbing fixtures & watering outlets in proposed building: 5
Future expansion of water use if known: None
Well, pump, tank will produce 12 GPM after 4 hrs. constant flow

State Well drilling permit obtained: Yes ✓ No _____ Number # 29-15517
Well to be installed by James Anderson Well Driller Lic. # 1138 Tel. # 240-2443

Well Drillers Signature James Anderson Well Drillers Address 46-3rd Bayway Toms River NJ 08753
As authorized by owner (signature only) Kathryn Pace Date Oct 3-85
Application for this well _____ approved this date _____ as proposed

Approving official _____
STATEMENT:
Approved water supply proposal is required before a building permit can be issued and is to be submitted simultaneously with septic application when applicable to new construction. A Certificate of Compliance is required before this well can be placed into use, and will not be issued without an "as built log," including any equipment used, other than listed above, especially actual volume/pressure of installation. Bacteriological and chemical analysis report from a certified laboratory is required. Location of the well will be as shown on septic plot plan. Any deviation shall meet with designing engineers' approval and shall be reflected on an as built plot plan map. All material, equipment, workmanship, required distances, depths, etc. shall meet requirements of all governing laws and regulations.

RECEIVED BY [Signature]
OCT 4 1985
OF THE MANCHESTER TWP.
BOARD OF HEALTH

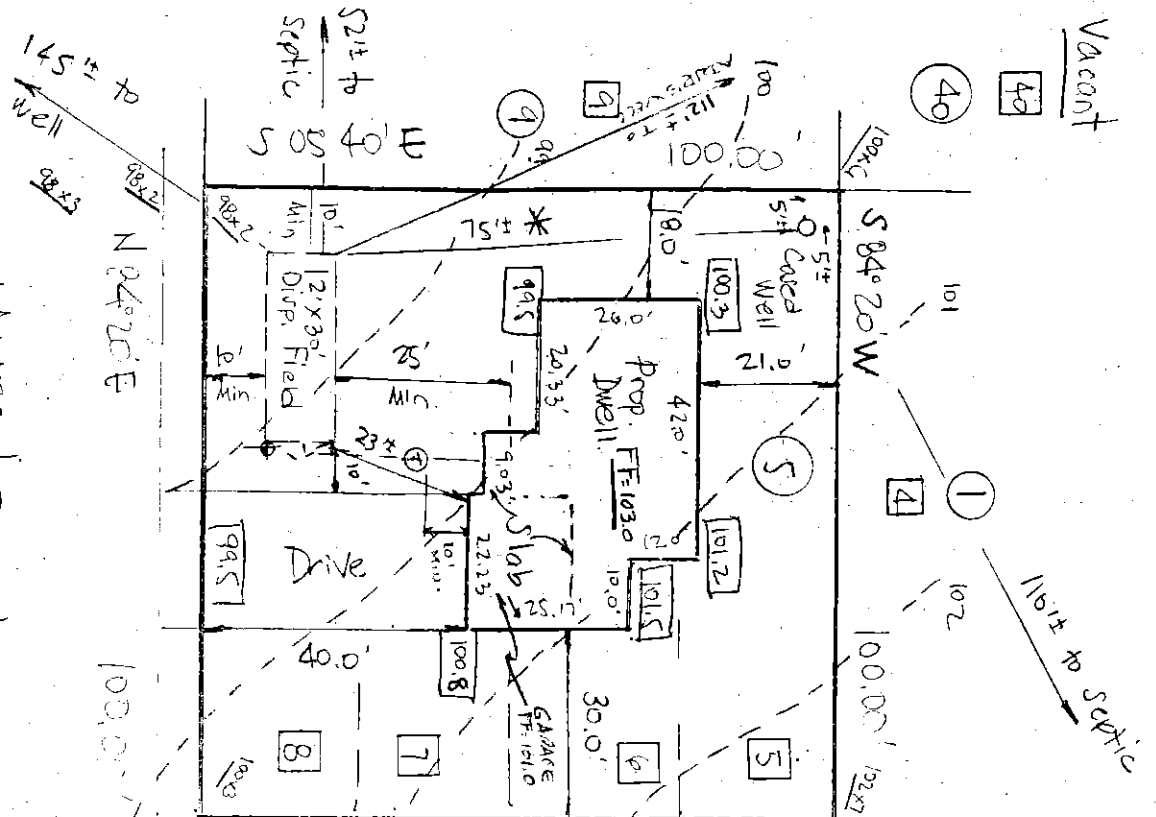


LAWRENCE AVENUE
(40' Filed Map)

Vacant

* Waiver Requested

PLOT PLAN
and
MAP of SURVEY
TAX LOT(S) 5
TAX BLOCK 1-284
MANCHESTER (TAX MAP SHEET NO. 7-4) TOWNSHIP
COUNTY of OCEAN, NEW JERSEY

SHWT below G
USDA Soil Type: LwB
Groundwater below 10'
Date of Perc Test: 9-23-85

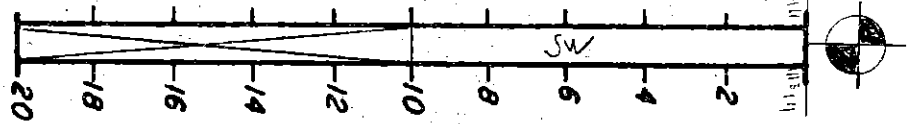

Septics and wells not critical

CERTIFICATION

TO: Mario Pace

I HEREBY CERTIFY THAT THIS SURVEY WAS
ACTUALLY MADE ON THE GROUND AND IS
CORRECT.

[Signature]

CHARLES B. RUSH, P.E. & L.S.
NJ LIC. NO. 21904 DATE: 7-7-85

FILED MAP REFERENCE		
TITLE: Pine Lake Park		
FILE NO. A-7	FILE DATE 11.30.10	
LOTS 5-8	BLOCK 284	
RUSH ENGINEERING COMPANY, INC.		
CONSULTING ENGINEERS · PLANNERS · SURVEYORS		
805 MAIN ST.	TOMS RIVER, NJ	08753
201-240-1200		
FILED PG.	SCALE: 1" = 30'	JOB NO. 1850858

Sheet 2 of 2



S747-85
closed

OCEAN COUNTY HEALTH DEPARTMENT

C. N. 2191

Toms River, N. J. 08753

201 - 341-9700

CHARLES KAUFFMAN
PUBLIC HEALTH COORDINATOR

PERCOLATION WITNESSING REPORT

Date 11/4/85

Municipality Jackson Block 108 Lot 2.02


Engineering Firm East Coast Engineering

Individual Conducting Test -

Depth of Perc Test Hole -

Soil Encountered -

*This was not witnessed
as perc was done at
Clayton's Pit on soils*

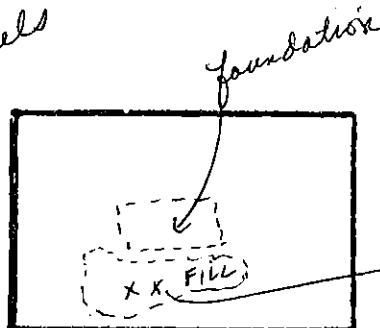

*Observed fill on
lot this is to be
used temporarily
as ramp for modular home
and then
unacceptable fill - chunky
clay, silt - beach sand
Builder states
this is for
modular home
only and this
fill will be
removed and
replaced*

Map indicating perc test and soil boring. Give Approximate distance to property lines. Identify adjoining properties (vacant or occupied) also identify streets.

Percolation Rate XX

Witnessing Inspector John A. Dotter



CONSULTING ENGINEERS LAND SURVEYING PLANNING

*Donna,
This has to
be witnessed*

JAY F. PIERSON L.S., P.P.
JEFFREY J. CARR P.E., P.P.
WILLIAM A. BROOKS P.E.
LEE V. MALLEY

1517 ROUTE 37 EAST TOMS RIVER, N.J. 08753 (201) 929 - 2970

Ocean County Health Dept.
CN 2191
Toms River, N.J. 08753

October 28, 1985

Dear Sir:

We would like to schedule a Perc Test for fill to be placed
on as follows:

Lot (s) 2.02 (2.10)
Block 108

The fill will be taken from Clayton's Gravel Pit
located on Bowman Road, Jackson Township.

We will be at the above location on November 4, 1985 at 9 a.m.


If you need further information please feel free to contact me
at this office.

Very truly yours,


J. F. Pierson
Jay F. Pierson, L.S.

*Bill
scale approved*

*11/4/85
no one on site
called Pierson
they're at gravel pits*

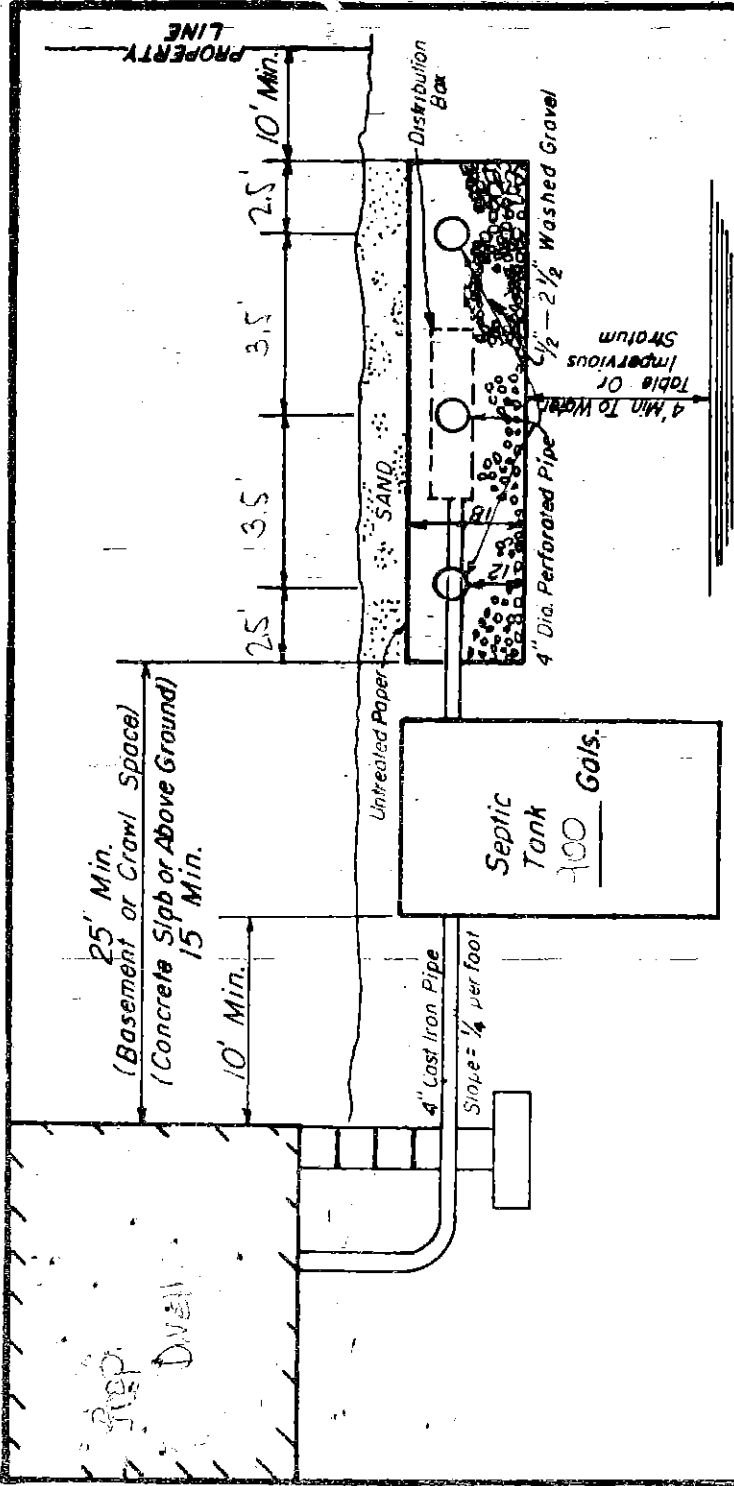

SECTION THROUGH SEPTIC INSTALLATION

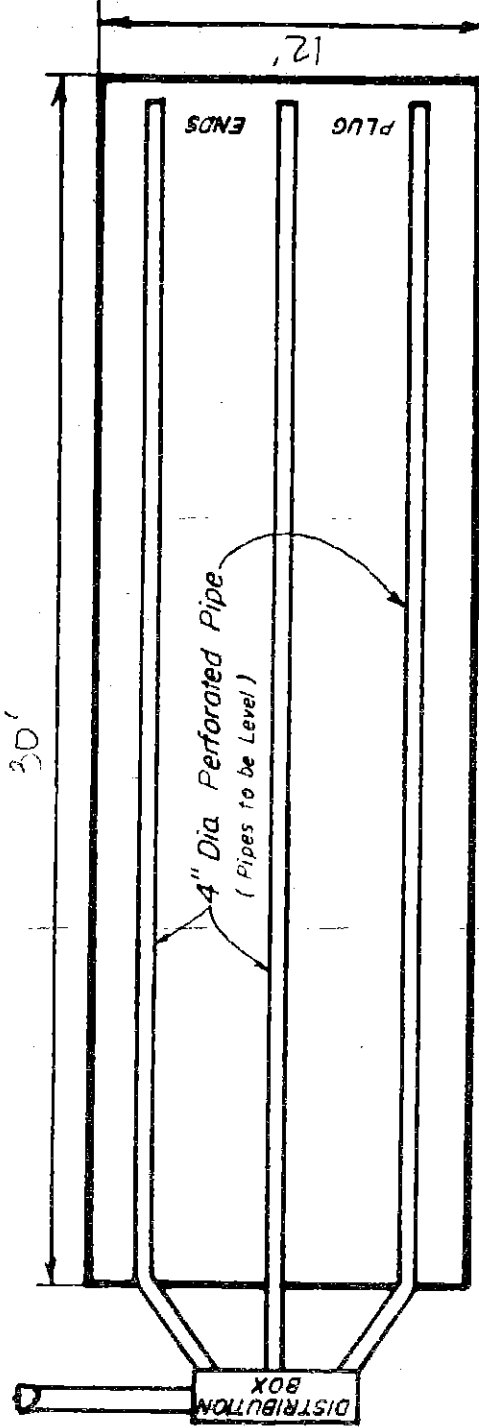

PLAN VIEW OF DISPOSAL FIELD

Required Percolating Area = $\frac{345}{\text{min.}} \text{ sq. ft.} (3 \text{ bdrms at } 115 \text{ sq. ft. / bdrm})$
 (Percolation Rate = $\frac{6}{\text{inch}}$; See Boring Log)
 Provided Percolating Area = 300 sq. ft.

SEPTIC SYSTEM DETAILS

TAX LOT 5 TAX BLOCK 1-284
 MANCHESTER (Tax Map Sheet No. 7-4) TOWNSHIP
 OCEAN COUNTY, NEW JERSEY

CERTIFICATION

I HEREBY CERTIFY THAT THIS EXHIBIT COMPLIES WITH
 CHAPTER 199, P.L. 1954 (REV. 1978) EXCEPT AS MODIFIED BY
 LOCAL ORDINANCE.

CHARLES B. RUSH, P.E.L.S.

[Signature] 10-1-85

NEW JERSEY LIS... NO. 21504

DATE

CLASH ENGINEERING COMPANY, INC.

Consulting Engineers Land Surveyors Planners

805 Main Street Toms River, New Jersey 08753

201-240-1200

Job No. 1890858

Sheet 2 of 2

October 8, 1985

Board of Health
Township of Manchester

1-284

5



749-85

(see below)

7:9-2.19 Septic tank is designed to be installed less than 10 feet from dwelling.

7:9-2.19 Engineer must locate well on lot 9 and state distance between that well and proposed septic.

BY: ROBERT J. INGENITO,
Principal Sanitary Inspector

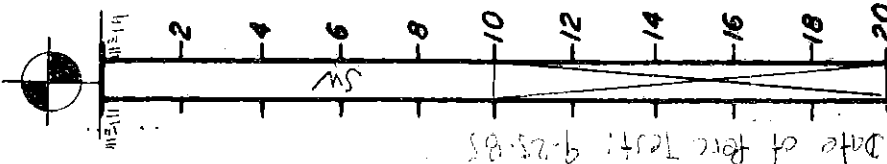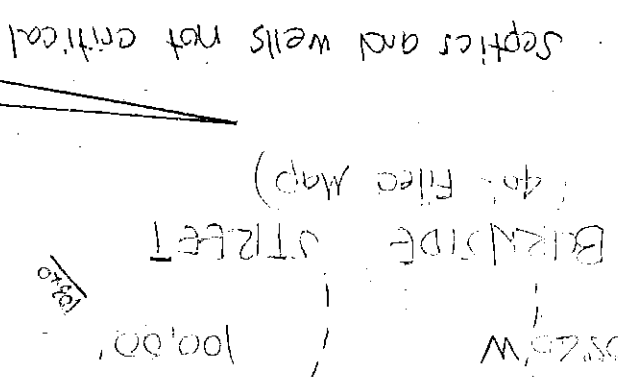

TAX LOT(S) 5 TAX BLOCK 1-284
MANCHESTER (TAX MAP SHEET NO. 74) TOWNSHIP
COUNTY of OCEAN, NEW JERSEY

FILED MAP REFERENCE

TITLE: Pine Lake Park

FILE NO. A-7 FILE DATE 1.30.10

LOT 5-8 BLOCK 284

RUSH ENGINEERING COMPANY, INC.

ACTUALLY MADE ON THE GROUND AND IS
CORRECT.

CONSULTING ENGINEERS · PLANNERS · SURVEYORS

805 MAIN ST. TOMS RIVER, NJ 08753


CHARLES B. RUSH, P.E. & L.S.
NJ LIC. NO. 21904 DATE: 12-1-85

201-240-1200


FILE
FLD BK. PG. SCALE: 1"=30'

FOR NO. 18888

Sheet 2 of 2

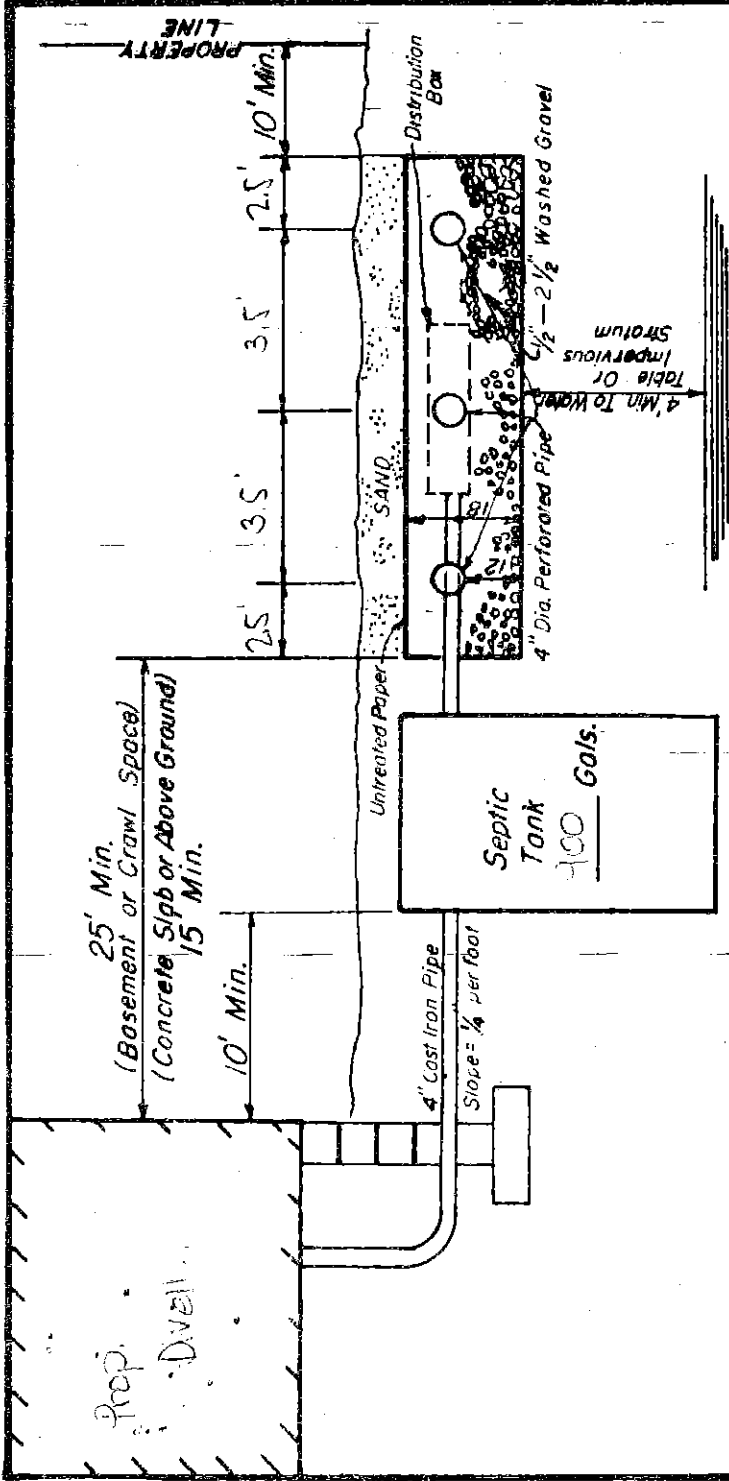

SECTION THROUGH SEPTIC INSTALLATION

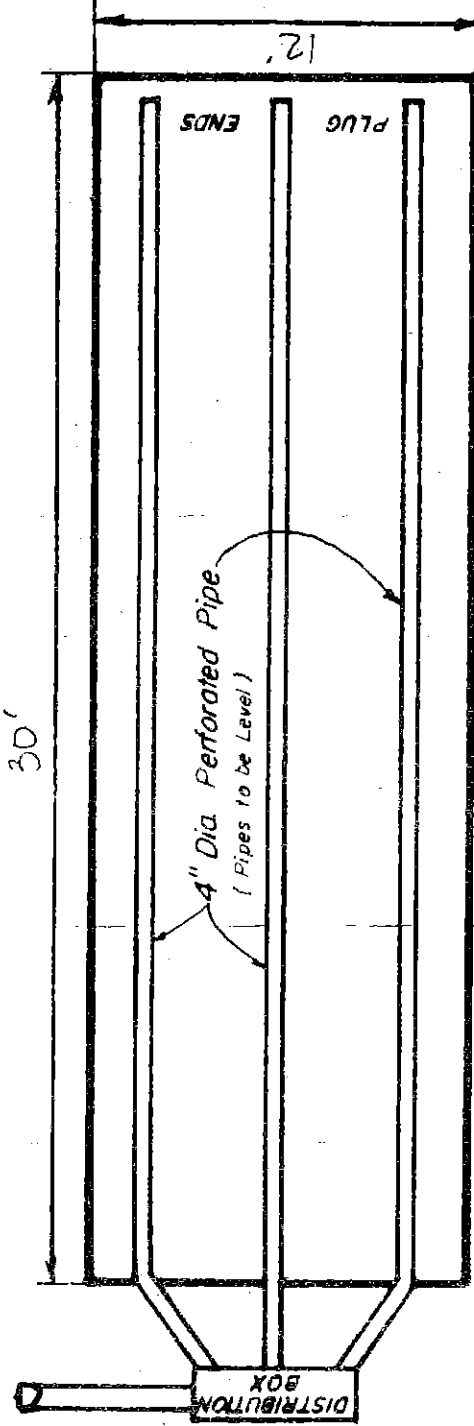

PLAN VIEW OF DISPOSAL FIELD

Required Percolating Area = $\frac{345}{6} = 57.5$ sq. ft. ($\frac{3}{6}$ bdrms at 115 sq. ft./bdrm)
 (Percolation Rate = $\frac{6}{\text{min.}} / \text{inch}$; See Boring Log)
 Provided Percolating Area = $\frac{500}{115} = 4.35$ sq. ft.

SEPTIC SYSTEM DETAILS

TAX LOT 5 TAX BLOCK 1-284

MANCHESTER (Tax Map Sheet No. 7-4) TOWNSHIP

OCEAN COUNTY, NEW JERSEY

CERTIFICATION

I HEREBY CERTIFY THAT THIS EXHIBIT COMPLIES WITH CHAPTER 199, P.L. 1954 (rev. 1978) EXCEPT AS MODIFIED BY LOCAL ORDINANCE

CHARLES B. RUSH, P.E., L.S.

[Signature] 10-1-85

NEW JERSEY LICENSE NO. 21504

DATE

W. H. ENGINEERING COMPANY, INC.

Consulting Engineers

Land Surveyors

Planners

805 Main Street

Toms River, New Jersey 08753

201-240-1200

Project File

Sheet 2 of 2

Job No. 890958

STATE OF NEW JERSEY
DEPARTMENT OF ENVIRONMENTAL PROTECTION
DIVISION OF WATER RESOURCES
TRENTON, N.J.

Mail to
Water Allocation
CN-029
Trenton, N.J. 08625

PERMIT TO DRILL WELL

VALID ONLY AFTER APPROVAL BY THE D.E.P.


Permit No. 29-15517
29.41679

Owner Mario Pace
Address 1971 Hazelwood Rd
Toms River NJ 08753
Name of Facility phone # 793-2136
Address _____

Driller Jonas Endreson
Address 40-3rd Bayway
Toms River NJ 08753

Diameter of Well <u>4"</u> Inches	Proposed Depth of Well <u>70'</u> Feet
Proposed Capacity of Pump <u>12</u> G.P.M.	Method of Drilling (cable-tool, rotary, etc.) <u>Cable-Tool</u>
Use of Well (See Reverse) <u>Domestic</u>	

Lot# 5 Block# 1-284 Municipality Manchester County Ocean

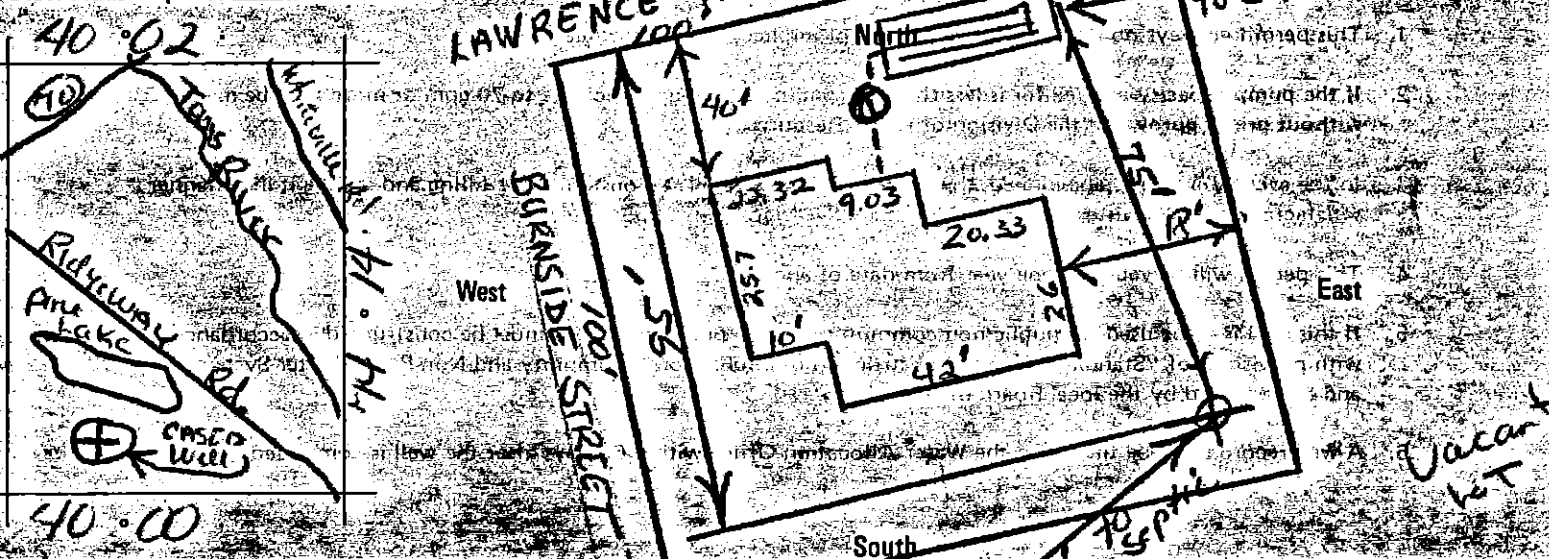State Atlas Map No. 29

SEE REVERSE SIDE FOR IMPORTANT PROVISIONS AND REGULATIONS pertaining to this permit. APPROVAL of this permit is made SUBJECT TO acceptance of and compliance with the following ADDITIONAL CONDITIONS:

- ☐ Permit issued in accordance with provisions of letter of transmittal dated _____
- ☐ It is necessary that Geophysical Logs of this well be made. Permanent pumping equipment SHALL NOT be installed until such logs are made.
- ☐ Samples of cuttings required every _____ feet.
- ☐ Domestic Potable Water Supply - The service line for water from the public community water supply system shall be turned off at the curb cock, and the meter shall be removed by the water purveyor.
- ☐ Domestic Irrigation Supply - No piping from the well for which the permit applies shall enter any building.
- ☐ Industrial/Commercial Supply - A physical connection permit shall be obtained pursuant to the provisions of N.J.A.C. 7:10-10-1 et. seq., and a vigorous cross connections control program shall be instituted and maintained within the premises.
- ☐ Heat Pump Wells - Wells must be 50 feet apart and the water must be returned to the same aquifer as the production well.
- ☐ _____

This Space for Approval Stamp

WELL PERMIT
APPROVED

OCT 3 1985

DEPT. ENV. PROTECTION
DIV. OF WATER RESOURCES
WATER ALLOCATION

In compliance with R.S. 58:4A-14, application is made for a permit to drill a well as described above.

Date _____

Signature of Owner _____

OWNER'S COPY



CHARLES B. RUSH, P.E., L.S., P.P.

☐ 805 MAIN STREET
P.O. BOX B
TOMS RIVER, NEW JERSEY 08754
201-240-1200

REPLY TO:

☐ 102 E. BAY AVE.
R.D. BOX 4
MANAHAWKIN, NEW JERSEY 08050
609-597-5444

September 19, 1985

Ocean County Health Department
Room 39 CN 2191
Sunset Avenue
Toms River, N.J. 08753

Attention: Bob Ingenito


Gentlemen:


We herewith request a witness for a percolation test and soil boring for 9 a.m. on Wednesday, September 25, 1985.

The location is Lots 5, Block 1-284,
Manchester Township on the Corner of Burnside
Street and Lawrence Ave.

If the specified date and time are not convenient, please call the undersigned to set up a schedule favorable to all concerned.

Very truly yours,

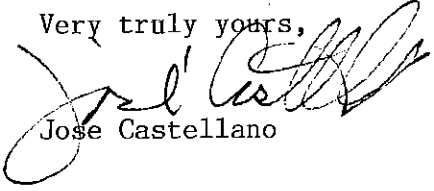
Jose Castellano

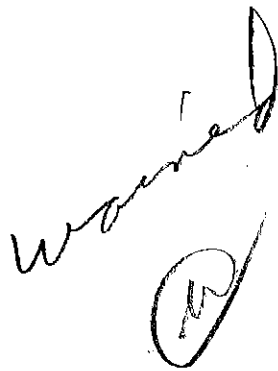

STATE OF NEW JERSEY
DEPARTMENT OF ENVIRONMENTAL PROTECTION
DIVISION OF WATER RESOURCES

5-749-85
Coord: 29.41679

PERMIT NO. 29-15517

APPLICATION NO. _____

COUNTY OCEAN

WELL RECORD

1. OWNER Mario Pace ADDRESS 1971 Hazelwood Rd T.R.
Owner's Well No. 1 SURFACE ELEVATION _____ Feet
(Above mean sea level)
2. LOCATION lot # 5 - Block # 1 - 284 - Manchester Township
3. DATE COMPLETED Jan 4, 1986 DRILLER Jonas Endreson
4. DIAMETER: Top 4" inches Bottom 4" inches TOTAL DEPTH 60' Feet
5. CASING: Type 4" BLACK steel Diameter 4" inches Length 57 Feet
6. SCREEN: Type S/S Size of Opening 12 Diameter 4" inches Length 3 Feet
- Range in Depth { Top 57 Feet
Bottom 60 Feet
- Geologic Formation cohansey
- Tail Piece: Diameter _____ inches Length _____ Feet
7. WELL FLOWS NATURALLY _____ Gallons per minute at _____ Feet above surface
Water rises to _____ Feet above surface
8. RECORD OF TEST: Date Jan 4, 1986 Yield 10 Gallons per minute
Static water level before pumping 34 Feet below surface
Pumping level 39 feet below surface after 2 hours pumping
Drawdown 5 Feet Specific Capacity 2 Gals. per min. per ft. of drawdown
How pumped submersible pump How measured 5 gal pail
Observed effect on nearby wells none
9. PERMANENT PUMPING EQUIPMENT:
Type submersible Mfrs. Name Red-Jacket
Capacity 12 G.P.M. How Driven electric H.P. 3 1/2 R.P.M. 3450
Depth of Pump in well 56' Feet Depth of Footpiece in well _____ Feet
Depth of Air Line in well _____ Feet Type of Meter on Pump _____ Size _____ inches
10. USED FOR Domestic AMOUNT { Average 500 Gallons Daily
Maximum 1000 Gallons Daily
11. QUALITY OF WATER Good Sample: Yes _____ No _____
Taste None Odor None Color clear Temp. 52 °F.
12. LOG ON BACK Are samples available? _____
(Give details on back of sheet or on separate sheet. If electric log was made, please furnish copy.)
13. SOURCE OF DATA Driller
14. DATA OBTAINED BY Jonas Endreson Date Jan 4, 1986

(NOTE: Use other side of this sheet for additional information such as log of materials penetrated, analysis of the water, sketch map, sketch of special casing arrangements, etc.)

\$10.00 Fee:

S-749-85

MANCHESTER TOWNSHIP

1 Colonial Drive, Ocean County, Manchester Township, N.J.

CERTIFICATE OF OCCUPANCY APPLICATION

(Please print or type)

PERMIT NUMBER: MC-2200-85 DATE: _____

Owner's Name: Salvatore & Kathryn Pace

Name of Street Lawrence & Burnside Block: 1-284 Lot: 5

House Number: _____ Map of: Pine Lake Park

_____ Map filed?: Yes _____ (yes or no)

Owner's Mailing Address This Date: 1971 Hazelwood Dr.

Toms River, N.J.

Responsible Person: Salvatore Pace

Use as Proposed (in detail): 2 story; 2 car agrage crawl

Ocean County Health Department Approvals: Well: 11/6/86 MCTonguehill Septic: 12/6/85 MCTonguehill

Zoning Officer: _____

Homeowner's Warranty Ins. #: _____

Engineering Ordinance 77-89 Approval: _____

Final cost of construction work including basic structure, all on site improvements, built in furnishings and fixtures, and all integral equipment exclusive of process or manufacturing equipment.

Total Cost: _____

As built building plans if deviated from approved set. As built site plan including but not limited to exact building, water and sewer location to lot lines, finished floor elevation and street grades shall accompany this application.

Conditions of Certificate of Occupancy:

1. Certificate of Occupancy shall be conditioned upon the following:

- That the completed project meets the conditions of the construction permit, the approved drawings including all amendments, and all prior approvals.
- That all required fees be paid in full.
- That all necessary inspections have been completed and that the completed project meets the requirements of the Regulations.
- That all violations have been corrected and that any assessed penalties have been paid.
- That all protective devices and equipment required to be installed by the Regulations will continue to be operational as required by the Regulations.
- That all other Municipal, County, and State approvals be obtained where applicable.

All information in the above application has been completed and is correct to the best of my knowledge.

To the best of my knowledge all work has been completed in accordance with the permit, the approved plans and all the Regulations.

Signature: Responsible person in charge

