


TITLE NO: _____

BURN'T TAVERN ROAD

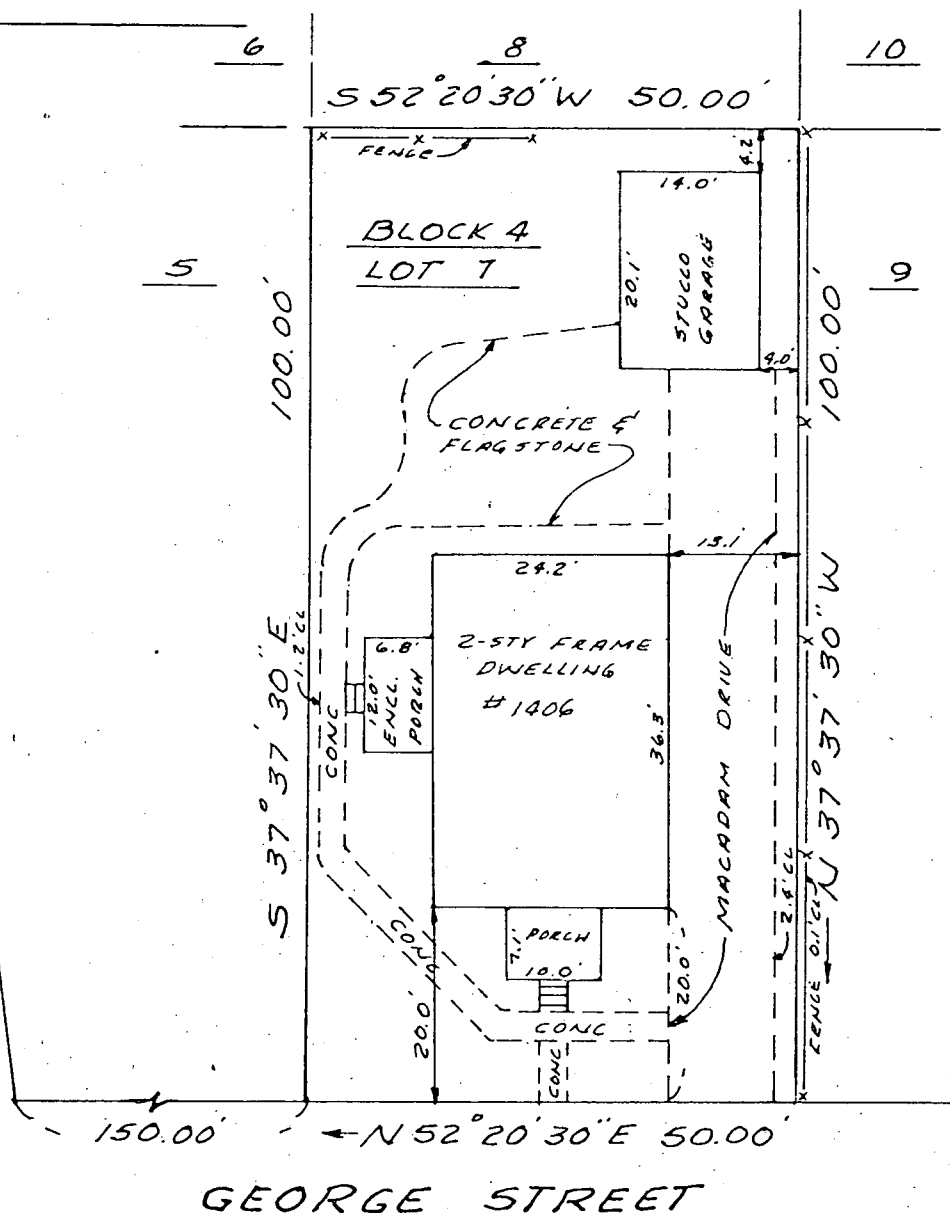


Property known and designated as Lot 7 in Block 4 as laid out on map entitled "Marsett Manor Borough of Point Pleasant, Ocean County," and filed in the Ocean County Clerk's Office on January 8th, 1947, as Map No. D-233.

This survey is certified to Alexander Moskov and Cynthia Moskov, his wife J. I. Kislak Mortgage Corporation and any title insurance company licensed to do business in New Jersey.

SKETCH OF PROPERTY SURVEYED FOR
ALEXANDER & CYNTHIA MOSKOV

SITUATED IN
BOROUGH OF POINT PLEASANT, OCEAN COUNTY, NEW JERSEY

EDWARD C. REILLY INC. DIVISION OF
GOODMAN, ALLGAIR & SCOTT INC.
PROFESSIONAL ENGINEER-PLANNER-LAND SURVEYORS
FREEHOLD, N.J. WOODBRIDGE, N.J.
70 SCHANCK ROAD
FREEHOLD, N.J. 07728
TEL. 201-462-7400

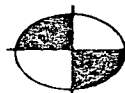

SCALE: 1"=20'

DATE: MAR. 23, 1973

TAX MAP:

MAP NO: 15-25-17

FILE NO: 73M2106

JOHN ALLGAIR
LIC. NO. 12012

FES/11/11