


TRIBUTARY OF NORTH BRANCH OF
BEAVER DAM CREEK

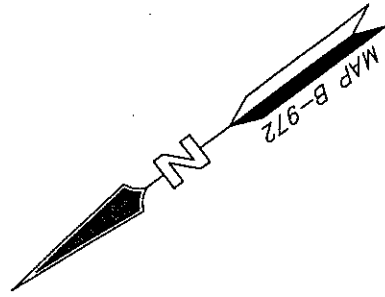

LOT 14

S 60°09'13" E 162.7'±
TO FACE OF BULKHEAD

BLOCK 342
LOT 15

ON LINE

STATE
CLAIM LINE

WOOD TIE

0.9'

COVERED
DECK

7.9'

GRAVEL
ACCESS

11.1'

2nd FLOOR
OVERHANG

COV. PORCH

2-STORY
DWELLING
NO. 1515

WOOD
DECK

5.7'

WOOD TIE ON LINE

5.8'

STORAGE SHOWER

BULKHEAD

ON LINE

LOT 17

5.0'


DWELLING

5.0'

0.4' ON

N 52°24'40" W 164.4'±
TO FACE OF BULKHEAD

PROJECT No. 12-932		DATE 04-28-17	SCALE: 1"=20'	SHEET: 1 OF 1
Charles Surmonte P.E. & P.L.S. New Jersey Professional Engineer and Land Surveyor License No. 35885		301 Main Street, 2nd Floor Allenhurst, New Jersey, 07711 Phone 732-660-0606 Fax 732-660-0404		
BOROUGH OF POINT PLEASANT		OCEAN COUNTY		
1515 LITTLEHILL ROAD		LOT 15 BLOCK 342		
AS-BUILT SURVEY				

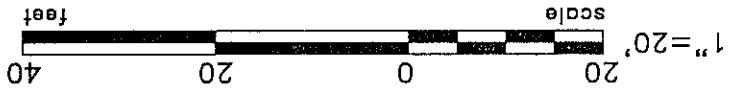

LITTLE HILL ROAD (50' R.O.W.)

