

CERTIFICATE OF COMPLIANCE

NEW JERSEY SAFE DRINKING WATER ACT
(N.J.A.C. 7:10 - 12.1 et.seq.)
"STANDARDS FOR INDIVIDUAL SUBSURFACE SEWAGE DISPOSAL SYSTEMS"
(CHAPTER 9A)

TO: Theodore S. Fisher
10 Blue Ridge Drive
Trenton, NJ 08638

FILE NUMBER: 56819C

DATE: 8/17/94

THIS IS TO CERTIFY that the water supply and sewage disposal facilities installed under permit have been constructed under the surveillance of the Cape May County Department of Health and found to be in compliance with Chapter 9A and the New Jersey Safe Drinking Water Act.

BLOCK	LOT
256.01	20

S. RAVENWOOD DRIVE

FOUR (4) BEDROOM DWELLING

MUNICIPALITY: TOWNSHIP OF DENNIS



DEBBIE DICKINSON, SANITARY INSPECTOR
The issuance of this certificate shall not be construed as a guarantee that the system will function satisfactorily nor shall it in any way restrict the powers or responsibilities of the Cape May County Department of Health in the enforcement of any law or ordinance relating to public health.

10/31/88

DEPARTMENT OF HEALTH
Cape May County
Cape May Court House, N.J. 08210

PERMIT

PERMISSION HAS THIS DATE BEEN GIVEN TO:

THEODORE S FISHER
10 Blue Ridge Drive
Trenton, NJ 08638

PERMIT No.
56819C

Date
10 | 27 | 88


- ☒ to construct a sewage disposal system as described in engineering data submitted and approved by this department in accordance with the provisions of Chapter 199, P.L., 1954 N.J.S.A.
- ☒ to construct a water supply system as described in engineering data submitted and approved by this department in accordance with the provisions of Chapter 199, P.L., 1954 N.J.S.A., at: SWP #3609371

LOCATION OF FACILITY: REVISED DESCRIPTION OF FACILITY:

NOTE: A NEW STATE WELL PERMIT WILL BE REQUIRED AS THIS ONE EXPIRES IN NOVEMBER (5th) 88.

Lot	Block
20	256.01

BOARD OF HEALTH OF DENNIS TOWNSHIP

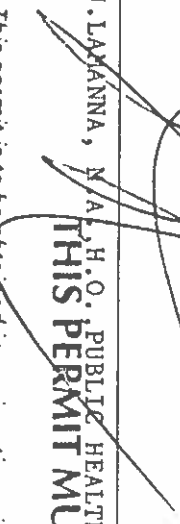By  L.J. LAXANNA, N/A, H.O. PUBLIC HEALTH COORDINATOR
Health before it is covered from view.

THIS PERMIT MUST BE POSTED IN PLAIN VIEW

This permit is to be submitted in conjunction with all applicable local, regional, state and/or federal permits required.

THEODORE S FISHER

MEMO TO PROPERTY OWNER

Attached hereto is your Permit No. 56819C to construct a sewage disposal system as described in engineering data submitted on 12/21/87.

The "X" marked items apply:

..XX... Copy of plans to be retained by you.

XX

Extra copy of plans to be signed and dated by the licensed well driller who has installed your well. Have well driller complete the appropriate section on plans marked "Attention Well Driller." When this is done, return plans to

DEPARTMENT OF HEALTH
CAPE MAY COUNTY
CREST HAVEN COMPLEX
CAPE MAY COURT HOUSE, N. J. 08210

..XX... A sample of raw water from every proposed water system shall be bacteriologically tested--copy of the analytical results shall be submitted to this office before a "Certificate of Compliance" will be issued.


XX

A sample of raw water from every proposed Non-public water system shall be tested for nitrates, iron, manganese and pH--copy of the analytical results shall be submitted to this office before a "Certificate of Compliance" will be issued.

.....

A sample of raw water from every proposed Public Non-community water system shall be tested for nitrates, iron, manganese, pH, arsenic, barium, cadmium, chromium, lead, mercury, selenium, silver, and fluoride--copy of the analytical results shall be submitted to this office before a "Certificate of Compliance" will be issued.

..XX... The building inspector has been notified so that your building permit can be issued.

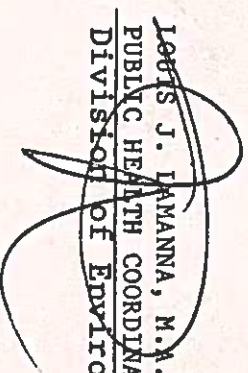
LOUIS J. IAMANNA, M.A., HO.,
PUBLIC HEALTH COORDINATOR

Division of Environmental Health

LJL:jem

cc: Constr Official

AGE EASEMENT

N 45°42'15"E
391.65

POSITIONS OF THE ELECTRICITY & TELEPHONE BOXES
BE APPROXIMATE. TO BE RELOCATED AS REQ'D

ELEVATIONS BASED ON LOCAL DATUM

EXISTING
WELL

This system must be inspected by
then from the Cape May County Dept. of
Health before it is covered from view.

This data has been examined by the Cape
May County Dept. of Health and found
acceptable for installation at the place and
under the conditions stated in the data
and on the application. By [Signature]

REVISED

When calling for Final inspection of
Sewage Disposal System or Water Supply,
refer to No. 56819c

HOWARD BOSWELL, JR.

PROFESSIONAL ENGINEER N.J. LIC 25409 N.Y. LIC 55912
PROFESSIONAL PLANNER N.J. LIC 2120

DATE

SITE PLAN

BLOCK 256.01 LOT 20

DENNIS TOWNSHIP

CAPE MAY COUNTY

NEW JERSEY

BOSWELL ENGINEERING COMPANY

330 PHILLIPS AVE

SOUTH HAVEN, N.J. 07606

SURVEYED BY

CHECKED BY


SCALE: 1" = 20'

NO	DATE	REVISION	BY
1	2.1.88	AS PER COUNTY HEALTH DEPT	H/A

DWG. NO. 87-275-SPSHEET 1 OF 2

REVISED

driven to 2' from
can be located 50' from

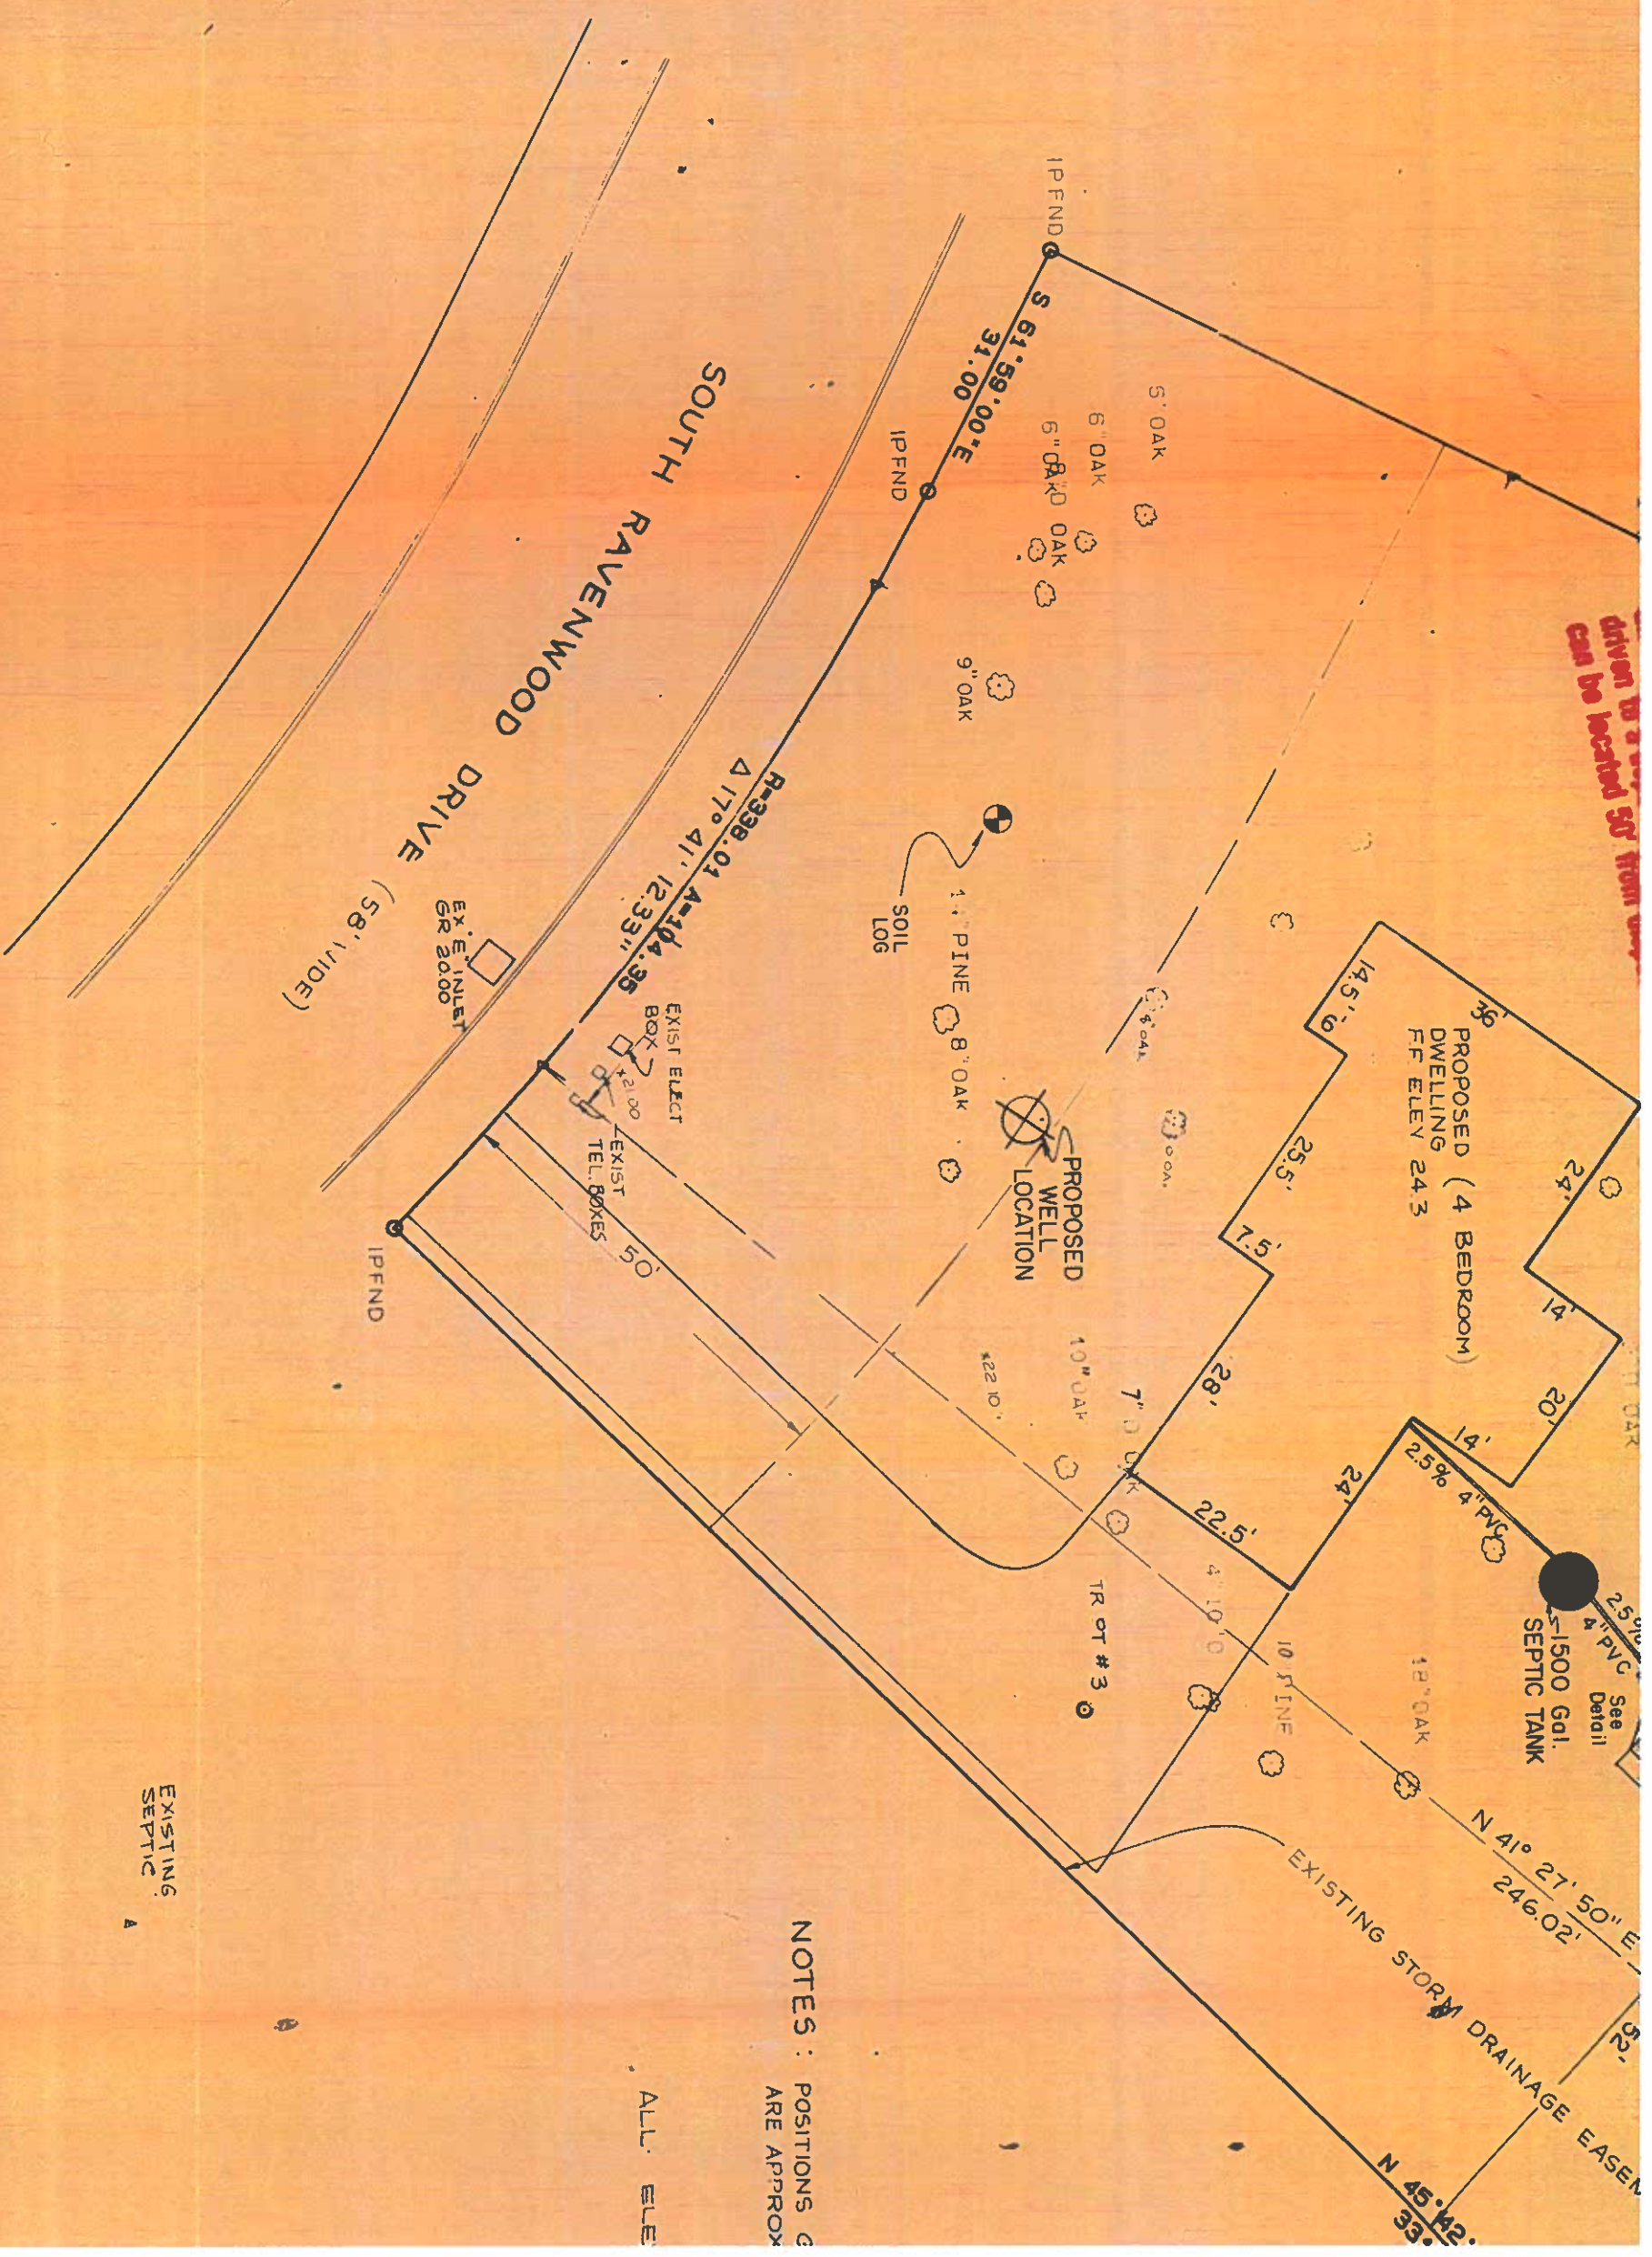

NOTES : POSITIONS
ARE APPROX

ALL ELE


EXISTING
SEPTIC

DEPTH	SOIL DESCRIPTION	UNIFIED
0'0" - 0'4"	Fine Dark Grey Top Soil	PT
0'4" - 2'0"	Med. Light Brown Sand	SP
2'0" - 3'6"	Med. Brown Sand with Course Stone	SP
3'0" - 4'0"	Med. Brown Sand	SP
4'0" - 6'0"	Fine Light Yellow Sand	SP
6'6" - 6'6"	Med. Dark Orange Sand	SP
6'6" - 6'8"	Fine Light Yellow Sand	SP
8'0" - 10'0"	Fine Light Grey Sand	SP

Percolation Rate = 8 min/inch
 Depth to Estimated Seasonal High Water = None to 10'0"
 Depth to Ground Water = None to 10'0"
 Date of Boring = September 14, 1987
 Type of Auger = Hand
 Performed by = Donald DeVaul



EXISTING
WELL

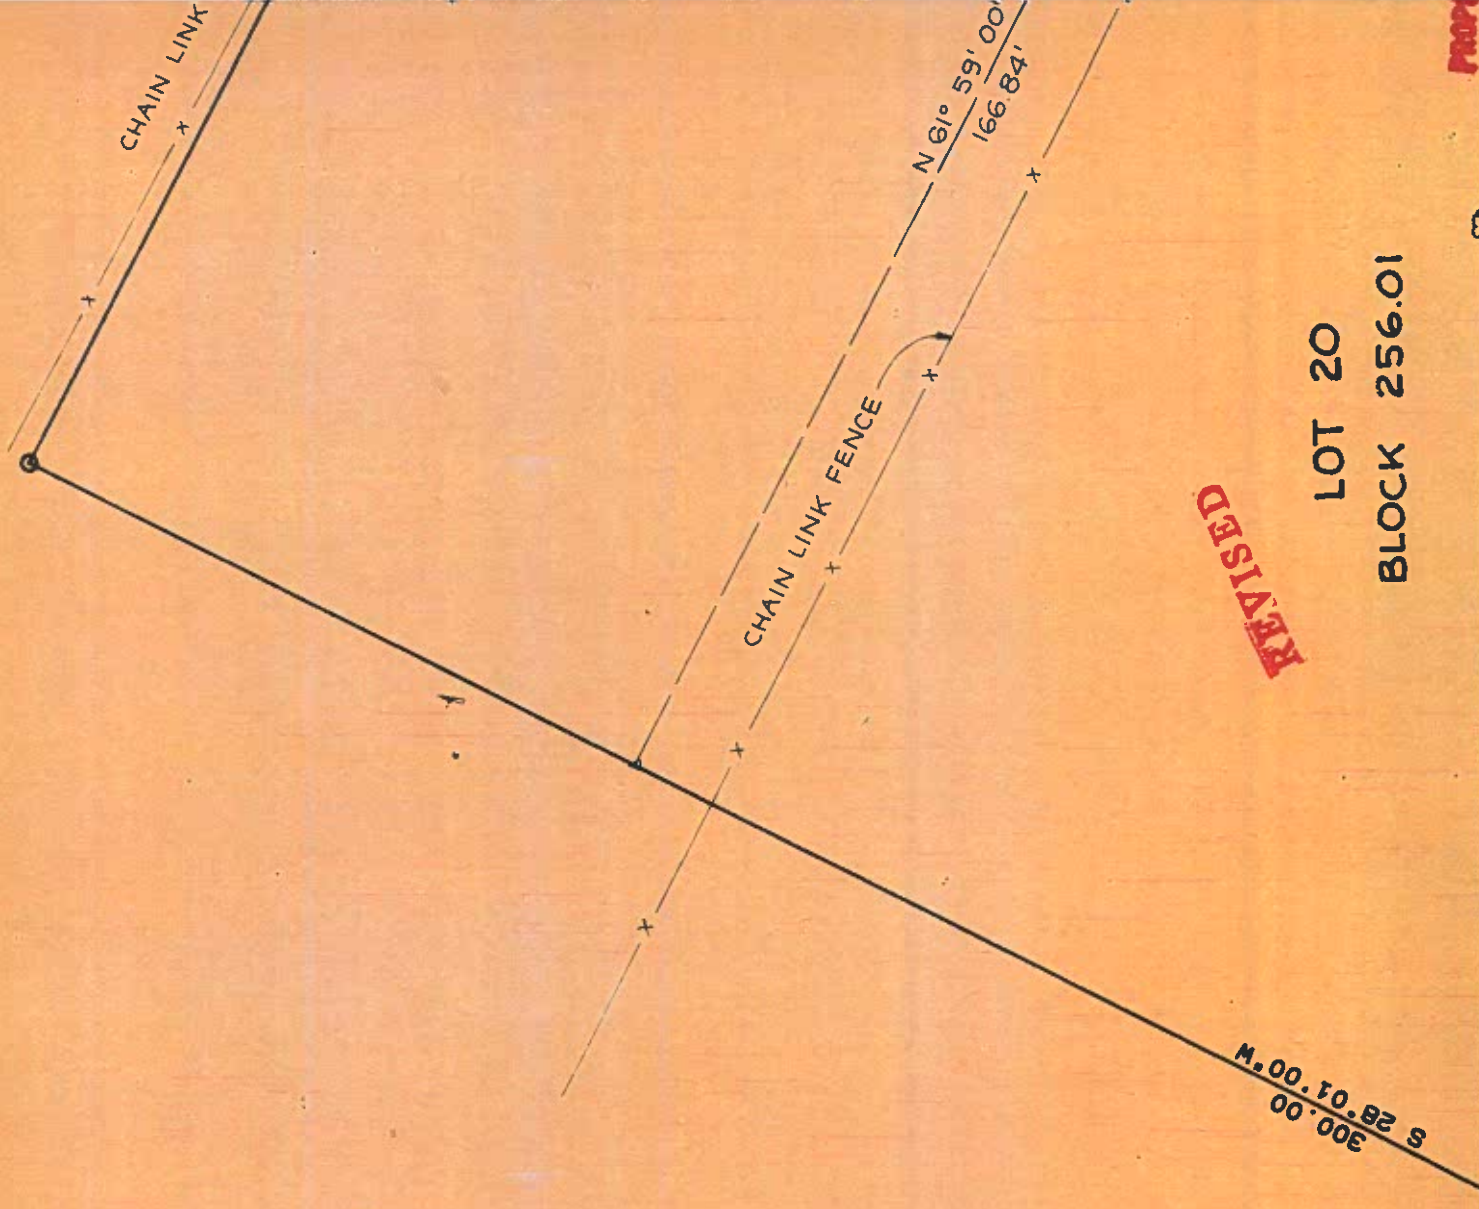


REVISED

REVISED

LOT 20
BLOCK 256.01

PROP

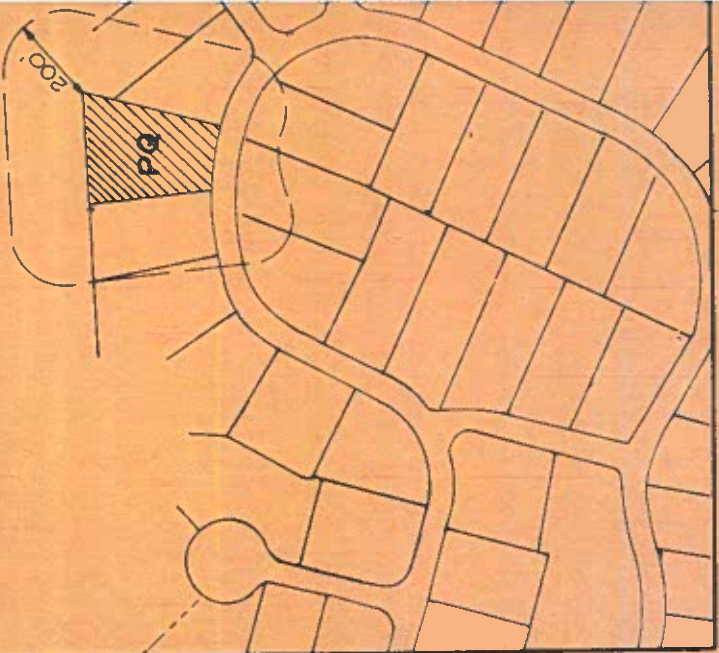

KEY MAP
SCALE: 1" = 500'

REVISED

CAPE MAY COUNTY
OCT 21 1988
Department of Health

