

Construction


Permit Applications

View Control Number	Permit Number	Issue Date	Work Type	Work Description	Subcodes	Status	Close Date	Certificates	Total Cost	Agent
View C-23-094			Alteration	ROOF MOUNT SOLAR SYSTEM	Building, Electrical, Fire	Under Review			22753	VISION SOLAR LLC
View C-16-042	16-032	2/12/2016	Alteration	CENTRAL A/C UNIT FURNACE	Plumbing, Electrical	CA and Close Date Issued	4/3/2017	CA	10400	Alpine Air Conditioning & Heating LLC
View C-06-281	06-304	12/18/2006	Alteration	Installation of water heater	Plumbing, Fire	Certificate (CA) Issued		CA	2300	DISKEN, DENNIS D & LINDA
View 02-231+A	02-231+A	11/18/2002			Electrical	Closed with Date	11/19/2002		1200	
View 02-231	02-231	10/24/2002	Addition	Alterations to existing kitchen	Building, Electrical	CO and Close Date Issued	10/25/2002	CO	10500	
View 01-255	01-255	12/5/2001	Alteration	Rip and re-roof	Building	CA and Close Date Issued	12/6/2001	CA	7000	
View 96-053	96-053	4/23/1996	Alteration	Installation of a 200 amp electrical service	Electrical	CA and Close Date Issued	4/24/1996	CA	950	
View 94-246	94-246	12/6/1994	Addition	Construct dormer to existing attic bedroom and install full bath	Building, Plumbing, Electrical, Fire	CO and Close Date Issued	12/7/1994	CO	15500	

Permit #91-208 - description of work
Installation of a 5 foot high chain link fence to enclose swimming pool

Certificate of approval issued 1/10/92


TIS IS NOT A PROPERTY SURVEY. DO NOT USE FOR HOME OR FENCE CONSTRUCTION.
 THIS SITE MAP HAS BEEN REVISED TO SHOW SURFACE DIMENSIONS AS-CONSTRUCTED.
 SEPTIC TANK MUST BE CLEANED EVERY THREE YEARS TO ENSURE THE SYSTEM OPERATION.
 NO FOOD WASTE GRINDERS OR WATER SOFTENERS PERMITTED TO DISCHARGE TO SDS.
 EFFLUENT FILTER INSTALLED IN OUTLET BAFFLE. CLEAN/REPLACE EVERY THREE YEARS.

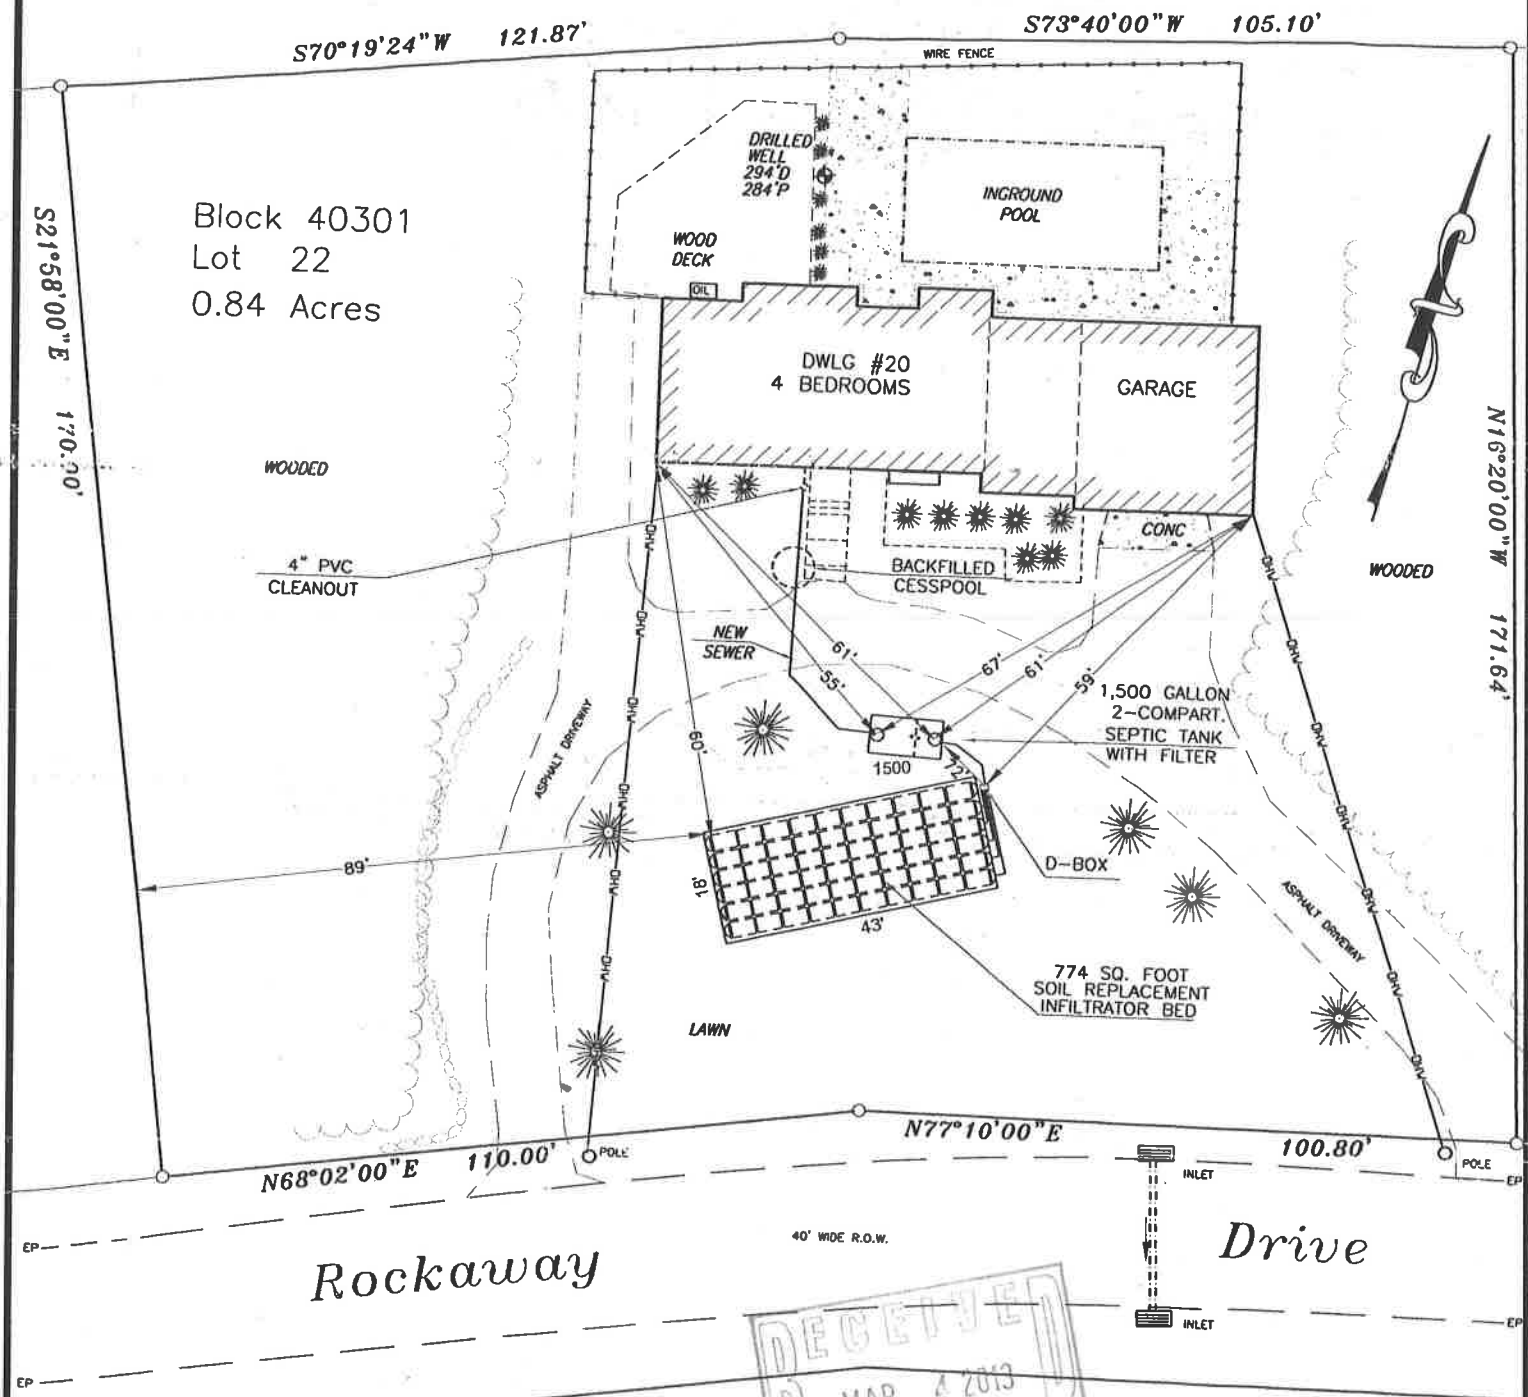

SITE PLAN
 1" = 30'

RESIDENCE OF:
 LINDA DISKEN
 20 ROCKAWAY DRIVE
 BOONTON TWP, NJ 07005

ALTERATION AS-BUILT

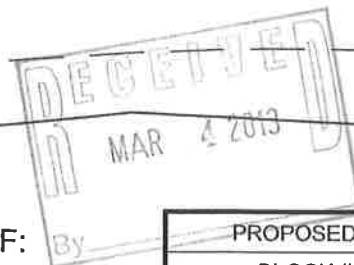

PROPOSED DISPOSAL SYSTEM REPLACEMENT	
BLOCK #: 40301	LOT #:22
TOWNSHIP OF BOONTON, MORRIS COUNTY, N..J.	
STEVEN BALDISSEROTTO, P. E. N.J. LICENSE #31164	
PROFESSIONAL ENGINEER	DATE 2/27/13
12 LAKESIDE TRAIL KINNELON, N. J. 07405	(973) 492-7171 FEBRUARY 27, 2013