

OCEAN COUNTY HEALTH DEPARTMENT

2/26/09

Date

P.O. BOX 2191

TOMS RIVER, N.J. 08754-2191

(732) 341-9700

No. 040281

BOARD OF HEALTH OF JACKSON

CERTIFICATE OF COMPLIANCE

Issued to Mr. + Mrs. Behm

(Owner or Contractor)

THIS IS TO CERTIFY That the

INDIVIDUAL SEWAGE SYSTEM

Approved - Repair

INDIVIDUAL WATER SYSTEM

N/A

Installed at Block No. 1101

Lot No. 13 is in compliance with the

Application for Permit to Locate and Construct or

Alter Such Systems.

No. 040281 dated 2/26/09

The issuance of this certification shall not be construed as a guarantee that the system will function satisfactorily nor shall it in any way restrict the powers or responsibilities of the Board of Health in the enforcement of any law or ordinance relating to public health.

Final
Approval

Ray T. Dean

OCEAN COUNTY HEALTH DEPARTMENT
P.O. Box 2191, Sunset Avenue
Toms River, NJ 08754-2191

APPLICATION FOR A PERMIT TO INSTALL A SEPTIC SYSTEM
AND/OR A WATER SUPPLY SYSTEM

JACKSON
MUNICIPALITY

Comm. Code 15

Official Use Only

Block 132 New 1101

Lot(s) 26.10 New 13

- ___ (A) To construct both a septic & water supply system
___ (B) To construct a water supply system
___ (C) To replace or alter a water supply system
___ (D) To construct or alter a septic system
X (E) To replace or repair a septic system

Type of Water System

- ___ (A) Potable Non-Public
___ (B) Potable Public Non-Community
___ (C) Non-Potable
___ (D) Public Community System

Replace 15x55 bed

(Current address of applicant required. All information must be completed.)

NAME OF APPLICANT Mr + Mrs. Behm

PHONE NO. (732) 961-1099

ADDRESS 21 Rivers Edge Dr CITY Jackson STATE NJ ZIP 08527

DIRECTIONS TO LOCATION Farmingdale Rd to Rivers Edge Dr

WELL APPLICATION

TYPE OF CASING: Material ___ Diameter ___ Grade ___ Thickness ___

TYPE AND METHODS OF SEALING JOINTS: Type ___ Method ___

METHOD OF INSTALLATION ___ If Rotary or Auger, size of hole ___

GROUTING MATERIAL ___ Depth & Method of grouting: Depth ___

Method ___

STORAGE TANK CAPACITY ___ Model No. ___

WELL DRILLER ___ (Print) ___ Lic. # ___ Driller Phone # ___

DRILLER ___ (Signature) ___ State Well Permit # ___

NOTE: Copy of NUDEP "Permit to Drill Well" must be attached. Hose bibs are prohibited on non-potable well, unless such well is sampled. NUDEP's "Well Record" must be immediately submitted to the Health Department upon installation of well.

SEPTIC APPLICATION

TYPE OF BUILDING TO BE SERVED Residential Dwelling Unit: No. of Bedrooms 3

EXPANSION ATTIC, DEN OR REC. ROOM: Yes ___ No ___ If yes, calculate as additional bedroom ___

PERCOLATION TEST PERFORMED BY All - Vets Date ___ Phone ___

WEATHER CONDITIONS AT TIME OF TEST ___

ENGINEER'S SIGNATURE AND SEAL ___

NOTE: All engineering data relating to soils, percolation & system design must be on engineer's drawing. Engineer's drawings must be signed & sealed by the engineer.

STATEMENT: Submit four (4) complete legible copies of applications, including engineer's & well driller's submissions. Final approval will only be granted after all inspections are completed, "as-built" drawings are submitted (where required) and satisfactory water analysis received, and all fees are paid. Permit is valid for one (1) year from date of issuance.

Frankie Moore Walker not

Location-Address 21 Riveredge Dr ^{new 1101} ^{new 13} Blk#: 132 Lot#: 26,01

Owner(Print): Mr. Bellm

Present Address: SAME

ALWAYS TRUCKING

889 Lakehurst Avenue Jackson, N. J. 08527

(908) 928-5862

732


Type of Building to be Served House Use: Yearly ☒ Summer ☐
Dwelling Unit: No. of Bedrooms 3 Expansion Attic: Yes ☐ No ☒
Other: Type of Business No Plumbing Units
Size of Lot: Area Sq. Ft.

PRIMARY TREATMENT (For Definitions See Other Side)

Septic Tank: Shape Rectangular Cylindrical ☐ Material Concrete
Width 15' Length 55' Liquid Depth 4' Total Depth 8'
Diameter (if cylindrical) None Capacity (Gals.) 1,000

(W)

SKETCH OF PROPOSED INSTALLATION/REPAIR

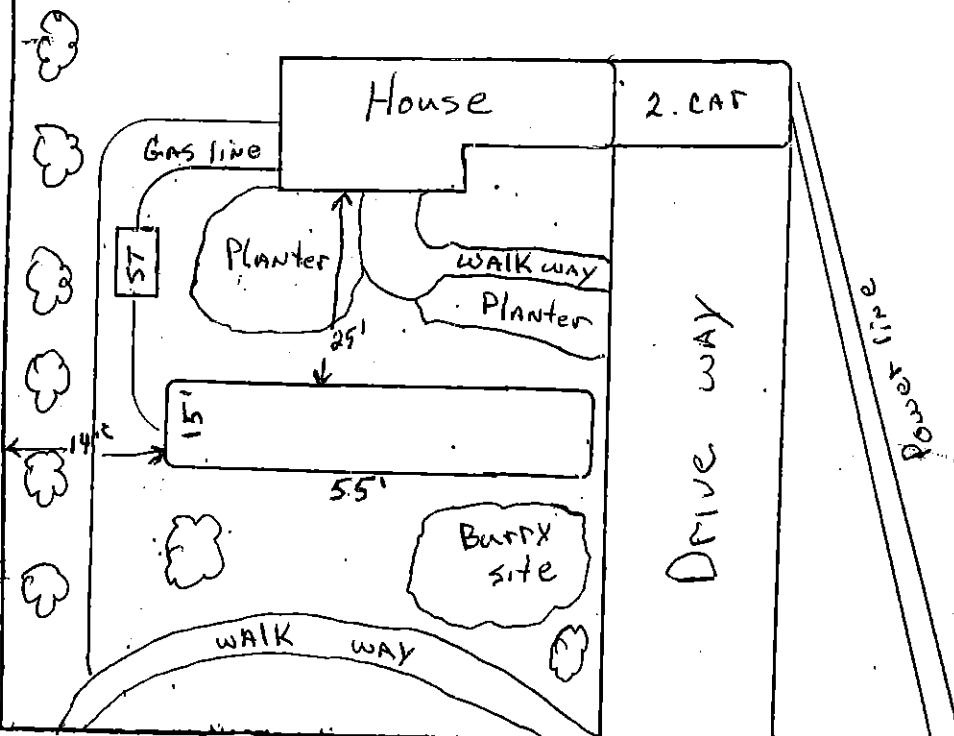

ESTIMATED
S.F.L.W.T. @

No.
water
16' +

NOTE:
CITY WATER
WELL WATER

Am
NB