

Septic System Inspected
Well Inspected

BOARD OF HEALTH
TOWNSHIP OF COLTS NECK
COLTS NECK • NEW JERSEY

most use all
1 1/2 - 2 1/2 STONE
SHEET LAY

AS-BUILT

need to see lines connected to TANKS

Permit No. #601
Date 3/18/81

APPLICATION FOR

☒ PERMIT TO LOCATE AND CONSTRUCT AN INDIVIDUAL SEWAGE DISPOSAL SYSTEM.
☐ PERMIT TO ALTER AN INDIVIDUAL SEWAGE DISPOSAL SYSTEM.

Location - Address DEER PATH LANE or Block No. 23 Lot No. 133
Owner (Print) BUCKMILL ASSO
Present Address 118 HILLCREST DR CLARK NJ 07066
Name and Address of Contractor (Print) SAME

Type of Building to be Served TWO STORY Use: Yearly ☒ Summer ☐
Dwelling Unit: No. of Bedrooms 4 Expansion Attic: Yes ☐ No ☒
Other: Type of Business _____ No. Plumbing Units 2 1/2 BATHS
Size of Lot 200 By 275 Area Sq. Ft. 55,000

PRIMARY TREATMENT (For Definitions See Other Side)

Septic Tank Shape _____ Rectangular# _____ Cylindrical# ☒ Material Conc.
Width _____ Length _____ Liquid Depth 69" Total Depth 86"
Diameter (if cylindrical) 78" O.D. Capacity (Gals.) 1250

SECONDARY TREATMENT (For Definition See Other Side)

Disposal Trenches: Width _____ Depth _____ Area Sq. Ft. _____
Distance between lines _____ Type and size of pipe _____
Disposal Bed: Width 20' Length 32' Area Sq. Ft. 640
Feet of pipe 160 Type and size of pipe 4" Perf.
Distance between lines 4'
For Laundry Seepage Pits: Number 1 Shape _____ Rectangular _____ Cylindrical ☒ Material Conc.
Width _____ Length _____ Total _____ Distance between pits _____
Diameter (if cylindrical) _____ Area Sq. Ft. (sides only) _____
Soil Is: () Loam. () Sandy Loam. () Clay. () Sandy Clay. ☒ Course sand, gravel. () Hardpan. () Rock.
Other sand


PERCOLATION TESTS:

PERFORMED BY: Maynard Thum Address: Englishtown Date: 4/24/79

Hole No.	Time In Min. Per In.	Number of Test To Determine Saturation	Depth	Type of Soil Encountered, Depth of Each Type
<u>1</u>	<u>7</u>	<u>3</u>	<u>52"</u>	<u>see Soil's Sheet.</u>

APPLICANTS FOR ALTERATIONS MUST FILL IN THE FOLLOWING:

Number of Occupants in dwelling _____ Automatic Dishwasher Yes _____ No _____
Automatic Clothes Washer Yes _____ No _____ Water softener discharged into Septic Tank Yes _____ No _____
Laundry waste discharged into Septic Tank Yes _____ No _____ Garbage Disposal Yes _____ No _____
Age of present system _____ Number of previous alterations _____
Year of last alteration _____ Date last septic tank pumping _____
Reason for failure present system _____

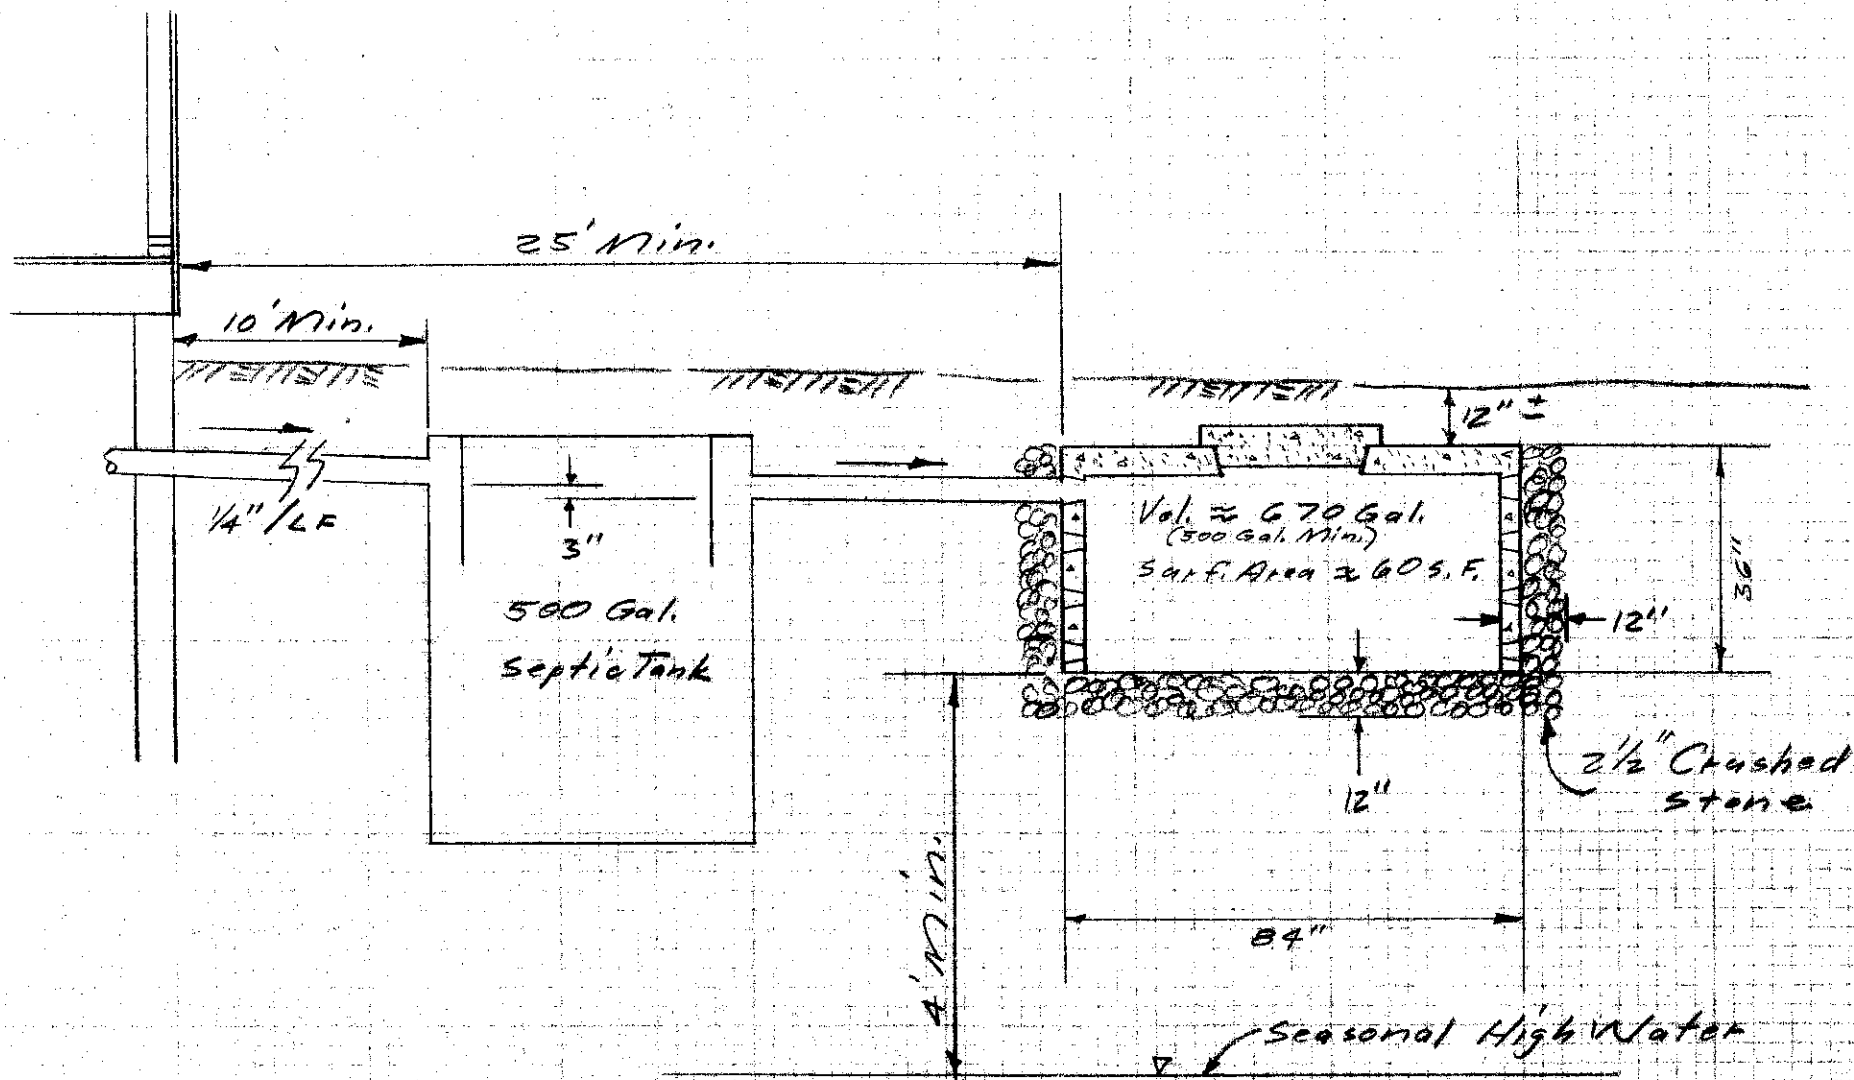


LAUNDRY WASTE DISPOSAL SYSTEM (N.T.S.)
Manalapan / Colts Neck

Lot 13-3

BEING KNOWN AS LOT 13-3, BLOCK 23 AS SHOWN ON "FINAL MAP OF BUCKSMILL ASSOCIATES" TOWNSHIP OF COLTS NECK MONMOUTH COUNTY, N.J. AND FILED AS CASE No. 153-B. FILED: 6/15/78.

ALSO BEING KNOWN AS LOT 13-3, BLOCK 23 AS SHOWN ON SHEET No. 4 OF THE TWP. OF COLTS NECK TAX MAP.

TIMBER LANE
(50' WIDE)

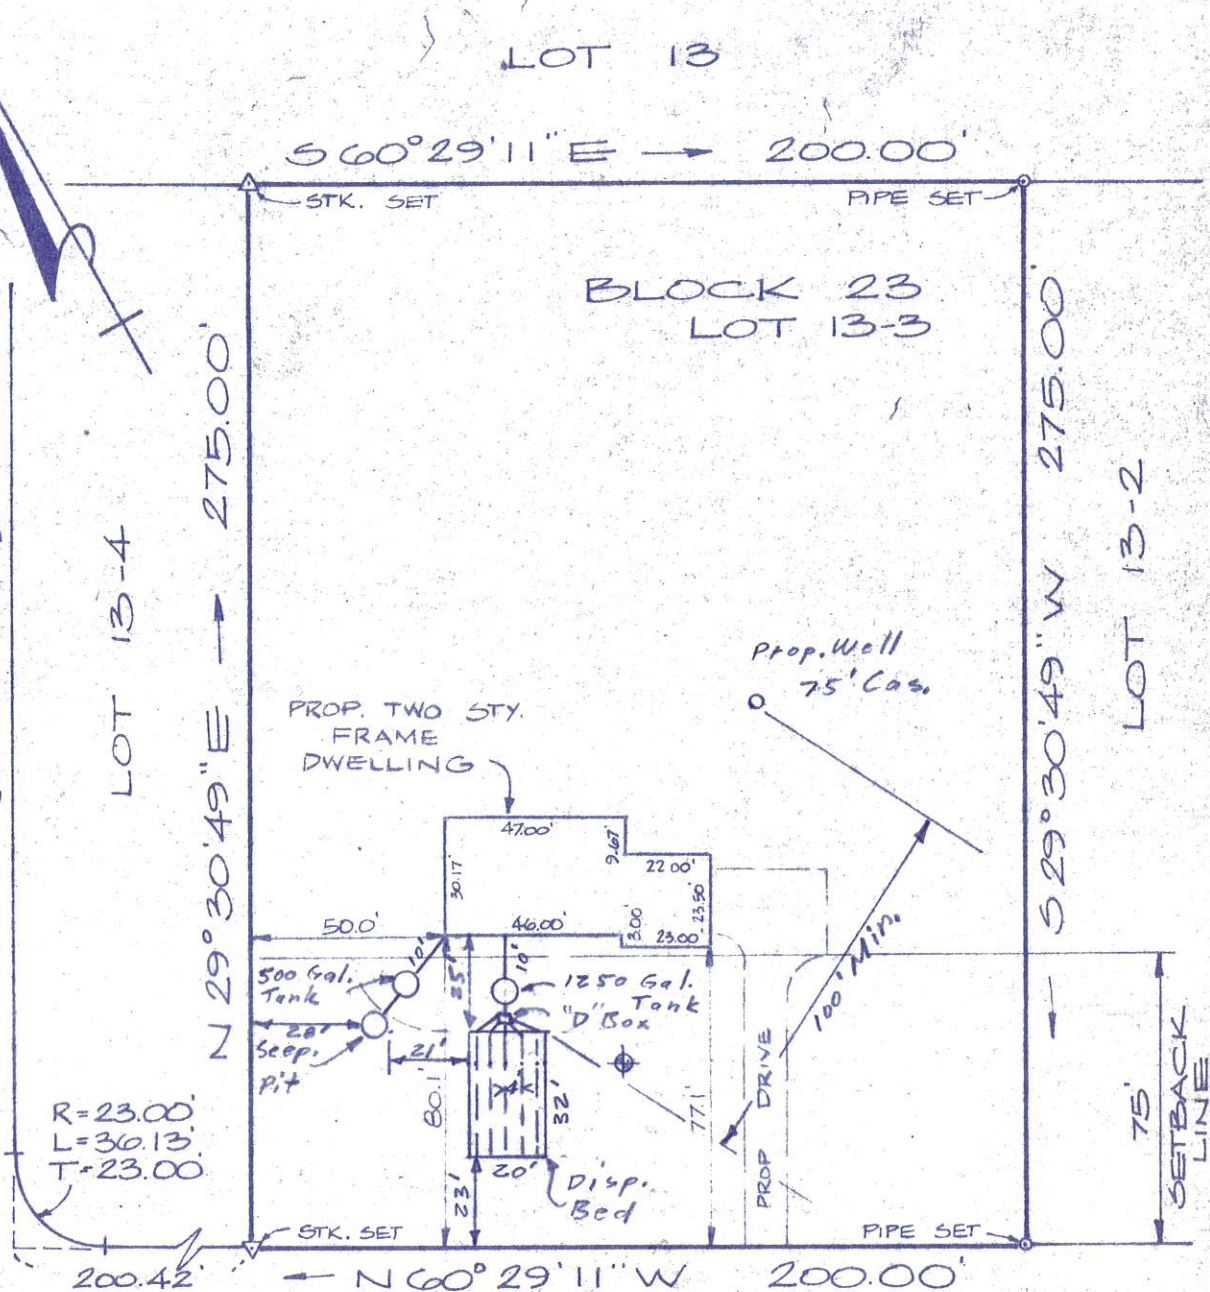

DEERPATH LANE
(50' WIDE)

4 H... Boring Location

SKETCH OF PROPERTY:

LOT 13-3, BLOCK 23

SITUATED IN
COLTS NECK TWP. MONMOUTH CO., N.J.



LANDTECH ENGINEERING AND
SURVEYING INC.

CONSULTING ENGINEERING - LAND SURVEYING - LAND PLANNING
R.D. 2, Box 95, HWY. 33 ENGLISHTOWN, N.J. 07726
(201) 446-6424 OR (201) 431-2855

MAYNARD THUM P.E. L.S.
NEW JERSEY LICENSE NO. 16713

3/26/81 1"=50' KGH MS L80-73 CN-2

Septic System Inspected
Well Inspected

BOARD OF HEALTH
TOWNSHIP OF COLTS NECK
COLTS NECK • NEW JERSEY

Permit No. 1088
Date 7/13/84

APPLICATION FOR

- PERMIT TO LOCATE AND CONSTRUCT AN INDIVIDUAL SEWAGE DISPOSAL SYSTEM.
.....✓..... PERMIT TO ALTER AN INDIVIDUAL SEWAGE DISPOSAL SYSTEM.

Location - Address Deerpath Lane or Block No. 23 Lot No. 13-3
Owner (Print) John Johnson
Present Address SAME AS ABOVE
Name and Address of Contractor (Print) S. H. Seplic Co. Inc. P.O. Box 401 Farmingdale N.J. 07727

Type of Building to be Served Residential Use: Yearly Summer
Dwelling Unit: No. of Bedrooms 4 Expansion Attic: Yes No
Other: Type of Business N/A No. Plumbing Units
Size of Lot Area Sq. Ft.

PRIMARY TREATMENT (For Definitions See Other Side)

Septic Tank Shape 1250/500 Rectangular# 1250/500 Cylindrical# Material
Width Length Liquid Depth Total Depth
Diameter (if cylindrical) Capacity (Gals.)

SECONDARY TREATMENT (For Definition See Other Side)

Disposal Trenches: Width Depth Area Sq. Ft.
Distance between lines Type and size of pipe
Disposal Bed: Width Length Area Sq. Ft.
Feet of pipe Type and size of pipe
Distance between lines
Seepage Pits: Number Shape Rectangular Cylindrical Material
Width Length Total Distance between pits
Diameter (if cylindrical) Area Sq. Ft. (sides only)
Soil Is: () Loam. () Sandy Loam. () Clay. () Sandy Clay. () Course sand, gravel. () Hardpan. () Rock.
Other

PERCOLATION TESTS:

PERFORMED BY:

Address:

Date:

Hole No.	Time In Min. Per In.	Number of Test To Determine Saturation	Depth	Type of Soil Encountered, Depth of Each Type

APPLICANTS FOR ALTERATIONS MUST FILL IN THE FOLLOWING:

Number of Occupants in dwelling 3 Automatic Dishwasher Yes No
Automatic Clothes Washer Yes No Water softener discharged into Septic Tank Yes No
Laundry waste discharged into Septic Tank Yes No Garbage Disposal Yes No
Age of present system 1 yr. Number of previous alterations None
Year of last alteration N/A Date last septic tank pumping N/A
Reason for failure present system Pool installed were Laundry System
Seepage pit is located:

(OVER)

MANALAPAN — COLTS NECK

Health Department

FEE SCHEDULE
BOARD OF HEALTH
COLTS NECK

BOX 15

TENNENT, NEW JERSEY 07763

PHONE 446-3200

462-5470

WILLIAM McBRIDE, JR.
Health Officer

ROBERT MANRELL
Sanitarian

THOMAS FRANK
Sanitarian

Septic.....\$25.00

Septic Alter..... 20.00

Well..... 40.00

Percolation..... 40.00

Home Owner OAK Park Homes

Contractor OAK Park Homes


Date September 7, 1983

Street Deer Path Lane

Block 23

Lot 13-3

AS-BUILT DESIGN

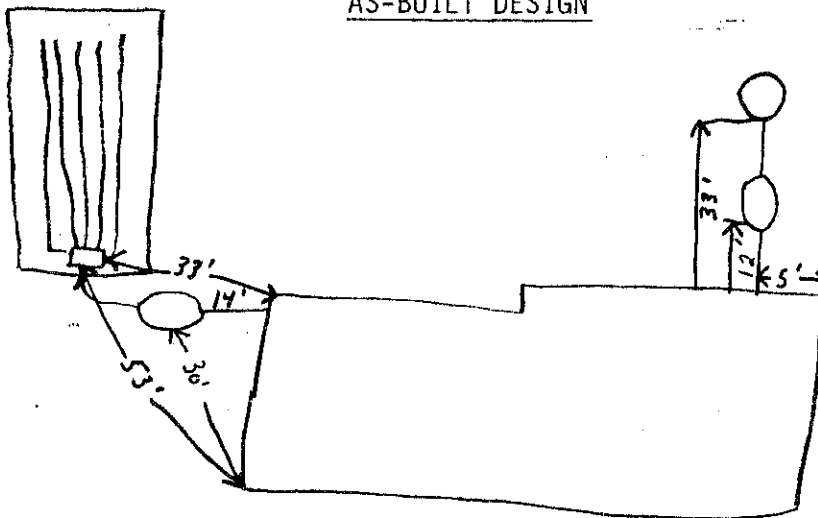

DEER PATH LANE

To All Contractors:

The following regulations apply to all permit applications (i.e. new construction and alterations to existing systems).

1. No work shall begin unless a permit is submitted, payed for, and approved by the Board of Health.
2. 24 hour advance notice is required for all required inspections.
3. Required inspections:
 - a. Preliminary inspection of excavated disposal area prior to the installation of filter material. (i.e. stone)

MANALAPAN — COLTS NECK

Health Department

BOX 15

TENNENT, NEW JERSEY 07763

PHONE 446-3200

462-5470


WILLIAM McBRIDE, JR.
Health Officer

ROBERT MANRELL
Sanitarian

THOMAS FRANK
Sanitarian

Home Owner John Johnson
Contractor Sitter Septic Co. Inc
Date July 9, 1984

Street Deerpark Lane.
Block 23
Lot 13-3

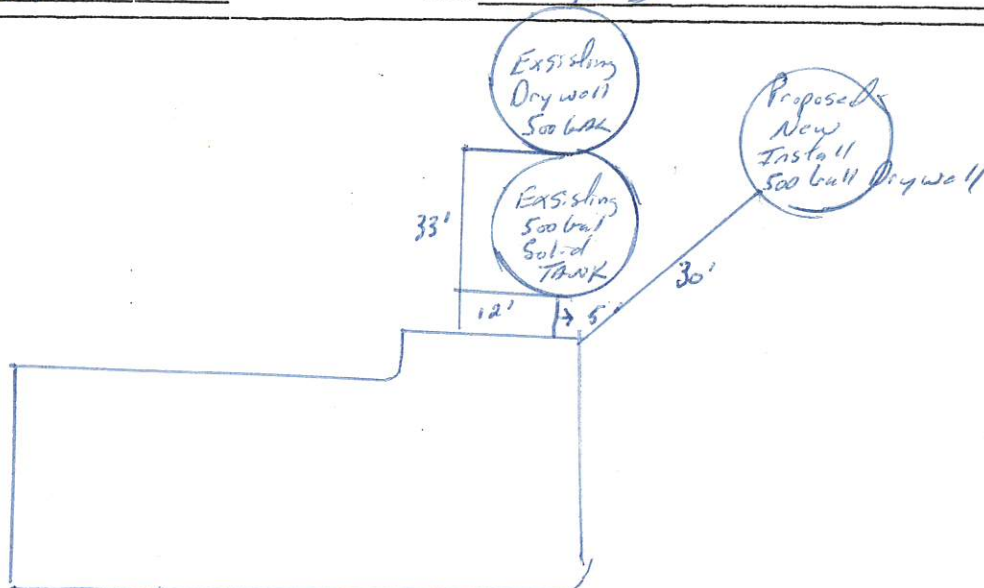

An "As Built" design must be submitted at the time of the final inspection, showing triangulation from the fixed points showing:

- A. Septic tank cleanout.
- B. Distribution box.
- C. Corners of disposal field and/or cleanout of seepage pits.
- D. Include well location, other water sources and distances.