

Board of Health
TOWNSHIP OF COLTS NECK

4437

FEE \$ 75 OK 7/20/01

Date 7/20/01

..... Permit to Construct a Septic System

☒ Permit to Alter a Septic System

..... Permit to Construct a Well

Permission is hereby granted to 2 River Eng.


Address PO Box 155 C.N. N.J.

to perform the above stated work at 20 Dunwoody

Blk. 23 Lot 13-3 Owned by —

Address S. L. in accordance
with the regulations of the Board of Health of the Township of Colts Neck, N. J.

[Signature]
Health Officer

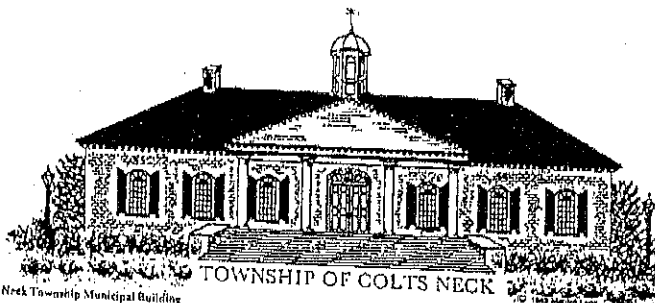

Colts Neck Township Municipal Building

Mailing Address: P.O. Box 249

Colts Neck, N.J. 07722

Cedar Drive, Colts Neck, New Jersey

Phone: (201) 462-5470

Fax: (201) 431-3173

APPLICATION FOR AN INDIVIDUAL SEWAGE DISPOSAL PERMIT

☐ original application
☐ to locate and construct
☐ to supplement
☐ revised application
☒ to alter/repair

Locations:

Address 22 Deerpath Block: 23 Lot: 13-3

Property Owner Walter Weadock Builder _____

Address: 22 Deerpath Phone 462-7664

Type of Building: Residential: _____ Other: _____ Sq. Ft: _____

No. of Bedrooms: _____ Expansion Room/Den: Yes: _____ No: _____
 Garbage Grinder: Yes: _____ No: _____ Volume of Sanitary Sewage (gal): _____

PreTreatment:

A) Septic Tank Material: Existing Capacity (gals): _____
 B) Grease Trap Material: _____ Capacity: _____
 C) Dosing Tank Material: _____ Capacity: _____

Disposal Bed

Width/Length _____
 Type/Ft. of pipe _____
 Dist. Between Pipe _____
 Req. Area _____
 Design Area _____

Trenches

Width/Length _____
 Dist. Between _____
 Depth _____
 Req. Area _____
 Design Area _____

Pits

Number 1 - 1800 gallon
 Material Concrete
 Length/Width/Diameter _____
 Req. Area _____
 Design Area _____

INCLUDE CROSS SECTIONS

Soil Characteristics:

Zone of Treatment: _____ Zone of Disposal: _____

Soil Investigator: Cara L Smith Phone: () 866-0111


Certifying Eng: Cara Smith Phone: () 866-0111

Engineer's Address P.O. Box 155, Colts Neck NJ 07722

Date of Soil Tests: 7/9/01 Witness: William McBride

PLEASE ATTACH THE FOLLOWING WITH APPLICATION:


- 1) ☒ Detailed soil logs & location
 2) _____ Ground Water Observation
 3) _____ I.D. of limiting zones
 4) _____ All permeability data (using applicable Chapt. 199 forms)
 5) _____ Interceptor Drain Details
 6) _____ Plot plan w/topography

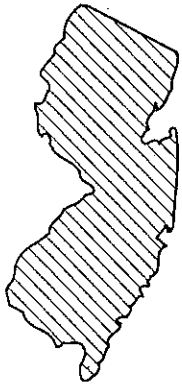



CENTRAL JERSEY SEPTIC INC.

7/13/01 AS BUILT
LOT 13-3 BLK 23
22 DEER PATH LANE
COLTS NECK, NJ

MAIN SEPTIC FIELD

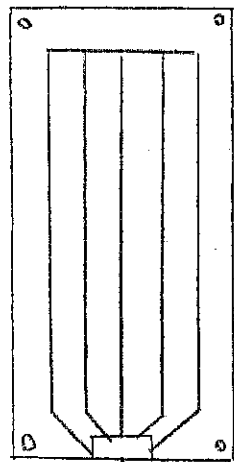

MAIN TANK

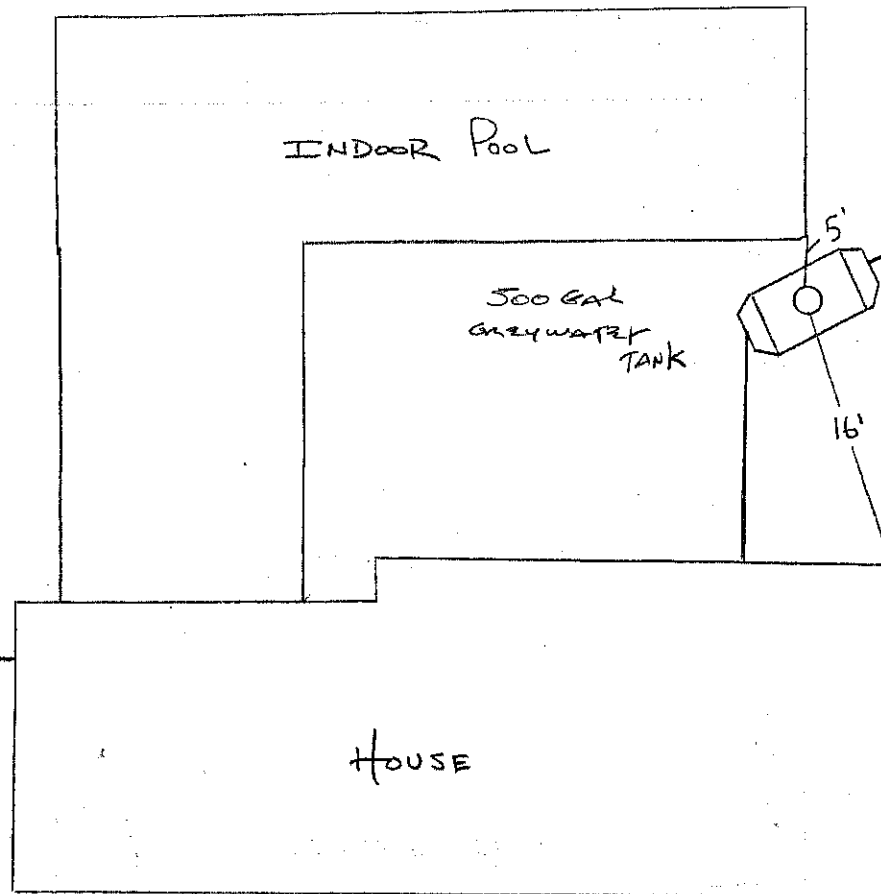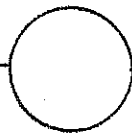

INDOOR POOL

500 GAL
GREY WATER
TANK

HOUSE

1800 GAL
SEEPAGE PIT

SHED

17'

23'

5'

16'