

OCEAN COUNTY HEALTH DEPARTMENT

6/22/10

Date

P.O. BOX 2191

TOMS RIVER, N.J. 08754-2191

(732) 341-9700

No. 042127

BOARD OF HEALTH OF JACKSON

CERTIFICATE OF COMPLIANCE

Issued to

Mike Walla

(Owner or Contractor)

THIS IS TO CERTIFY That the

INDIVIDUAL SEWAGE SYSTEM

Approved - Repair

INDIVIDUAL WATER SYSTEM

N/A

Installed at Block No.

21801

Lot No.

27

is in compliance with the

Application for Permit to Locate and Construct or

Alter Such Systems.

No.

042127

dated

6/22/2010

The issuance of this certification shall not be construed as a guarantee that the system will function satisfactorily nor shall it in any way restrict the powers or responsibilities of the Board of Health in the enforcement of any law or ordinance relating to public health.

Final

Approved

Reg. T. Brown

OCEAN COUNTY HEALTH DEPARTMENT
P.O. Box 2191, Sunset Avenue
Toms River, NJ 08754-2191

APPLICATION FOR A PERMIT TO INSTALL A SEPTIC SYSTEM
AND/OR A WATER SUPPLY SYSTEM

Comm. Code

15

Official Use Only

Block 58.02 - 21801

Lot(s) 2524 - 27

JACKSON
MUNICIPALITY

- (A) To construct both a septic & water supply system
— (B) To construct a water supply system
— (C) To replace or alter a water supply system
— (D) To construct or alter a septic system
☒ (E) To replace or repair a septic system

Type of Water System

- (A) Potable Non-Public
— (B) Potable Public Non-Community
— (C) Non-Potable
— (D) Public Community System

(Current address of applicant required. All information must be completed.)

NAME OF APPLICANT MIKE WALA PHONE NO. _____
ADDRESS 2524/2526 Lexington Jackson CITY RT STATE RI ZIP _____

DIRECTIONS TO LOCATION _____

WELL APPLICATION

TYPE OF CASING: Material _____ Diameter _____ Grade _____ Thickness _____

TYPE AND METHODS OF SEALING JOINTS: Type _____ Method _____

METHOD OF INSTALLATION _____ If Rotary or Auger, size of hole _____

GROUTING MATERIAL _____ Depth & Method of grouting: Depth _____

Method _____

STORAGE TANK CAPACITY _____ Model No. _____

WELL DRILLER _____ (Print) Lic. # _____ Driller Phone # _____

DRILLER _____ (Signature) State Well Permit # _____

NOTE: Copy of NJDEP "Permit to Drill Well" must be attached. Hose bibs are prohibited on non-potable well, unless such well is sampled. NJDEP's "Well Record" must be immediately submitted to the Health Department upon installation of well.

SEPTIC APPLICATION

TYPE OF BUILDING TO BE SERVED RES Dwelling Unit: No. of Bedrooms _____

EXPANSION ATTIC, DEN OR REC. ROOM: Yes No If yes, calculate as additional bedroom

PERCOLATION TEST PERFORMED BY Affordable Pumping Phone 866-22-0

WEATHER CONDITIONS AT TIME OF TEST _____

ENGINEER'S SIGNATURE AND SEAL _____

NOTE: All engineering data relating to soils, percolation & system design must be on engineer's drawing. Engineer's drawings must be signed & sealed by the engineer.

STATEMENT: Submit four (4) complete legible copies of applications, including engineer's & well driller's submissions. Final approval will only be granted after all inspections are completed, "as-built" drawings are submitted (where required) and satisfactory water analysis received, and all fees are paid. Permit is valid for one (1) year from date of issuance.


Repair - 14 x 22

Repair - 14 x 22

**INSPECTION REQUIRED PRIOR TO BACKFILL
ANY DEVIATION FROM THIS APPROVED PLAN
WILL REQUIRE ENGINEERING CORRECTION AND
SUBMITTAL OF NEW PLANS**

PG

cut

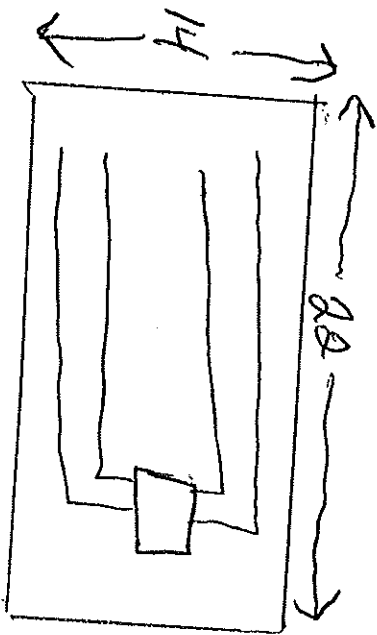

1800 Lx41

B-2182
1-27
2524
Lxwto 27 2526

city
water