


THIS SURVEY DOES NOT PURPORT TO IDENTIFY ENCROACHMENTS, UTILITIES, SERVICE LINES OR STRUCTURES ABOVE OR BELOW GRADE, IF ANY, EXCEPT AS SPECIFICALLY NOTED HEREON.

NO ATTEMPT WAS MADE TO DETERMINE IF ANY PORTION OF THESE PREMISES IS CLAIMED BY THE STATE OF NEW JERSEY OR THE UNITED STATES OF AMERICA AS TIDELANDS OR WETLANDS

LEGEND:

- S 0.00 = Spot Elevation
- p 0.00 = Proposed Fin. Grade
- TC 0.00 = Top of Curb Elev.
- G 0.00 = Gutter Elev.
- = Direction of Runoff
- Elevations refer to N.A.V.D. 1988

F.M. D-413

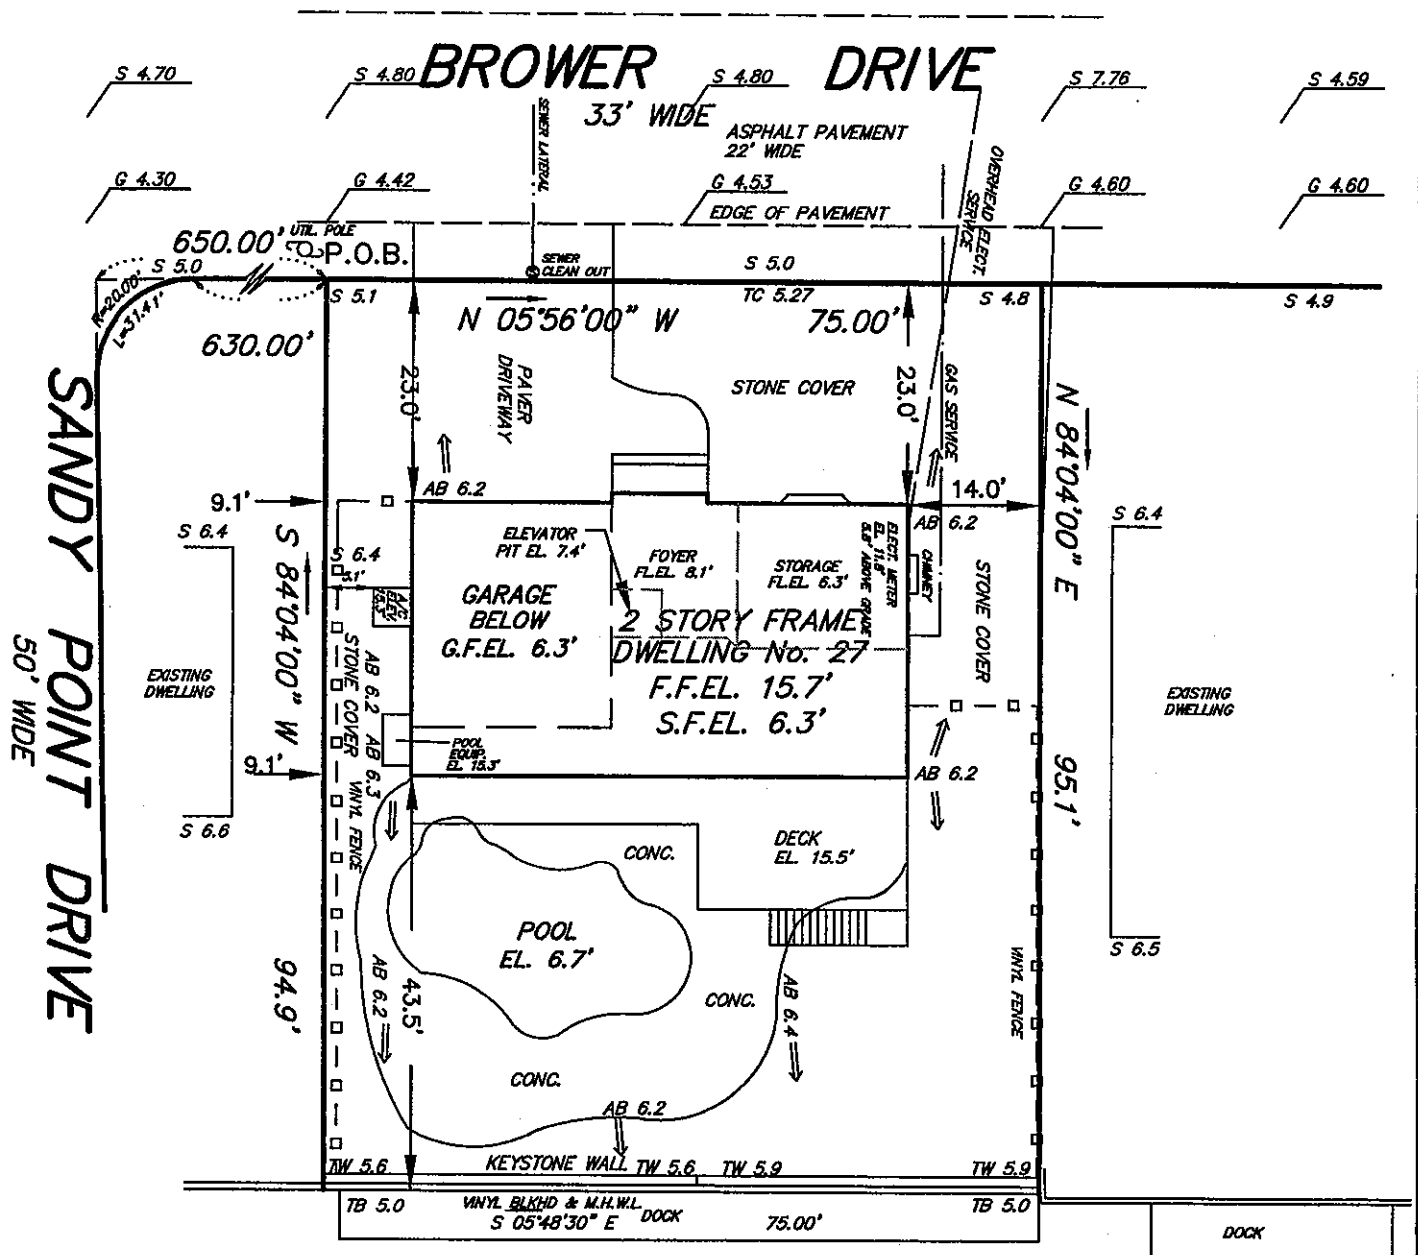

P.Q. IS FLOOD HAZARD ZONE AE EL. 5' AS PER F.I.R.M. #34029C0212F DATED 9/29/06.
PBFE IS AE EL. 8' AS PER F.I.R.M. #34029C0214G DATED 1/30/15.
ALSO KNOWN AS LOT 40 & 1/2 LOT 41
BLOCK 1 SANDY POINT, FILED IN THE
THE O.C.C.O. ON 10/2/1987 AS MAP No. D-413

*10/26/16-OK-Final

MAYFLOWER LAGOON

REVISED 10/20/16 - STOR. FL. EL.
REVISED 9/13/16 - FINAL AS-BUILT SURVEY
REVISED 3/30/16
REVISED 11/18/15 - FINAL AS-BUILT SURVEY
REVISED 4/9/15 - BANDING LOCATION
REVISED 8/10/14 - ADD TOPO ELEVATIONS

SURVEY OF PROPERTY
LOT 40 **BLOCK 89.01**
BRICK TOWNSHIP TAX MAP

BRICK TOWNSHIP
OCEAN COUNTY NEW JERSEY
FILED MAP CASE No. DATE FILED
THIS SURVEY IS CERTIFIED AS HAVING BEEN PREPARED
UNDER MY DIRECT SUPERVISION TO:
DION NATALE

R.H. MORRIS LAND SURVEYING
LAND SURVEYING & PLANNING
1123 MORRIS AVENUE
POINT PLEASANT BOROUGH, N.J. 08742
732-899-4387

ROBERT H. MORRIS

Date

New Jersey Lic. Professional Land Surveyor No. 30090
New Jersey Lic. Professional Planner No. 426600

I HEREBY CERTIFY THAT THIS SURVEY WAS ACTUALLY
MADE ON THE GROUND AS PER RECORD DESCRIPTION
AND IS CORRECT AND THERE ARE NO ENCROACHMENTS
EITHER WAY ACROSS PROPERTY LINES EXCEPT AS SHOWN

Date:	Scale:	Job No.	Map No.
10/22/02	1"=20'	02-224	2-3232


THIS SURVEY DOES NOT PURPORT TO IDENTIFY ENCROACHMENTS, UTILITIES, SERVICE LINES OR STRUCTURES ABOVE OR BELOW GRADE, IF ANY, EXCEPT AS SPECIFICALLY NOTED HEREON.

NO ATTEMPT WAS MADE TO DETERMINE IF ANY PORTION OF THESE PREMISES IS CLAIMED BY THE STATE OF NEW JERSEY OR THE UNITED STATES OF AMERICA AS TIDELANDS OR WETLANDS

LEGEND:

S 0.00 = Spot Elevation
p 0.00 = Proposed Fin. Grade
TC 0.00 = Top of Curb Elev.
G 0.00 = Gutter Elev.
→ = Direction of Runoff
Elevations refer to N.A.V.D. 1988

F.M. D-413

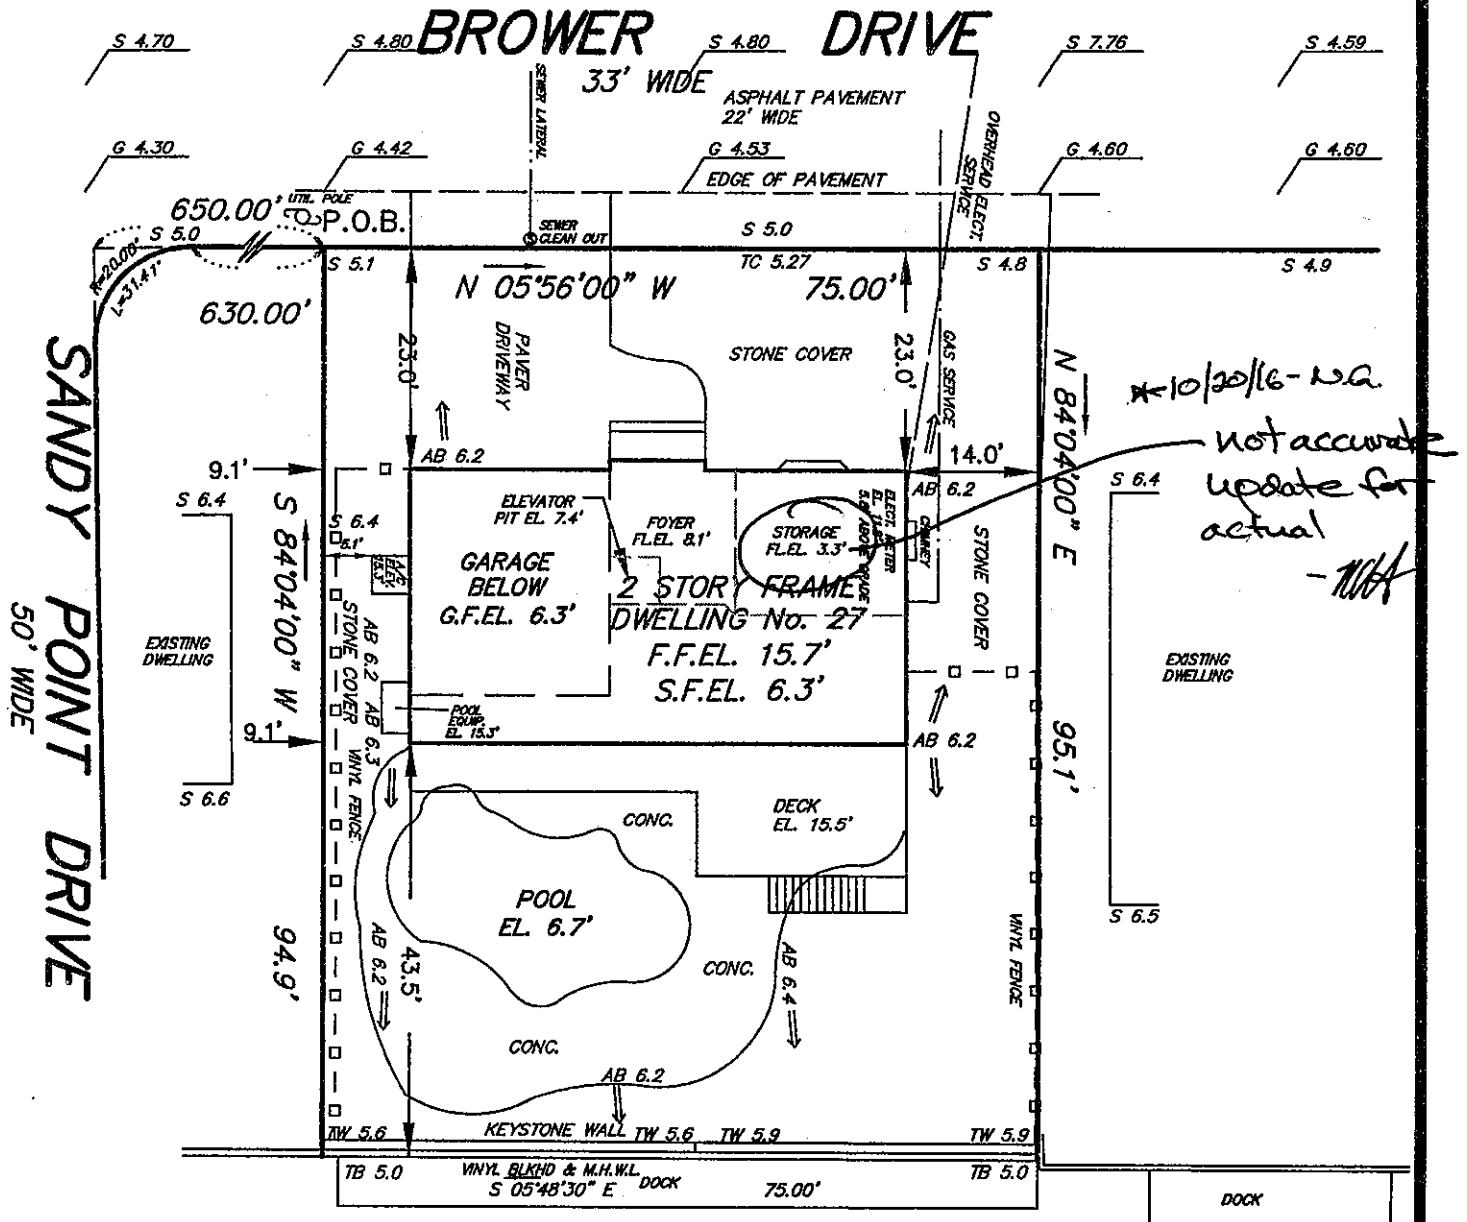

P.Q. IS FLOOD HAZARD ZONE AE EL. 5' AS PER F.I.R.M. #34029C0212F DATED 9/29/06.
PBFE IS AE EL. 8' AS PER F.I.R.M. #34029C0214G DATED 1/30/15.
ALSO KNOWN AS LOT 40 & 1/2 LOT 41
BLOCK 1 SANDY POINT, FILED IN THE
THE O.C.C.O. ON 10/2/1987 AS MAP No. D-413

REVISED 9/13/16 - FINAL AS-BUILT SURVEY
REVISED 3/30/16
REVISED 11/18/15 - FINAL AS-BUILT SURVEY
REVISED 4/9/15 - BANDING LOCATION
REVISED 8/10/14 - ADD TOPO ELEVATIONS

SURVEY OF PROPERTY
LOT 40 BLOCK 89.01
BRICK TOWNSHIP TAX MAP

BRICK TOWNSHIP
OCEAN COUNTY NEW JERSEY
FILED MAP CASE No. DATE FILED
THIS SURVEY IS CERTIFIED AS HAVING BEEN PREPARED
UNDER MY DIRECT SUPERVISION TO:
DION NATALE

R.H. MORRIS LAND SURVEYING
LAND SURVEYING & PLANNING
1123 MORRIS AVENUE
POINT PLEASANT BOROUGH, N.J. 08742
732-899-4387

ROBERT H. MORRIS Date
New Jersey Lic. Professional Land Surveyor No. 30090
New Jersey Lic. Professional Planner No. 426600

I HEREBY CERTIFY THAT THIS SURVEY WAS ACTUALLY
MADE ON THE GROUND AS PER RECORD DESCRIPTION
AND IS CORRECT AND THERE ARE NO ENCROACHMENTS
EITHER WAY ACROSS PROPERTY LINES EXCEPT AS SHOWN

Date:	Scale:	Job No.	Map No.
10/22/02	1"=20'	02-224	2-3232