

NOTE:
PIPE BENEATH DRIVEWAY SHALL
BE ENCASED IN CONCRETE 6"
ALL AROUND

PROPOSED 4 BR
DWELLING

PROVIDE
DIVERSION
BERM

PERC TESTS
1 Soil Log #1

DISPOSAL BED

DISTRIBUTION BOX

1000 GAL. SEPTIC TANK

PROPOSED
WELL

PLACE NO STONE UNTIL
DEPTH OF BED OR TRENCHES
IS INSPECTED

4.5 AC ±

232' ±

200' ±

487' ±

PLOT PLAN
SEWAGE DISPOSAL SYSTEM
LOT 24 BLOCK 28
TEWKSBURY TOWNSHIP HUNTERDON COUNTY
NEW JERSEY

CARLTON N. FROST *Carlton N. Frost*

Professional Engineer & Land Surveyor • N. J. Lic. No. 12672
Professional Planner • N. J. Lic. No. 1875

ASSOCIATED
CONSULTANTS

ENGINEERS AND LAND SURVEYORS INC.
PROFESSIONAL PLANNERS

PERRY STREET
CHESTER, N.J. 07930
Tel: (201) 879-6400

SCALE: 1"=40'

DATE: 4-17-86

DESIGNED BY: CNF


DRAWN BY: WES

BOOK:

FILE: 2683

NO.	DATE REVISION	DESCRIPTION

BRUNING 40-22 48444

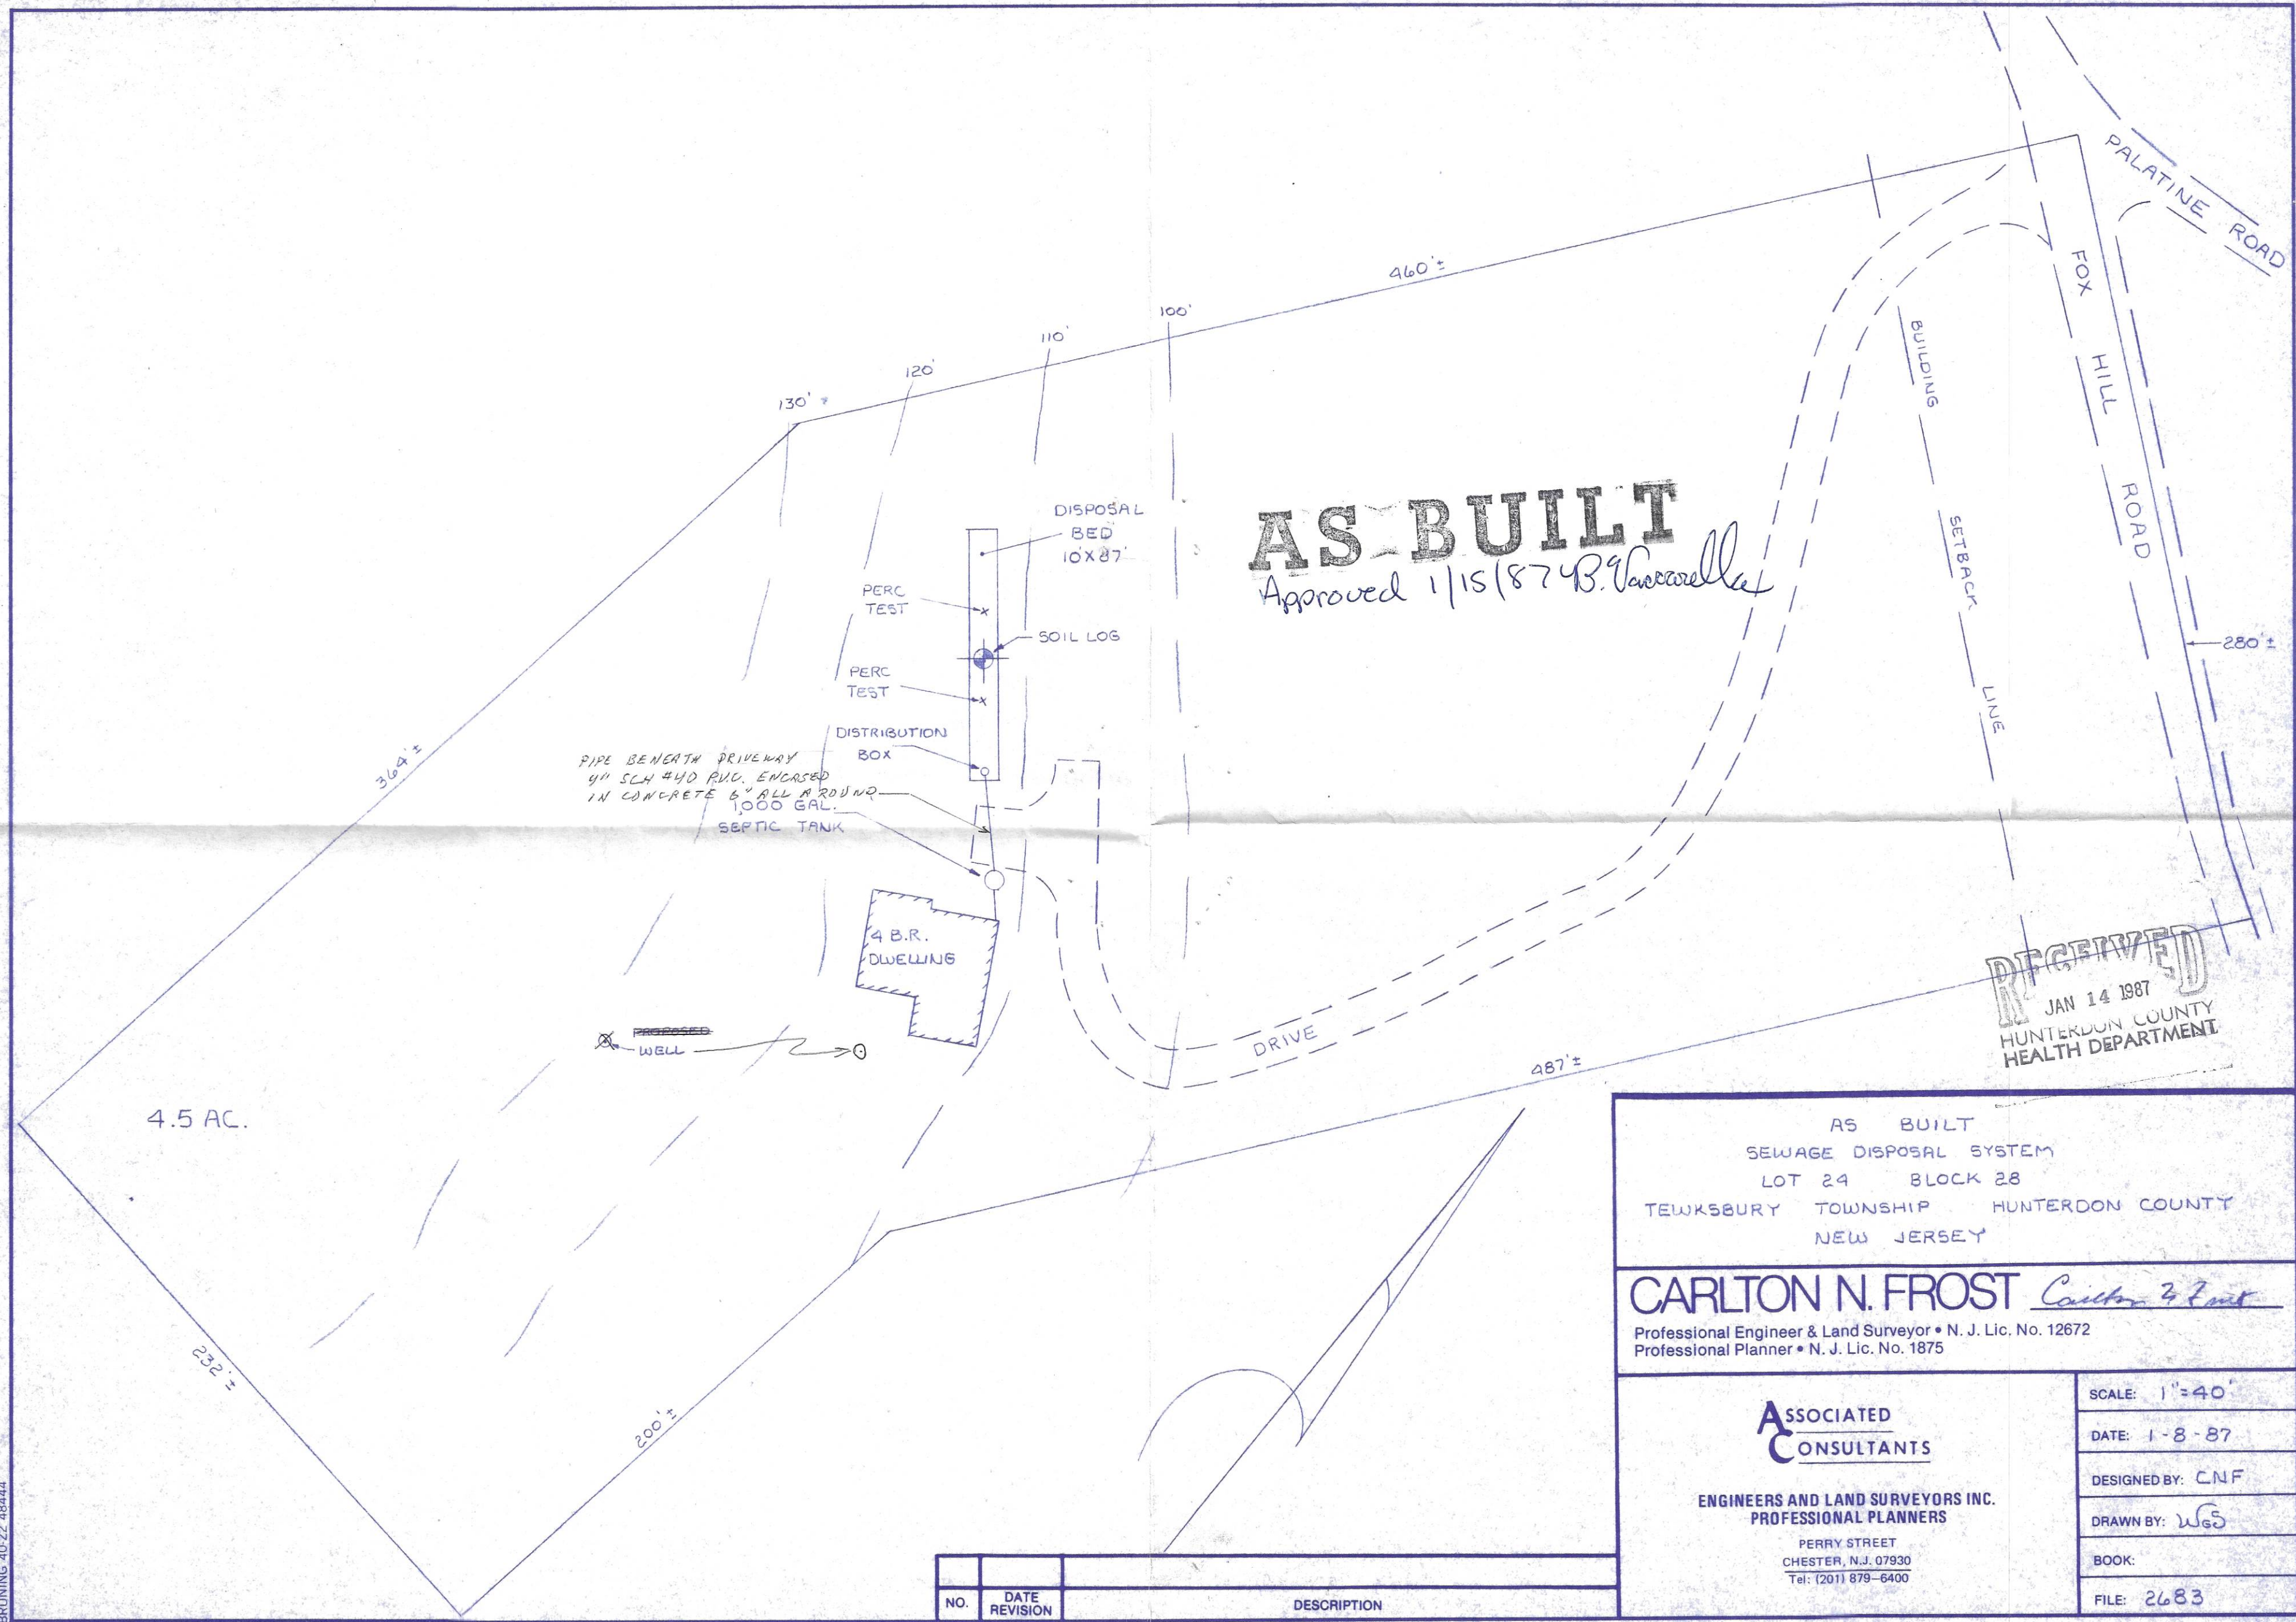

RECEIVED
JAN 14 1987
HUNTERDON COUNTY
HEALTH DEPARTMENT

AS BUILT SEWAGE DISPOSAL SYSTEM LOT 24 BLOCK 28 TEWKSBURY TOWNSHIP HUNTERDON COUNTY NEW JERSEY	
CARLTON N. FROST <i>Carlton N. Frost</i> Professional Engineer & Land Surveyor • N. J. Lic. No. 12672 Professional Planner • N. J. Lic. No. 1875	
ASSOCIATED CONSULTANTS ENGINEERS AND LAND SURVEYORS INC. PROFESSIONAL PLANNERS PERRY STREET CHESTER, N.J. 07930 Tel: (201) 879-6400	SCALE: 1"=40'
	DATE: 1-8-87
	DESIGNED BY: CNF
	DRAWN BY: WGS
	BOOK:
FILE: 2683	

NO.	DATE REVISION	DESCRIPTION