

GREGORY E. YANNACCONE
N.J. PROFESSIONAL ENGINEER
NO. 39904 DATE: 1/8/07

NOT VALID WITHOUT SIGNATURE AND RAISED SEAL

NO. DATE REVISION

PROJECT TITLE :
**RAUSCHKOLB
PROPERTY**
LOT 36 ~ BLOCK 26.01
CHESTER TOWNSHIP
MORRIS COUNTY, NEW JERSEY



SHEET TITLE :
**SEPTIC
AS-BUILT**

DRAWN BY: EL DATE: 1/8/07
CHECKED BY: GEY SCALE: 1"=30'

W.O. 206131
F.B. -
FILE:
COMP FILE: M:SEPTIC/206131/LOT36AB

SHEET 1 OF 1

	TIE DISTANCES		
	HOUSE CORNER		
	"1"	"2"	"3"
SEPTIC TANK #1	92.1'	36.1'	44.2'
EXISTING SEPTIC TANK #2	107'	47.6'	34.0'
DISPOSAL BED CORNER "A"	28.8'	73.4'	
DISPOSAL BED CORNER 'B'	52.8'	85.5'	
DISPOSAL BED CORNER "C"	67.5'	54.9'	
DISPOSAL BED CORNER 'D'	52.5'	33.8'	
EXISTING SEPTIC E		+ - 46'	+ - 81'
EXISTING SEPTIC F		+ - 67'	+ - 56'

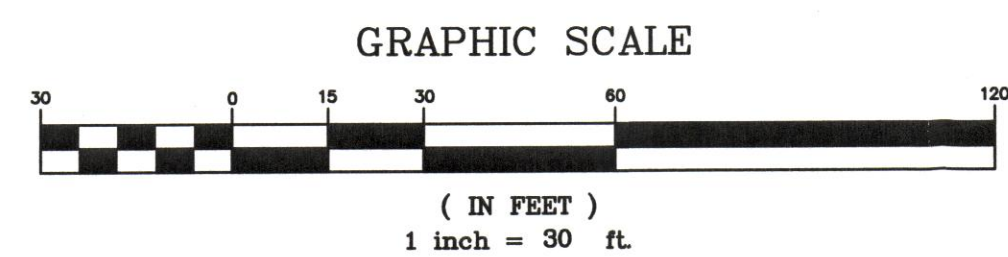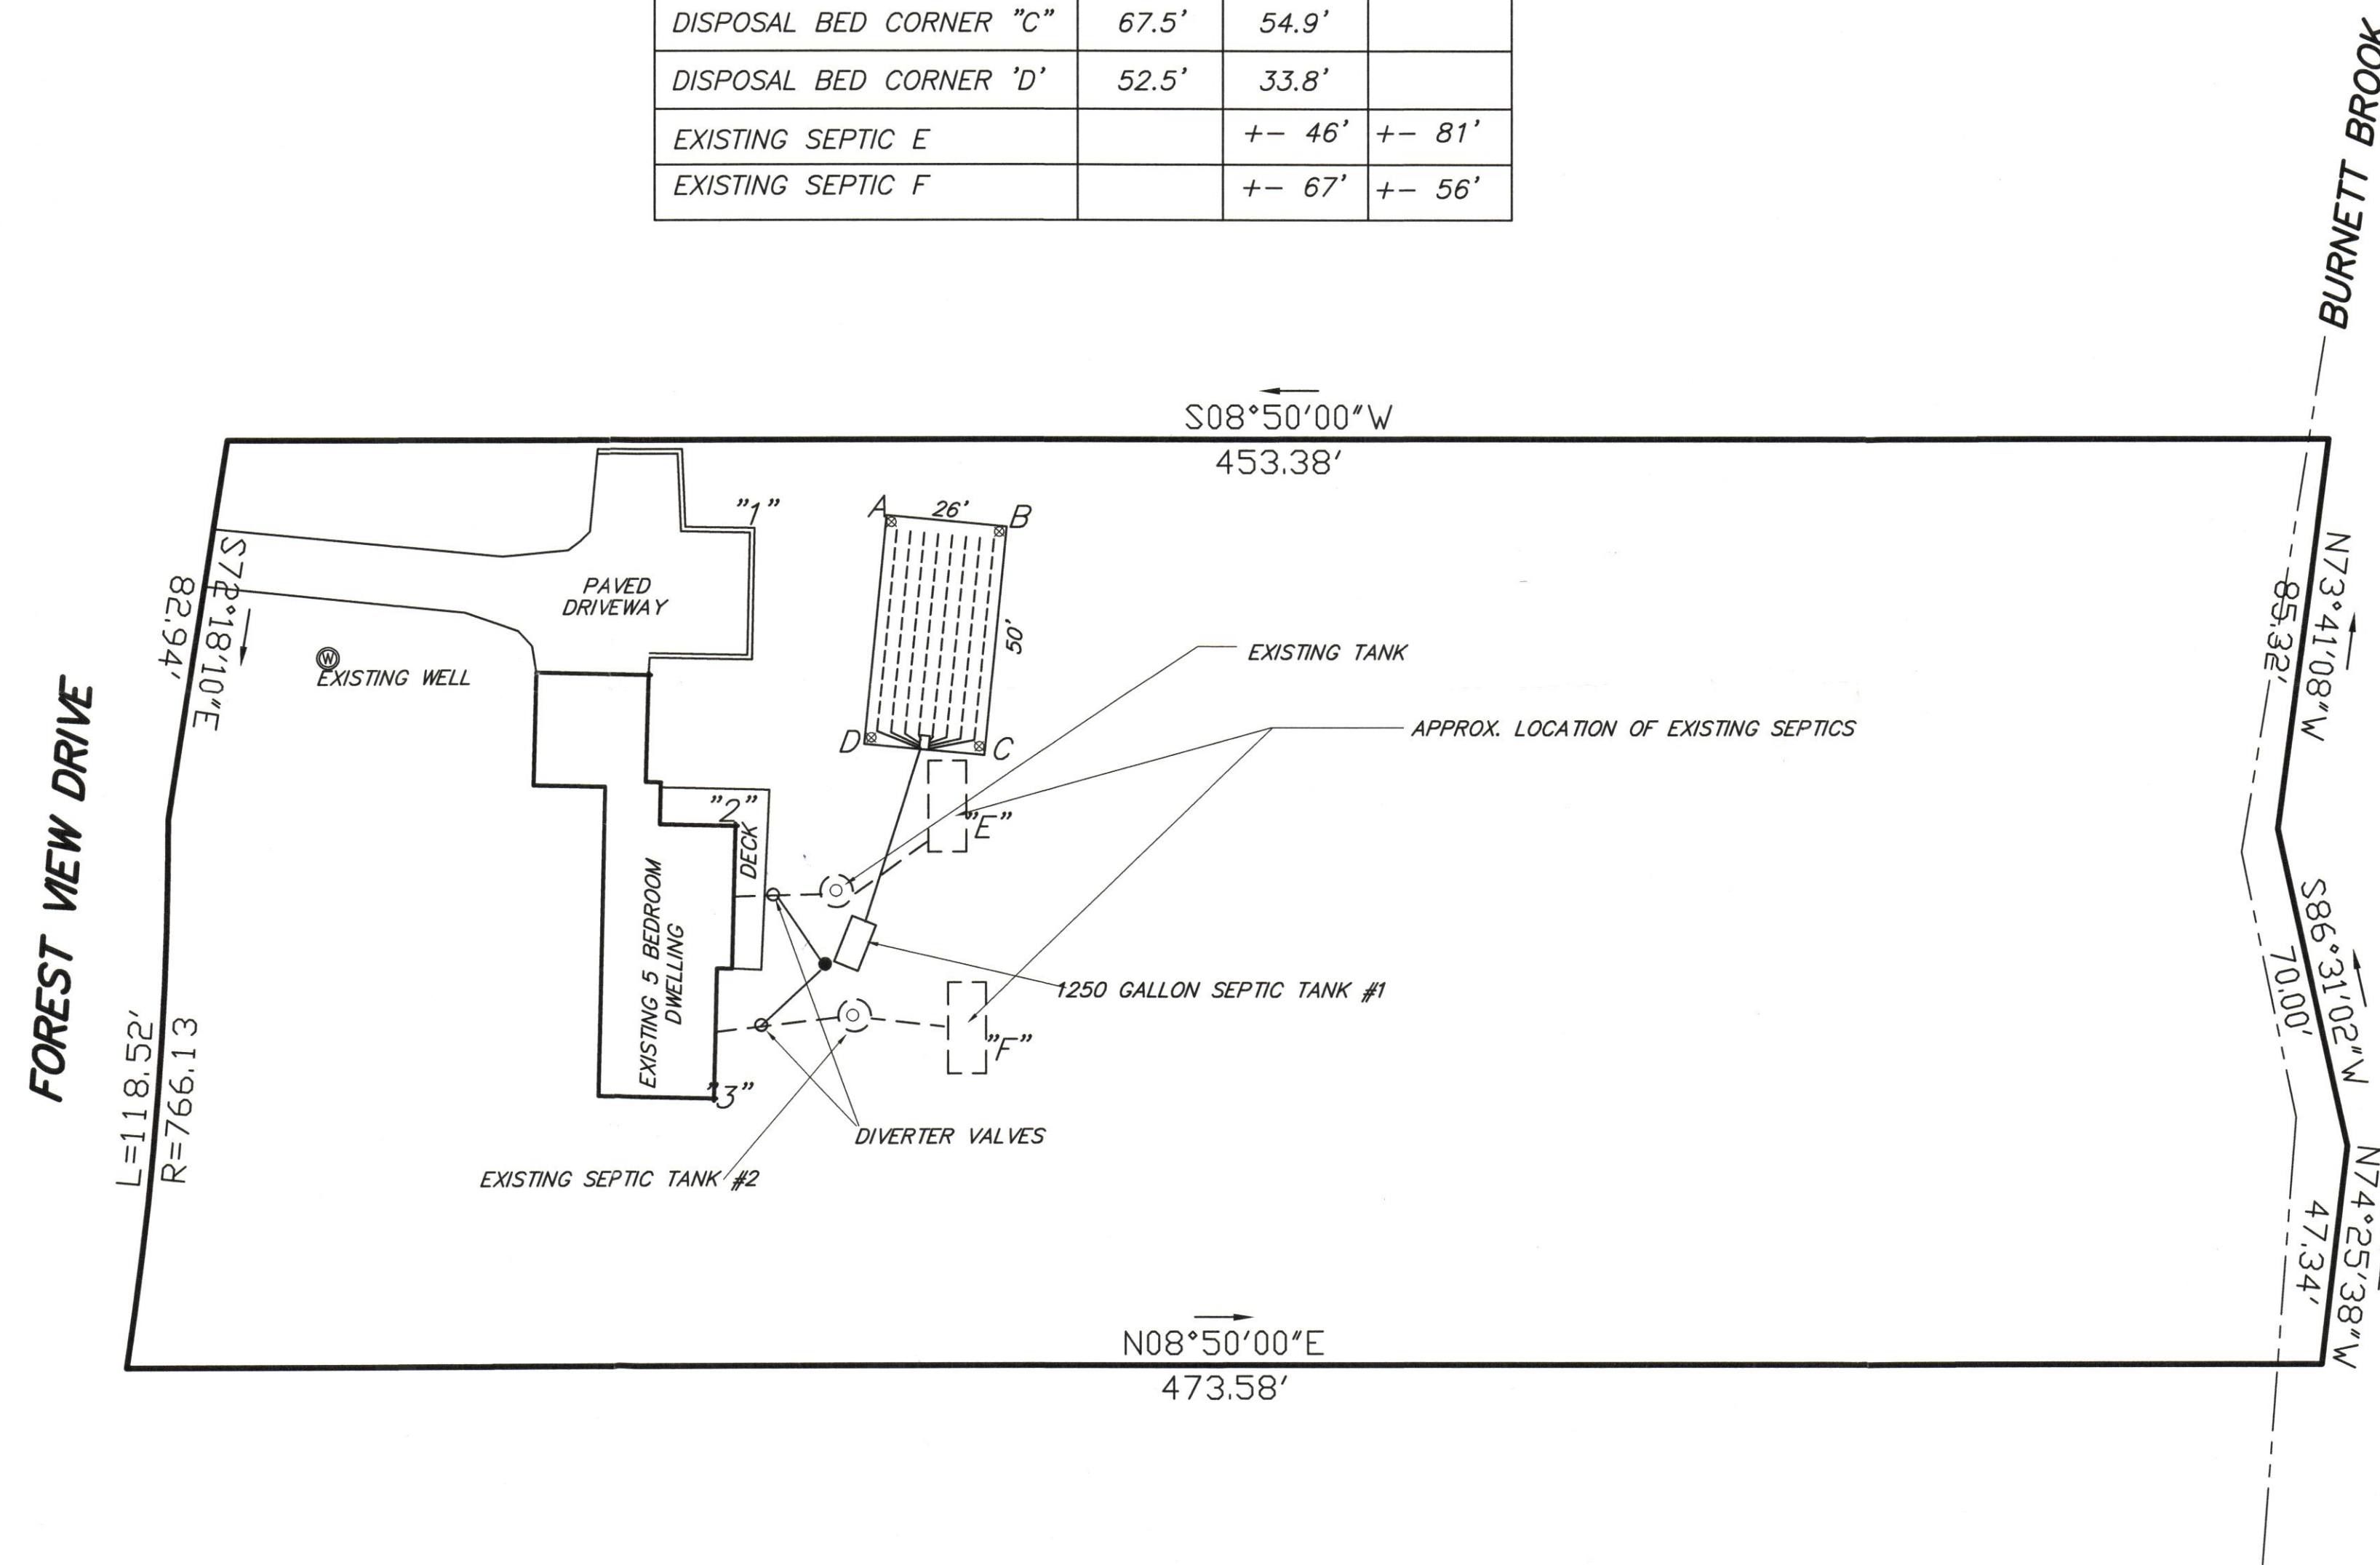

LEGEND
⊗ DENOTES INSPECTION PORT
• DENOTES CLEANOUT

NOTE: SURVEY INFORMATION IS BASED ON A PLAN PREPARED BY:
THOMAS C. YEAGER, NJPLS No. 32656, DATED AUGUST 17, 2006