

John Protonentis, REHS
Environmental Health Coordinator
Environmental & Consumer Health
Email: jprotonentis@ochd.org



OCEAN COUNTY HEALTH DEPARTMENT

P.O. Box 2191
175 Sunset Avenue
Toms River, NJ 08754-2191
(732) 341-9700 ext. 7416
Fax: (732) 286-1495
www.ochd.org

DATE: 3/27/2023

FILE #: 058778

CERTIFICATE OF COMPLIANCE

Issued to: Daniel + Nora Hirschfeld

THIS IS TO CERTIFY THAT THE:

Individual Sewage System: SEWER Abandonment
Engineer Certification

Individual Water System: N/A

Located in: JACKSON
Municipality

At Block: 3801 Lot: 59 Is in compliance with the
application for permit to locate, construct and/or alter such systems.

File #: 058778 Dated: 11/8/2023

The issuance of this certification shall not be construed as a guarantee that the system will function satisfactorily nor shall it in any way restrict the powers or responsibilities of the Board of Health in the enforcement of any law or ordinance relating to public health.

✓ Final Approval

[Signature]
Inspecting Official

Certificate Of Compliance

County/Municipality: Ocean County / Jackson Township

INSTRUCTIONS: Part A is to be completely filled in for all Certifications. Only Part B or Part C will be completed. Part B will be completed if the administrative authority relies upon the certification signed and sealed by a New Jersey licensed professional engineer that the system has been located, constructed, installed or altered in compliance with the requirements of N.J.A.C. 7:9A-1 and the Application to Construct/Alter/Repair an Individual Subsurface Sewage Disposal System which was approved by the administrative authority. Part C will be completed if the administrative authority performs the certification.

Part A—General Information

1. Permitted Activities (Check applicable categories):

Permit Number: 058777

- ☐ New Construction
☐ Alteration/No Expansion or Change of Use
☐ Alteration/Expansion or Change in Use
☒ Alteration/Malfunctioning System
☐ Deviation from Standards
☐ Repairs to Existing System

2. Location of Project:

Municipality: Jackson Township Old Lot 20.01 Old Block 98.02
New Lot 59 New Block 3801

Street Address: 557 Burke Road

3. Name and Present Address of Applicant:

Daniel and Nora Hirschfeld
557 Burke Road
Jackson, NJ 08527

Applicant's Phone Number: (732) 552-5273

Part B—Professional Engineers Certification

I certify under penalty of law that the subsurface sewage disposal system identified in Part A has been located, constructed, installed or altered in compliance with the requirements of N.J.A.C. 7:9A-1 and the Application to Construct/Alter/Repair an Individual Subsurface Sewage Disposal System which was approved by the administrative authority. I am aware that there are significant penalties for submitting false information, including the possibility of fine and imprisonment.


Cara L. Smith, P.E. N.J.P.E. # 37929

3-13-23
Date

Part C—Certification by Administrative Authority

I certify under penalty of law that the subsurface sewage disposal system identified in Part A has been located, constructed, installed or altered in compliance with the requirements of N.J.A.C. 7:9A-1 and the Application to Construct/Alter/Repair an Individual Subsurface Sewage Disposal System which was approved by the administrative authority. I am aware that there are significant penalties for submitting false information, including the possibility of fine and imprisonment.

Authorized Signature Type of License Held _____

Name (Typed or Printed) License Number _____



Ocean
County
Health
Department

Environmental Health Services

175 Sunset Ave.
P.O. Box 2191
Toms River, NJ 08754
(732) 341-9700 ext. 7416
www.ochd.org



Public Health
Prevent. Promote. Protect

APPLICATION FOR A PERMIT TO INSTALL A SEPTIC SYSTEM AND/OR A WATER SUPPLY SYSTEM

OCEAN COUNTY
HEALTH DEPARTMENT
NO. 1
058778 1/18/2023

<u>Jackson</u> MUNICIPALITY	☐ (A) To construct both a septic & water supply system	Type of Water System ☒ (A) Potable Non-Public ☐ (B) Potable Public Non-Community ☐ (C) Non-Potable ☐ (D) Public Community System
Comm. Code <u>15</u> Official Use Only	☐ (B) To construct a water supply system	
Block <u>Old: 98.02 New 3801</u>	☐ (C) To replace or alter a water supply system	
Lot(s) <u>Old: 20.01 New 59</u>	☐ (D) To construct or alter a septic system	
	☐ (E) To replace or repair a septic system	
	☒ (F) Abandonment	

(Current address of applicant required. All information must be completed.)

NAME OF APPLICANT Daniel + Nora Hirschfeld PHONE NO. 732-552-5273
ADDRESS 557 Burke Rd CITY Jackson STATE NJ ZIP 08527
DIRECTIONS TO LOCATION Cobain Rd to Burke Rd

WELL APPLICATION

TYPE OF CASING: Material _____ Diameter _____ Grade _____ Thickness _____
TYPE AND METHODS OF SEALING JOINTS: Type _____ Method _____
METHOD OF INSTALLATION _____ If Rotary or Auger, size of hole _____
GROUTING MATERIAL _____ Depth & Method of grouting: Depth _____
Method _____
STORAGE TANK CAPACITY _____ Model No. _____
WELL DRILLER _____ Lic # _____ Driller Phone # _____
(Print)
DRILLER _____ State Well Permit # _____
(Signature)








NOTE: Copy of NJDEP "Permit to Drill Well" must be attached. Hose bibs are prohibited on non-potable well, unless such well is sampled. NJDEP's "Well Record" must be immediately submitted to the Health Department upon installation of well.

SEPTIC APPLICATION

TYPE OF BUILDING TO BE SERVED residential Dwelling Unit: No. of Bedrooms 2
EXPANSION ATTIC, DEN OR REC. ROOM: Yes ☒ No ☐ If yes, calculate as additional bedroom _____
PERCOLATION TEST PERFORMED BY Cara L. Smith, P.E. Date 12-20-22 Phone 732-866-0111
WEATHER CONDITIONS AT TIME OF TEST Sunny 45°
ENGINEER'S SIGNATURE AND SEAL [Signature]

NOTE: All engineering data relating to soils, percolation & system design must be on engineer's drawing. Engineer's drawings must be signed & sealed by the engineer.

STATEMENT: Submit four (4) complete legible copies of applications, including engineer's & well driller's submissions. Final approval will only be granted after all inspections are completed, "as-built" drawings are submitted (where required) and satisfactory water analysis received, and all fees are paid. Permit is valid for one (1) year from date of issuance.

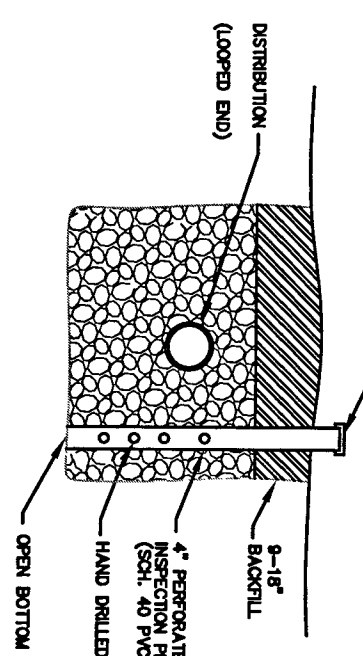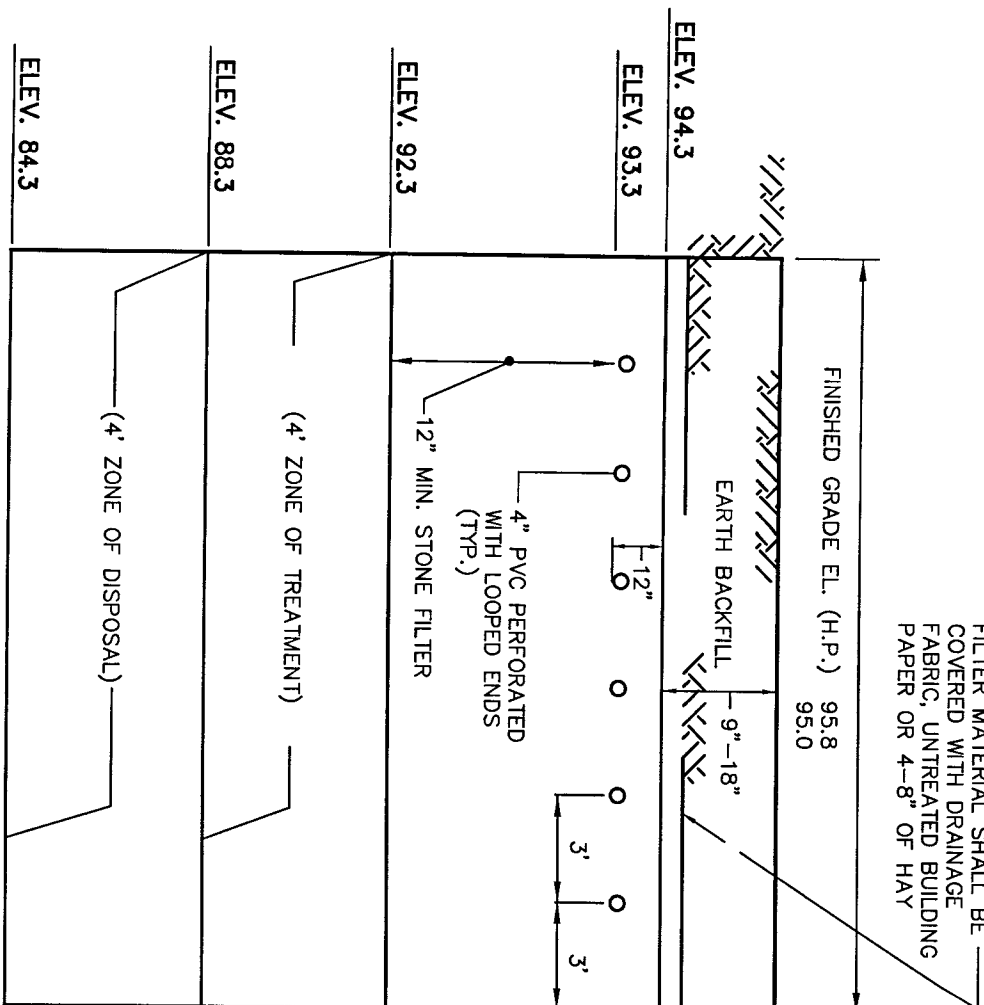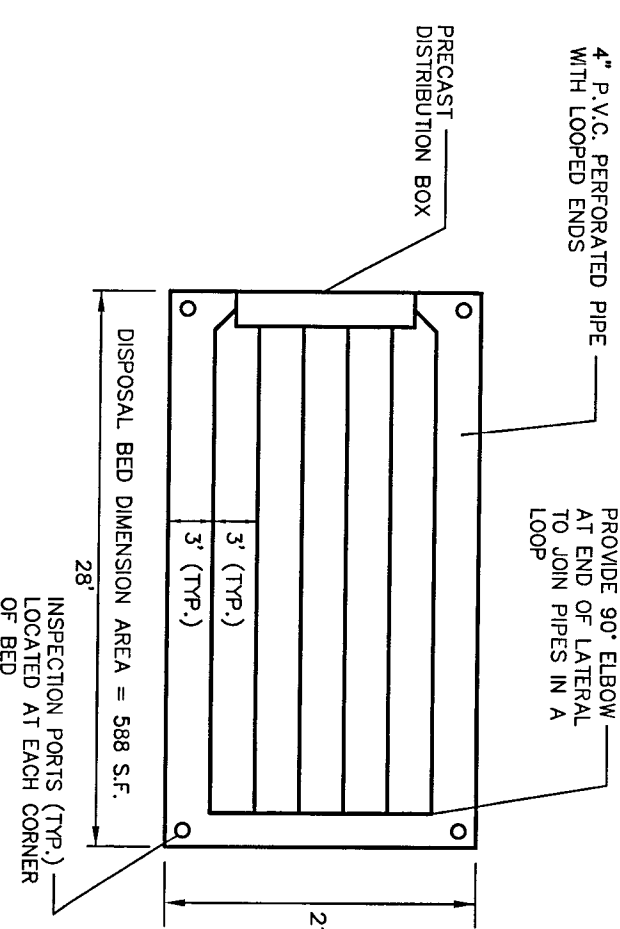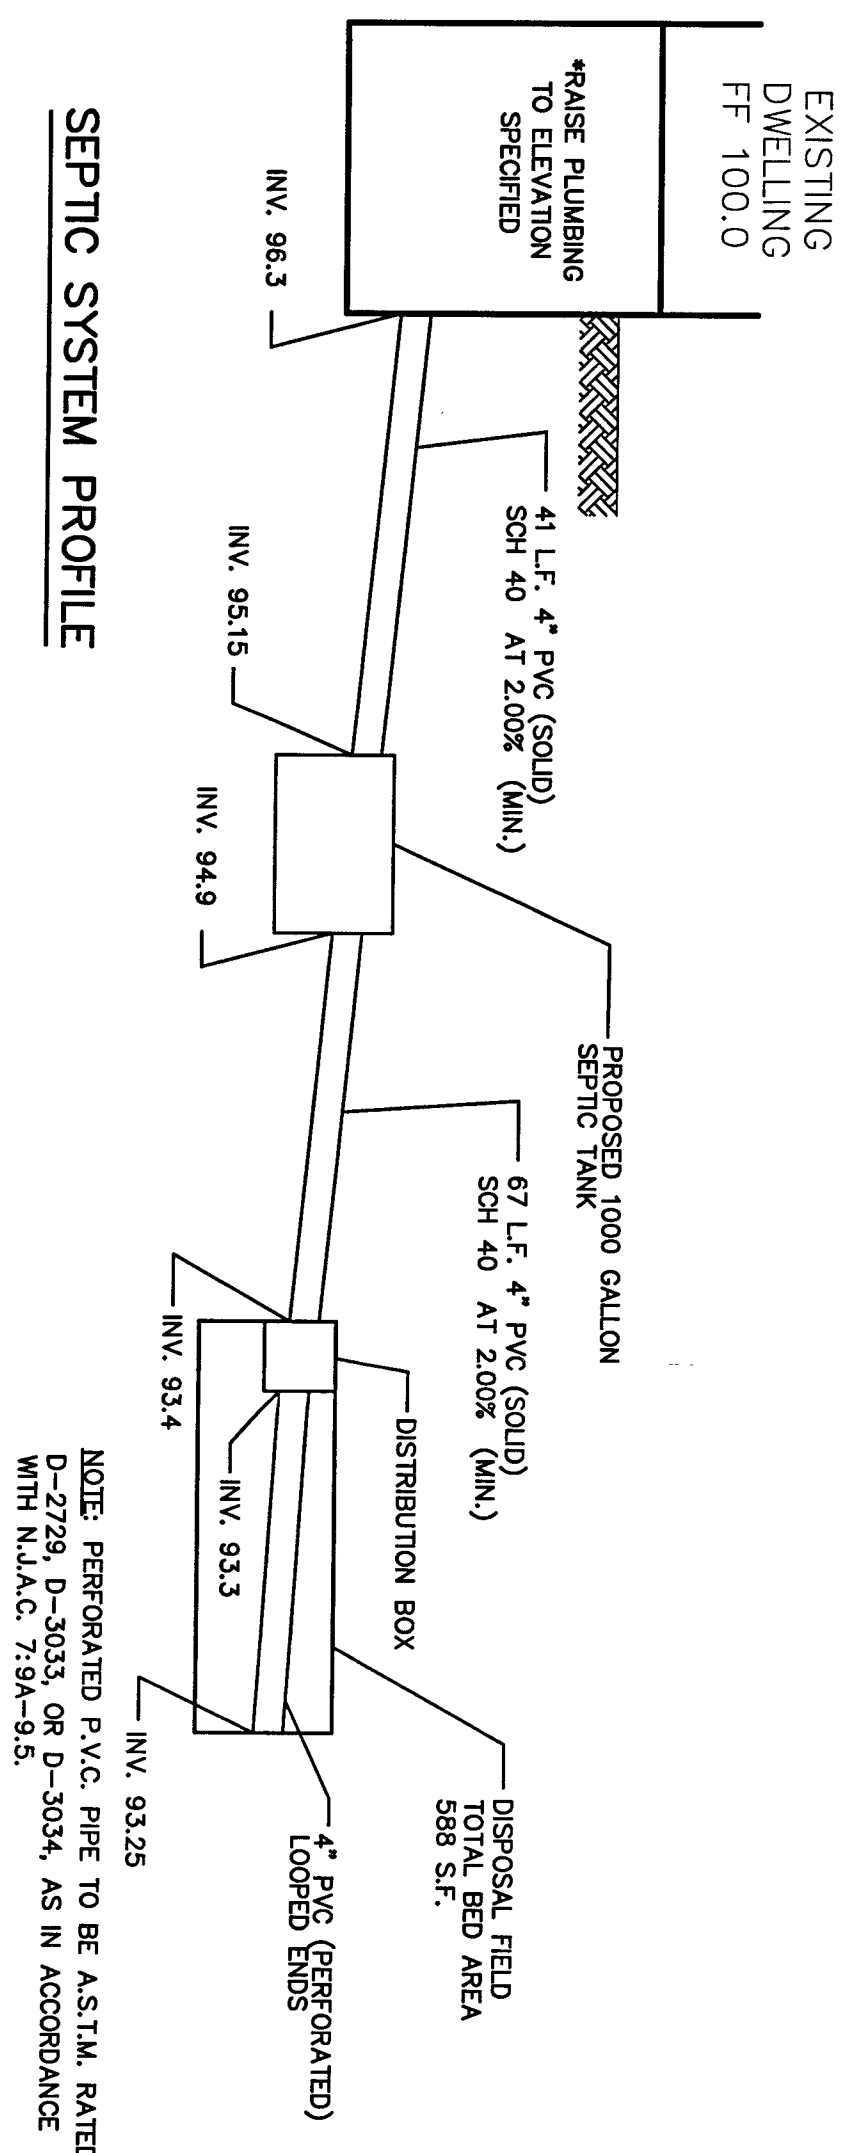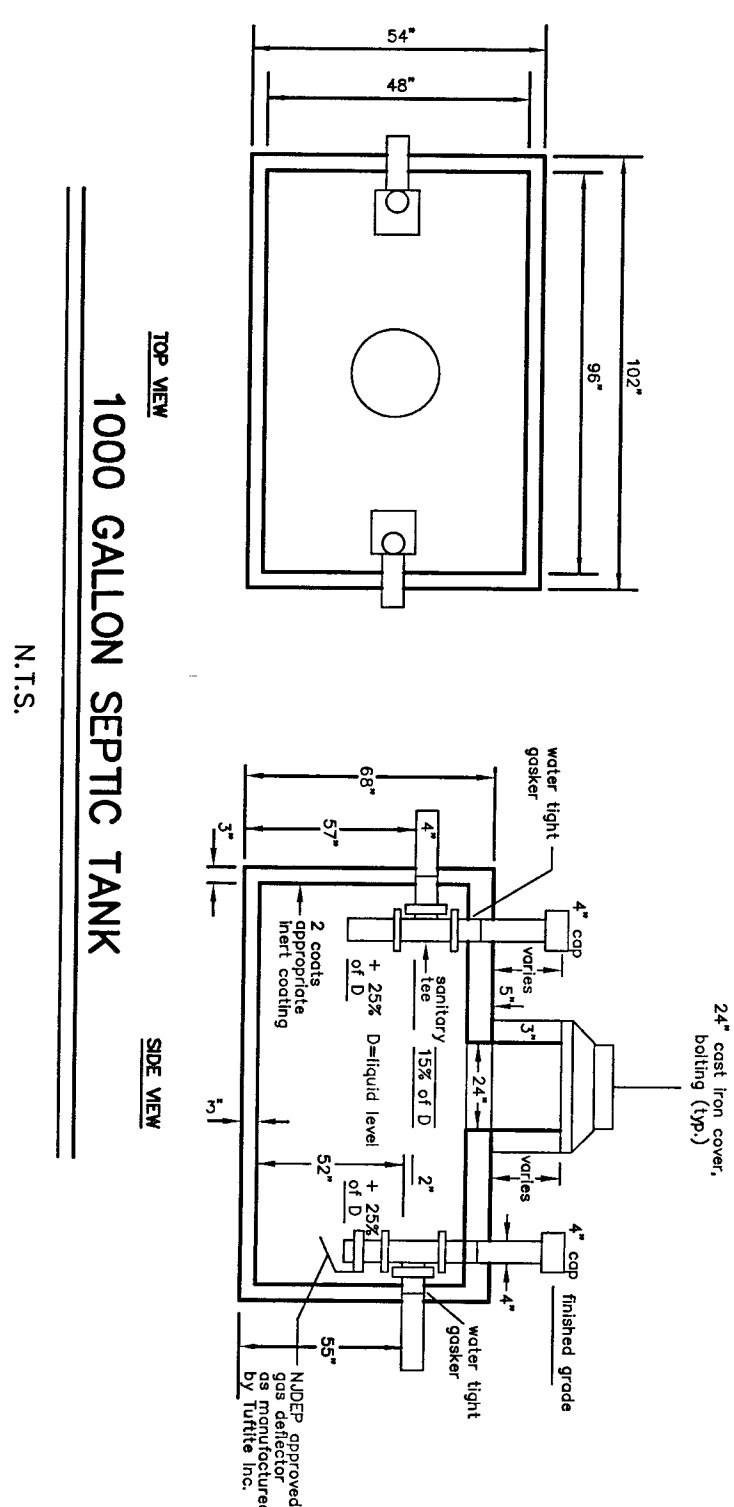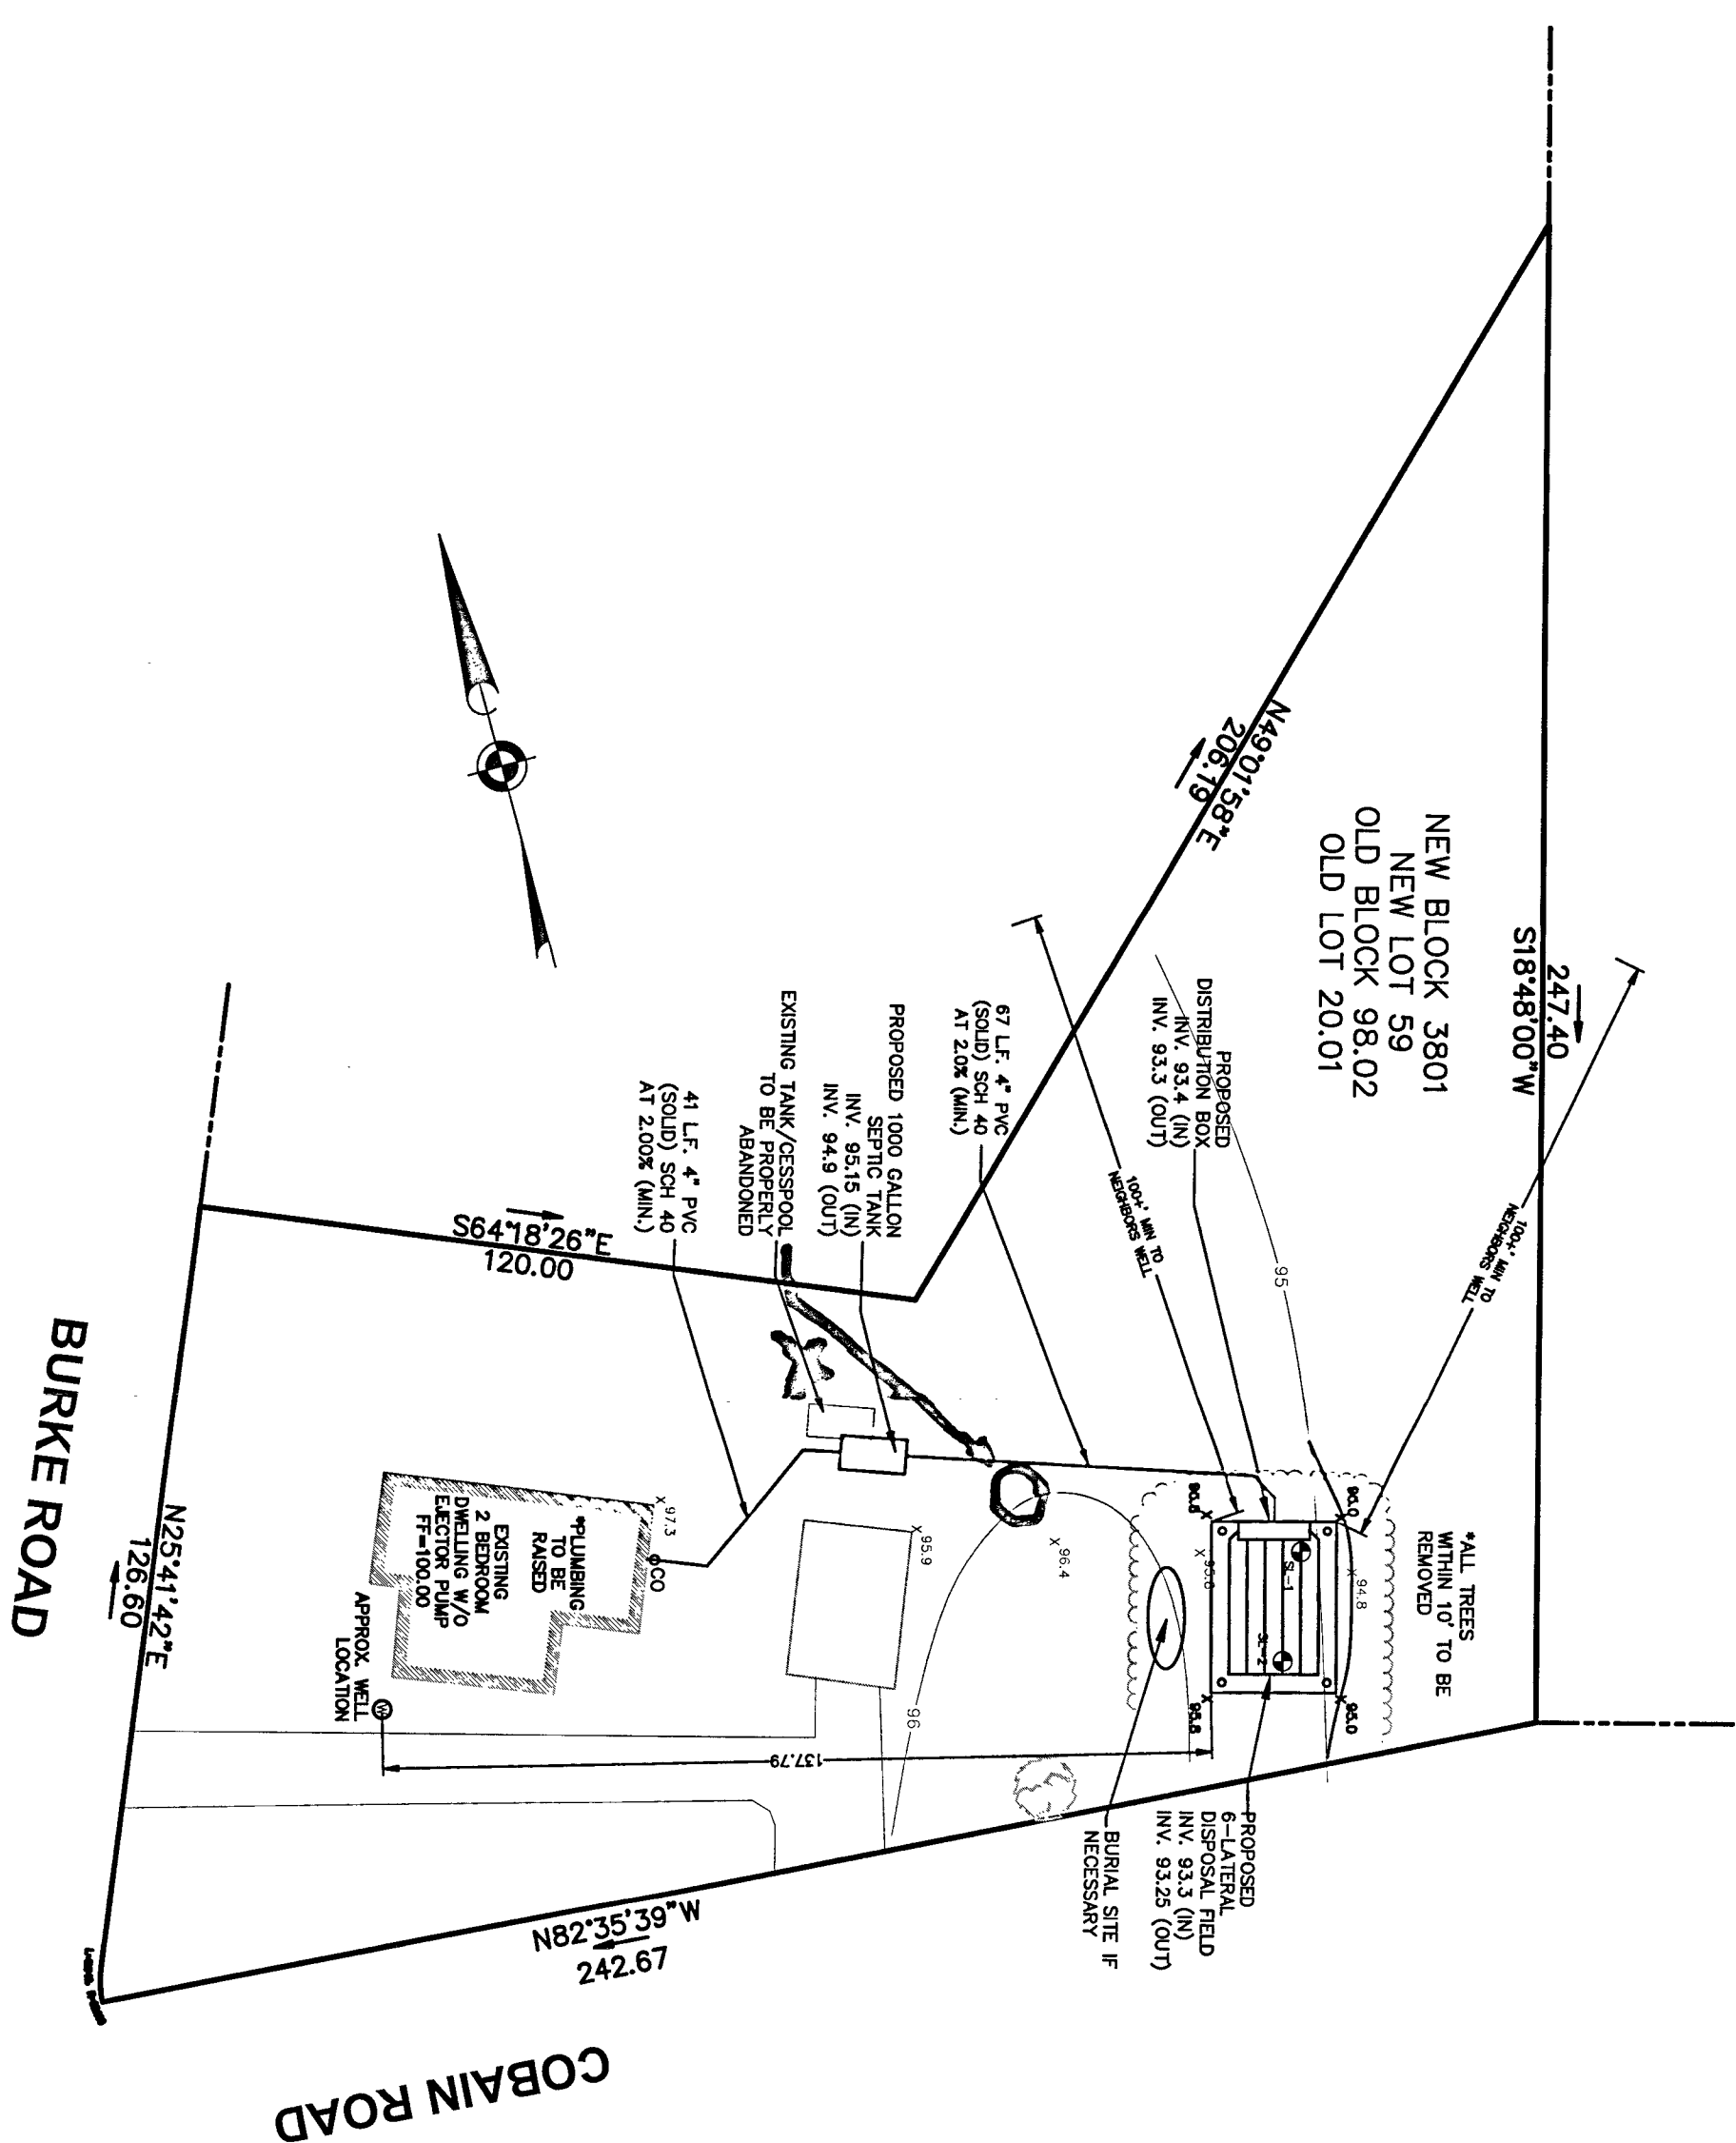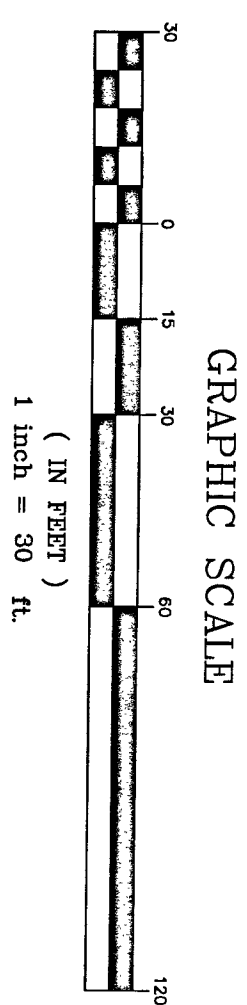

1. **NOTES:**
CONTRACTOR/HOMEOWNER TO CONFIRM ALL OUTGOING LINES FROM DWELLING GO TO PROPOSED SEPTIC SYSTEM. IF NOT, CONTACT BELOW SIGNED ENGINEER PRIOR TO CONSTRUCTION.
2. **NO WELLS WITHIN 100' OF PROPOSED DISPOSAL FIELD.**
3. **ALL STRUCTURES ASSOCIATED WITH EXISTING SEPTIC SYSTEM TO BE PROPERLY ABANDONED AS NECESSARY.**
4. **CONTRACTOR TO VERIFY THAT WATER SOFTENER DISCHARGE PIPING IS NOT TIED INTO SEPTIC SYSTEM.**
5. **DISION MEETS ALL SETBACK REQUIREMENTS**

GENERAL CONSTRUCTION NOTES

1. BOUNDARY INFORMATION TAKEN FROM A PLAN PROVIDED BY WILLIAM P. SCHEMEL, P.L.S. 36275
2. DO NOT SCALE DRAWINGS, ADJACENT AND SURROUNDING PHYSICAL CONDITIONS, BUILDINGS, STRUCTURES, ETC., ARE SCHEMATIC ONLY EXCEPT WHERE DIMENSIONS ARE SHOWN THEREON.
3. THIS PLAN IS NOT A SURVEY OR PLOT PLAN. IT IS TO BE UTILIZED FOR THE CONSTRUCTION OF THE INDIVIDUAL SUBSURFACE SEWAGE DISPOSAL SYSTEM ONLY.
4. BOTTOM OF THE BED AND DISTRIBUTION LINES SHALL HAVE A RELATIVELY LEVEL GRADE. MAXIMUM SLOPE OF 2 IN. 100 FEET.
5. STONE SHALL BE WASHED GRAVEL, OR CRUSHED STONE, FREE OF FINES, DUST, SANDS OR CLAY. THE FILTER MATERIAL SHALL CONFORM TO ADOPT STANDARD SIZES FOR COARSE AGGREGATES IN SIZE AND GRADUATION TO SIZE NO. 24, SIZE NO. 3 OR SIZE NO.4.
6. UNDER NO CONDITION SHALL MECHANICAL EQUIPMENT BE USED TO BACKFILL THE BED.
7. BED SHOULD BE CONSTRUCTED AFTER ALL DANGER FROM MECHANICAL EQUIPMENT HAS PASSED.
8. CONSTRUCTION OF THIS BED SHALL TAKE PLACE WHEN SOIL IS DRY.
9. MINIMUM DIAMETER OF DISTRIBUTION LINES IS 4 INCHES.
10. SEEPAGE AREA REQUIREMENTS MUST CONFORM TO THE CURRENT NEW JERSEY DEEP MANUAL, STANDARDS FOR THE CONSTRUCTION OF INDIVIDUAL SUBSURFACE SEWAGE DISPOSAL SYSTEMS.
11. SEPTIC TANK SHALL BE A MINIMUM OF 10 FEET FROM DWELLINGS.
12. DISPOSAL FIELD SHALL BE A MINIMUM OF 25 FEET FROM THE DWELLING AND 10 FEET FROM PROPERTY LINES.
13. THE CONTRACTOR SHALL NOTIFY THE UNDERSIGNED PROFESSIONAL, IF ANY, TWO WEEKS BEFORE THE FIELD LINES DIFFER IN THE FIELD THAN WHAT IS SHOWN ON THE PLAN.
14. PERMANENT MARKERS SHALL BE PROVIDED OVER THE DISTRIBUTION BOX.
15. MARK 4 CORNERS OF DISPOSAL FIELD TO PREVENT MACHINERY RUNNING OVER INSTALLED AREAS.
16. CONTRACTOR TO MULCH DISPOSAL FIELD TO PREVENT SOIL EROSION OVER WINTER MONTHS. DISPOSAL FIELD TO BE SEEDED BY OWNER AFTER SPRING THAW.
17. SOIL LOGS 1 & 2 SHOWN HEREON IS BASED UPON ON-SITE FIELD INSPECTION BY CAROL L. SMITH, P.E. ON DECEMBER 20, 2022.
18. THE CONTRACTOR SHALL NOTIFY THE UNDERSIGNED PROFESSIONAL IMMEDIATELY IF ANY FIELD CONDITIONS ENCOUNTERED DIFFER MATERIALLY FROM THOSE PRESENTED HEREON. THE UNDERSIGNED PROFESSIONAL SHALL BE GRANTED ACCESS TO REVIEW SAID CONDITION, MUNICIPAL COUNTY OR STATE RECORDS HEREON TO THE APPROPRIATE PROFESSIONAL'S SATISFACTION.
19. THE CONTRACTOR SHALL NOTIFY THE UNDERSIGNED PROFESSIONAL, IN WRITING APPROXIMATELY 48 HOURS PRIOR TO COMPLETION OF THE DISPOSAL FIELD, TO BE PRESENT AND SIGN THE UNDERSIGNED PROFESSIONAL ACCESS TO THE SITE AND TO SIGN THE UNDERSIGNED CONTRACTOR TO VERIFY SITE CONDITIONS AND OBSERVE CONSTRUCTION. THE CONTRACTOR SHALL NOT POSTPONE, ALTER, AND/OR DELAY THE CONSTRUCTION SCHEDULE OF THE DISPOSAL FIELD PENDING SITE VISITATION FROM THE UNDERSIGNED PROFESSIONAL.
20. THIS SYSTEM HAS BEEN DESIGNED TO ACCOMMODATE FLOWS FROM A 2 BEDROOM PRIVATE RESIDENTIAL BUILDING WITHOUT AN EJECTOR PUMP OR A DOMESTIC GARAGE GRINDER.
21. THE CONTRACTOR IS RESPONSIBLE FOR VERIFYING THE LOCATION OF

DISPOSAL BED CALCULATIONS	
NO. OF BEDROOMS	- EXISTING 2 BEDROOM
DESIGN PERMEABILITY	K-4 (3-20 IN./HR.)
FIRST BEDROOM	200 GALS./DAY
ADDITIONAL 1 BEDROOM	350 GALS./DAY
TOTAL VOLUME	550 GALS./DAY
350 GALS./DAY x 1.61 SQ. FT./GAL./DAY =	564 SQ. FT.
TOTAL BED SIZE REQUIRED =	568 SQUARE FEET
TOTAL BED SIZE PROVIDED =	568 SQUARE FEET (21' x 26')

SEPTIC TANK CALCULATIONS

NO. OF BEDROOMS = 2
250 GALS. PER BEDROOM
2 X 250 = 500 GALLONS
USE NEW 1000 GALLON SEPTIC TANK

NOTE: ACCORDING TO N.A.A.C. 7-9A-3.3(C)2 "ALTERATIONS ARE MADE IN SUCH A WAY THAT THOSE COMPONENTS OF THE SYSTEM ALTERED ARE IN CONFORMANCE WITH THE REQUIREMENTS OF THIS CHAPTER OR ARE CLOSER TO BEING IN CONFORMANCE WITH THIS CHAPTER THAN ORIGINAL COMPONENTS PRIOR TO THE ALTERATION." IT IS THE INTENT OF THIS PLAN TO IMPROVE THE EXISTING MALFUNCTIONING SYSTEM, NO WARRANTIES OR GUARANTEES ARE ASSOCIATED WITH THIS PLAN.


NOTE: ALL MANHOLE COVERS MUST BE AT GRADE WITH LOOKING COVERS. AN INFORMATION MARKER MUST BE PROVIDED INSIDE THE UD WITH THE NAME OF THE LOCAL HEALTH DEPARTMENT, PERMIT NUMBER, DATE OF INSTALLATION, TYPE OF SYSTEM, AND TOTAL DESIGN FLOW IN GPD. MARKER MUST BE ATLEAST 6", SQUARE, AND MADE OF NON-CORROSIVE MATERIAL.

PLAN PREPARED FOR:

DANIEL & NORA HIRSCHFELD
557 BURKE ROAD
JACKSON, NJ 08527
PHONE: 732-552-5273
EMAIL: NORADANIAN@AOL.COM

OLD BLOCK 98.02, LOT 20.01
NEW BLOCK 3801, LOT 59
DECEMBER 20, 2022
SITE EVALUATOR: CARA L. SMITH, P.E.
SOIL LOG #1 & #2 (ELEV. 95.0)

24-120* SAND, YELLOW BROWN (10YR 5/6), SINGLE GRAIN,
LOOSE, MOIST
NO GROUND WATER ENCOUNTERED
NO SEASONAL HIGH WATER TABLE ENCOUNTERED
*SAMPLE FROM SL-1 (K-4)

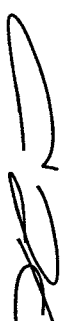REV.	DATE	DESCRIPTION
NEW BLOCK 3801 NEW LOT 59 OLD LOT 20.01 TOWNSHIP OF JACKSON OCEAN COUNTY NEW JERSEY SEPTIC DESIGN PLAN		
20 RIVER ENGINEERING www.20rivereng.com P.O. Box 195 Cedar Neck, N.J. 07722 Tel: 732.866.0111 Fax: 732.866.4348 ■ Engineers ■ Surveyors ■ Planners ■ Environmental Consultants		
 CARA L. SMITH 12-21-2022 DATE N.J. Professional Engineer License No. 246C03792900 PROJECT NO.: 22180 DATE: DECEMBER 21, 2022 DRAWING NO.: 22180SP DRAWN BY: ERI CLIENT: HIRSCHFELD SCALE: AS SHOWN		
SHEET NO. 1 OF 1		

