

CERTIFICATION IN LIEU OF OATH

I. OWNER SECTION (to be completed if the applicant is the owner in fee)

I hereby certify that I am the owner in fee of the property listed on Page 1.

Mark the following applicable boxes:

- A. ☐ I further certify that a new home (private residence) will be constructed on this property for my own use and occupancy. This dwelling is to be occupied by myself and is not to be used for any purpose other than single family residential use. I attest that all construction, plumbing, or electrical work will be done, in whole or in part, by me or by subcontractors under my supervision, in accordance with all applicable laws; and, I further acknowledge that said new home is not covered under the New Home Warranty and Builders Registration Act (N.J.S.A. 46:3B-1 et seq.) and that such fact shall be disclosed to any person purchasing this property within ten years of the date of issuance of a certificate of occupancy.

I UNDERSTAND THAT IN MARKING BOX A, I ACKNOWLEDGE THAT I AM ASSUMING RESPONSIBILITY FOR THE WORK DONE ON SAID PROPERTY, THE CONDITION OF THE PROPERTY PRIOR TO, DURING, AND AFTER ANY WORK PERFORMED, AND FOR THE PERFORMANCE OF THE SUBCONTRACTORS I HIRE, EMPLOY, OR OTHERWISE CONTRACT OR WITH WHOM I MAKE AGREEMENTS TO PERFORM WORK. I AM VOLUNTARILY AND KNOWINGLY ASSUMING THIS RESPONSIBILITY.

- B. ☐ I further certify the following as required by the New Jersey Uniform Construction Code, N.J.A.C. 5:23-2.15(e)1.vii:

I personally prepared the plans submitted for: 1) the new home referred to in A.; or, 2) an addition, alteration, renovation, or repair to an existing single family residence owned and occupied by myself and located on the property listed on Page 1; or, 3) a new structure that will be physically separate from, but that will be deemed part of, an existing single family residence that is owned and occupied by myself and located on the property listed on Page 1.

- C. ☐ I further certify that I will perform or supervise the following work:

C.1. ☐ Building C.2. ☐ Fire Protection

I further certify that I will perform the following work:

C.3. ☐ Electrical C.4. ☐ Plumbing

- D. ☐ I agree to advise all contractors on this project that they are required to be registered with the New Jersey Division of Taxation and to comply with all New Jersey tax laws.

I further certify the following as required by the Uniform Construction Code, N.J.A.C. 5:23-2.15(a)5: All required State, county, and local prior approvals have been given, including such certification as the construction official may require.

I understand that if any of the above statements are willfully false, I am subject to punishment.

Signature _____ Date _____

II. AGENT SECTION (to be completed if the applicant is not the owner in fee)

I hereby certify the following as required by the Uniform Construction Code, N.J.A.C. 5:32-2.15(d): the proposed work is authorized by the owner in fee; and I have been authorized by the owner in fee to make this application as his agent.

I further certify the following as required by the Uniform Construction Code, N.J.A.C. 5:23-2.15(a)5: All required State, county, and local prior approvals have been given, including such certification as the construction official may require.

I agree to advise all contractors on this project that they are required to be registered with the New Jersey Division of Taxation and to comply with all New Jersey tax laws.

I understand that if any of the above statements are willfully false, I am subject to punishment.

☐ Check if contractor.

Agent Name Bob Hannemann

Address 1 Cornell Ct

Jackson N.J. 08527

Telephone (732) 363-8418

Signature [Signature]

III. ☐ LEAD HAZARD ABATEMENT: Include Homeowner or Building Owner Affidavit as per N.J.A.C. 5:17.

OFFICE DATE RECEIVED: _____

VIII. PRIOR APPROVALS CHECKLIST (office use only)	LOCAL APPROVAL		COUNTY APPROVAL		REGIONAL APPROVAL		STATE APPROVAL		COMMENTS
	Prelimin. Initial	Final Date	Prelimin. Initial	Final Date	Prelimin. Initial	Final Date	Prelimin. Initial	Final Date	
☐ Zoning Officer									IMPORTANT A.H.B.T. - EXEMPT
☐ Planning Board									
☐ Zoning Board									
☐ Sewer Authority									
☐ Water Authority									
☐ Police Department									
☐ Health Department									
☐ Soil Conservation									
☐ N.J. Department of Community Affairs									
☐ N.J. Department of Transportation									
☐ N.J. Department of Environmental Protection									
☐ Utility Dig No.									
☐									
☐									

IX. SUBCODES AND SPECIAL REGULATIONS APPLICABLE (office use only—optional)

Name of Code & Edition	Name of Code & Edition	Other
Building _____	Energy _____	
Electrical _____	Barrier Free _____	
Plumbing _____	Flood Hazard _____	
Fire Protection _____	As Built Elevation Cert. _____	
Mechanical _____	Other _____	

X. CERTIFICATES ISSUED (office use only)

	DATE ISSUED	DATE EXPIRED	DATE REISSUED	DATE EXPIRED
☐ Temporary Certificate of Occupancy	No. _____	_____	_____	_____
☐ Temporary Certificate of Compliance	No. _____	_____	_____	_____
☐ Continued Certificate of Occupancy	No. _____	_____	_____	_____
☐ Certificate of Compliance	No. _____	_____	_____	_____
☐ Certificate of Occupancy	No. _____	_____	_____	_____
☐ Certificate of Approval	No. _____	_____	_____	_____
☐ Lead Abatement Clearance Certificate	No. _____	_____	_____	_____

TOWNSHIP OF BRICK
401 CHAMBERS BRIDGE RD
DIVISION OF INSPECTIONS

UCC NEW JERSEY
CONSTRUCTION
PERMIT

0004
1719**#
BLOCK 378 # 0.00
LOT 3 # 0.00
BUILDING 85.00
D.C.A. 2.00
ZONE/LOT 15.00
TOTAL 102.00
CASH 105.00
CHANGE 3.00
0031A005 12:49

Date Issued 05/16/2000
Control #
Permit # 00-1719

IDENTIFICATION Block 378.13 Lot 3 Qual 05/16/00

Work Site Location 83 BAY HARBOR BLVD

DETACHED DECK

Owner in Fee WALSH, JOHN C.

Address SAME

BRICK NJ

Telephone

Contractor BOB HANNEMANN
Address 1 CORNELL CT
JACKSON, NJ 08527-

Telephone (732)363-8418

Lic. No. or Bids. Reg. No.

Federal Emp. No.

Is hereby granted permission to perform the following work:

[X] BUILDING [] PLUMBING [] LEAD HAZARD ABATEMENT
[] ELECTRICAL [] FIRE PROTECTION [] DEMOLITION
[] ELEVATOR DEVICES [] ASBESTOS ABATEMENT [] OTHER
(Subchapter 8 only)

DESCRIPTION OF WORK:

DETACHED DECK 28X11 W/ 2 SETS OF STAIRS.

NOTE: If construction does not commence within one (1) year of date of issuance,
or if construction ceases for a period of six (6) months, this permit is void.

Estimated Cost of Work \$ 3,000

Construction Official

[Signature]

05/16/2000
Date

U.C.C. FIVE (5%)

PAYMENTS (Office Use Only)

Building 85
Electrical 0
Plumbing 0
Fire Protection 0
Elevator Devices 0
Other
DCA Training Fee 2
Cert. of Occupancy 0
Other 204
Total 187
Check No. 118-
Cash X
Collected By JL

TOWNSHIP OF BRICK
401 CHAMBERS BRIDGE RD
DIVISION OF INSPECTIONS

UCC NEW JERSEY
BUILDING
SUBCODE
TECHNICAL SECTION

Date Received 04/11/2000
Date Issued 5/16/00
Control # C12-48
Permit # 02-17719

A. IDENTIFICATION-APPLICANT: COMPLETE ALL APPLICABLE INFORMATION, WHEN CHANGING
CONTRACTORS, NOTIFY THIS OFFICE. CALL UTILITY DIG NO: 1-800-272-1000

Block 378.13 Lot 3 Qual
Work Site Location 83 BAY HARBOR BLVD
DETACHED DECK

Owner in Fee WALSH, JOHN C

Address SAME

BRICK, NJ

Telephone

Contractor BOB HANNEBMAN

Address 1 CORNELL CT

JACKSON, NJ 08527-

Tele. (732) 363-8418 Fax ()

Lic. No. or Blat

Federal Emp. No.

JOB SUMMARY (Office Use Only)

PLAN REVIEW Date Initial

☐ No Plans Req. *4/25/00 [signature]*

☒ All

☐ Roofing

☐ Foundation

☐ Frame

☐ Other

Joint Plan Review Required:

☐ Elect ☐ Plumb ☐ Fire

SUBCODE APPROVAL ☐ Elev

☐ CO ☐ CCO ☐ CA

Date:

Approved By:

INSPECTIONS

Type

Roofing

Foundation

Slab

Frame

BarrierFree

Insulation

Finishes

Energy

Mechanical

FCO

Other

Final

BarrierFree

Dates (Month/Day)

Failure Failure Approval Initial

C. CERTIFICATION IN LIEU OF OATH

I hereby certify that I am the (agent of) owner
of record and am authorized to make this application.

Signature

D. TECHNICAL SITE DATA

DESCRIPTION OF WORK

DETACHED DECK 28X11 W/ 2 SETS OF STAIRS.

FEE (Office Use Only)

TOWNSHIP OF BRICK
401 CHAMBERS BRIDGE RD
DIVISION OF INSPECTIONS

UCC NEW JERSEY
BUILDING
SUBCODE
TECHNICAL SECTION

Date Received 04/11/2000
Date Issued
Control # C12548
Permit #

02-1719

A. IDENTIFICATION-APPLICANT: COMPLETE ALL APPLICABLE INFORMATION, WHEN CHANGING
CONTRACTORS, NOTIFY THIS OFFICE. CALL UTILITY DIG NO: 1-800-272-1000

Block 378.13 Lot 3

Work Site Location 83 BAY HARBOR BLVD

DETACHED DECK

Owner in Fee WALSH, JOHN C

Address SAME

Driver HI

Telephone

Contractor BOB HANSEN

Address 1 CORNWELL CT

JACKSON, NJ 08527-

Telephone (732)363-8418

Lic. No. of Bldg. Reg. No.

Federal Emp. No.

JOB SUMMARY (Office Use Only)

PLAN REVIEW Date Initial

No Plans Req. 4/25/00

Roofing

Foundation

Frame

Other

Joint Plan Review Required:

Elect [] Plumb [] Fire

SUBCODE APPROVAL [] Elev

[] CO [] CCC [] CA

Date:

Approved By:

Final

BarrierFree

BarrierFree

Use Group Present U

Constr. Class Present Proposed

No. of Stories 0

Height of Structure 0 Ft.

Area Largest Floor 0 Sq. Ft.

New Bldg. Area/All Floors 0 Sq. Ft.

Volume of New Structure 0 Cu. Ft.

Total Land Area Disturbed 0 Sq. Ft.

INSPECTIONS Dates (Month/Day)

Type Failure Failure Approval Initial

Roofing

Foundation

Slab

Frame

BarrierFree

Insulation

Finishes

Energy

Mechanical

TCO

Other

Final

BarrierFree

BarrierFree

Est. Cost of Bldg. Work:

1. New Bldg. \$ 0

2. Alteration \$ 3,000

3. Total (1+2) \$ 3,000

Industrialized Building:

[] State Approved

[] MOD

C. CERTIFICATION IN LIEU OF OATH

I hereby certify that I am the (agent of) owner
of record and am authorized to make this application.

Signature

D. TECHNICAL SITE DATA
DESCRIPTION OF WORK

DETACHED DECK 2811 W/ 2 SETS OF STAIRS.

TYPE OF WORK

[] New Building

[] Addition

[X] Alteration

[] Roofing

[] Siding

[] Fence

[] Sign

[] Pool

[] Asbestos Abatement Subchapter 8

[] Lead Haz. Abatement NJAC 5:17

[] Other

Other

[] Demolition

FEE (Office Use Only)

\$ 0

\$ 85

\$ 0

\$ 0

Administrative Surcharge

Minimum Fee

TOTAL FEE

\$ 85

\$ 2

DCA Training Fee

\$ 2

U.C.C. F110 (rev. 3/96)

TOWNSHIP OF BRICK
401 CHAMBERS BRIDGE RD
DIVISION OF INSPECTIONS

UCC NEW JERSEY
BUILDING
SUBCODE
TECHNICAL SECTION

Date Received 04/11/2000
Date Issued 5/1/00
Control # C12-48
Permit #

A. IDENTIFICATION-APPLICANT: COMPLETE ALL APPLICABLE INFORMATION. WHEN CHANGING
CONTRACTORS, NOTIFY THIS OFFICE. CALL UTILITY DIG NO: 1-800-272-1000

Block 378.13 Lot 3 Quad
Work Site Location 83 BAT HARBOR BLVD

DETACHED DECK

Owner in Fee WALSH, JOHN C

Address SAME

BRICK, NJ

Tele

Contractor BOB HANSEN

Address 1 CORNELL CT

JACKSON, NJ 08521-

Tele (732)363-8818 Fax ()

Lic. No. or Bids. Reg. No.

Federal Emp. No.

C. CERTIFICATION IN LIEU OF OATH

I hereby certify that I am the (agent of) owner
of record and am authorized to make this application.

Signature

D. TECHNICAL SITE DATA
DESCRIPTION OF WORK

DETACHED DECK 23111 W/ 2 SETS OF STAIRS.

JOB SUMMARY (Office Use Only)
PLAN REVIEW Date Initial

☐ No Plans Req. 4/25/00

☒ All

☐ Footing

☐ Foundation

☐ Frame

☐ Other

Joint Plan Review Required:

☐ Elect ☐ Plumb ☐ Fire

SUBCODE APPROVAL ☐ Elev

☐ CO ☐ CCO ☐ CA

Date:

Approved By:

INSPECTIONS

Type

Failure

Failure Approval Initial

Foundation

Slab

Frame

BarrierFree

Insulation

Finishes

Energy

Mechanical

TCO

Other

Final

BarrierFree

Est. Cost of Bldg. Work:

1. New Bldg. \$

2. Alteration \$

3. Total (1+2) \$

Industrialized Building:

☐ State Approved

☐ HUD

TYPE OF WORK

☐ New Building

☐ Addition

☒ Alteration

☐ Roofing

☐ Siding

☐ Fence

☐ Sign

☐ Pool

☐ Asbestos Abatement Subchapter 8

☐ Lead Haz. Abatement H0AC 5:17

☐ Other

☐ Demolition

FEE (Office Use Only)

\$

\$

TOWNSHIP OF BRICK ZONING PERMIT

Permit Approved: April 12, 2000

No.2000-0535

Block: 378.13

Lot 3 & 4

Zone: R-7.5

Property Address: 83 Bay Harbor Boulevard

Owner: John C. Walsh

Applicant: Bob Hannemann

Phone: [REDACTED]


Existing Use: single family dwelling

Proposed Use: same


Proposed Construction: 11' x 28', 24" high detached deck

Conditions: The deck must be setback at least 5 feet from the side and rear property lines and 25 feet from the property line at Sunnydale Drive.


This permit shall be null, void and of no effect if any of the facts contained in the application upon the basis that this permit was granted are false or untrue in any material respect. This permit shall expire one (1) year after the date of issuance if the use or substantial construction has not been commenced.

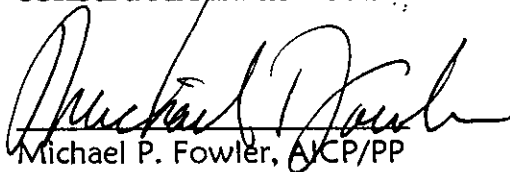

Michael P. Fowler, AICP/PP
Municipal Planner

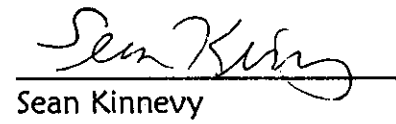

Sean Kinnevy
Zoning Officer

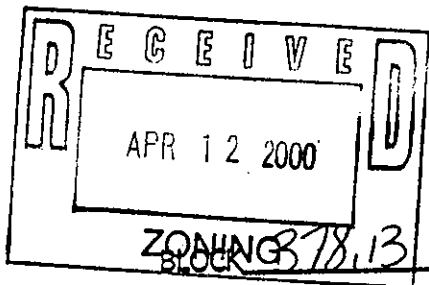

TOWNSHIP OF BRICK
Zoning Permit Application
(Please Type or Print Neatly)

PROPERTY ADDRESS (number and street) 83 Bay Harbor Blvd. Brick
NAME OF PROPERTY OWNER John C. Walsh
PERSONAL NAME OF APPLICANT Bob Hannemann
BUSINESS NAME OF APPLICANT Bob Hannemann
MAILING ADDRESS OF APPLICANT 1 Cornell Ct Jackson N.J. 08527
TELEPHONE NUMBER OF APPLICANT [REDACTED]

PRESENT USE OF PROPERTY (check all that apply)

- ☐ Vacant Lot
☒ Single-family dwelling
☐ Multi-family dwelling
☐ Commercial (please describe) _____

PROPOSED USE OF PROPERTY (check all that apply)

- ☐ Vacant Lot
☒ Single-family dwelling
☐ Multi-family dwelling
☐ Commercial (please describe) _____

PROPOSED CONSTRUCTION (please describe, specifically additions)

Build a 28x11' Foot Deck at rear of home with
2 sets of steps

✓ All dimensions: 28 Width 28 Length 24 Height

All dimensions: _____ Width _____ Length _____ Height

All dimensions: _____ Width _____ Length _____ Height

Deck or Garage: _____ Attached ☒ Detached 24 Height


Fence: _____ Style _____ Material _____ Height

CHECKLIST:

- ☐ All information completed above
☒ Two (2) copies of the property survey map containing:
☐ All existing and proposed structures
☐ All dimensions of the lot and structures
☐ All setbacks from the structures to the property lines
☐ All adjacent streets and waterways
☐ If applicable, include a copy of the Zoning Board of Adjustment Resolution, the date that the map was signed, and/or the date that the subdivision map was filed with the Ocean County Clerk, along with the file map and number.

The applicant certifies that all statements and information made and provided as part of this application are true to the best of the applicant's knowledge, information and belief. The applicant further states that the applicant will comply with all other Municipal approvals and ordinances and all County, State, and Federal Regulations.

Signature of applicant Bob Hannemann Date 4/11/00
Reviewed by Zoning Officer _____ Date 4/12/00 Approved () Rejected

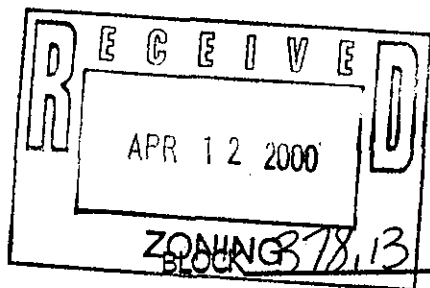

TOWNSHIP OF BRICK
Zoning Permit Application
(Please Type or Print Neatly)

PROPERTY ADDRESS (number and street) 83 Bay Harbor Blvd. Brick
NAME OF PROPERTY OWNER John C. Walsh
PERSONAL NAME OF APPLICANT Bob Hannemann
BUSINESS NAME OF APPLICANT Bob Hannemann
MAILING ADDRESS OF APPLICANT 1 Cornell Ct Jackson N.J. 08527
TELEPHONE NUMBER OF APPLICANT [REDACTED]

PRESENT USE OF PROPERTY (check all that apply)

- ☐ Vacant Lot
☒ Single-family dwelling
☐ Multi-family dwelling
☐ Commercial (please describe) _____

PROPOSED USE OF PROPERTY (check all that apply)

- ☒ Vacant Lot
☒ Single-family dwelling
☐ Multi-family dwelling
☐ Commercial (please describe) _____

PROPOSED CONSTRUCTION (please describe, specifically additions)

Build a 28x11' Foot Deck at rear of home with
2 sets of steps

✓ All dimensions: 28 Width 28 Length 24 Height

All dimensions: _____ Width _____ Length _____ Height

All dimensions: _____ Width _____ Length _____ Height

Deck or Garage: _____ Attached ☒ Detached 24 Height

Fence: _____ Style _____ Material _____ Height

CHECKLIST:

- ☐ All information completed above
☒ Two (2) copies of the property survey map containing:
☐ All existing and proposed structures
☐ All dimensions of the lot and structures
☐ All setbacks from the structures to the property lines
☐ All adjacent streets and waterways
☐ If applicable, include a copy of the Zoning Board of Adjustment Resolution, the date that the map was signed, and/or the date that the subdivision map was filed with the Ocean County Clerk, along with the file map and number.

The applicant certifies that all statements and information made and provided as part of this application are true to the best of the applicant's knowledge, information and belief. The applicant further states that the applicant will comply with all other Municipal approvals and ordinances, and all County, State, and Federal Regulations.

Signature of applicant Bob Hannemann Date 4/11/00
Reviewed by Zoning Officer _____ Date 4/12/00 () Approved () Rejected

TOWNSHIP OF BRICK
OCEAN COUNTY, NEW JERSEY
401 CHAMBERS BRIDGE ROAD, BRICK, N.J. 08723
(732) 262-1050



Joseph C. Scarpelli Mayor

Department of Administration & Finance

Township Council

Frederick J. Underwood, Sr - President
Stephen C. Acropolis
Kimberley S. Casten
Steven N. Cucci
Gregory S. Kavanagh
Kathy M. Russell
Anthony R. Shupin

Office of Municipal Engineer
(732) 262-1038
Fax: (732) 262-8954
www.twp.brick.nj.us

Date: 4/11/00

Block: 3781B Lot: 344

Property Address: 83 Bay Harbor

I, Bob Hannemann of 83 Bay Harbor
(name) (address)

request to be exempt from the plot plan requirement for an addition, fence, shed, deck, pool, retaining wall, ect. as outlined in Chapter 190.31 if the Codified Ordinance of the Township of Brick.

[Signature]
Applicant's Signature

The following shall be submitted with this request:

1. Submit surveys locating existing dwelling and proposed addition. Dimensions of the addition should be included.
2. Proof that the property is not located in a Flood Hazard Area.

Note: Prior to approval a site inspection by the Engineering Department will be performed to verify that the proposed addition will not create a drainage problem.

FOR OFFICE USE ONLY

Approved on: 4/28/00 Signed: [Signature]

Rejected on: _____ Signed: _____


Comments:

Mr Mrs J. Walsh
83 Bay Harbor Blvd
Brick

(1/4" = 1'-0")
(SCALE)

House

Lots 344
Block 378.13 (13)

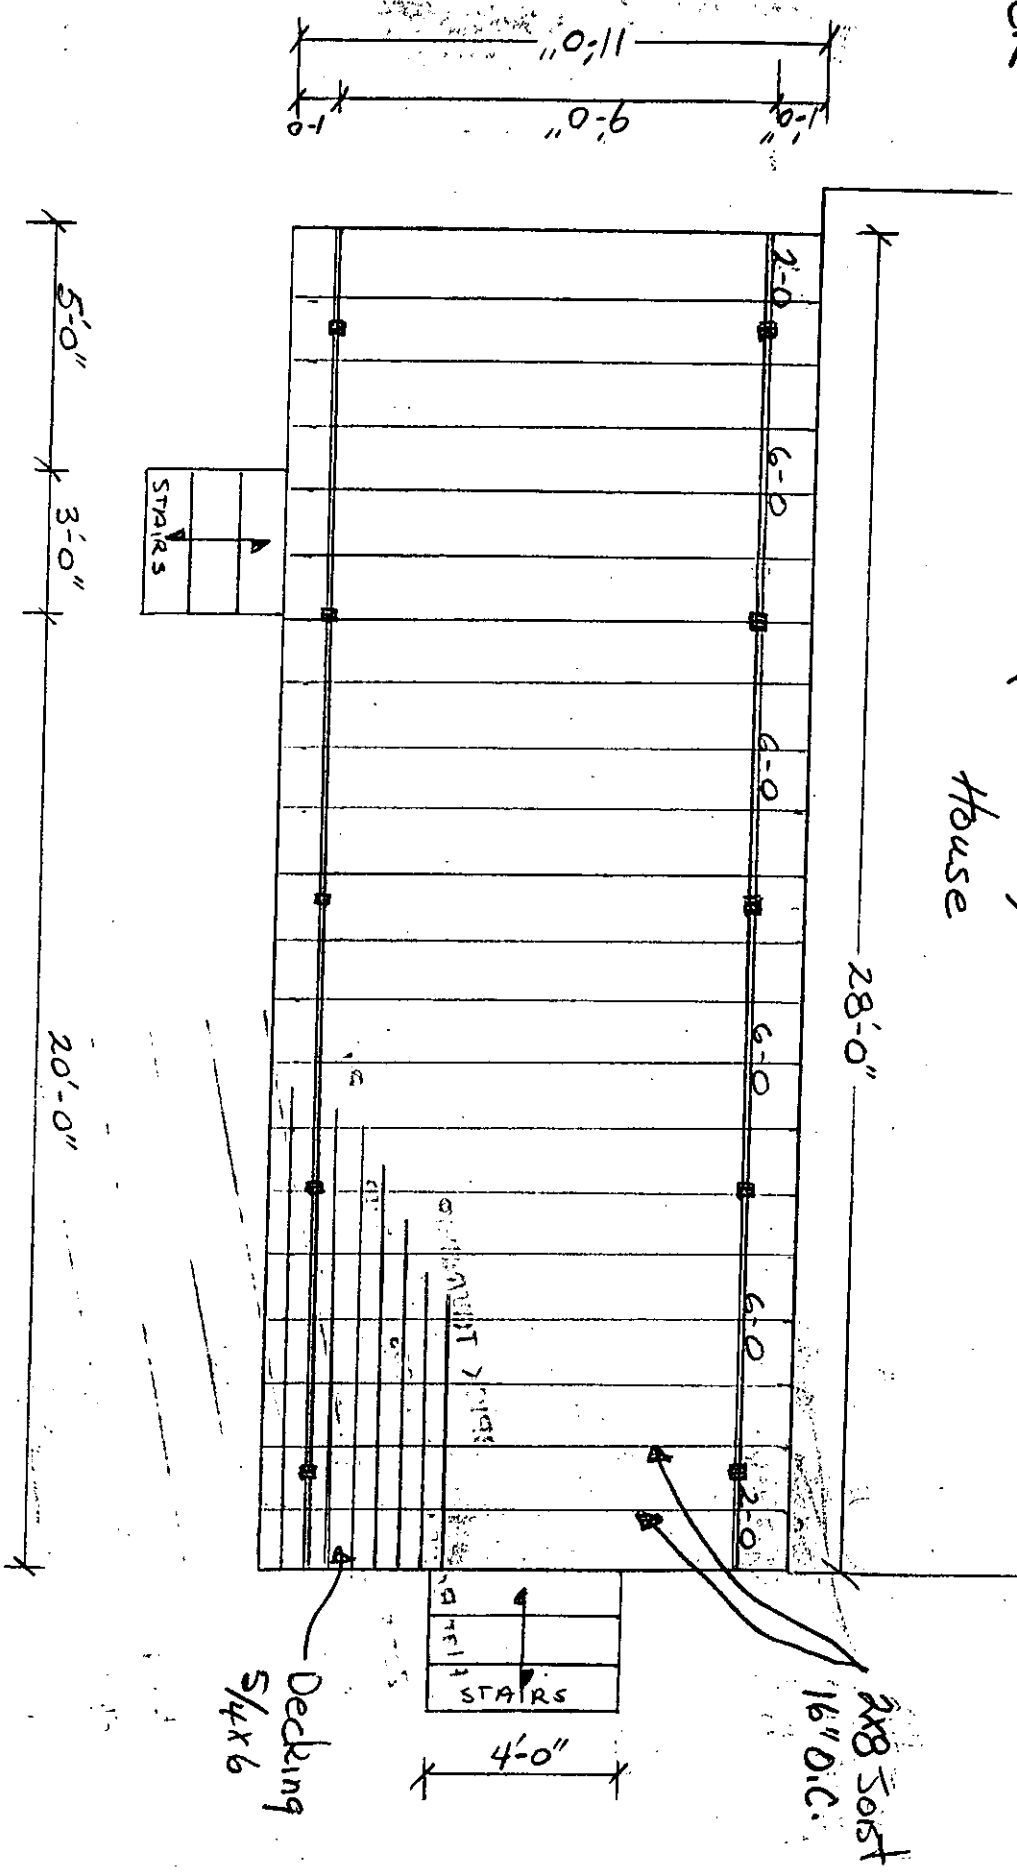

Posts: 4x4

Girders: double 2x8 spiked together

Joists: 2x8 16" O.C.

Decking: 5/4x6

All lumber Pressure Treated cca

BRICK TOWNSHIP

Plan Review	Class	Date	By
Zoning			
Plumbing			
Building	4-25-00	FM	
Fire			
Energy			
Electrical			


Mr Mrs J. Walsh
 83 Bay Harbor Blvd.
 Brick

Lots 344
 Block 378.13 (13)

(Scale
 $\frac{1}{4}" = 1'-0"$)

Rear View


(House)

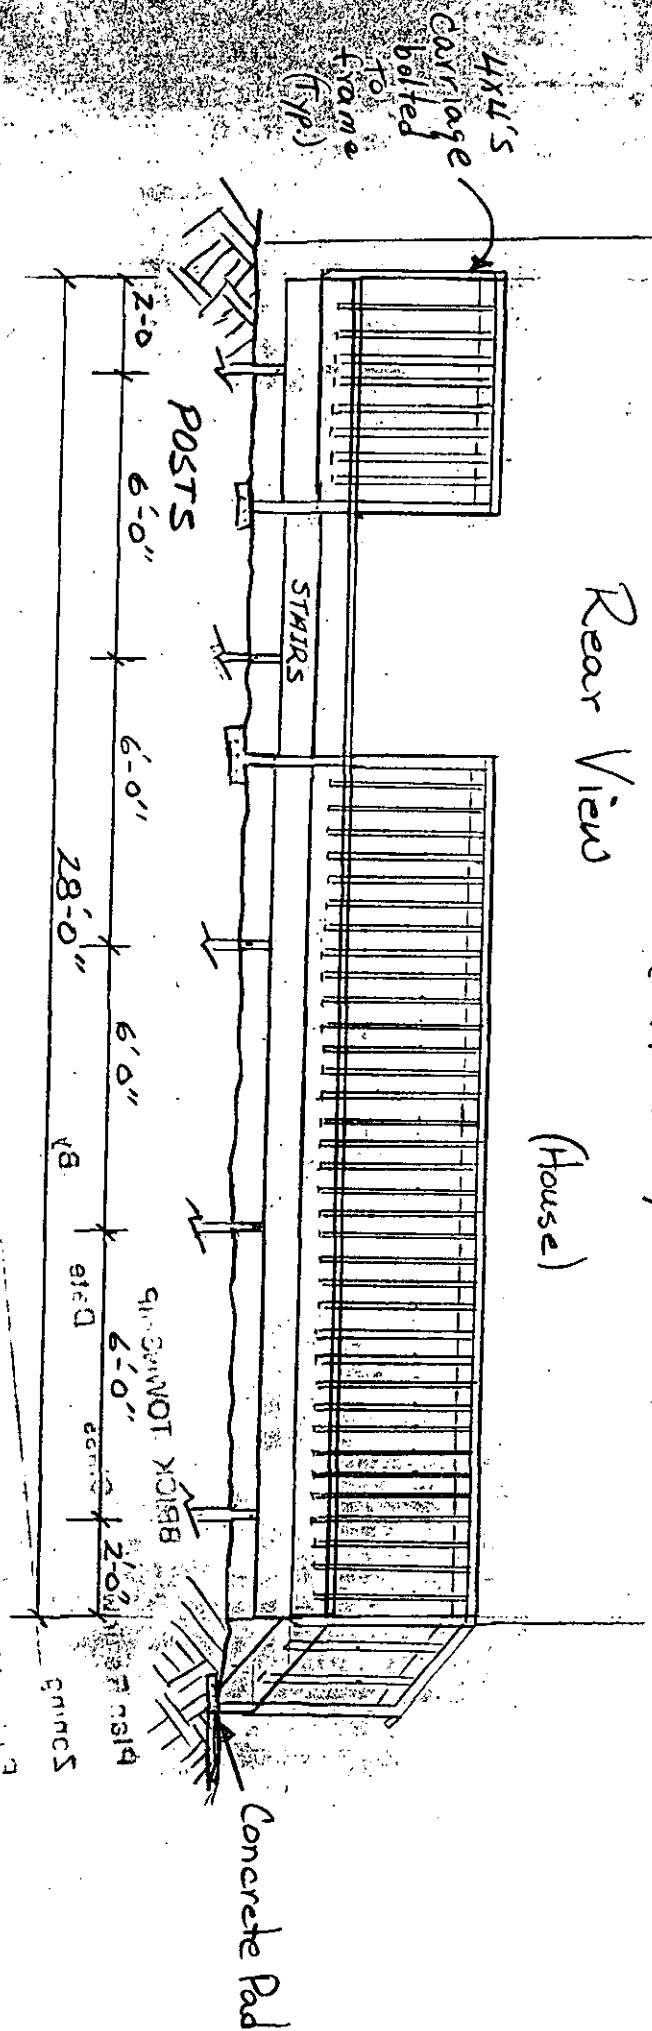

Note:

2x2 Baluster Rail
 5 1/2" O.C. Maximum
 opening between
 balusters 4" inches

Left Side View

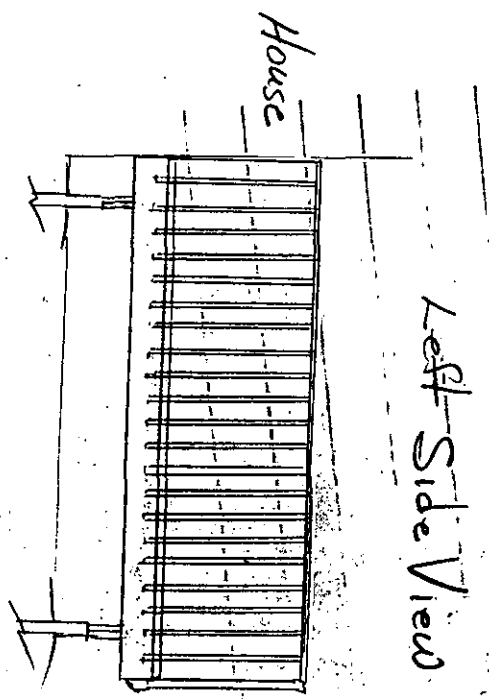


BRICK TOWNSHIP

Plan Review	Class	Date	By
Zoning			
Plumbing			
Building	4-25-00		FM
Fire			
Energy			
Electrical			


Mr Mrs J. Walsh

83 Bay Harbor Blvd. Brick

Lot 344
Block 378.13 (13)

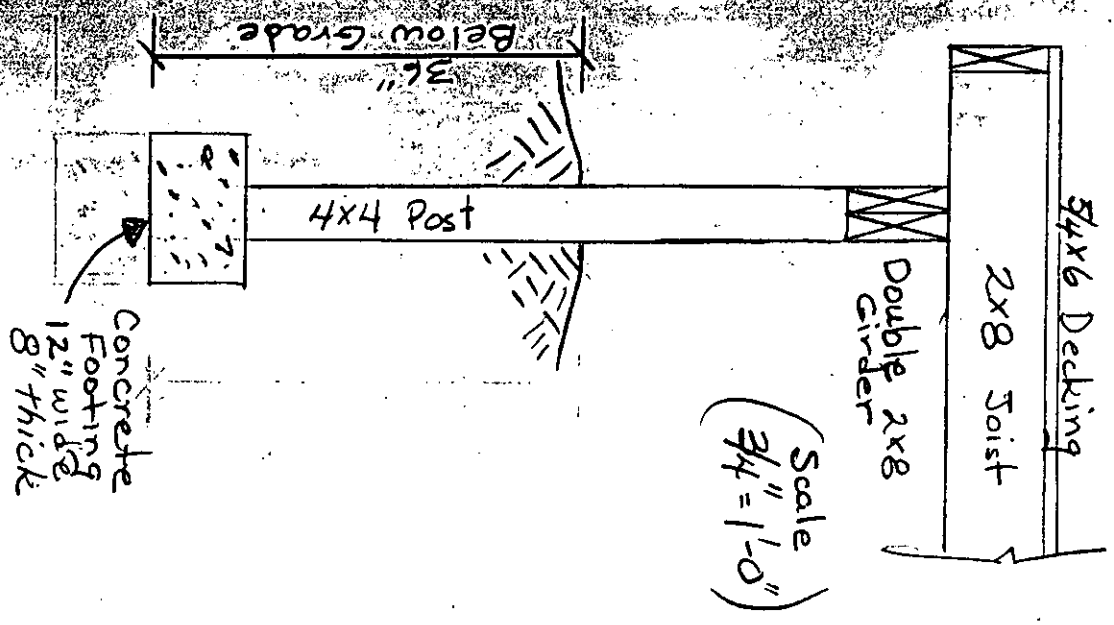

* All Lumber CCA Pressure Treated
All Nails Galvanized

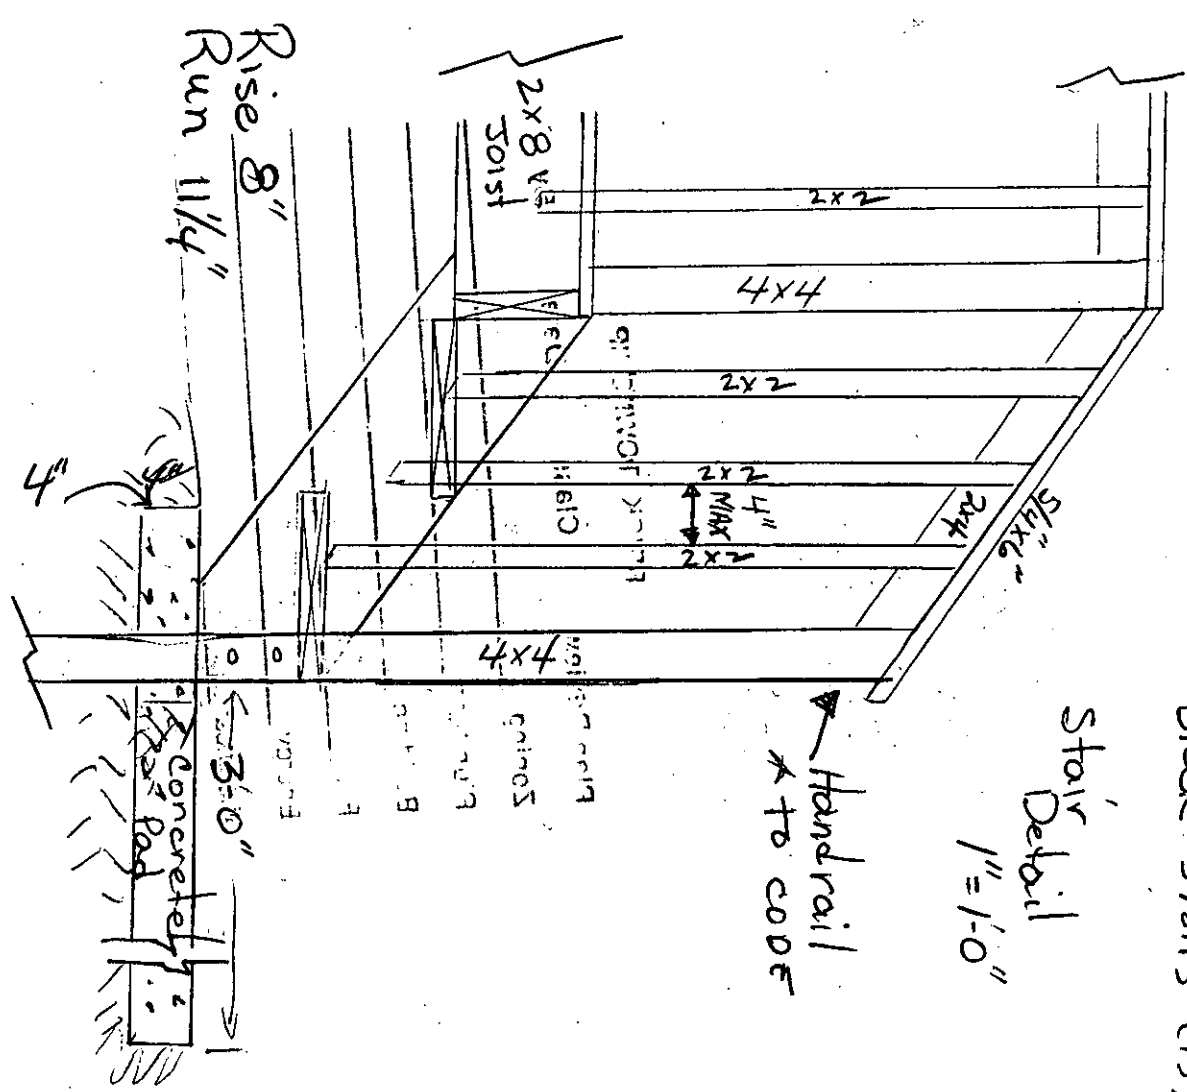

BRICK TOWNSHIP


Plan Review	Class	Date	By
Zoning			
Plumbing			
Building		4-25-00 PM	
Fire			
Energy			
Electrical			

Permit # 00-1719

WALSH
83 Bay Harbor.

* Please Note Mr Mrs Walsh
would like to increase deck
width from 11'-0" to 12'-0"
Every thing else remains the same.

CHANGE
CANT
FROM
1'-0" TO 1'-11"

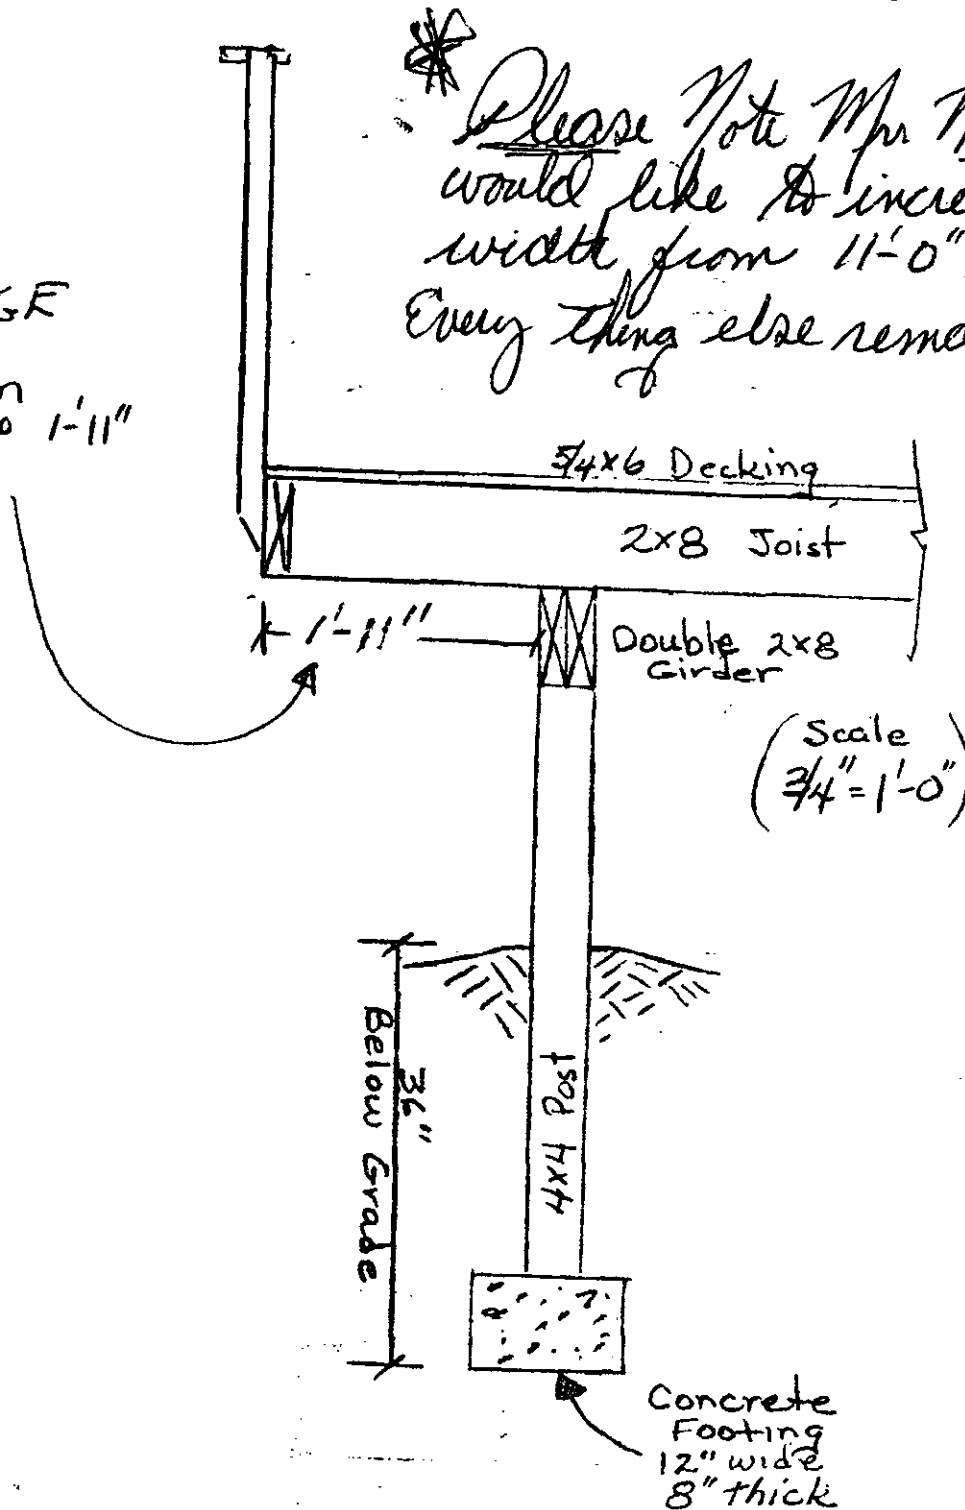

* All Lumber CCA Pressure Treated
All Nails Galvanized



Bob Hannemann
363-8418

25 Bay Harbor Blvd
Brick

(1" SCALE)

Block 378.13

House

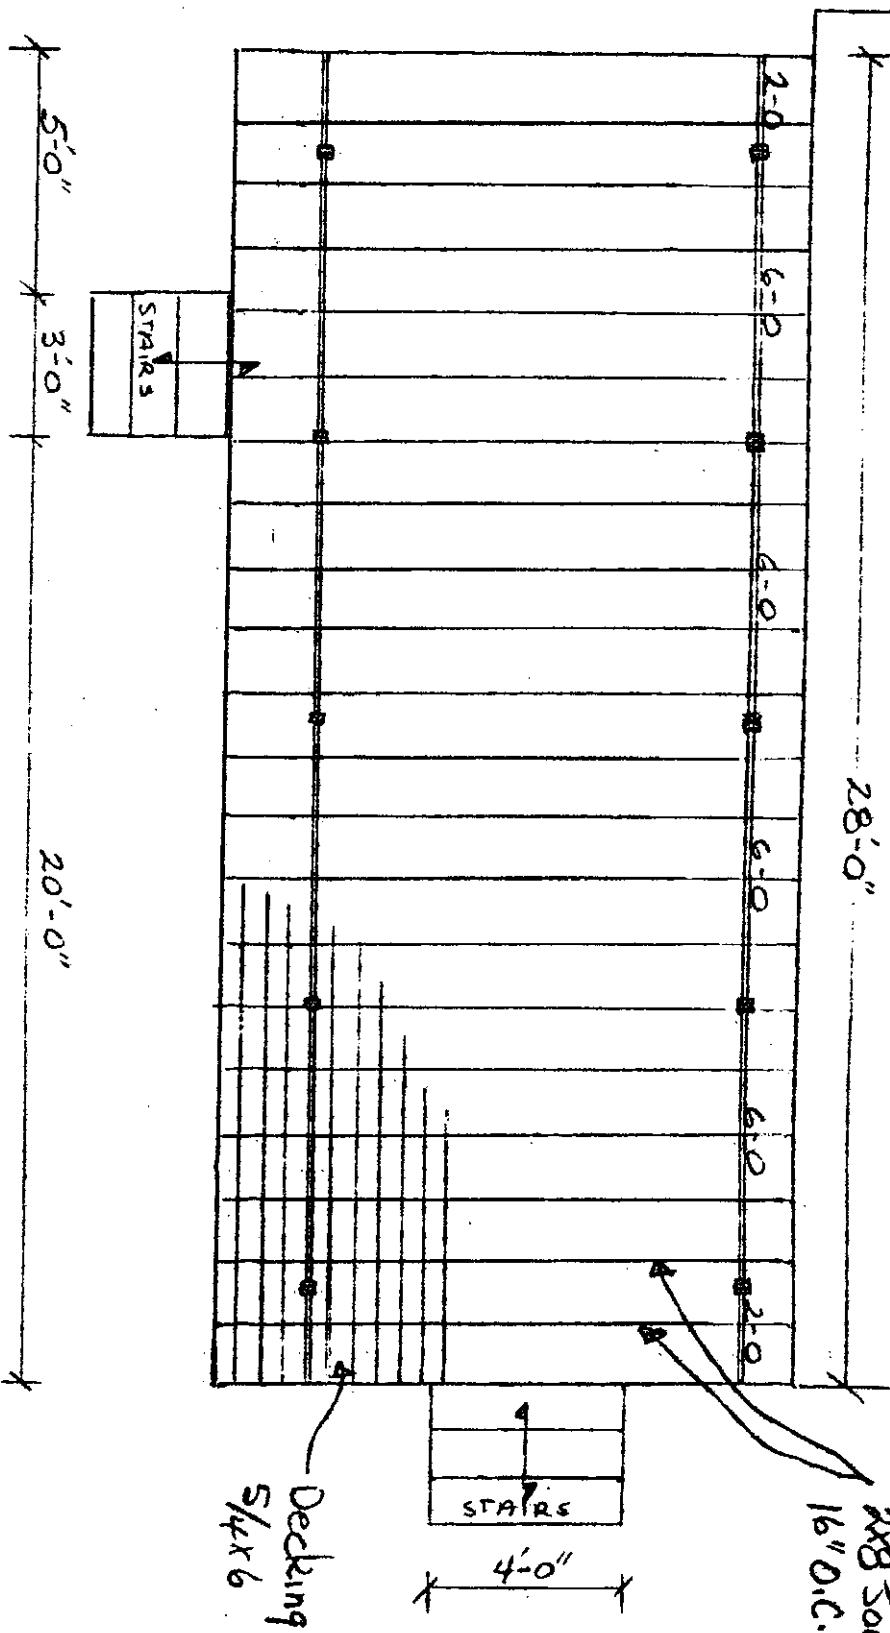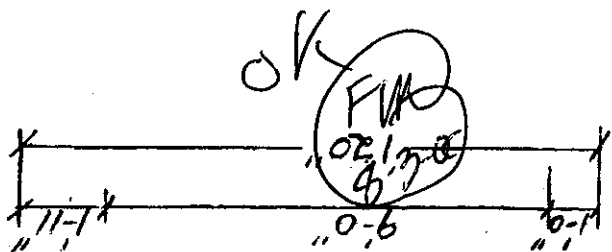

Posts: 4x4
Girders: double 2x8 spiked together
Joists: 2x8 16" O.C.
Decking: 5/4x6
All Lumber Pressure Treated cca

Please note change
Deck Width from 11 foot
To 12 foot


Walsh.
3 Bay Harbor Blvd
rick

(Scale
 $\frac{1}{4}" = 1'-0"$)

Lots 3 & 4
Block 378.13 013

Rear View

(House)

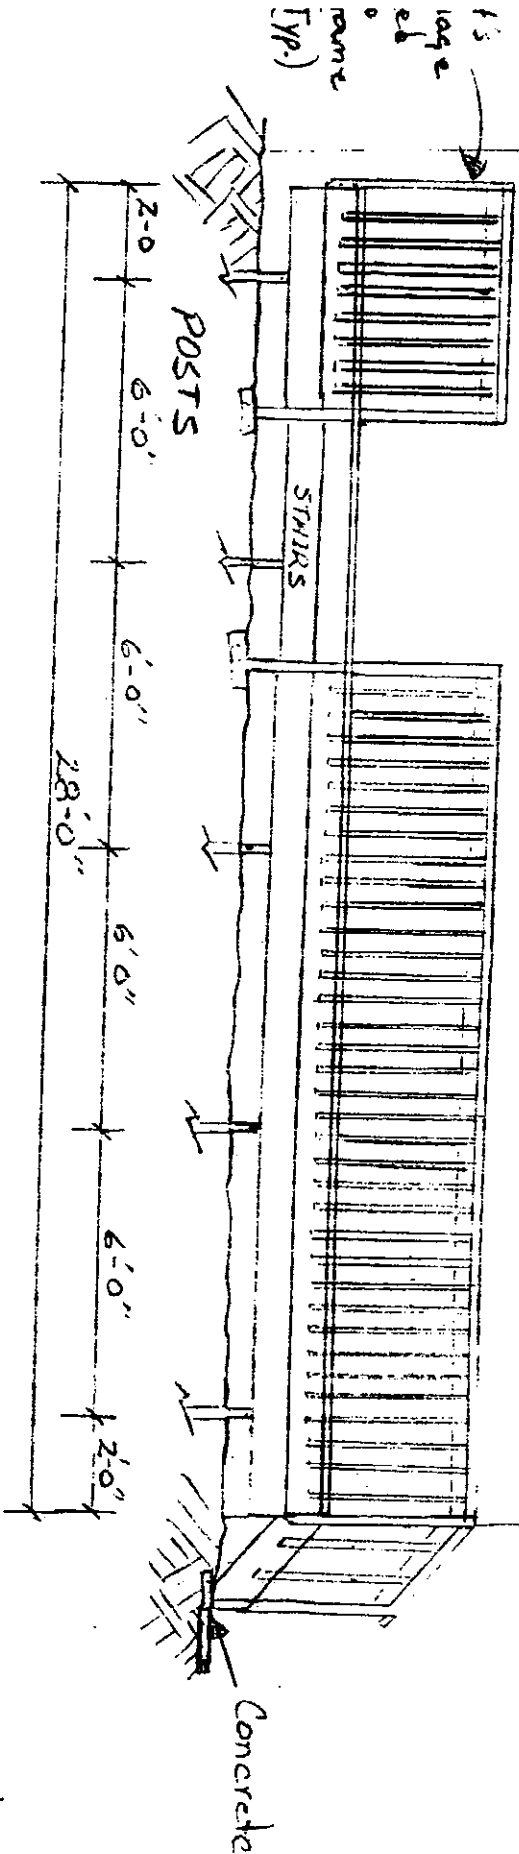


Note:

2x2 Baluster Rail
5 1/2" O.C. Maximum
Opening between
balusters 1 1/4" inches

Left Side View

Note

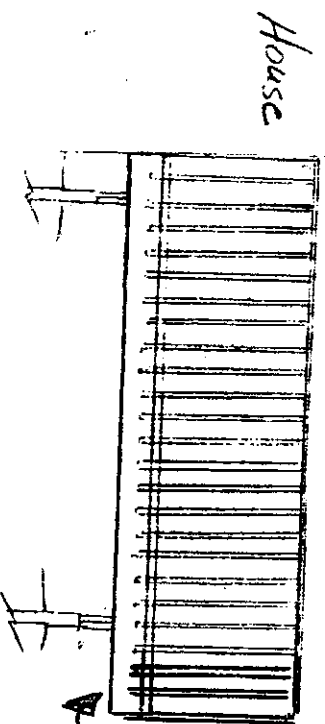

CHANGE
CAN'T
FROM
1'-0"
TO
1'-11"

Township of Brick

Counter Form
(PLEASE PRINT)

Site Location: 83 Bay Harbor Blvd. Brick
Block: 378.13 Lot: 344
Owner's Name: John C. Walsh
Owner's Mailing Address: 83 Bay Harbor Blvd. Brick
Phone: [REDACTED]

BUILDING

Contractor: Bob Hannemann
Address: 1 Cornell Ct
Jackson, N.S. 08527
Phone#: (732) 363-8418
Lis # [REDACTED]
Federal Emp # or SSN [REDACTED]

Technical Data

Description of Work:

Build a 28 Foot wide by 11 foot deep
CCA pressure treated deck at
The rear of the home.
The deck will have 2 sets of
stairs.

Type of Work

☐ New Building ☐ Siding
☐ Addition ☐ Fence
☐ Alteration ☐ Pool
☐ Roofing ☐ Demolition
☐ Asbestos Abatement ☐ Sign sq ft
☒ Deck 308 sq ft.

Building Characteristics

Use Group Present: _____ Proposed: _____
No of Stories: _____
Height of Structure: _____
Area of the largest floor: _____
Area of New Building: _____
Volume of Structure: _____
Total Land Disturbed: _____
Cost of Alteration: _____

Cost of New Building: _____

Total Cost of Building Work: \$3000.00

Signature: Bob Hannemann
Please Print Name Bob Hannemann

ELECTRICAL

Contractor: _____
Address: _____
Phone#: _____
Lis #: _____
Federal Emp # or SSN _____

Technical Data

Item	Quantity
Lighting Fixtures	_____
Receptacles	_____
Switches	_____
Detectors	_____
Light Poles	_____
Motors w/ Fract. HP	_____
Emergency & Exit Lights	_____
Communication Points	_____
Alarm Devices/FAC Panel	_____
Total	_____

Pool	_____
Spa/Hot Tub/Storable Pool	_____
Electric Range	_____ KW
Oven/Surface Unit	_____ KW
Electric Water Heater	_____ KW
Electric Dryer	_____ KW
Dishwasher	_____ KW
Garbage Disposal	_____ HP
A/C Unit - Central Air	_____ KW
Space Heater/Air Handler	_____ KW
Baseboard Heating	_____ KW
Motors 1+ HP	_____ KW
Transformer/Generator	_____ AMP
Light Stander	_____ AMP
Service	_____ AMP
Subpanel	_____ AMP
Motor Control Center	_____ AMP
Sign/Outline Light	_____ KW
Furnace	_____
Steam Boiler	_____
Other:	_____

Estimated Cost of Electrical Work: _____

Signature: _____
Please Print Name _____

CONTRACTOR'S SEAL

Counter Form
PLEASE PRINT

PLUMBING

FIRE

Contractor: _____
Address: _____
Phone #: _____
Lis #: _____
Federal Emp # or SSN _____

Contractor: _____
Address: _____
Phone #: _____
Lis #: _____
Federal Emp # or SSN _____

Technical Data

Quantity

Fixtures

Water Closets _____
Urinals/Bidets _____
Bath Tub _____
Lavatory _____
Shower _____
Floor Drain _____


Technical Data

Description of Work:

Heating Type: _____ Gas _____ Oil _____ Electric _____ Solar _____
Heating System is _____ New _____ Existing _____
Location of Furnace/Boiler: _____
Water Supply Source _____
Method of Valve Supervision _____
Local Alarm Supervision _____
Central Supervision: _____

Being Lots 3 & 4 Block 13 on "Plan of Bay Harbor Estates on Barhegot Bay Section A-1" filed in the Ocean County Clerk's Office on March 20, 1959 as Map No. D-266. Also being Lots 3 & 4 Block 378.13 on the Brick Township Tax Map

BAY HARBOR BOULEVARD (75' wide)

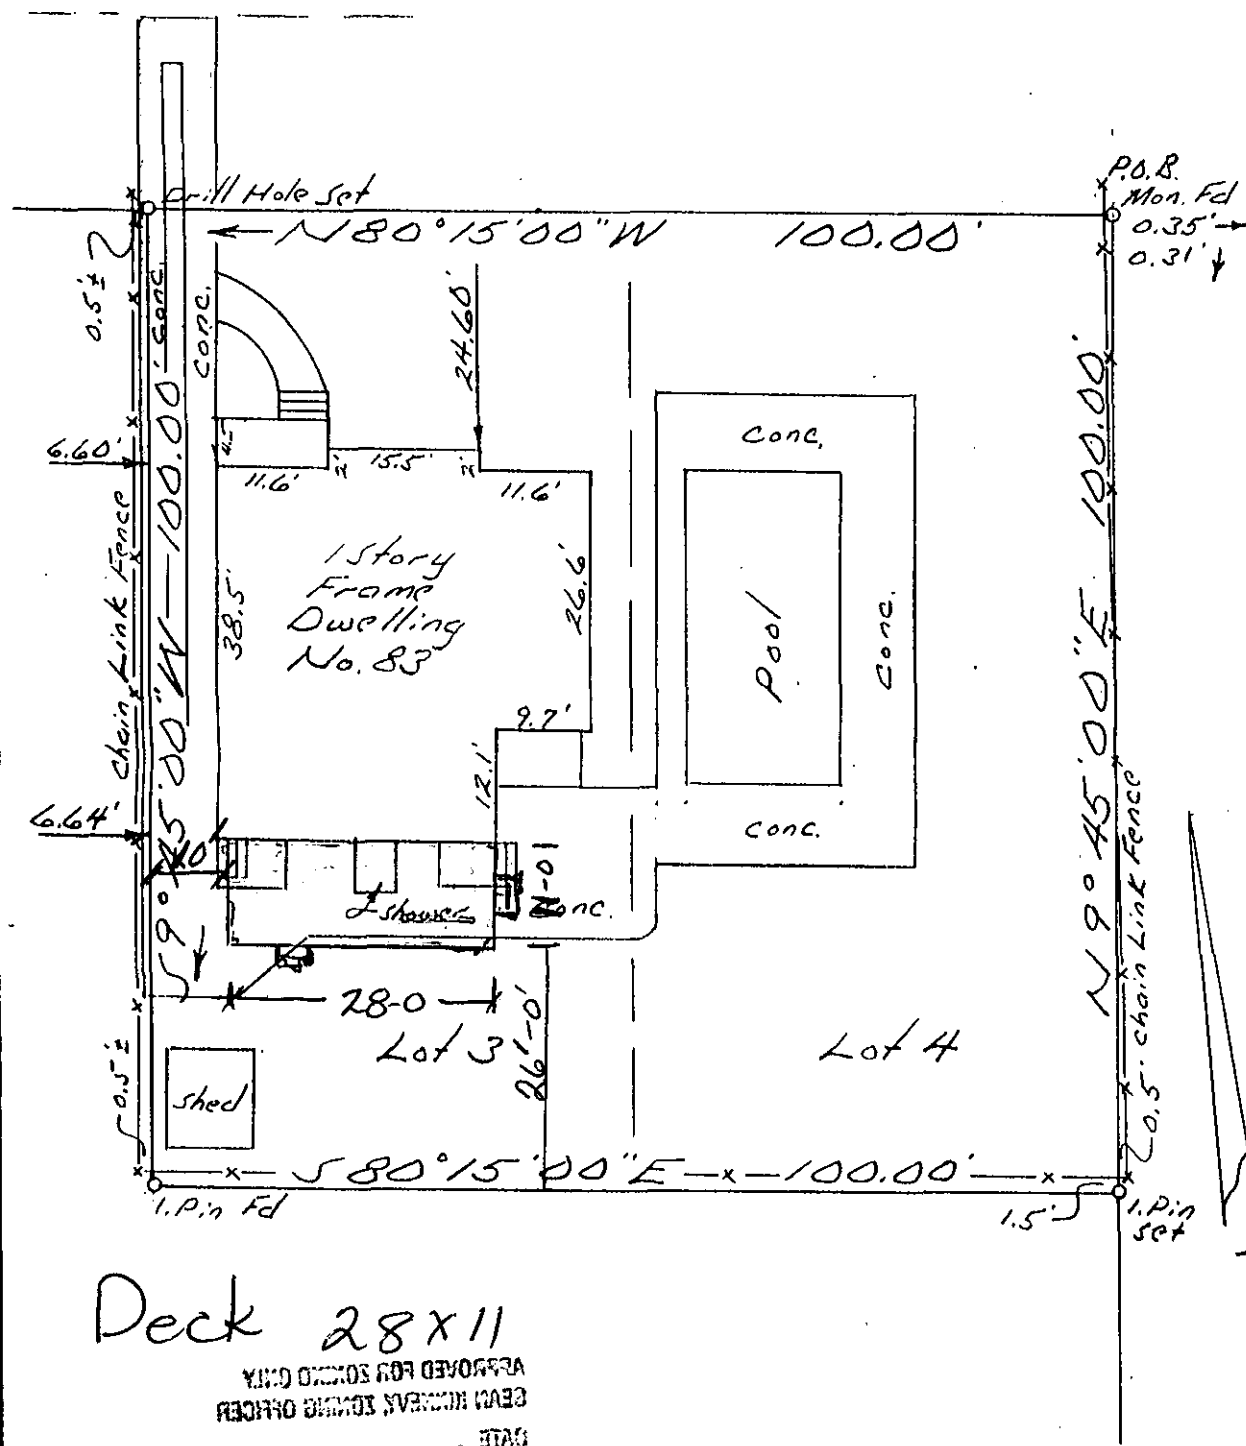

SUNNYDALE DRIVE (50' wide)
formerly
PINWOOD DRIVE

Filed Map
D-266

PREMISES SURVEYED FOR

JOHN C. WALSH
BRICK TOWNSHIP, OCEAN COUNTY, N.J.

SURVEYED July 14, 1994

SCALE 1" = 20'

Certified to John C. Walsh and Barbara L. Walsh, husband and wife;
Chicago Title Insurance Company; Sovereign Bank, FSB, its
successors and/or assigns; Peter D. Kearns, Esq.

Elbert Morris, P.E.

Elbert Morris
Lic. L.S. No. 8509

MORRIS & GLASGOW, INC.
ENGINEERING AND SURVEYING
1119 ARNOLD AVENUE
POINT PLEASANT BORO, N.J.

Charles W. Glasgow
Lic. P.E. & L.S. No. 9095

MAP No. 2-2774

BOOK
94-177

APPROVED FOR ZONING ONLY
SEAN KINNEVY, ZONING OFFICER
DATE 4-12-00 SK