


MORGANVILLE ROAD
(ROW VARIES)

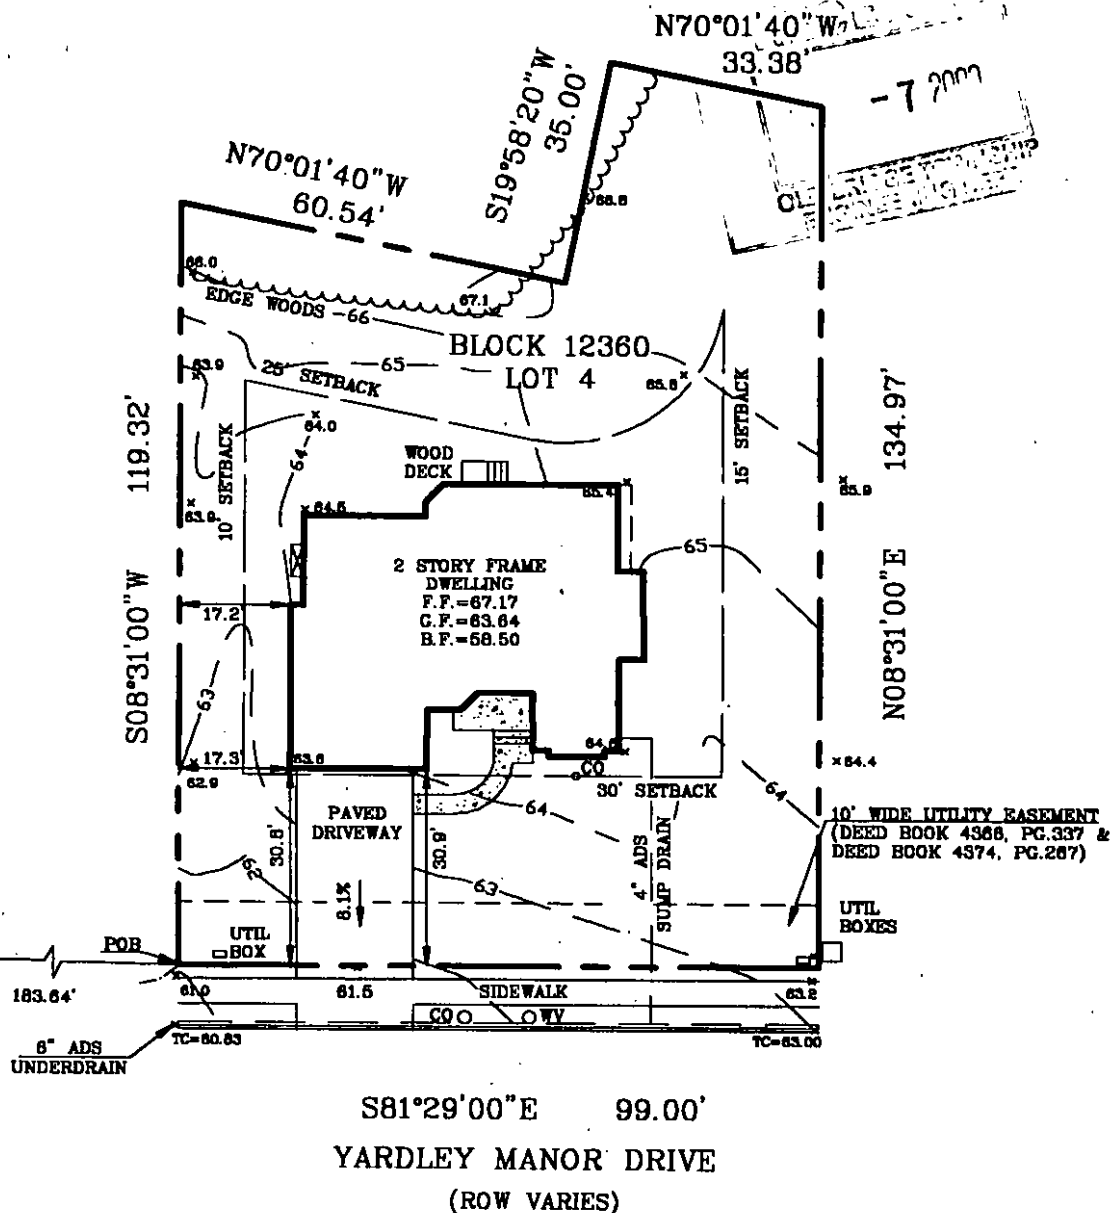

REFERENCES:

A FILED MAP ENTITLED: "FINAL PLAT - PHASE 1 SECTION 1A & 1B OF YARDLEY MANOR " FILED 11/15/98 AS MAP NO. 5778 FILE 981.

D2 MODEL



Brunswick Surveying Incorporated
LAND SURVEYORS
61 STELTON ROAD PISCATAWAY, NEW JERSEY
(732) 752-0100 08854

AS BUILT SURVEY
TOWNSHIP OF OLD BRIDGE
MIDDLESEX COUNTY, NEW JERSEY
JOB 46 - #5 YARDLEY MANOR DRIVE
BLOCK 12360 LOT 4

THIS WORK PREPARED UNDER MY
IMMEDIATE SUPERVISION

Drawn by JK Job No. 601296 Date 5/16/00

Checked by RSZ Drawing No. YM-46AB Scale 1"=30'

ROBERT M. HORVATH N.J.L.S. 27476
X RICHARD S. ZINN N.J.L.S. 34888
JAY A. STUHL, JR. N.J.L.S. 36762