


RECEIVED

JUL 21 1991

Hopewell Township Health Dept.

BLOCK No. 91
LOT No. 25.02
Containing 1.959± ac.

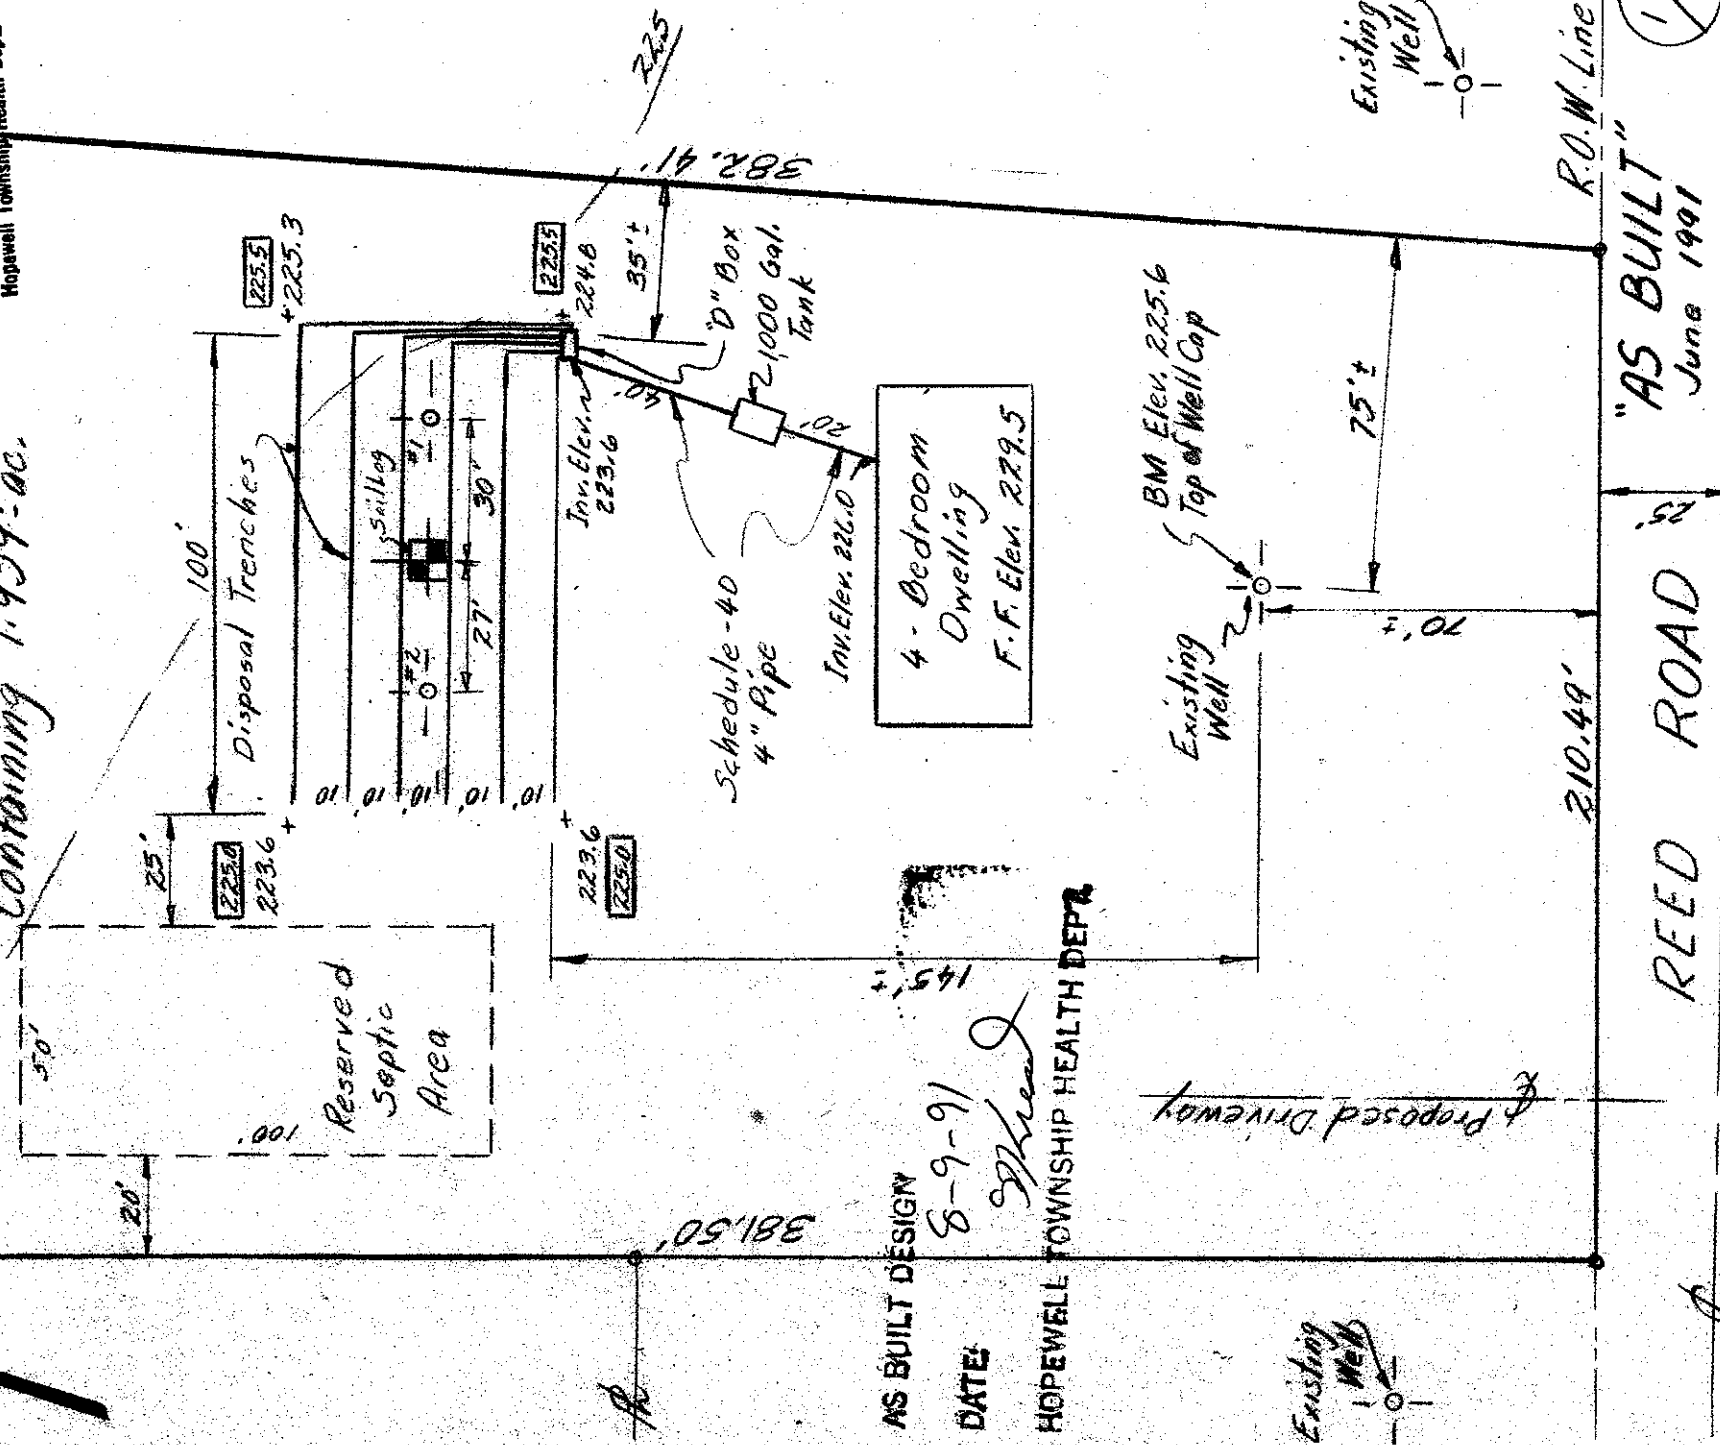

AS BUILT DESIGN
DATE: 8-9-91
HOPEWELL TOWNSHIP HEALTH DEPT.

"AS BUILT"
June 1991

LEGEND
000 - Existing Grade
000 - Proposed Grade

KOLODZIEJ

Hopewell Township - Mercer County
New Jersey

JOHN M. WALDNER, P.E. #15525

Licensed New Jersey Professional Engineer

John M. Waldner

69 Upper Ferry Rd, Trenton, N.J. 08628

SEPTIC SYSTEM DESIGN

Block No. 91

Date: Nov. 1989

Lot No. 25.02

Scale: 1" = 40'

Rev. Jan. 1990