




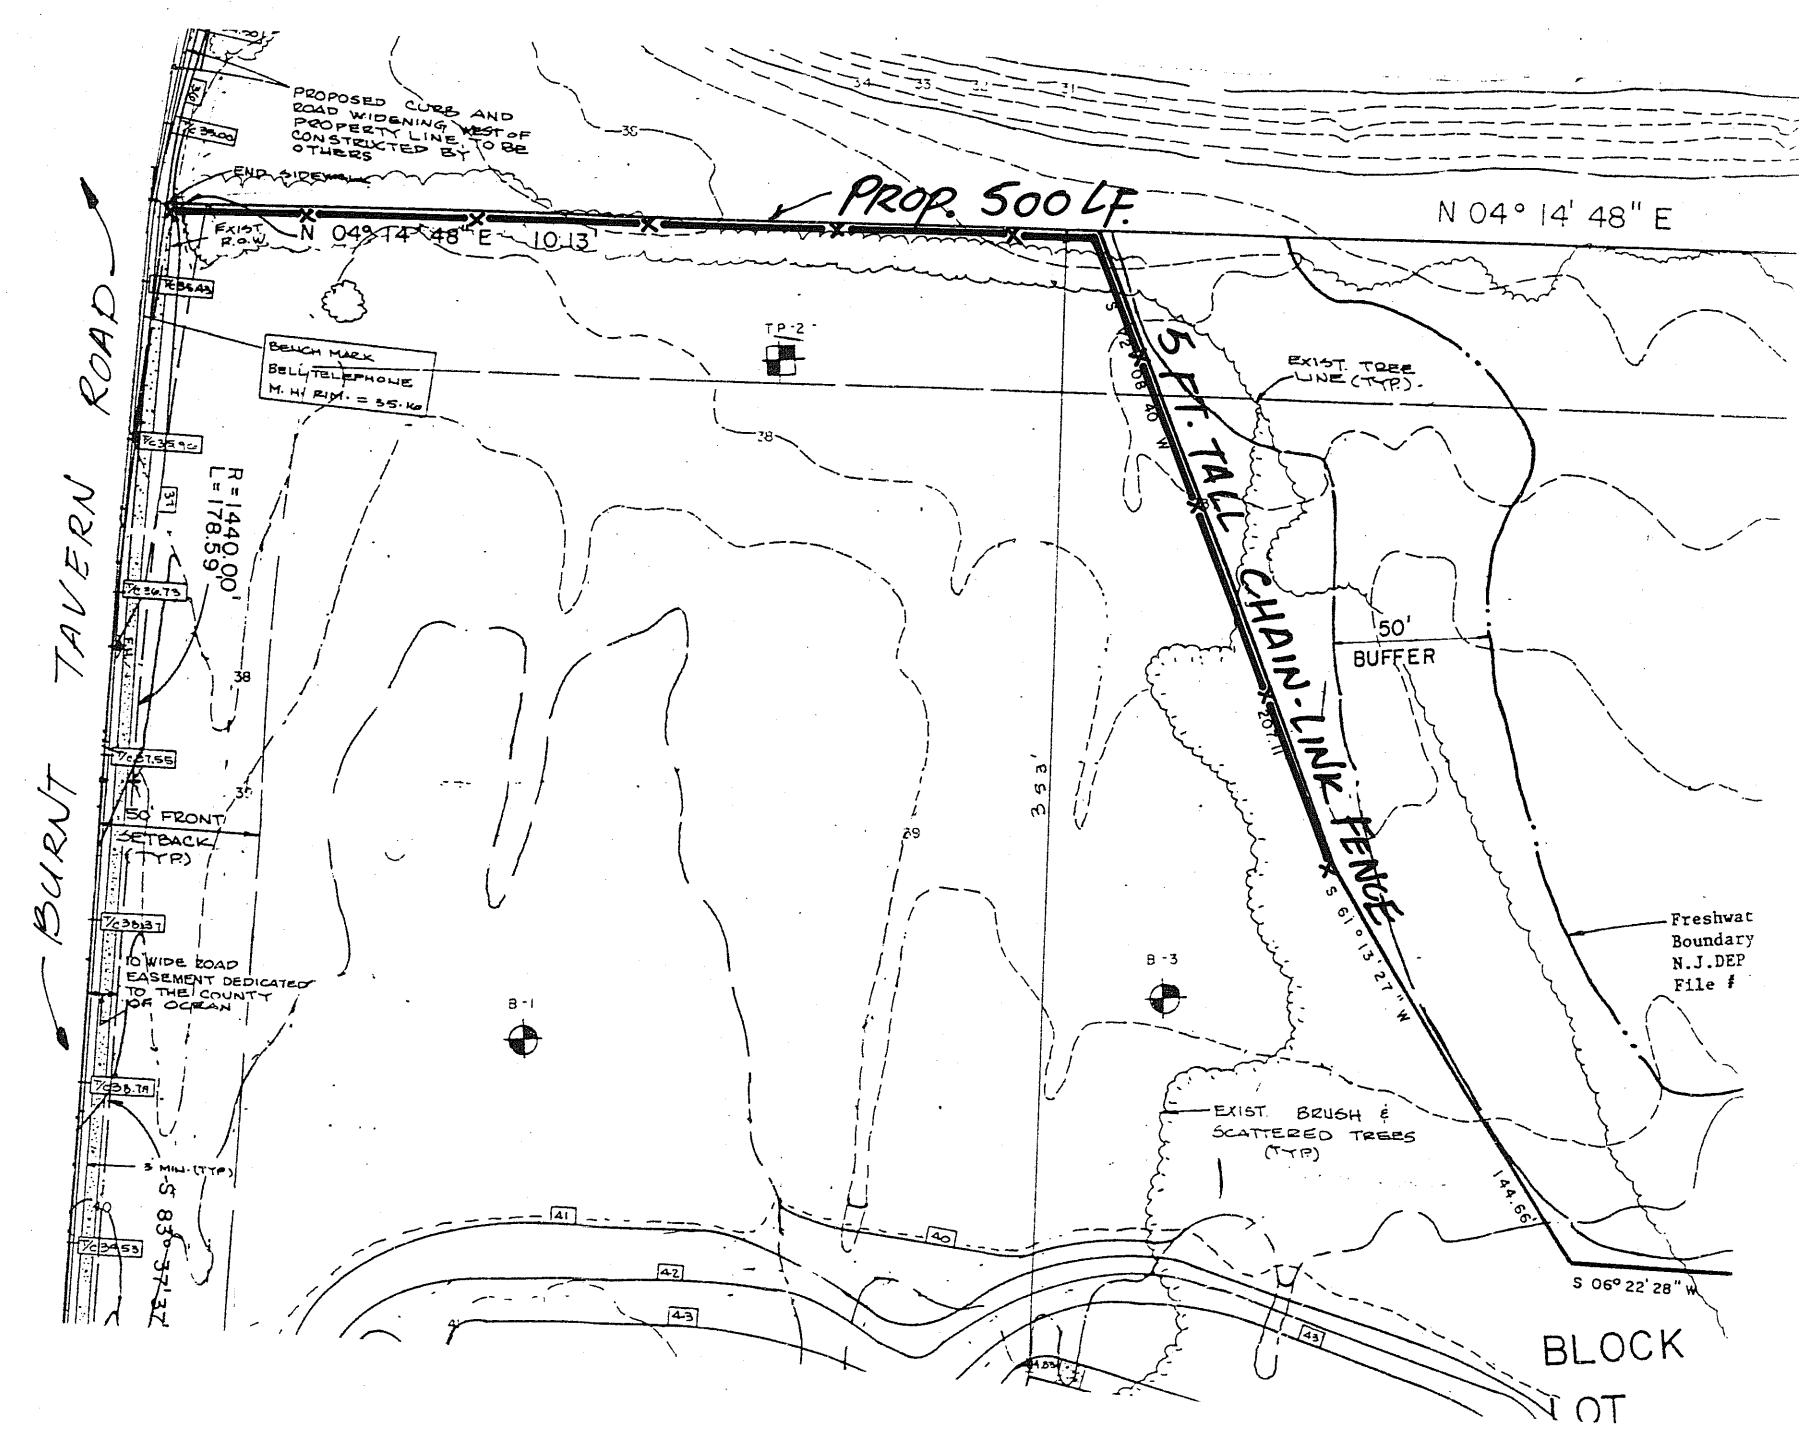


FENCE "A"
1"=60'

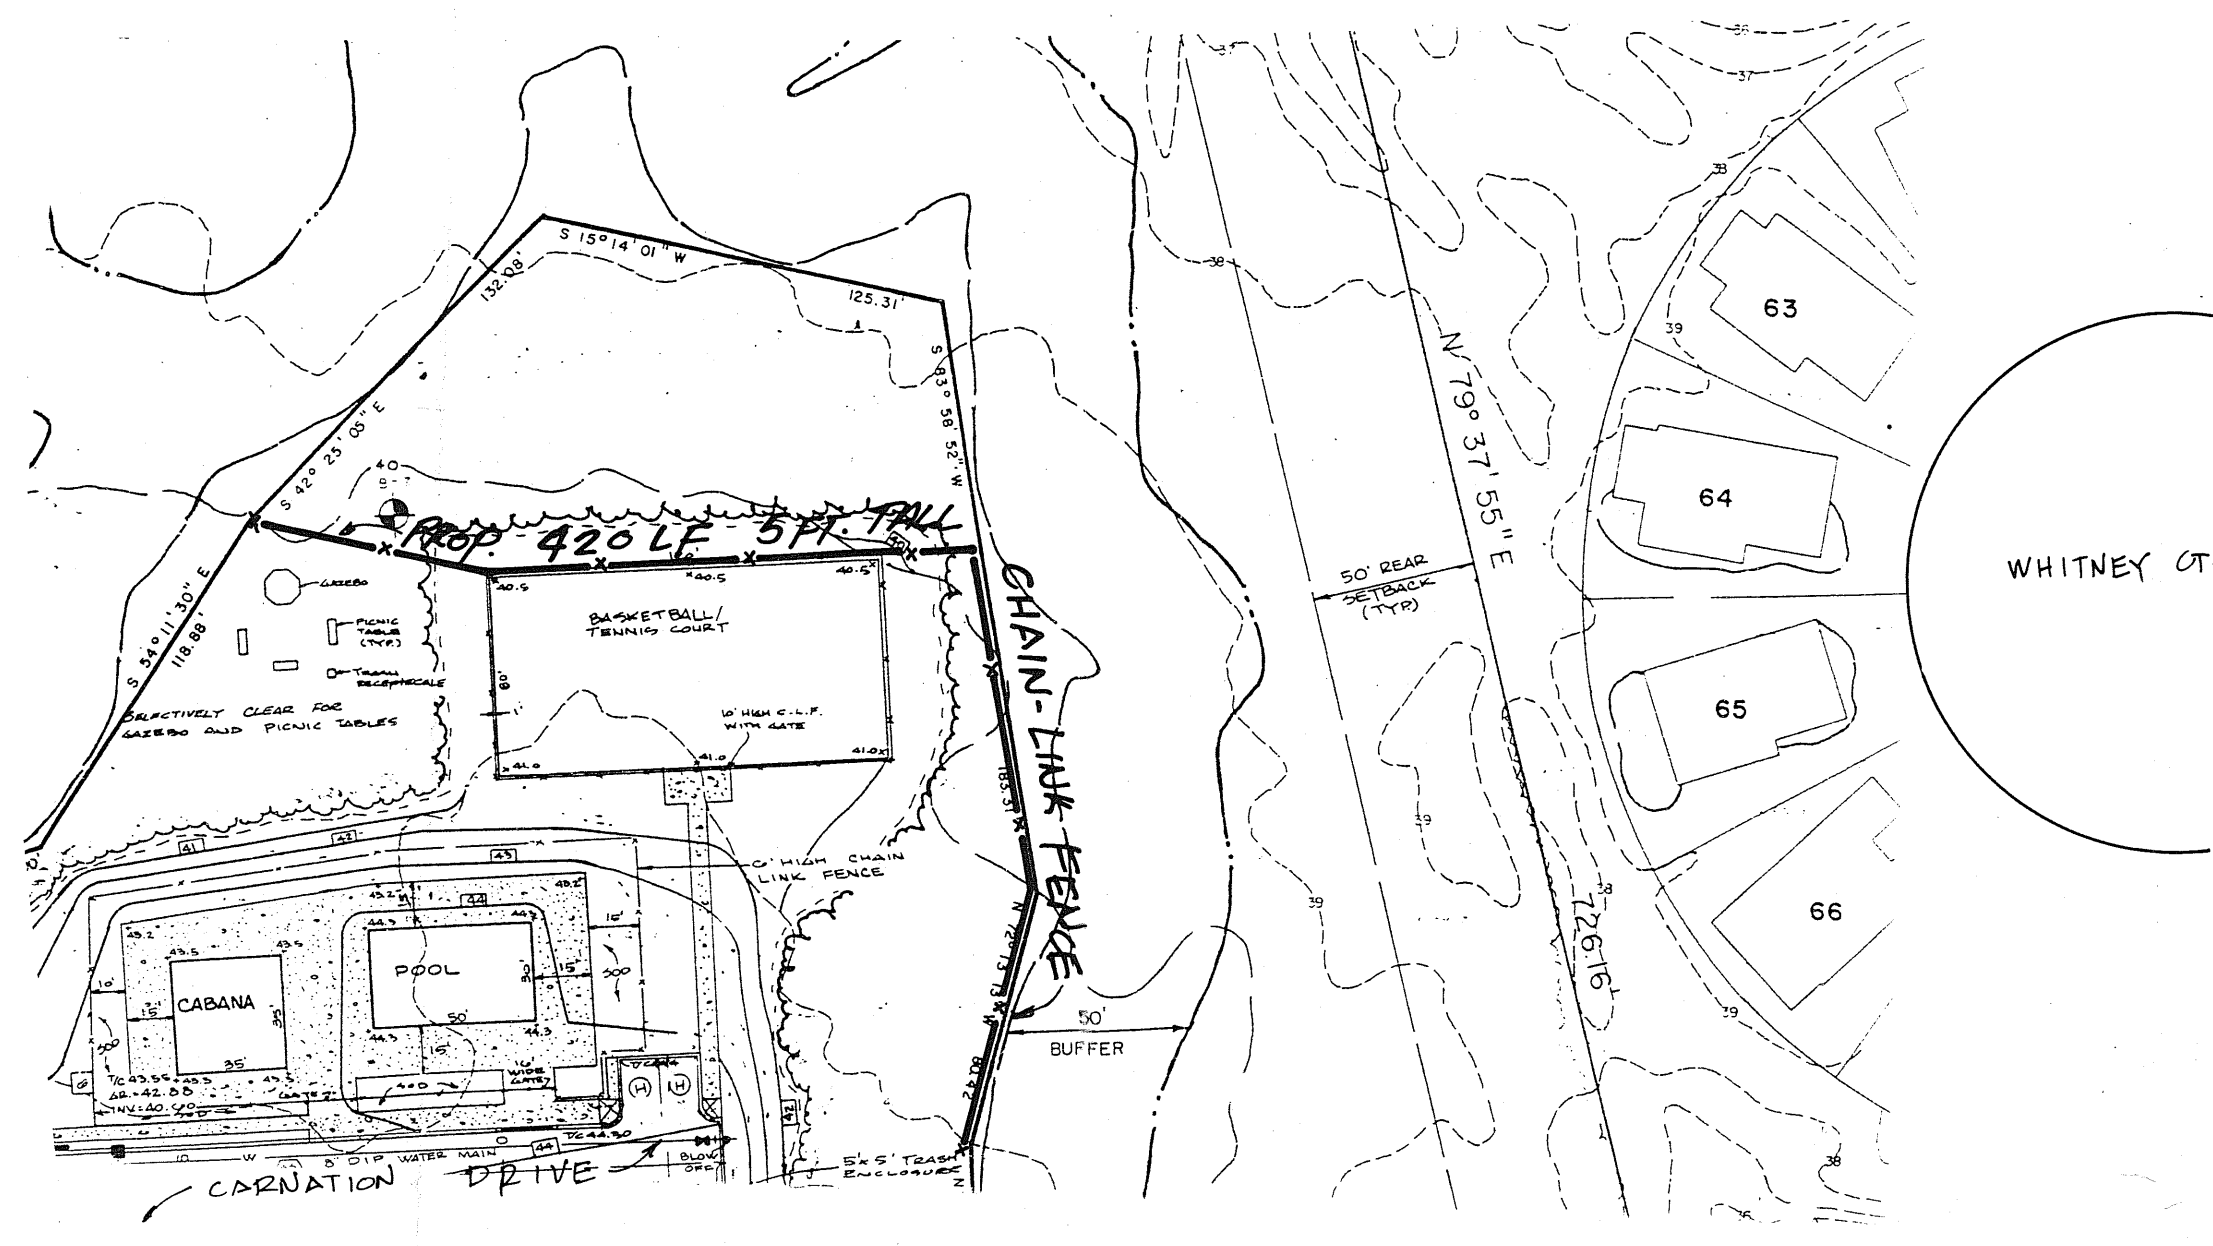


FENCE "B"
1"=60'

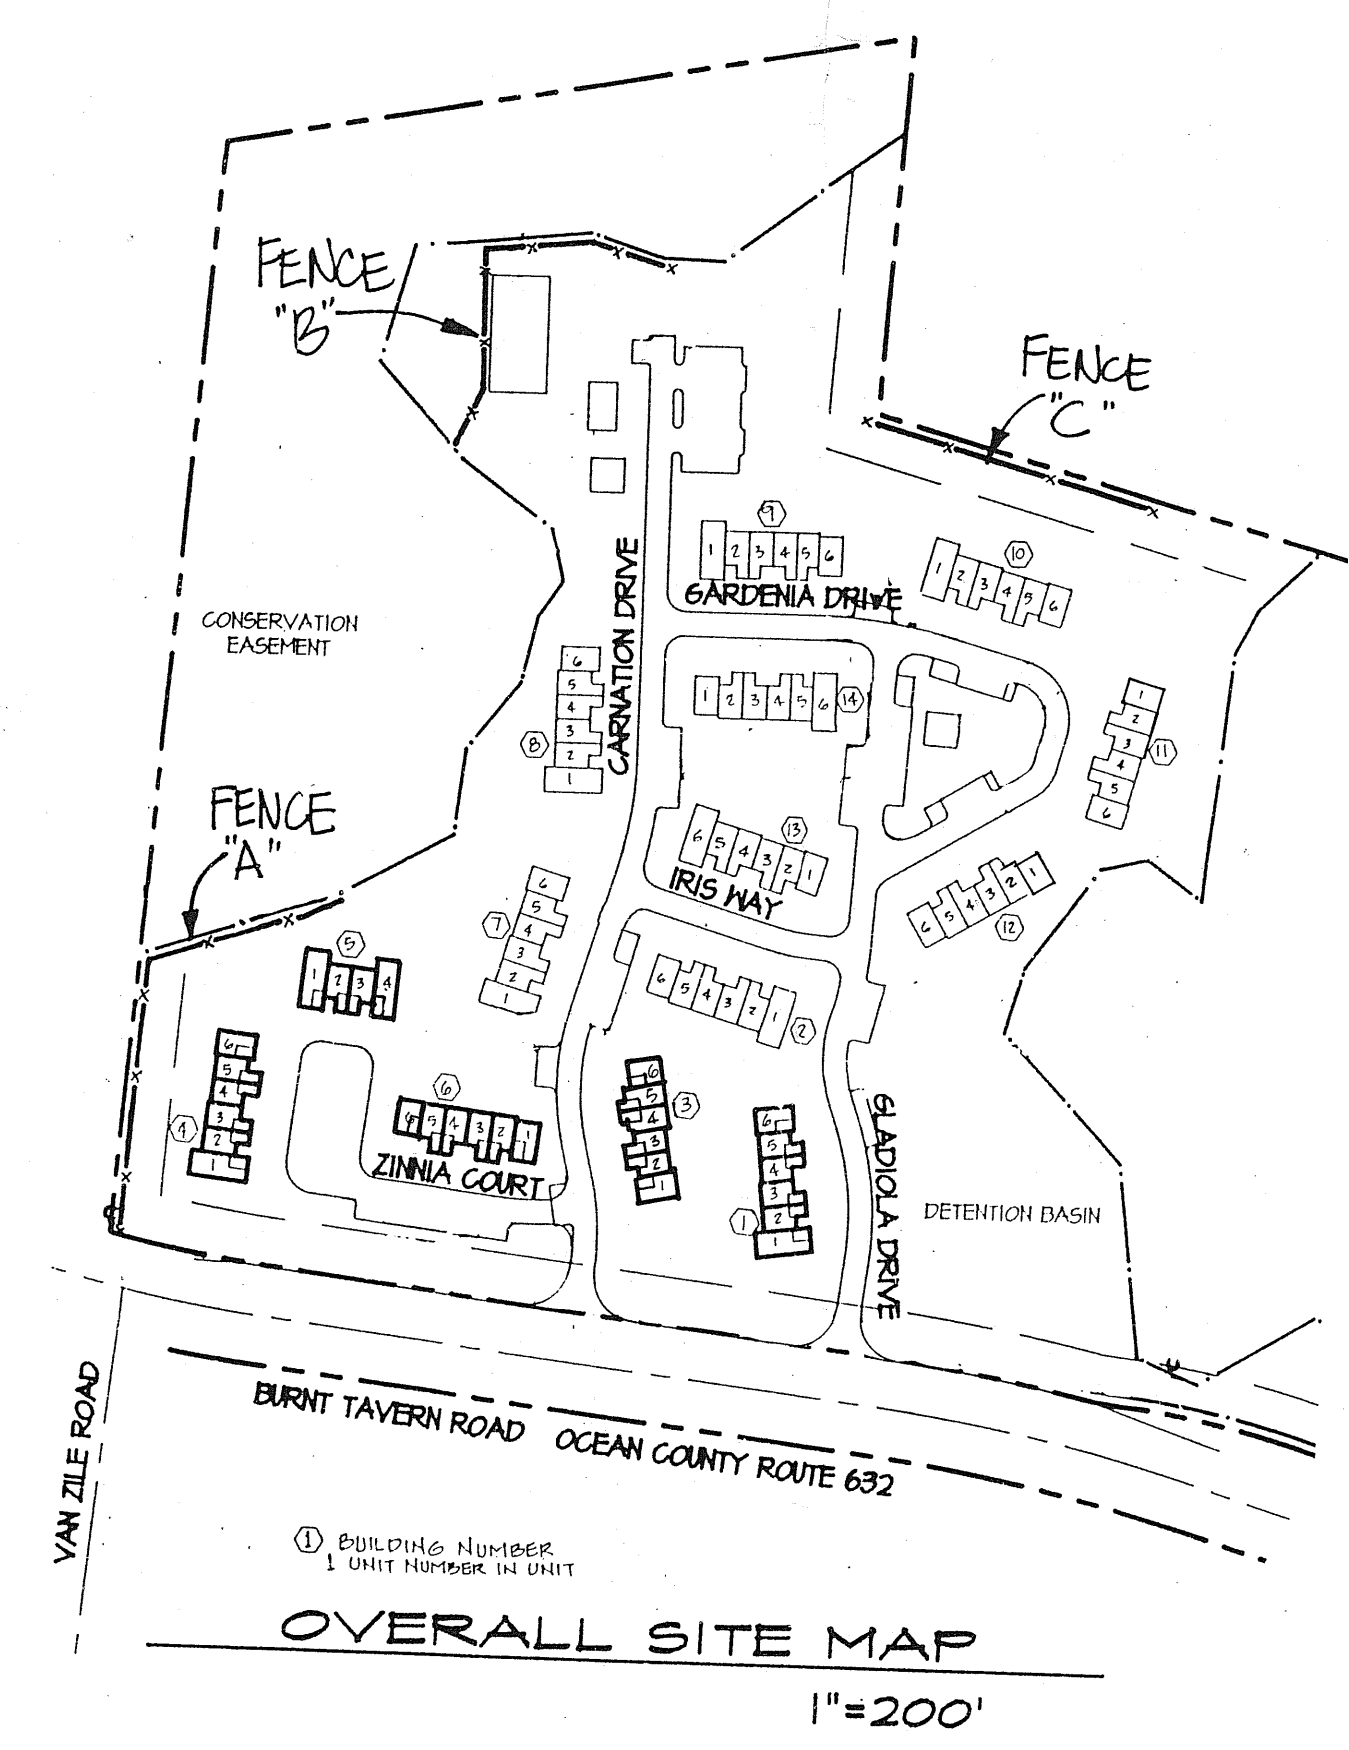

OVERALL SITE MAP
1"=200'

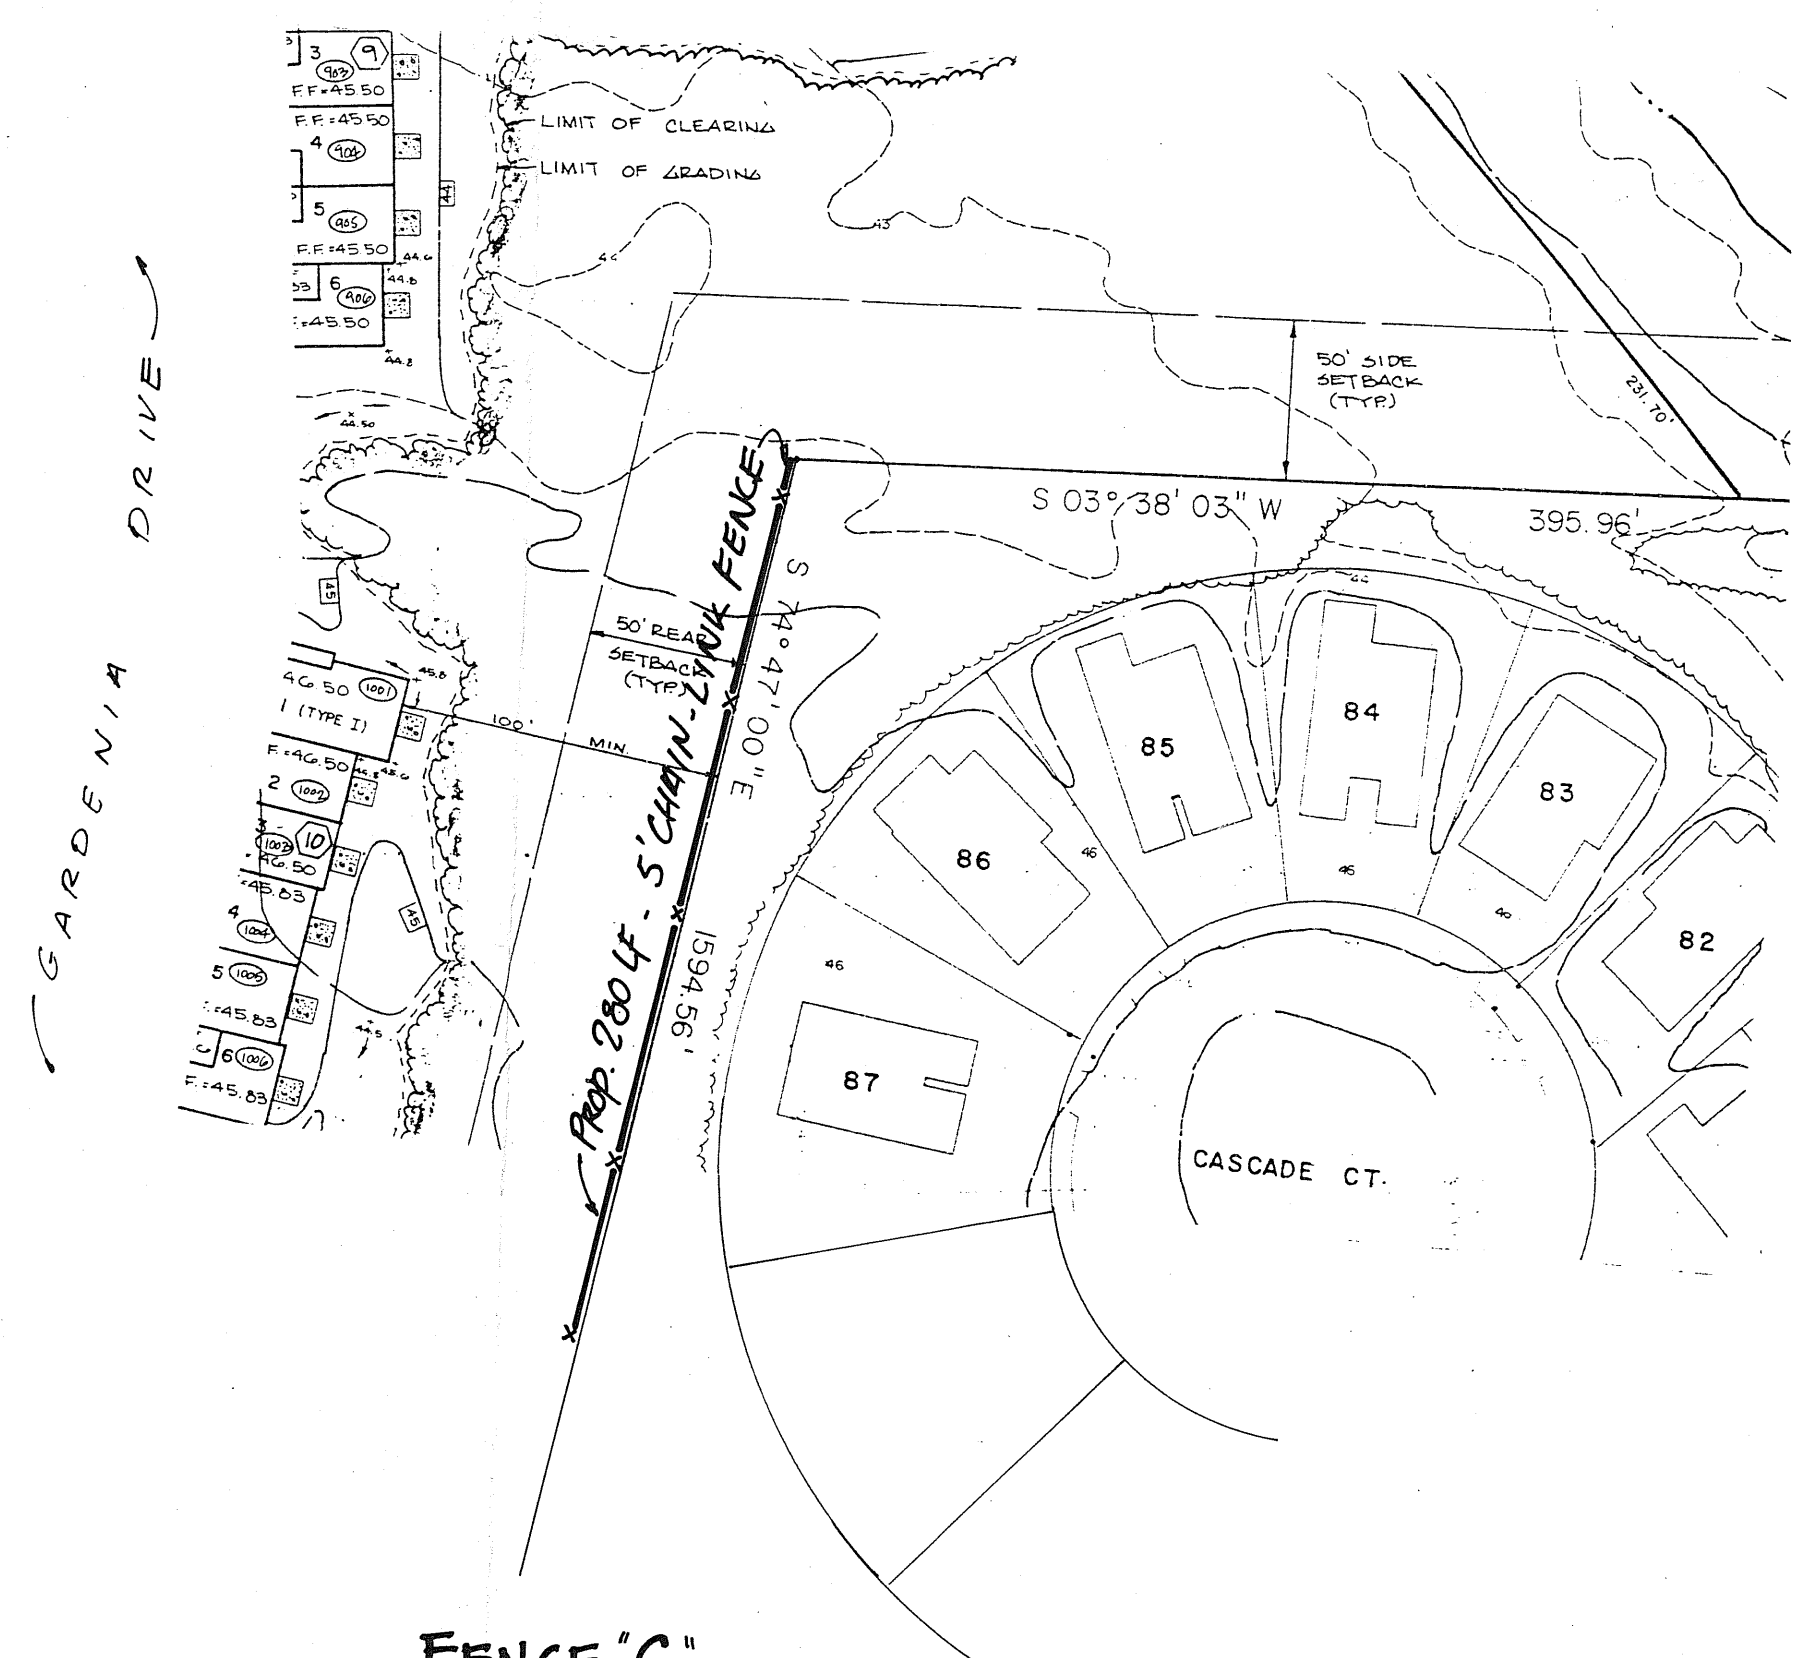


FENCE "C"
1"=60'

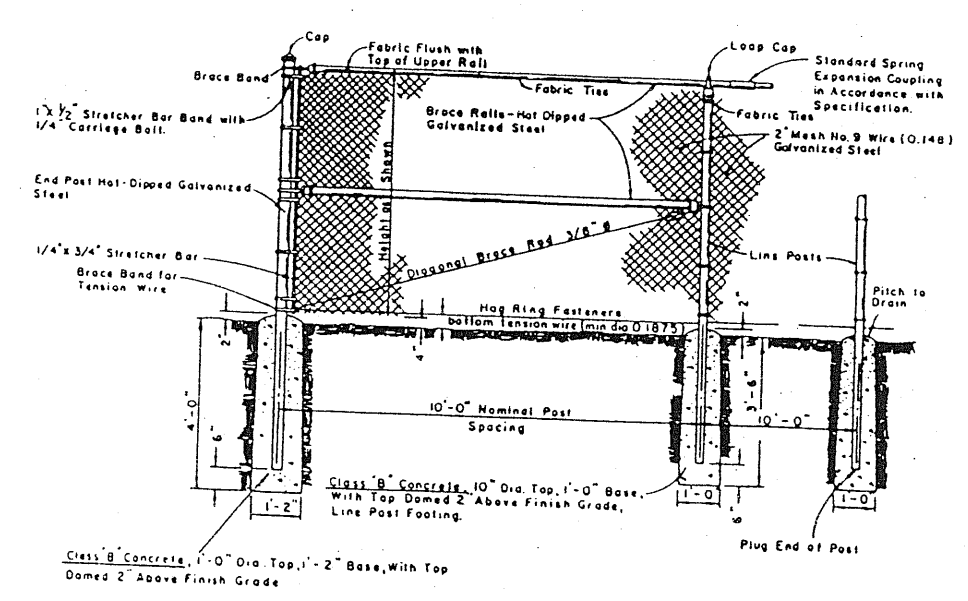

- NOTES:**
- Fence shall be Galvanized Steel Type Construction. See Plans and Contract Documents for Type Specified.
 - Post Size to be in Accordance with Schedule Cited in Contract Documents.
 - Footing Sizes Vary with Nominal Fence Height - See Contractor Documents.
 - Unless Otherwise Provided, Fence Details Shall Conform to the Requirements of ASTM A 95.1-90.
 - All 6' and 10' High Fences shall have Bottom Rail in place of Bottom Tension Wire.

5 FT. TALL CHAIN LINK FENCE

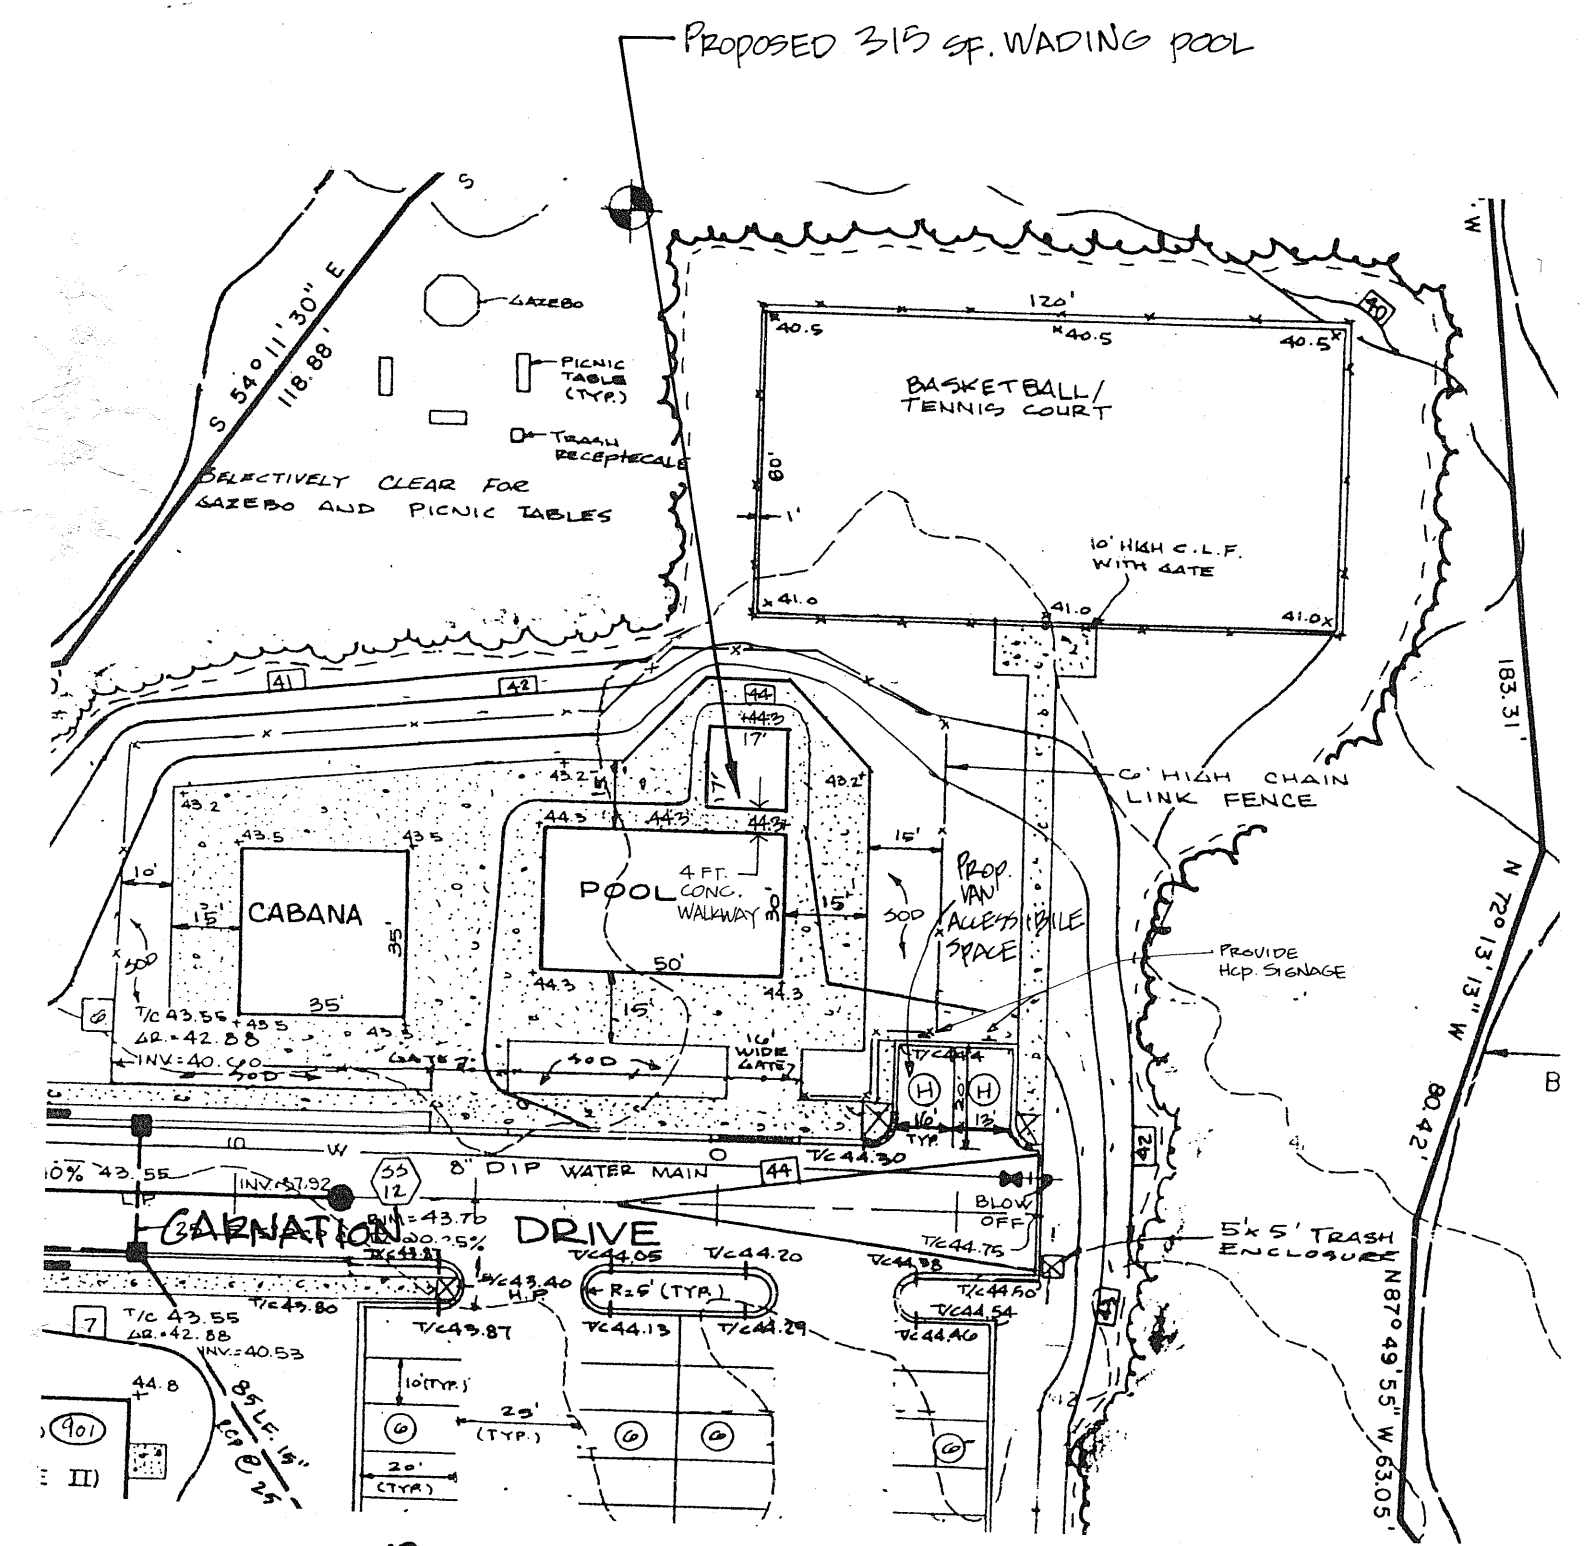

PLAN OF WADING POOL ADDITION
1"=40'

APPROVED BY THE TOWNSHIP OF BRICK ZONING BOARD.

Christine Rapas 7/24/97
ZONING BOARD SECRETARY
Frank J. Baer, Jr. 7/24/97
ZONING BOARD ENGINEER

DATE	REVISION	BY	CHK.
7/24/97	ADD SIGNATURE BLOCKS OF C.B. & B.T.M.		
2/10/97	ADDED VAN ACCESSIBLE P.D., TRAILER, & 1/2" WALL WIDTH	RM	
7/24/97	ADDED 4' WALKWAY BETWEEN WADING & MAIN POOL	RM	

PLAN OF POOL ADDITION & PROPOSED FENCES
AT
WOODS OF LAUREL
LOT 2, BLOCK 1210.15
OCEAN COUNTY BRICK TOWNSHIP NEW JERSEY

WSB engineering group, p.a.
Weinert * Smildzins
engineering * environmental planning * surveying * architecture
1018 Schenck's Mill Line Road, Toms River, New Jersey 08753
Prepared under the supervision of:
FRANK J. BAER, JR.
N.J.P.E. 26716 N.J.P.F. 02801

THIS IS TO CERTIFY THAT THE WATER AND SEWER MAIN DESIGN CONFORMS WITH THE RULES AND REGULATIONS OF THE BRICK TOWNSHIP MUNICIPAL UTILITIES AUTHORITY.
Frank J. Baer, Jr. 7/28/97
DATE
DIRECTOR OF ENGINEERING

des.	date	11/12/96	scale	As NOTED
dwn. RM.			job no.	1805-186
chk.	sheet	5A of 5	dwg no.	6192