


WOOSAMONSA ROAD

S 88°44' W 226.0'

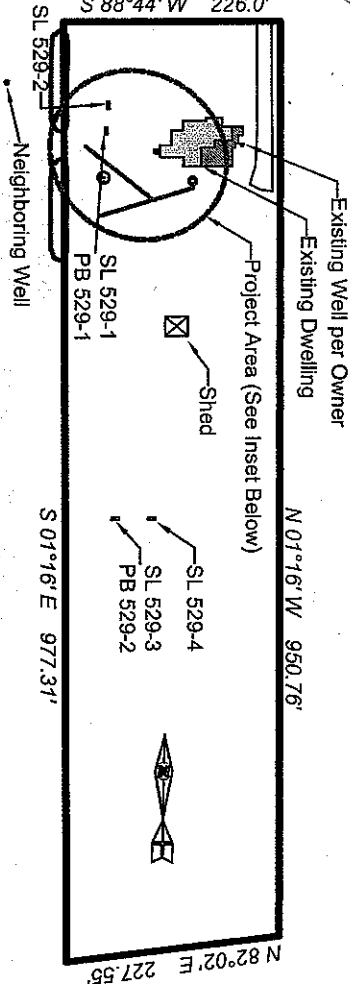


N 01°16' W 950.76'

S 01°16' E 977.31'


N 82°02' E 227.55'

NOTES:
The septic tank and septic tank effluent filter require routine maintenance. Pumping of the septic tank is recommended to be performed every 2 to 3 years. Cleaning of the septic tank effluent filter shall be performed during septic tank pumping and shall not to exceed a 3 year period. More frequent cleaning cycles may be required depending on household habits/use.

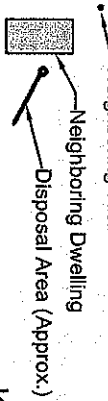

AS - BUILT DESIGN
Key Map
1" = 200' DATE: 10/16/13

26 Woosamonsa Road (Block 49, Lot 16)
Hopewell Township, Mercer County, NJ
APPROVED
HOPEWELL TOWNSHIP HEALTH DEPT.

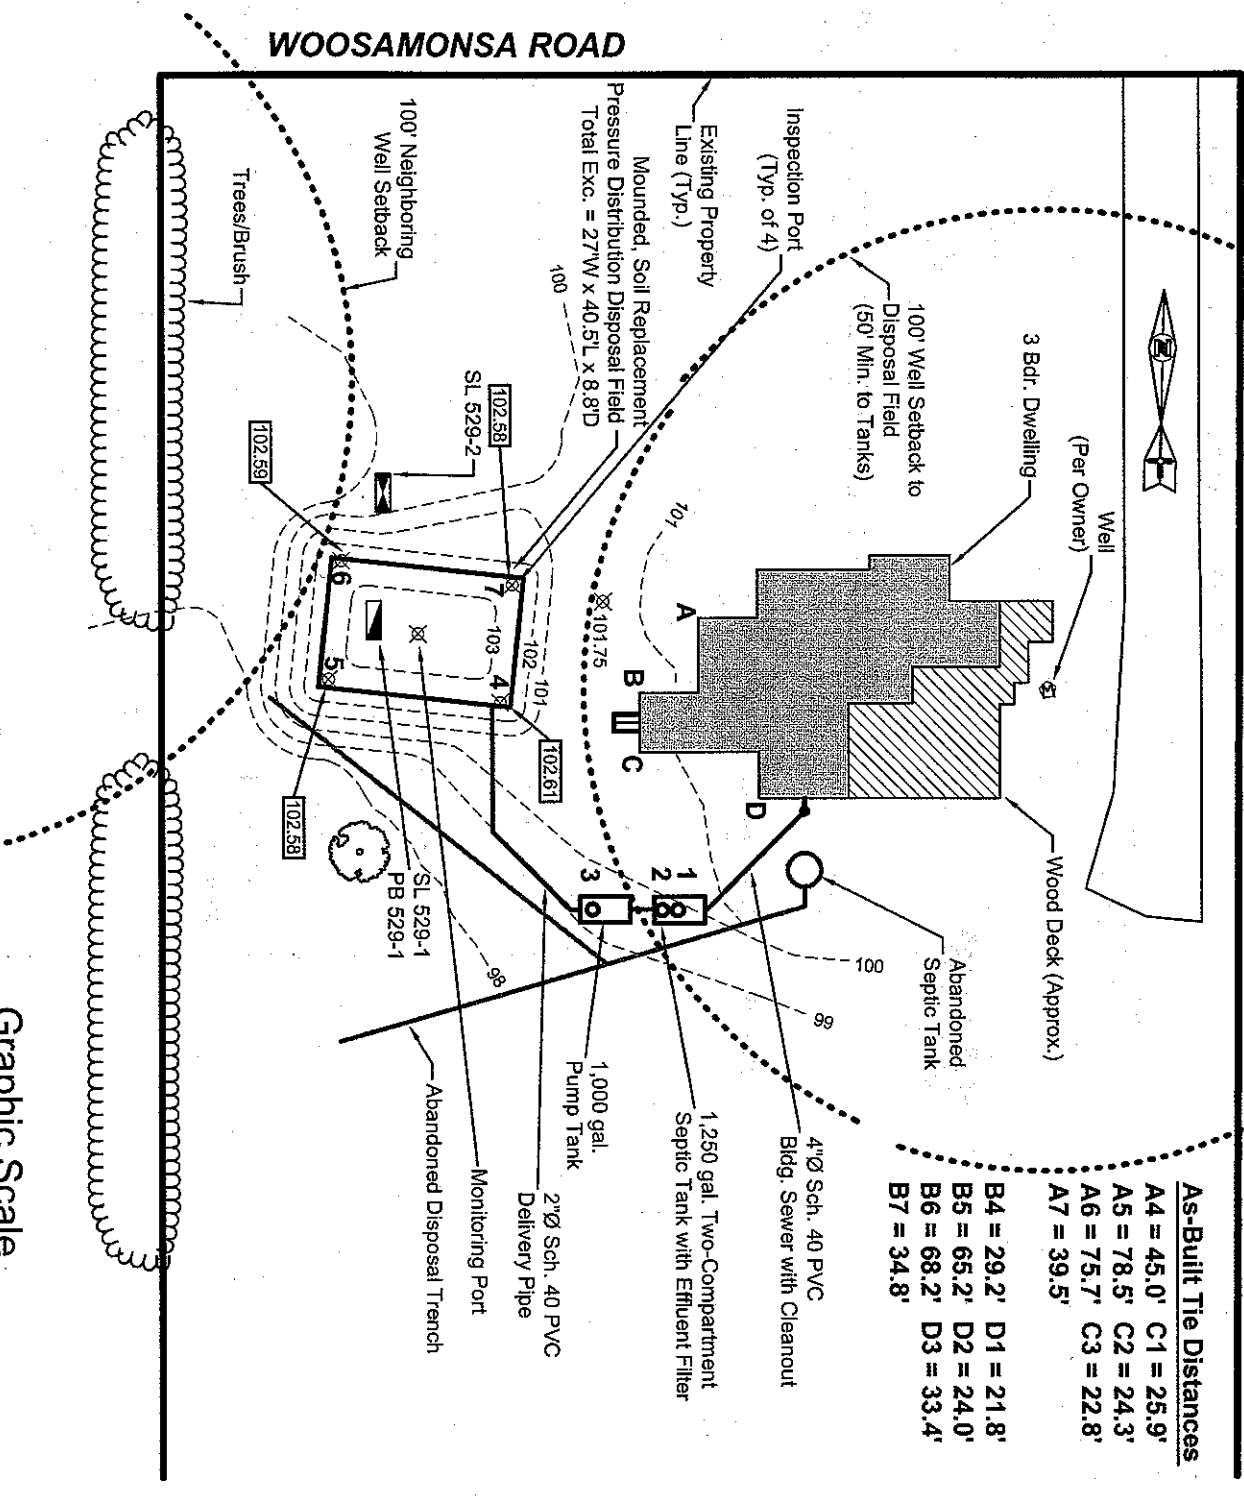

As-Built Tie Distances

A4 = 45.0' C1 = 25.9'
A5 = 78.5' C2 = 24.3'
A6 = 75.7' C3 = 22.8'
A7 = 39.5'
B4 = 29.2' D1 = 21.8'
B5 = 65.2' D2 = 24.0'
B6 = 68.2' D3 = 33.4'
B7 = 34.8'

REVISION DESCRIPTION	DATE	APPROVED



Septic System Alteration Design
Record Drawing Plan

Peter Tyson & Megan Miller Block 49, Lot 16 Hopewell Township, Mercer County, New Jersey 26 Woosamonsa Road

DRAWN BY:	DESIGNED BY:	CHECKED BY:	DWG NO.	BRE JOB#:	SCALE:	DATE:	SHEET:
ARL	WMU	THB	REC-1	13-1320	As Noted	September 27, 2013	1 of 1

THEODORE H. BAYER, P.E.
New Jersey Professional Engineer License No. GE33806



BAYER-RISSE ENGINEERING, INC.
78 ROUTE 173 WEST, SUITE 6
HAMPTON, NEW JERSEY 08827
PHONE 908-735-2255 FAX: 908-735-5838
Certificate of Authorization No. 246327834300