

BERGMAN HATTON ASSOCIATES

a professional corporation

Consulting Engineers

University Park Plaza
741 Alexander Road
Princeton, N.J. 08540-6390
(609) 452-0580

WEST WINDSOR TOWNSHIP

HEALTH AUTHORITY APPROVAL


Subdivision Princeton Oaks (Huntington)

Street Address 10 Huntington Dr.

Block 21-08 Lot 42

Inspection of On-Site Sewage Disposal System


Accepted:

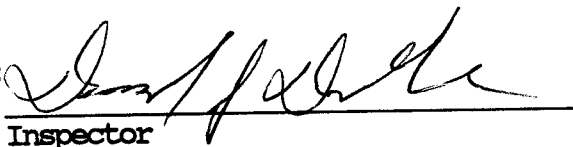
Inspector

5-10-88
Date

NOTE: Issuance of this Certificate indicates:

1. Septic system construction inspected and accepted
2. Permanent marker is in place
3. As built of system has been received and is on file in Township construction files

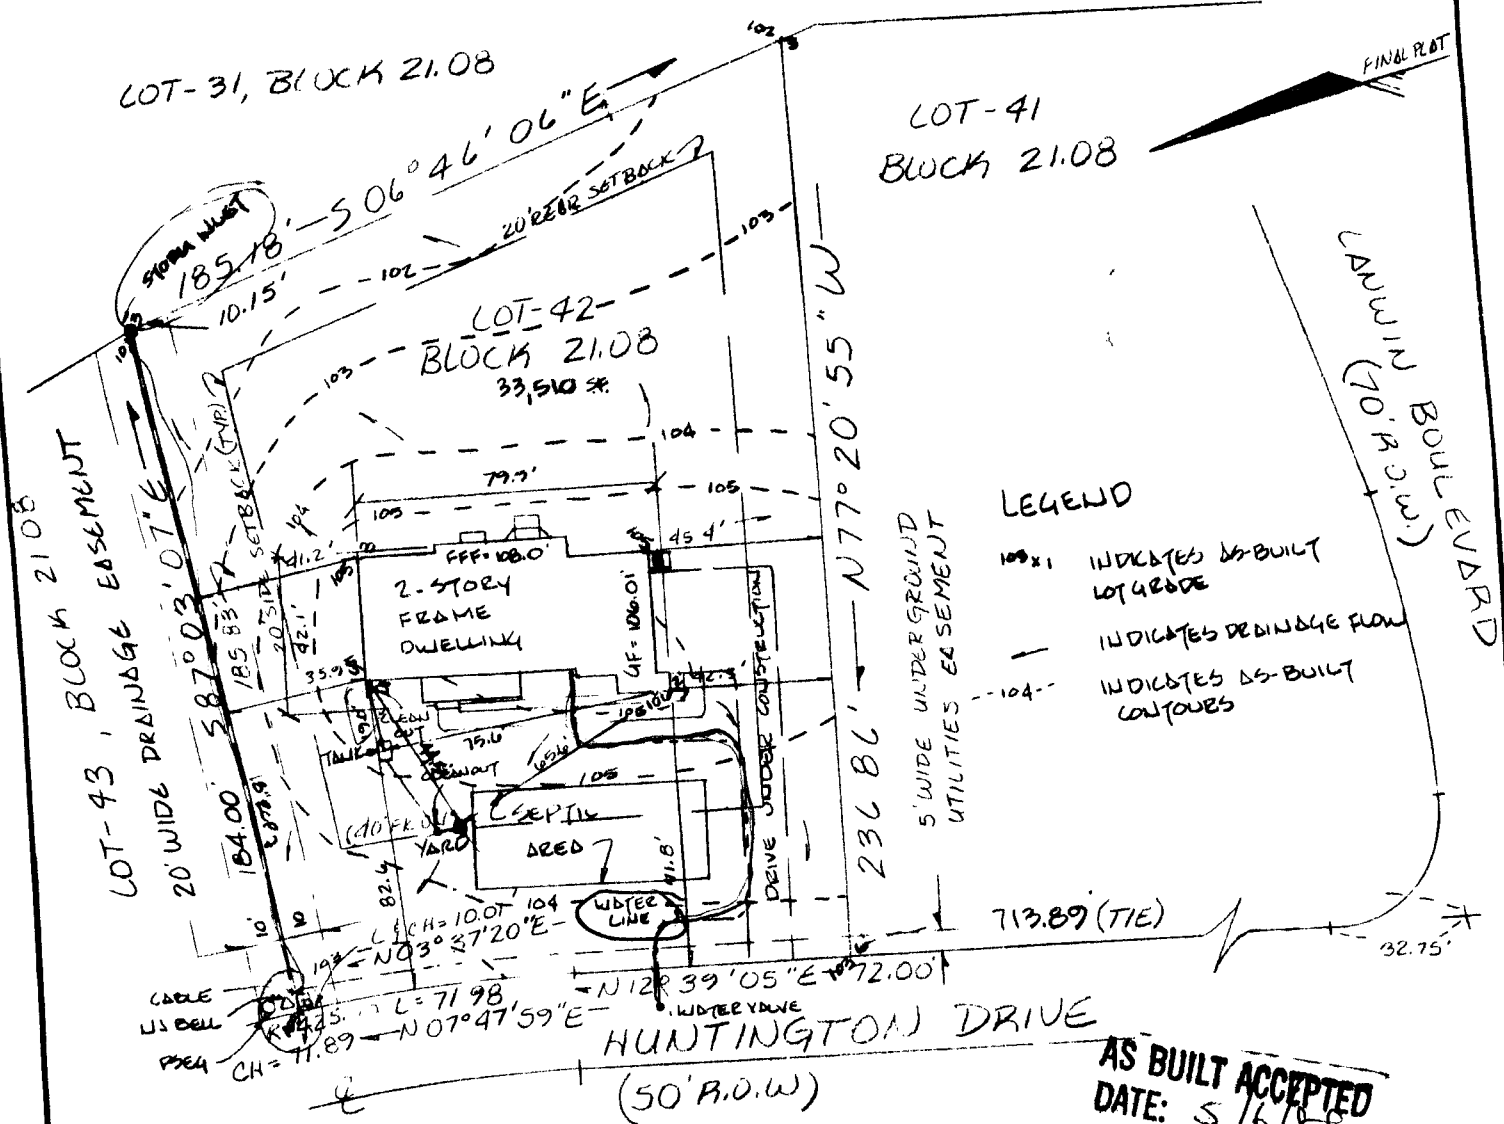

I HEREBY CERTIFY THAT THE FILTER SAND USED IN THE CONSTRUCTION OF THE DISPOSAL FIELD SHOWN HEREON CONFORMS TO THE CURRENT SPECIFICATIONS OF WEST WINDSOR TOWNSHIP.

D. GEOFFREY BROWN, P.E. #24327

I HEREBY CERTIFY THAT THE AS-BUILT GRADING SHOWN HEREON IS IN CONFORMITY WITH THE APPROVED LOT GRADING PLAN

D. GEOFFREY BROWN, P.E. #24327

NOTE:

CORNERS NOT SHOWN HAVE NOT BEEN SET AS PER CONTRACTUAL AGREEMENT.

REFERENCE PLAN:

FINAL PLAT, HUNTINGTON VILLAGE - PRINCETON OAKS, LOCATED IN WEST WINDSOR TOWNSHIP, MERCER COUNTY, NEW JERSEY, SCALE 1"=100', DATED 5-15-86 AND FILED IN THE MERCER COUNTY CLERKS OFFICE ON 5-12-87 AS MAP # 2835.

5-6-88

Needs Final Grading
Over Field

5-10-88 signed by E.W.