

DEPARTMENT OF HEALTH
Cape May County
Cape May Court House, N. J.

COURTWAY ASSOC.

MEMO TO PROPERTY OWNER

Attached hereto is your Permit No. 57596C to construct a sewage disposal system as described in engineering data submitted on 12/13/88.

The "X" marked items apply:

.. XXX. Copy of plans to be retained by you.

.. XXX. Extra copy of plans to be signed and dated by the licensed well driller who has installed your well. Have well driller complete the appropriate section on plans marked "Attention Well Driller." When this is done, return plans to

DEPARTMENT OF HEALTH
CAPE MAY COUNTY
CREST HAVEN COMPLEX

CAPE MAY COURT HOUSE, N. J. 08210

.. XXX. A sample of raw water from every proposed water system shall be bacteriologically tested--copy of the analytical results shall be submitted to this office before a "Certificate of Compliance" will be issued.

.. XXX. A sample of raw water from every proposed Non-public water system shall be tested for nitrates, iron, manganese and pH--copy of the analytical results shall be submitted to this office before a "Certificate of Compliance" will be issued.

.. XXX. A sample of raw water from every proposed Public Non-community water system shall be tested for nitrates, iron, manganese, pH, arsenic, barium, cadmium, chromium, lead, mercury, selenium, silver, and fluoride--copy of the analytical results shall be submitted to this office before a "Certificate of Compliance" will be issued.


.. XXX. The building inspector has been notified so that your building permit can be issued.

LOUIS J. LAMANA, M.A., H.O.,
PUBLIC HEALTH COORDINATOR

Division of Environmental Health

LJL/jam

SEASONAL GROUND WATER

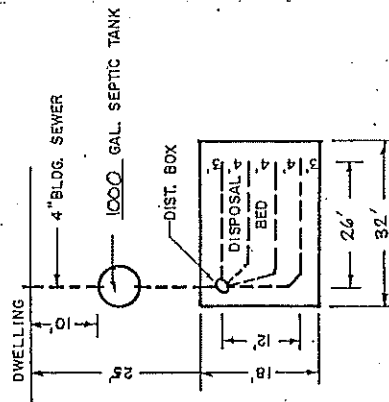

LOT
48.23

Proposed septic design
will not support
a garbage grinder.

When calling for Final Inspection of
Sewage Disposal System or Water Supply,
~~Never to Mr.~~ Mr. [unclear]

~~This system must be inspected by a senior man from the Cape May County Dept of Health, before it is covered from view.~~

This date has been examined by the
May County Dept. of Health and was
acceptable for immediate use and was
under the supervision of the health
department. The date of use was
BLOG 5
LOT 48-24

Well that he located the car and tow him back to the garage and driven to a dealer. The car can be located 50 or more. Then it can be located 50 or more. Then it can be located 50 or more.


[illegible]

DEC 2 1989

Department of Health

CONTAINER TO NOTIFY THE APPLICANT
BY AIRMAIL AS EARLY AS POSSIBLE
TO COMPLETION OF INSPECTION OF
DISPATCH AND TO BE COMPLETED

SCALE: 1" = 100'

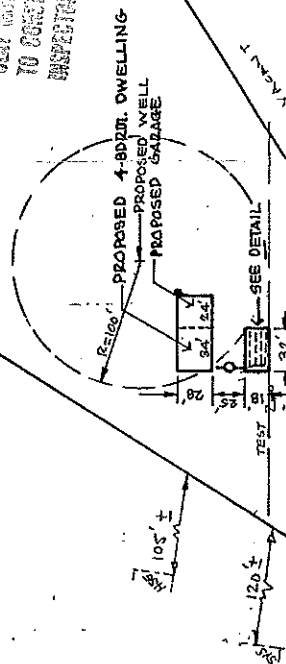

150' ——— SOUTH DENNIS ROAD
(49.5' WIDE)

YACANT

SEPTIC SYSTEM DESIGN
BLOCK 5
LOT 48.24
MIDDLE TOWNSHIP
CAPE MAY COUNTY - NEW JERSEY

M-V ENGINEERING
(M^c GUIRE VANCE ENGINEERING)
P.O. BOX 484 - 102 NORTH MAIN STREET
CAPE MAY COURT HOUSE, N.J. 08210
(609) 465 7080

SHEET 1 OF 2 PROJECT NO. 305-28
DATE 11/11/88 SCALE AS NOTED DRAWING BY: T.S.-B.
APPROVED BY: 

I HEREBY CERTIFY THAT THIS SEWAGE DISPOSAL
DESIGN WAS PREPARED BY ME OR UNDER MY CLOSE
SUPERVISION AND ACCORDING TO A PERMITS TEST MADE ON 11/11/88
BY:  T.S.-B. 11/11/88
NEW JERSEY DEPT. OF ENVIRONMENTAL AFFAIRS
DIVISION OF WATER POLLUTION CONTROL
HARRISON, N.J. 07033

APPLICANT: COURTWAY ASSOC.

Area Code (609) 465-1208

DEPARTMENT OF HEALTH
Cape May County
Cape May Court House, N.J. 08210

PERMIT

PERMISSION HAS THIS DATE BEEN GIVEN TO:

TOM REPLICI
c/o Courtway Assoc.
15 S. Main St.
C.M.C.H., NJ 08210

PERMIT No.
57596C

Date
2 | 6 | 89

~~XXX~~ to construct a sewage disposal system as described in engineering data submitted and approved by this department in accordance with the provisions of Chapter 199, P.L., 1954 N.J.S.A.

~~XXX~~ to construct a water supply system as described in engineering data submitted and approved by this department in accordance with the provisions of Chapter 199, P.L., 1954 N.J.S.A., at
STATE WELL PERMIT #35-08619

LOCATION OF FACILITY:

S. DENNIS ROAD

DESCRIPTION OF FACILITY:

FOUR (4) BEDROOM DWELLING

Lot	Block
48.24	5

BOARD OF HEALTH TOWNSHIP OF MIDDLE

By D.J. LAMARCA, M.A., R.O., P.E.C.
NOTICE: This system must be inspected by a sanitary inspector from the Cape May County Department of Health before it is covered from view.

THIS PERMIT MUST BE POSTED IN PLAIN VIEW

This permit is to be obtained in conjunction with all applicable local, regional, state and/or federal permits required.
HS 24-38 (Rev. 10/87)