

Brick

Permit Without a Jacket

Permit Number B-4550

LDS BR 10307951

Construction Permit # B-4550

Oct. 14, 1983

Owner .. Thomas Kelly

Location ... 170 Cherry Quay Rd.

Cherry Quay

Block . 338. Lot . 434-435

Contractor ... Same

Fee \$.49.88 ck. Use .. Addn.

BUILDING SUB-CODE INSPECTIONS

Footing Trench ... 10-24-83 78

Foundation ... 11-12-83 Rm

Slab

Sheathing

Framing ... 3-19-84 Rm

Insulation ... 3-22-84 Rm

Sheet Rock ... 4-6-84 Rm

Plumbing

Fire Inspection

Final

C.O. Issued

PLUMBING SUB-CODE INSPECTIONS

Slab

Rough

Septic/Sewer

Water

Final

Electrical Final

VIOLATIONS

Use reverse side for additional remarks

Approved plans must be on job or assessed penalty under 5:23:2.5 (C5)

Finals for Certificates of Occupancy must be called for or assessed penalty under 5:23-27.

1983		CONSTRUCTION PERMIT APPLICATION	
BUILDING		BRICK TOWNSHIP, NEW JERSEY	
IMPORTANT — Complete ALL items. Mark boxes where applicable			
I. LOCATION OF BUILDING	Number and street 170 CHERRY QUAY RD	Section CHERRY QUAY	Lot 234 Block 338
	N S		N S
	E W side of S12°-00'-E 40' feet E W from intersection of N78°-00' 100' (Other local geographic, political, or legal subdivision identification)		
II. TYPE AND COST OF BUILDING — All applicants complete Parts A - D			
A. TYPE OF IMPROVEMENT 1 ☐ New buildings 2 ☒ Addition (If residential, enter number of new housing units added, if any, in Part D, 13) 3 ☐ Alteration (See 2 above) 4 ☐ Repair, replacement 5 ☐ Demolition 6 ☐ Moving (relocation) 7 ☐ Garage ☐ Swim Pool ☐ in ☐ out ☐ Fence		D. PROPOSED USE — For "Wrecking" most recent use Residential 12 ☒ One family 13 ☐ Two or more family — Enter number of units 14 ☐ Transient hotel, motel, or dormitory — Enter number of units 15 ☐ Garage 16 ☐ Carport 17 ☐ Other — Specify addn. B. Rm. Nonresidential 18 ☐ Amusement, recreational 19 ☐ Church, other religious 20 ☐ Industrial 21 ☐ Parking garage 22 ☐ Service station, repair garage 23 ☐ Hospital, institutional 24 ☐ Office, bank, professional 25 ☐ Public utility 26 ☐ School, library, other educational 27 ☐ Stores, mercantile 28 ☐ Tanks, towers 29 ☐ Other - Specify	
B. OWNERSHIP 8 ☒ Private (individual, corporation, nonprofit institution, etc.) 9 ☐ Public (Federal, State, or local government)			
C. COST 10. Cost of improvement To be installed but not included in the above cost a. Electrical (# Fixtures, Outlets) b. Plumbing (# of Fixtures) c. Heating, air conditioning d. Other (elevator, etc.) 11. TOTAL COST OF IMPROVEMENT \$		(Omit cents) @5,000.	Nonresidential — Describe in detail proposed use of buildings, e.g., food processing plant, machine shop, laundry building at hospital, elementary school, secondary school, college, parochial school, parking garage for department store, rental office building, office building at industrial plant. If use of existing building is being changed, enter proposed use. _____ _____ _____
III. SELECTED CHARACTERISTICS OF BUILDING — For new buildings and additions, complete Parts E - I; for wrecking, complete only Part H, for all others skip to IV.			
E. PRINCIPAL TYPE OF FRAME ☐ Masonry (wall bearing) ☒ Wood frame ☐ Structural steel ☐ Reinforced concrete ☐ Other - Specify	H. DIMENSIONS Number of stories 1 Total square feet of floor area, all floors, based on exterior dimensions 612 Total land area, sq. ft. 4000	FEE COMPUTATIONS VOLUME OF BUILDING 3600 BUILDING SUB CODE 25.20 ELECTRICAL CODE - PLUMBING CODE - PLAN REVIEW 20.00 CERTIFICATE OF OCCUPANCY 2.16 STATE TRAINING FUND CONSTRUCTION PERMIT FEE 49.88	3600 25.20 - - 20.00 2.16 49.88
F. TYPE OF HEATING SYSTEM Specify ELECTRIC Air Cond. Yes ☐ No ☒	I. RESIDENTIAL BUILDING ONLY Number of bedrooms 3 Number of bathrooms { Full 1 Partial		
G. TYPE OF SEWERAGE DISPOSAL ☒ Public ☐ Individual			

SEE REVERSE

B4550

Check

SUB CONTRACTORS				
NAME	TRADE	ADDRESS	ZIP CODE	PHONE #
1.				
2.				
3.				
4.				
5.				
6.				
7.				
8.				

PERSON TO BE IN CHARGE OF CONSTRUCTION

NAME THOMAS Kelly (Homeowner)
 ADDRESS 68 TILLER LANE BRICKTOWN

IV. IDENTIFICATION — To be completed by all applicants

Name	Mailing address — Number, street, city, and State	ZIP code	Tel. No.
1. <u>Owner Agent</u> <u>THOMAS Kelly</u>	<u>68 TILLER LANE BRICKTOWN NJ</u>		<u>477-9115</u>
2. <u>Contractor</u> <u>Dame</u>			
3. <u>Architects</u>			

The owner of this building and the undersigned agree to conform to all applicable laws of Township of Brick and that all required state, county and local prior approvals have been given.

Signature of applicant <u>Thomas W. Kelly</u>	Address <u>68 Tiller Ln BRICK</u>	Application date
--	--------------------------------------	------------------

DO NOT WRITE IN THIS SPACE — FOR OFFICE USE ONLY

Approved by <u>Fred Jerolimon</u>	Date permit issued <u>10/14/83</u>	Permit Number <u>B4550</u>
--------------------------------------	---------------------------------------	-------------------------------

I agree to construct said building in conformity with the plans and specifications filed with the Construction Official and in compliance with the provisions of the Building Code whether shown on plans or not.

BRICK TOWNSHIP APPLICANT'S DECLARATION

I Julia Kelly for the purpose of inducing the Inspector to accept the plans and specifications submitted by me and to issue a building permit, declare as follows:

I am the applicant named in, and who signed, the annexed application for a building permit to be issued by the Building Inspector of the Township of Brick in the County of Ocean, State of New Jersey, for the (construction) (alteration) of a building in said township.

As permitted by the statute the plans and specifications which accompany said application were prepared by me, as I am myself acting as the designer of said (building) (alteration) which is to be constructed by me for my own occupancy.

The above words, "to be constructed by me" as used in this declaration do not mean that I intend personally to do the work of (construction) (altering) said building, but means that I am the person undertaking the work as owner and principal; and as above stated, said (building) (alteration) is to be constructed for my own occupancy.

Sworn and subscribed to
before me this 11th day
of Oct. 1983

Julia Kelly
APPLICANT


BUILDING INSPECTOR

Date _____

Mary R. Smith
Notary Public of New Jersey

NOTARY PUBLIC OF NEW JERSEY

My Commission Expires July 30, 1986

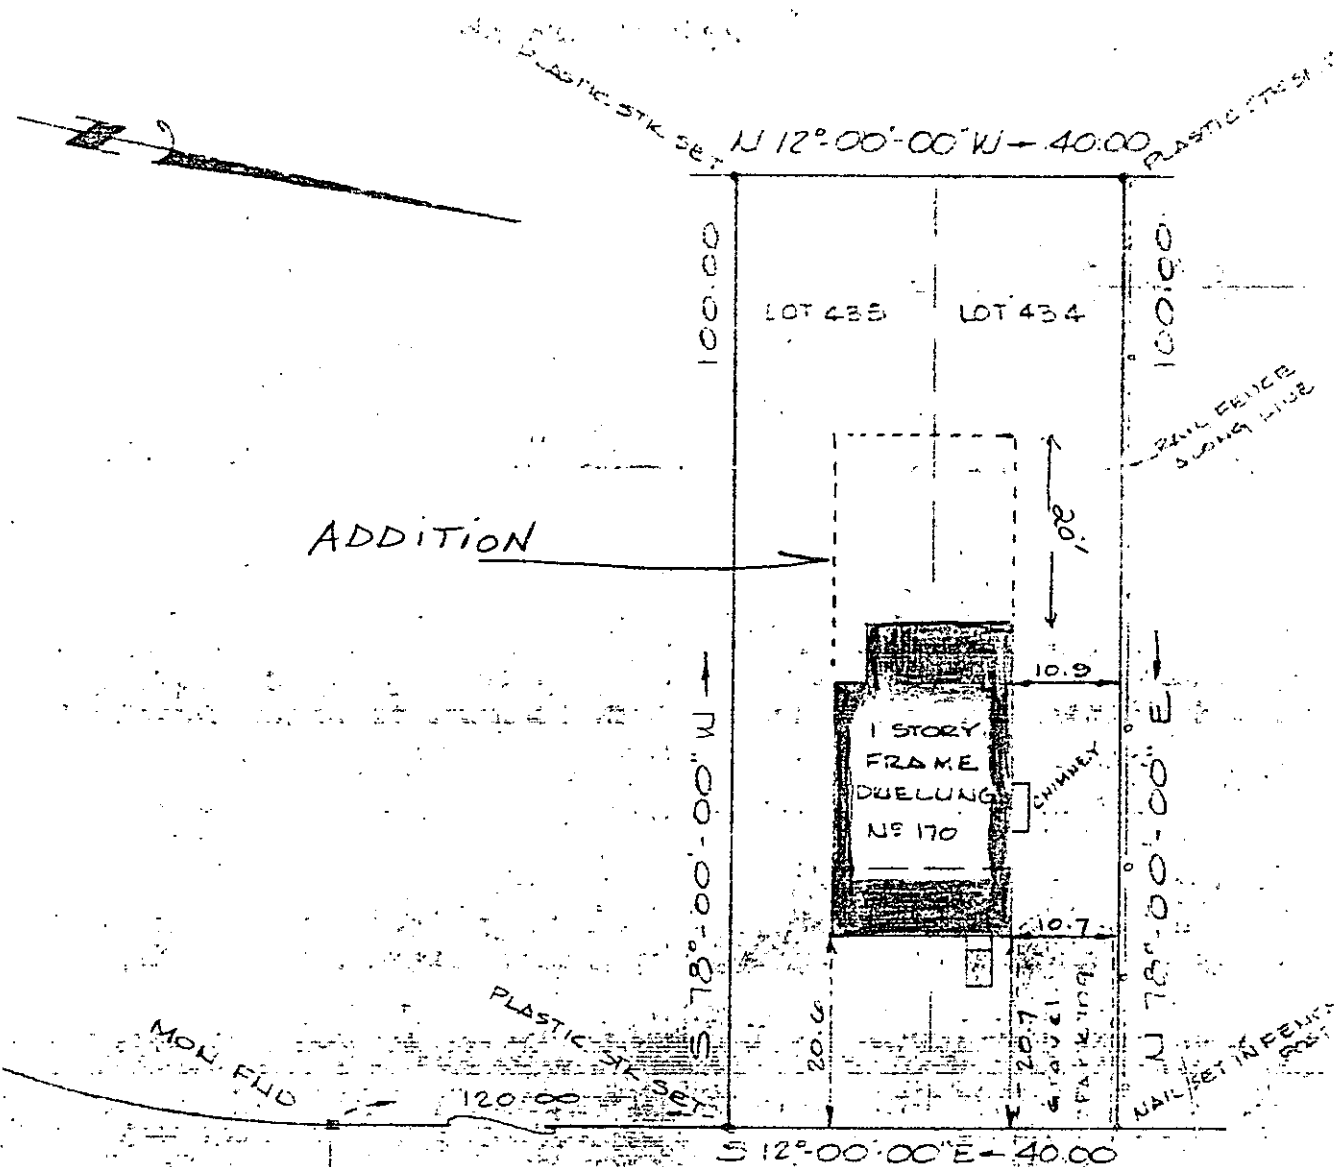

CHERRY QUAY RD
(50' R/W)
(FORMERLY MAINSAIL RD)

JIB
LANE

THIS SURVEY IS CERTIFIED TO:
THOMAS W. KELLY AND JULIA A.
KELLY, NEW JERSEY REALTY
TITLE INSURANCE CO, ISSADOR
BERLIN (ATTORNEY) AND TO
ALL OTHER CURRENT PARTIES
IN INTEREST.

Robert E. Scott

ROBERT E. SCOTT L.S. 13460
189 HWY 37 WEST
TOMS RIVER, NEW JERSEY

SCALE

1" = 20'

DATE

11/14/72

DRAWN

RES

JOB NO

72-592

SURVEY MAP

(TAX MAP)

LOTS 434 & 435


BLOCK ~~383~~ 338

BRICK TOWNSHIP

OCEAN COUNTY

NEW JERSEY

ADDITION

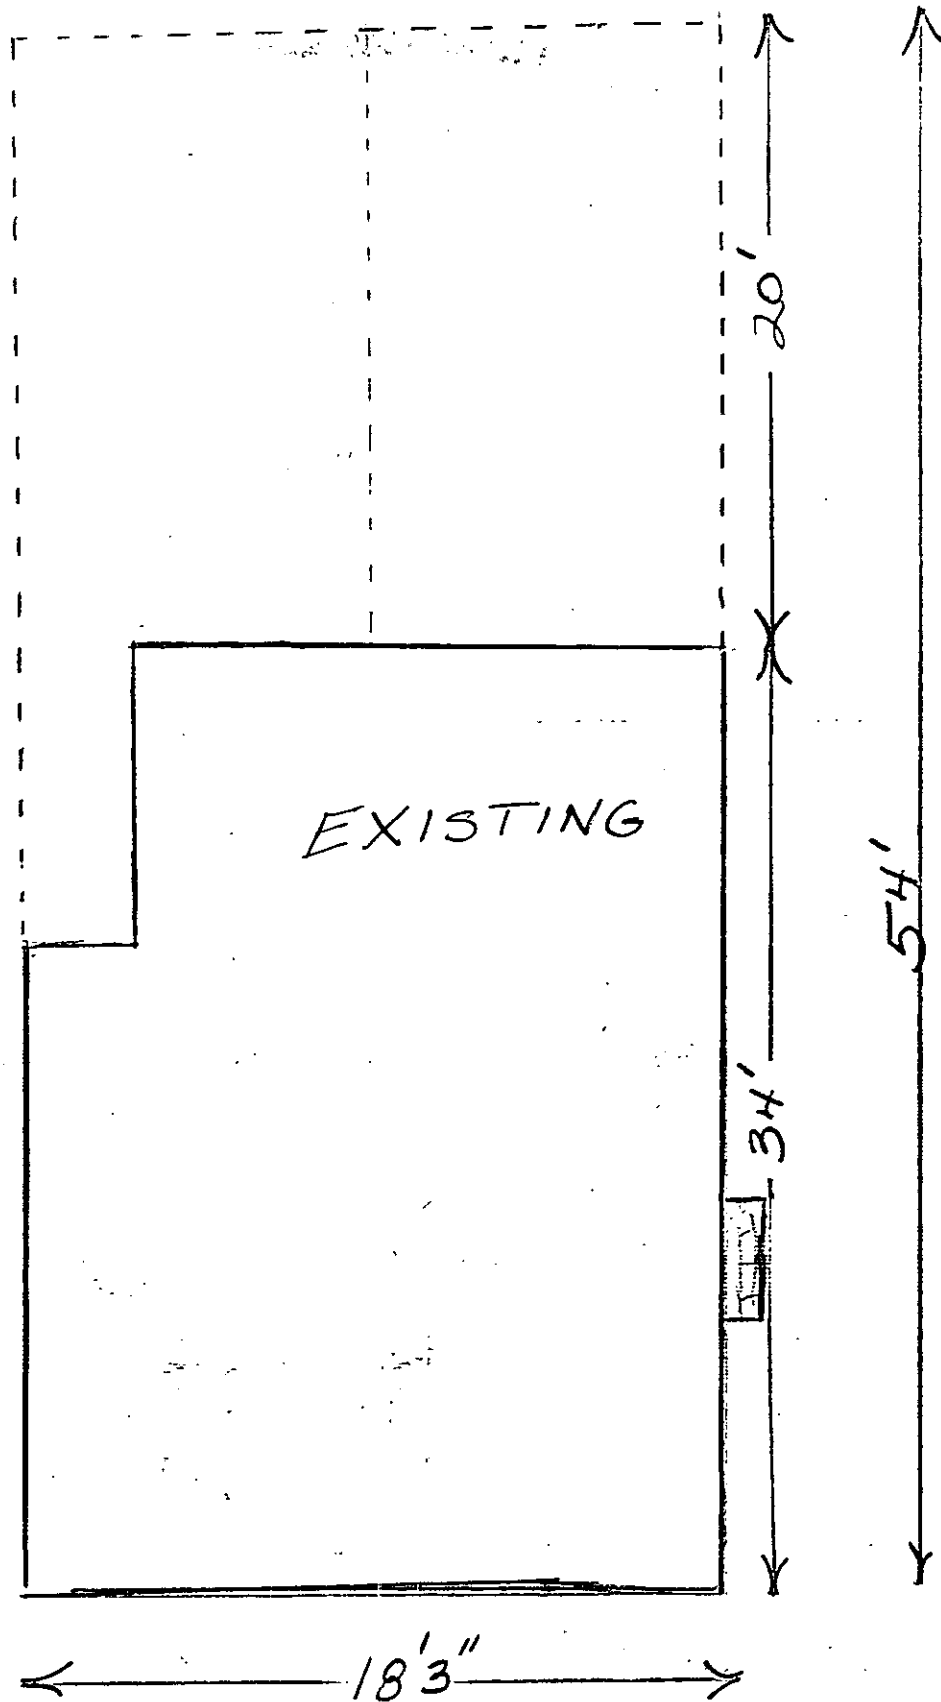

BRICK TOWNSHIP

Plan Review Class Date By

Zoning _____

Plumbing _____

Building 10-13-83 Jf

Fire _____

Energy _____

Electrical _____

34550

BRICK TOWNSHIP

Plan Review

Class

Date

By

Zoning

Plumbing

Building


Fire

Energy

Electrical

10-13-83 JH

64550

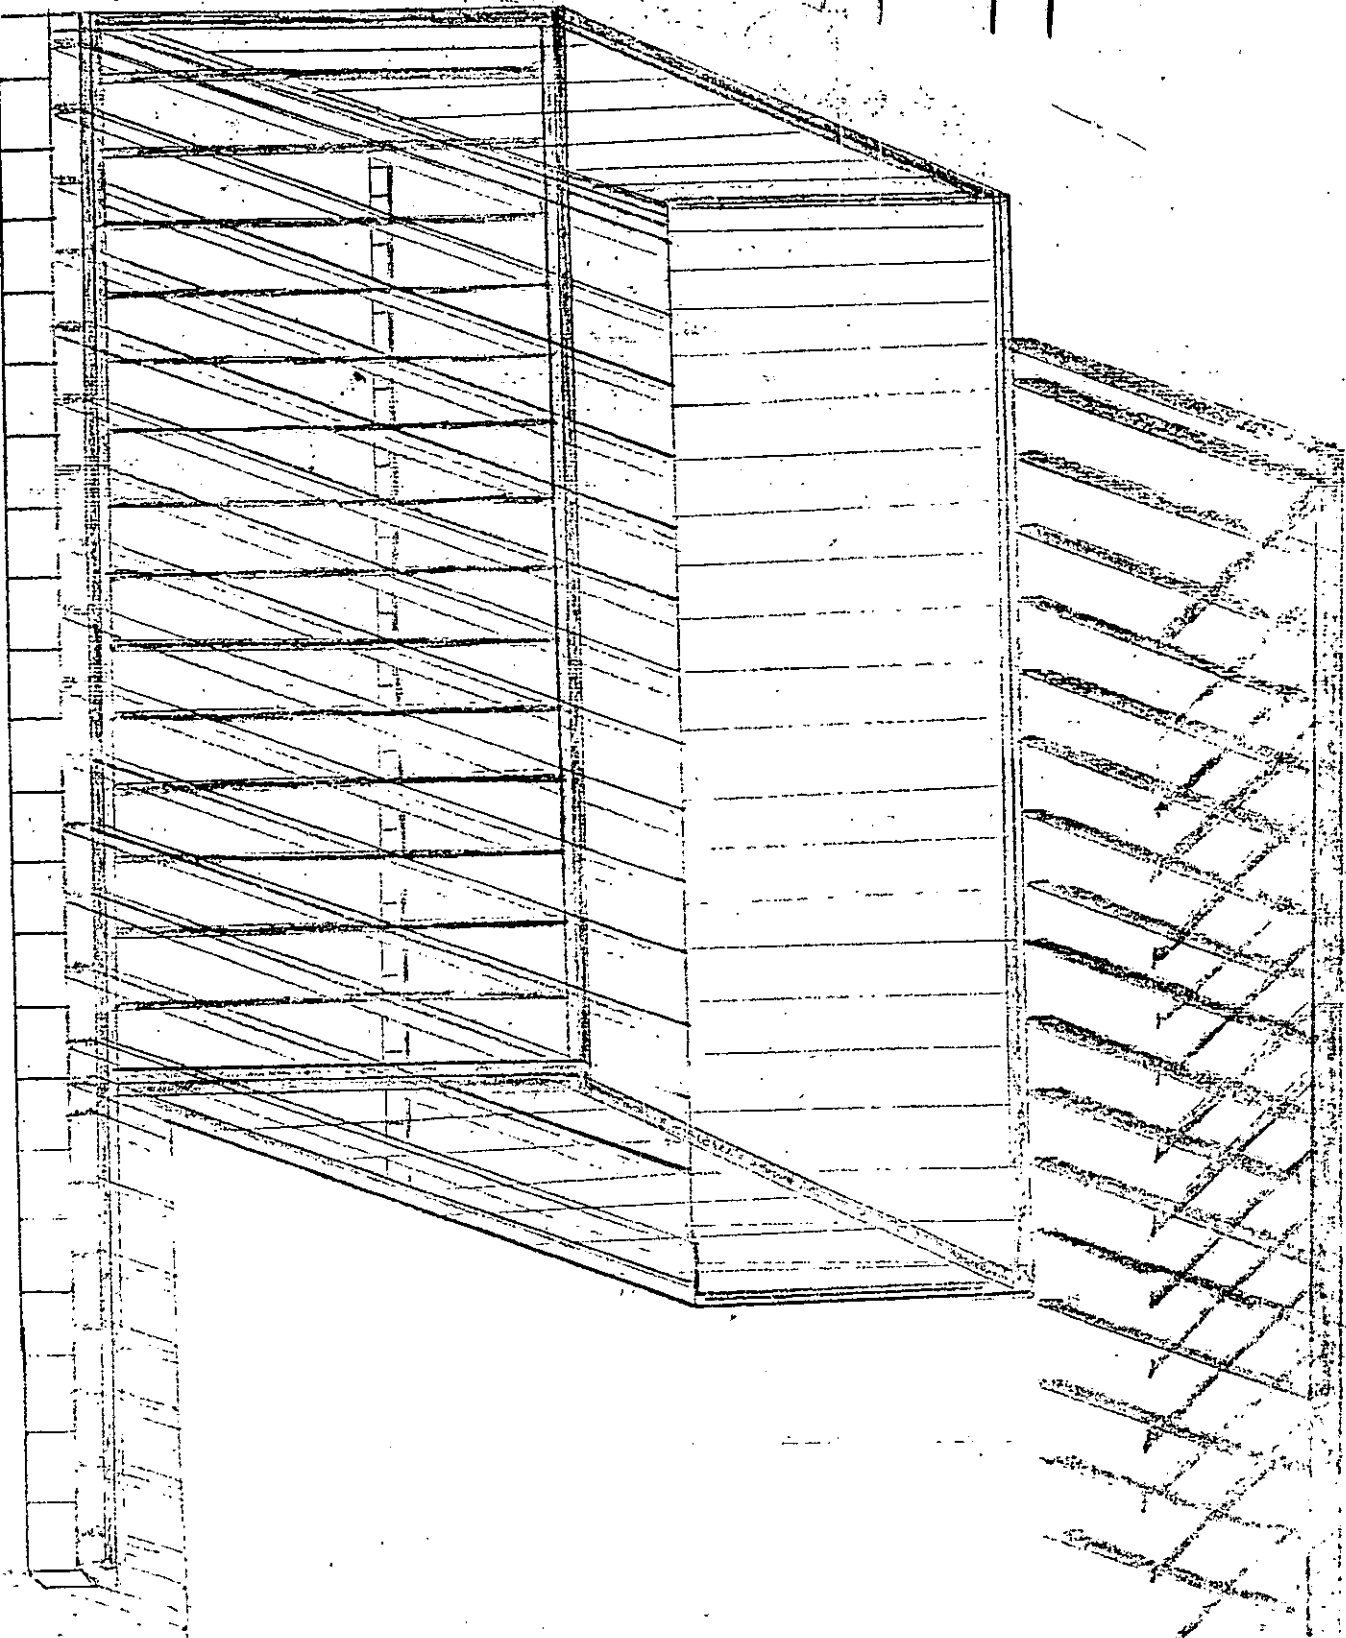

3' FOOTING

2x8

2x6

BRICK TOWNSHIP

Plan Review Class Date By

Zoning

Plumbing

Building

Fire

Energy

Electrical

10-13-23 JA

3459


STUDS 2x4

JOISTS 2x8

SILL 2x6

ANCHORS 4' APART

3' FOOTING

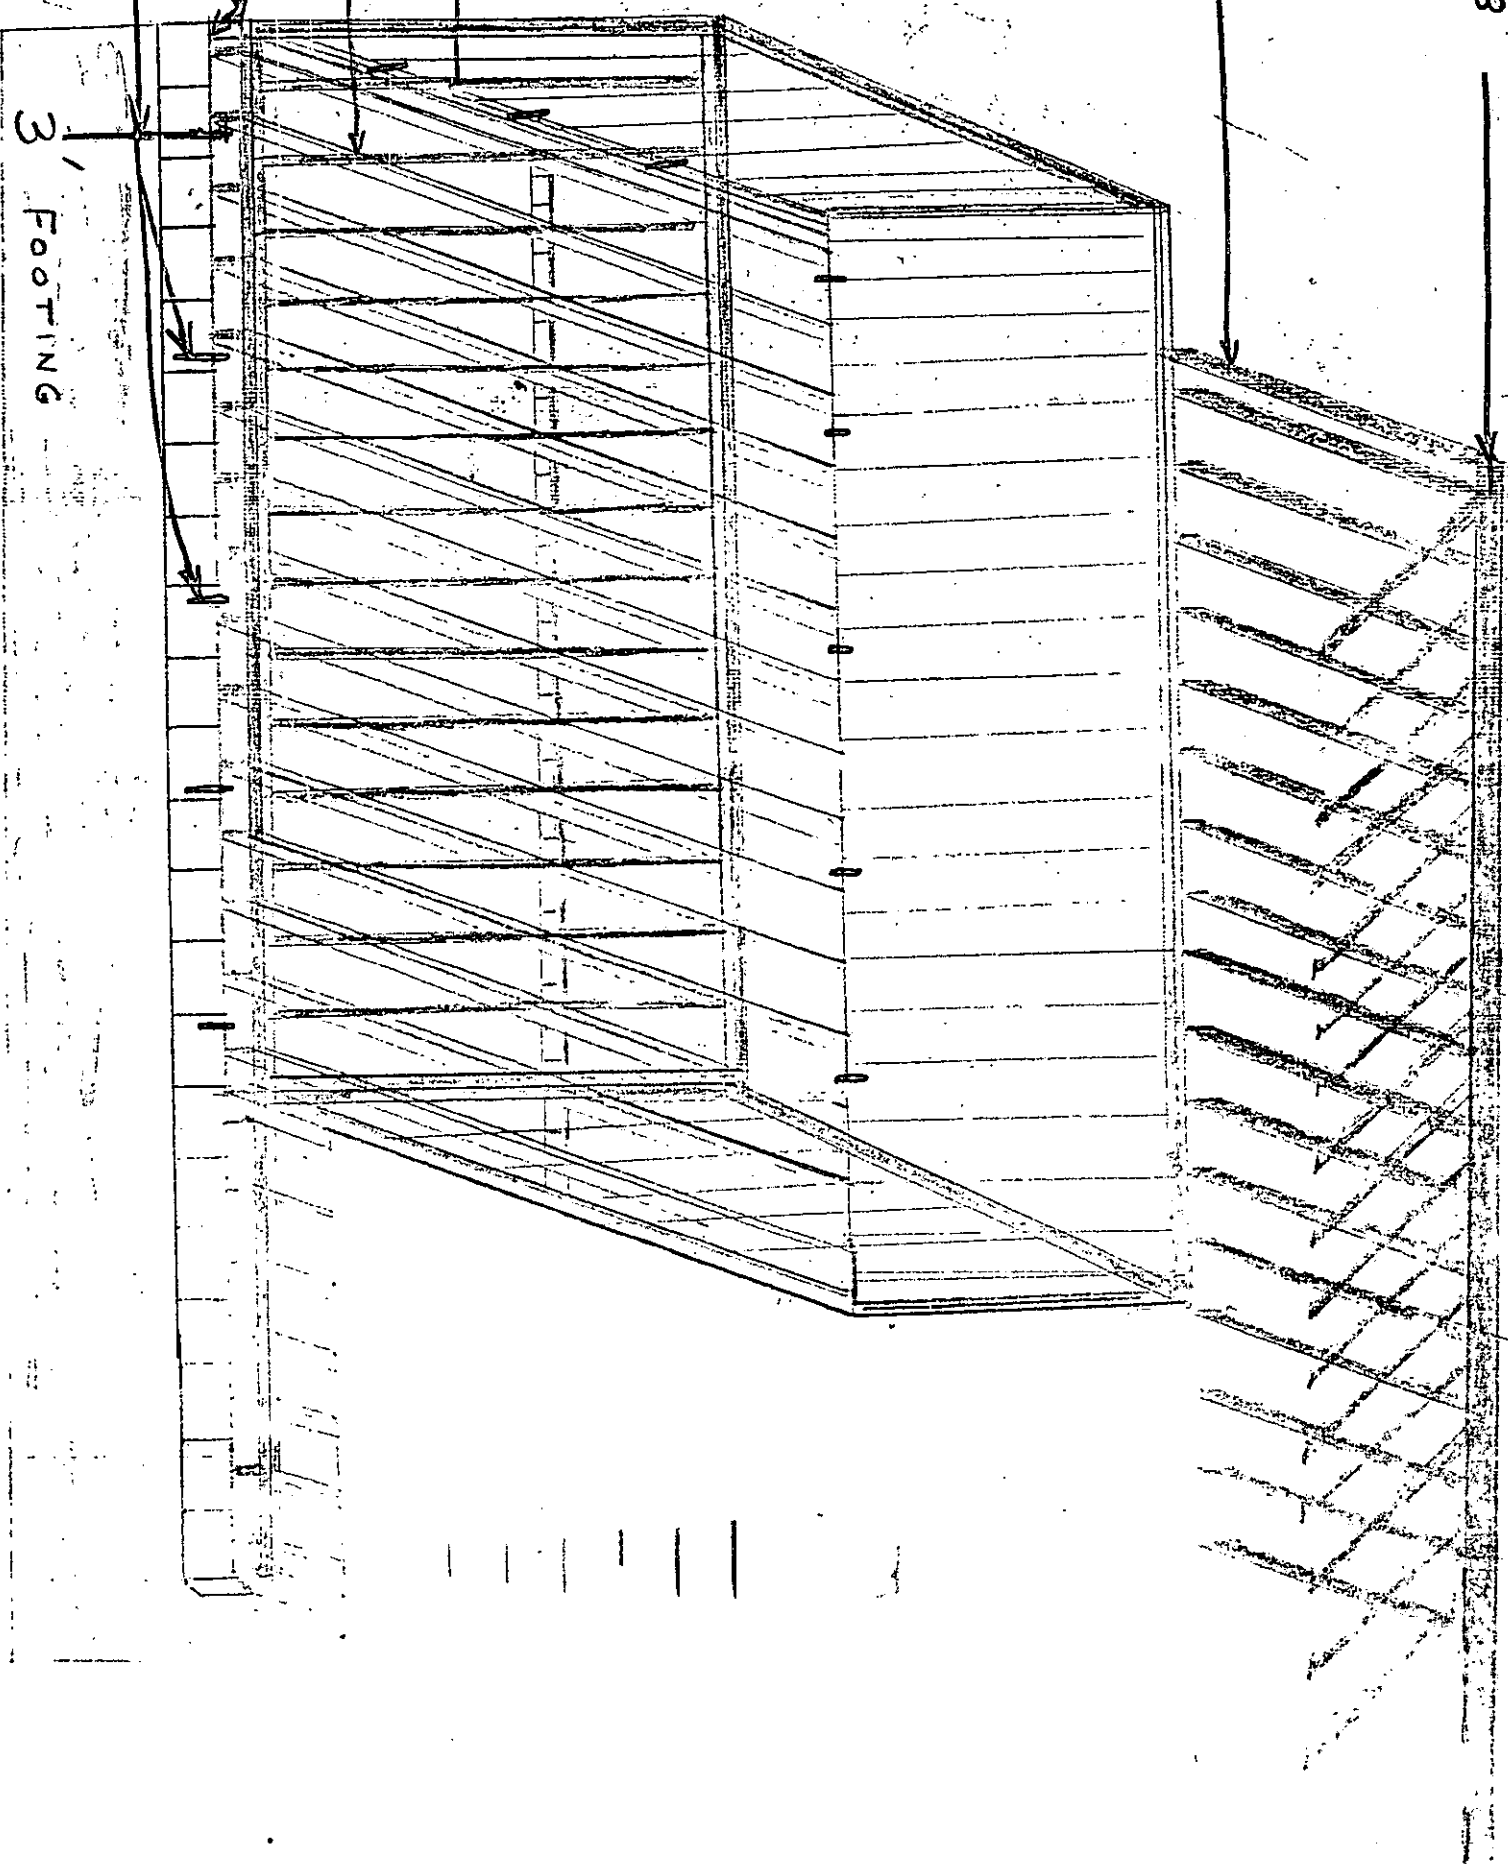

BRICK TOWNSHIP

Plan Review Class Date By

Zoning

Plumbing

Building 16-13-83 JH

Fire

Energy

Electrical

94550

