


TAX MAP: BLOCK 16


LOT 12.04

30,144.56 FT.


2.069 Ac.

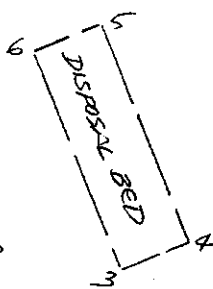

° Clear-Air
2

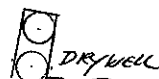

① SEPTIC TANK

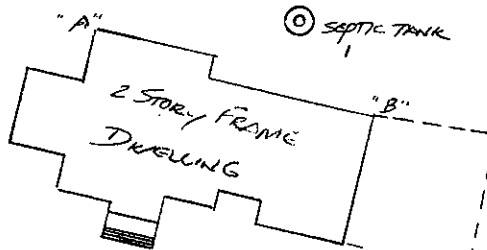

° WELL

R=535.00'
L=191.95'
HIGHLAND DRIVE 50' R/W

40.53'

CONSERVATION EASEMENT

452.67'

LOT 12.05

LOT 12.03

TIES TO COMPONENTS

HOUSE CORNER A-1 = 52.5'

A-2 = 95.2'

A-3 = 139.4'

A-4 = 153.9'

A-5 = 189.3'

A-6 = 176.1'

HOUSE CORNER B-1 = 32.3'

B-2 = 82.8'

B-3 = 134.7'

B-4 = 143.7'

B-5 = 196.7'

B-6 = 189.6'

AS-BUILT
SEWAGE DISPOSAL SYSTEM

TAX MAP LOT 12.04 in BLOCK 16
CHESTER TOWNSHIP MORRIS COUNTY
NEW JERSEY

HARRY F. METZLER

Land Surveyor • N.J. Lic. No. 16981
Professional Planner • N.J. Lic. No. 1876

ASSOCIATED
CONSULTANTS

ENGINEERS AND LAND SURVEYORS INC.
PROFESSIONAL PLANNERS

530 EAST MAIN STREET
P.O. BOX 383
CHESTER, N.J. 07930
Tel: (908) 879-6400

SCALE: 1" = 50'

DATE: MAY 10, 2002

DESIGNED BY:

DRAWN BY: JIB

BOOK: 212-C

FILE: 2928