


I CERTIFY THIS SURVEY TO NORTH BRUNSWICK MANOR, A PARTNERSHIP,
CITY FEDERAL SAVINGS AND LOAN ASSOCIATION AND AMERICAN TITLE
INSURANCE COMPANY.

MICHAEL T. CARR, NEW JERSEY P.E. & L.S. LICENSE NO. 27831

Bldg - 47 - Permit #
12 units 14,829 - 41

As Built approved 3/31/89
Joe G. Submittal
Code Enforcement officer

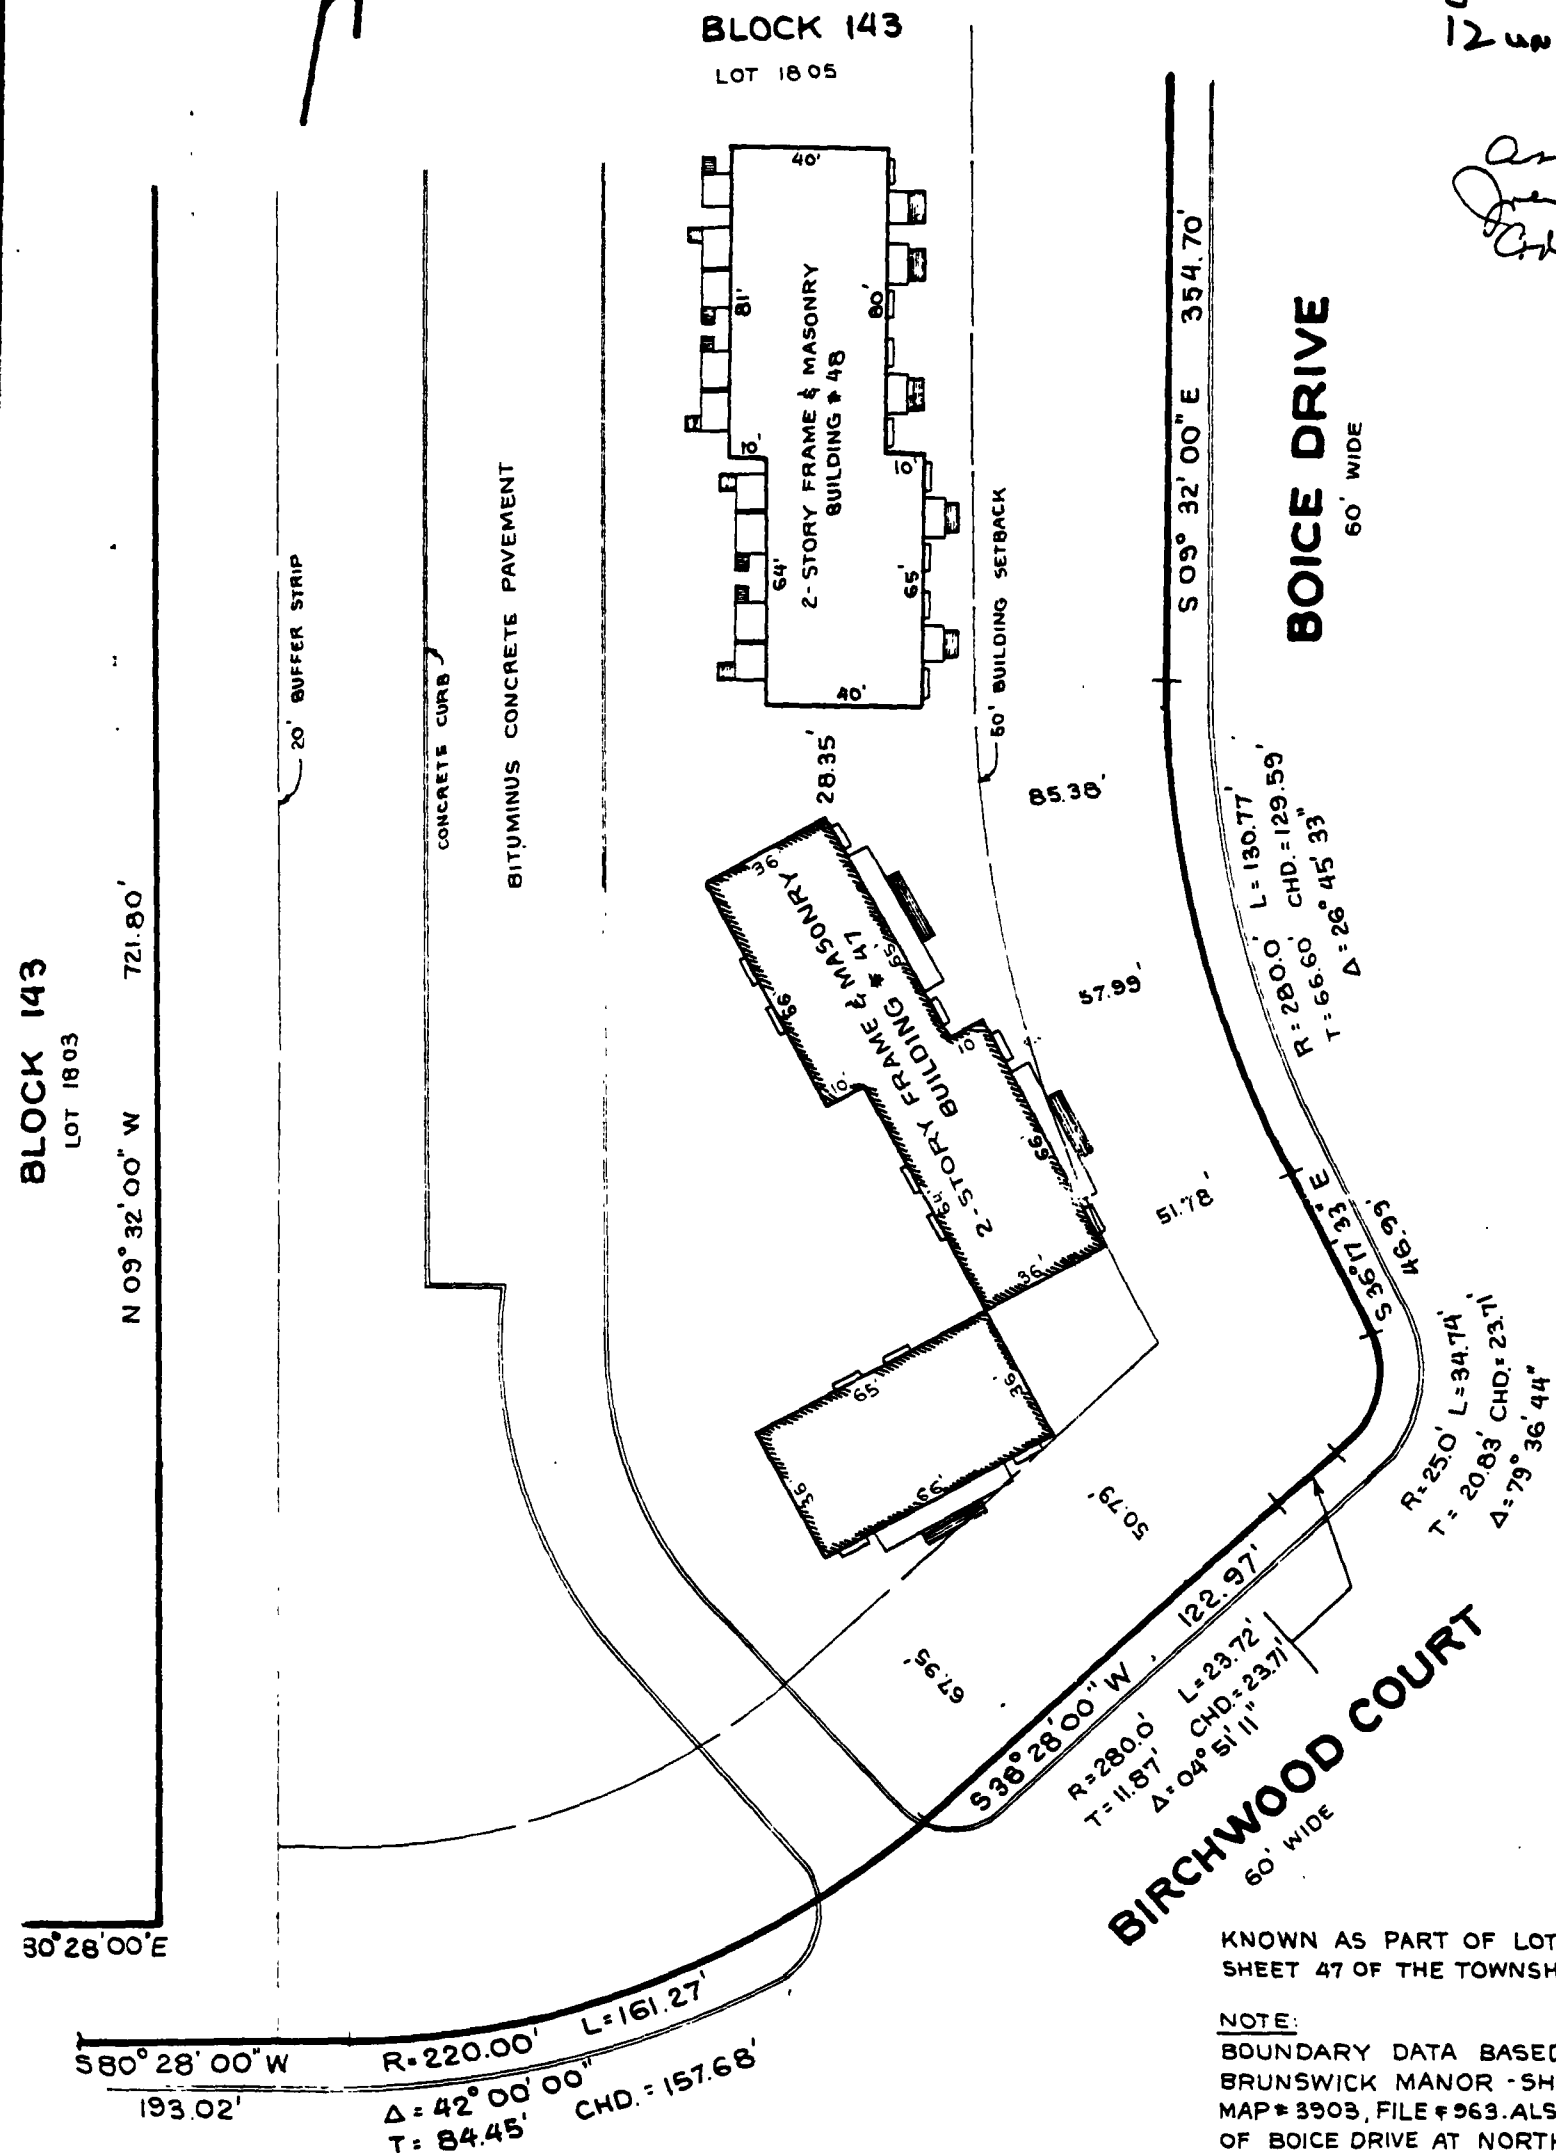

PERMIT: 14842
LDS NB 10601811

KNOWN AS PART OF LOT 18.05 IN BLOCK 143 AS SHOWN ON
SHEET 47 OF THE TOWNSHIP OF NORTH BRUNSWICK TAX MAP.

NOTE:
BOUNDARY DATA BASED UPON "FINAL MAP OF NORTH
BRUNSWICK MANOR - SHEET 1 OF 2," FILED: DECEMBER 18, 1976,
MAP # 3903, FILE # 963. ALSO "FINAL MAP SHOWING REALIGNMENT
OF BOICE DRIVE AT NORTH BRUNSWICK MANOR FILED:
OCTOBER 18, 1979, MAP # 4248, FILE # 966.

REVISIONS



CARR ENGINEERING ASSOCIATES, P.A.

CIVIL ENGINEERS - SURVEYORS - PLANNERS
P.O. BOX 679
PERTH AMBOY, NEW JERSEY 08862-0679

MICHAEL T. CARR, NEW JERSEY P.E. & L.S. LIC. NO. 27831

AS BUILT AND LOCATION SURVEY FOR BUILDING #47 PREPARED FOR:

NORTH BRUNSWICK MANOR, A PARTNERSHIP

SITUATED IN:

NORTH BRUNSWICK TOWNSHIP

MIDDLESEX COUNTY, NEW JERSEY