

5-16-76



I. IDENTIFICATION

V. FEE SUMMARY (for office use only)

		Update	Update
1. Building	\$ 30 -		
2. Electrical			
3. Plumbing			
4. Fire Protection			
5. Elevator Devices			
6. Subtotal	\$ 30 -		
7. Less 20% for State Plan Review			
8. Subtotal	\$		
9. DCA Training Fee			
10. Subtotal	\$		
11. Cert. of Occupancy			
12. Other <i>2PA</i>	\$ 15		
13. TOTAL	\$ 45.00		

VI. BUILDING/SITE CHARACTERISTICS		(office use only)
1. Number of Stories _____		
2. Height of Structure _____	ft.	
3. Area—Largest Floor _____	sq. ft.	
4. New Building Area _____	sq. ft.	
5. Volume of New Structure _____	cu. ft.	
6. Construction Classification _____		
7. Total Land Area Disturbed _____	sq. ft.	
8. Flood Hazard Zone _____		
9. Base Flood Elevation _____	ft.	
10. Wetlands yes _____	sq. ft.	
no _____		
11. Max. Live Load _____		
12. Max. Occupancy Load _____		

Deck.

[illegible]

IV. DOES OR WILL YOUR BUILDING CONTAIN ANY OF THE FOLLOWING?

- | | | |
|---|--|---|
| 1. ☐ Elevators/Escalators/Lifts/
Dumbwaiters/Moving Walks | 4. ☐ Refrigeration Systems | 7. ☐ Sprinklers |
| 2. ☐ High Pressure Boilers | 5. ☐ Cross-Connections/Backflow
Preventers | 8. ☐ Smoke Control Systems in Open Wells |
| 3. ☐ Pressure Vessels | 6. ☐ Hazardous Uses/Places of Assembly | 9. ☐ Underground Storage Tanks |

VII. DESCRIPTION OF BUILDING USE

A. RESIDENTIAL *Condo*

- ☐ Hotels (R-1)
- ☐ Multi-Family (R-2)
- ☐ Two-Family (R-3) BOCA
- ☐ Two-Family (R-4) CABO
- ☐ One-Family (R-3) BOCA
- ☐ One-Family (R-4) CABO

No of dwelling units:

Before Construction _____

After Construction _____

Net gain or loss _____

B. NON-RESIDENTIAL
1. State Specific Use:

2. Use Group:

3. Change in Use Group, Indicate Former:

LDS BR 10317538

CERTIFICATION IN LIEU OF OATH

I. OWNER SECTION (to be completed if the applicant is the owner in fee)

I hereby certify that I am the owner in fee of the property listed on Page 1.

Mark the following applicable boxes:

A. ☐ I further certify that a new home (private residence) will be constructed on this property for my own use and occupancy. This dwelling is to be occupied by myself and is not to be used for any purpose other than single family residential use. I attest that all construction, plumbing, or electrical work will be done, in whole or in part, by me or by subcontractors under my supervision, in accordance with all applicable laws; and, I further acknowledge that said new home is not covered under the New Home Warranty and Builders Registration Act (N.J.S.A. 46:3B-1 et seq.) and that such fact shall be disclosed to any person purchasing this property within ten years of the date of issuance of a certificate of occupancy.

I UNDERSTAND THAT IN MARKING BOX A, I ACKNOWLEDGE THAT I AM ASSUMING RESPONSIBILITY FOR THE WORK DONE ON SAID PROPERTY, THE CONDITION OF THE PROPERTY PRIOR TO, DURING, AND AFTER ANY WORK PERFORMED, AND FOR THE PERFORMANCE OF THE SUBCONTRACTORS I HIRE, EMPLOY, OR OTHERWISE CONTRACT OR WITH WHOM I MAKE AGREEMENTS TO PERFORM WORK. I AM VOLUNTARILY AND KNOWINGLY ASSUMING THIS RESPONSIBILITY.

B. ☐ I further certify the following as required by the New Jersey Uniform Construction Code, N.J.A.C. 5:23-2.15(e)1.vii:

I personally prepared the plans submitted for: 1) the new home referred to in A.; or, 2) an addition, alteration, renovation, or repair to an existing single family residence owned and occupied by myself and located on the property listed on Page 1; or, 3) a new structure that will be physically separate from, but that will be deemed part of, an existing single family residence that is owned and occupied by myself and located on the property listed on Page 1.

C. ☐ I further certify that I will perform or supervise the following work:

C.1. ☐ Building C.2. ☐ Fire Protection

I further certify that I will perform the following work:

C.3. ☐ Electrical C.4. ☐ Plumbing

D. ☐ I agree to advise all contractors on this project that they are required to be registered with the New Jersey Division of Taxation and to comply with all New Jersey tax laws.

I further certify the following as required by the Uniform Construction Code, N.J.A.C. 5:23-2.15(a)5: All required State, county, and local prior approvals have been given, including such certification as the construction official may require.

I understand that if any of the above statements are willfully false, I am subject to punishment.

X Signature *Kinda Jordanell* Date 6/7/96

II. AGENT SECTION

(to be completed if the applicant is not the owner in fee)

I hereby certify the following as required by the New Jersey Uniform Construction Code, N.J.A.C. 5:32-2.15(d): the proposed work is authorized by the owner in fee; and I have been authorized by the owner in fee to make this application as his agent.

I further certify the following as required by the Uniform Construction Code, N.J.A.C. 5:23-2.15(a)5: All required State, county, and local prior approvals have been given, including such certification as the construction official may require.

I agree to advise all contractors on this project that they are required to be registered with the New Jersey Division of Taxation and to comply with all New Jersey tax laws.

I understand that if any of the above statements are willfully false, I am subject to punishment.

☐ Check if contractor.

Agent Name _____

Address _____

Telephone (_____) _____

Signature _____ Date _____

OFFICE DATE RECEIVED: _____

VIII. PRIOR APPROVALS CHECKLIST (office use only)	LOCAL APPROVAL		COUNTY APPROVAL		REGIONAL APPROVAL		STATE APPROVAL		COMMENTS
	Prelimin. Initial	Final Date	Prelimin. Initial	Final Date	Prelimin. Initial	Final Date	Prelimin. Initial	Final Date	
☐ Zoning Officer									IMPORTANT A.H.B.T. - EXEMPT
☐ Planning Board									
☐ Zoning Board									
☐ Sewer Authority									
☐ Water Authority									
☐ Fire Department									
☐ Police Department									
☐ Health Department									
☐ Soil Conservation									
☐ N.J. Dept. of Community Affairs									
☐ N.J. Department of Transportation									
☐ N.J. Dept. of Environmental Protection									
☐ Utility Dig No.									
☐									
☐									

IX. SUBCODES AND SPECIAL REGULATIONS APPLICABLE (office use only—optional)

Name of Code & Edition

Name of Code & Edition

Other

Building _____
Electrical _____
Plumbing _____
Fire Protection _____
Mechanical _____

Energy _____
Barrier Free _____
Flood Hazard _____
As Built Elevation Cert. _____
Other _____

X. CERTIFICATES ISSUED (office use only)

(office use only)

DATE ISSUED

DATE EXPIRED

DATE REISSUED

DATE EXPIRED

- ☐ Temporary Certificate of Occupancy
☐ Temporary Certificate of Compliance
☐ Continued Certificate of Occupancy
☐ Certificate of Compliance
☐ Certificate of Occupancy
☐ Certificate of Approval

No. _____
No. _____
NOTE: If construction does not commence within one (1) year of date of issuance, or if construction ceases for a period of six (6) months, this permit is void.

Estimated Cost of Work \$ 500.00

U.C.C. Form F-170C

CONSTRUCTION OFFICIAL

1 WHITE - OFFICE

2 CANARY - TAX ASSESSOR

3 PINK - JACKET

4 GOLD - APPLICANT

Other 06/07/96 ND 5 00716005
DCA Training Fee _____
Cert. of Occ. _____
Other 214-15-
Total 15-
Check No. #
Cash ✓
Collected By: W

15:58

ORIGINAL
ILLEGIBLE



CONSTRUCTION
PERMIT

Date Issued

Control #

Permit #

6/7/96

1293-96

IDENTIFICATION Block

K129.02

Lot

200127

Work Site Location

1270 Cammell Rd

Contractor

Bob Bauli

Address

Owner in Fee

Loft O'Hanlon

Address

Scenic

Tele. ()

Lic. No. or Bldrs. Reg. No.

Exp. Date

1273019

Federal Emp. No.

1427102

or Social Security No.

LOT

is hereby granted permission to perform the following work:

☒ BUILDING ☐ PLUMBING ☐ OTHER

☐ ELECTRICAL ☐ FIRE PROTECTION

☐ ELEVATOR DEVICES

DESCRIPTION OF WORK:

Deck

NOTE: If construction does not commence within one (1) year of date of issuance, or if construction ceases for a period of six (6) months, this permit is void.

Estimated Cost of Work \$

500.00

CONSTRUCTION OFFICIAL

U.C.C. Form F-170C

1 - WHITE - OFFICE

2 - CANARY - TAX ASSESSOR

3 - PINK - JACKET

4 - GOLD - APPLICANT

PAYMENTS (Office Use Only) 2 #

Building 30.00

Plumbing 15.00

Electrical 45.00

Fire Protection 45.00

Other 0.00

Other 06/07/96 NO 5 00714005 15.58

DCA Training Fee

Cert. of Occ.

Other 274-15-

Total 75.58

Check No. #

Cash

Collected By: J



**BUILDING
SUBCODE
TECHNICAL SECTION**



Date Received
Date Issued
Control #
Permit #

6/17/96
1298-96

A. IDENTIFICATION--APPLICANT: COMPLETE ALL APPLICABLE INFORMATION. WHEN CHANGING CONTRACTORS, NOTIFY THIS OFFICE. CALL UTILITY DIG NO: 1-800-272-1000.

Block 1429-C Lot 127
Work Site Location Brick, NJ 08724
Owner in Fee Linda & Scott O'Donnell
Address 127 Camille Ct
Brick, NJ 08724
Tel. [REDACTED]
Contractor Bob Buylis
Address 824 Seaglen Ave., Beachwood, NJ 08722
Tel. (908) 286-5097
Lic. No. or Bids. Reg. I [REDACTED]
Federal Emp. No. [REDACTED] Social Security [REDACTED]

C. CERTIFICATION IN LIEU OF OATH

I hereby certify that I am the (agent of) owner of record and am authorized to make this application.

Signature Linda O'Donnell

D. TECHNICAL SITE DATA

DESCRIPTION OF WORK

14x14 Deck

JOB SUMMARY (Office Use Only)

PLAN REVIEW	Date	Initial	INSPECTIONS	Dates (Month/Day)
☐ No Plans Req.				
☒ All	6/17/96	SC	Type: Footing	Approval: Initial
☐ Footing			Foundation	
☐ Foundation			Slab	
☐ Frame			Frame	
☐ Other			Insulation	
Joint Plan Review Required:			Finishes:	
☐ Elec. ☐ Plumb. ☐ Fire			Energy	
SUBCODE APPROVAL			Mechanical	
☐ CO ☐ CCO ☐ CA			TCO	
Date:			Other	
Approved By:			Final	1/15/97 JTK

B. BUILDING CHARACTERISTICS

Use Group Present _____ Proposed _____
Constr. Class Present _____ Proposed _____
No. of Stories _____
Height of Structure _____ Ft.
Area--Largest Floor _____ Sq. Ft.
New Bldg. Area/All Floors _____ Sq. Ft.
Volume of New Structure _____ Cu. Ft.
Total Land Area Disturbed _____ Sq. Ft.

Est. Cost of Bldg. Work:

1. New Bldg. \$ _____
2. Alteration \$ _____
3. Total (1+2) \$ 500-

(Office Use Only)
FEE

TYPE OF WORK:	
☐ New Building	
☐ Addition	
☐ Alteration	
☐ Roofing	
☐ Siding	
☐ Fence _____ Height (6' or over)	
☐ Sign _____ Sq. Ft.	
☐ Pool	
☐ Asbestos Abatement	
☐ Other _____	
☐ Demolition	
<u>Construct New Deck</u>	

Paid ☐ Check # _____
Collected by: _____
DCA TRAINING FEE \$ _____
TOTAL FEE \$ _____

Administrative Surcharge \$ _____

Minimum Fee \$ _____

TOWNSHIP OF BRICK

ZONING PERMIT

Date of Issue: May 28, 1996 1996 Z 0633

Block 1429.02 Lot 2-C0127 Zone R-M

Property Address: 127 Camille Court

Owner: Scott O'Donnell (Phone) [REDACTED]

Applicant: Same (Phone): Same

Use: Residential condominium unit.


Proposed Construction (if any): 14' by 14' deck.

Conditions: As approved by Evergreen Woods Park Association.

Letter dated May 3, 1996.

Please note that Building Permits, as well as Zoning Permits, must be obtained prior to any construction.

This permit shall be null, void and of no effect if any of the facts contained in the application upon the basis of which this permit was granted are false or untrue in any material respect. This permit shall expire one (1) year after the date of issuance if the use or substantial construction has not been commenced.

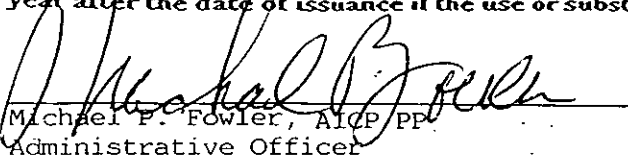
Michael P. Fowler, AICP, PP
Administrative Officer


Sean Kinnevy
Zoning Officer

EVERGREEN WOODS PARK ASSOCIATION

107 MIRANDA COURT BRICK, NJ 08724
(908) 458-1784 Fax (908) 458-8405

May 3, 1996

Township of Brick
Building Department
401 Chambersbridge Road
Brick, NJ


Re: Scott O'Donnell
127 Camille Court

Dear Sir/Madam,

Please be advised that plans for a deck have been approved on the above referenced unit. We have placed our seal on each of the pages.

If you have any questions concerning the above, please do not hesitate to contact us at the above number.


Sincerely,

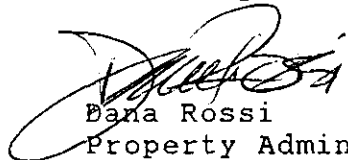


Dana Rossi
Property Administrator

DR/gc


STAIR DETAIL

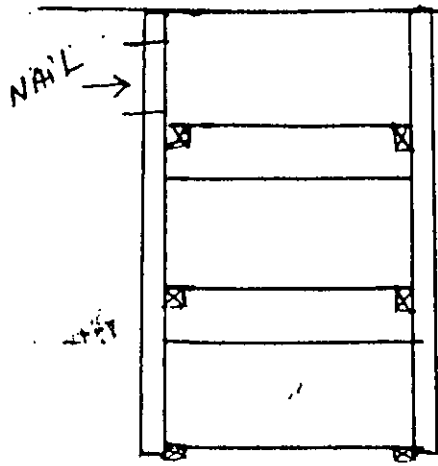

STAIR
2x12 stringer
with 2x12 TREAD
ON 2x4 BLOCKS
36" WIDE

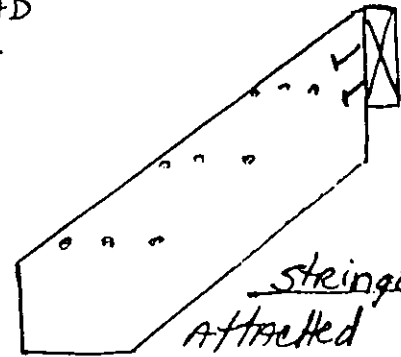


stringer
Attached to
Box Beam and
top TREAD

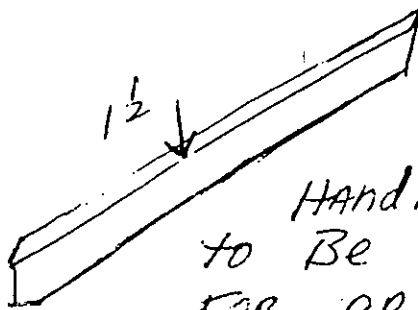


Handrail
to Be 1 1/2" wide
For grip

RAIL Detail

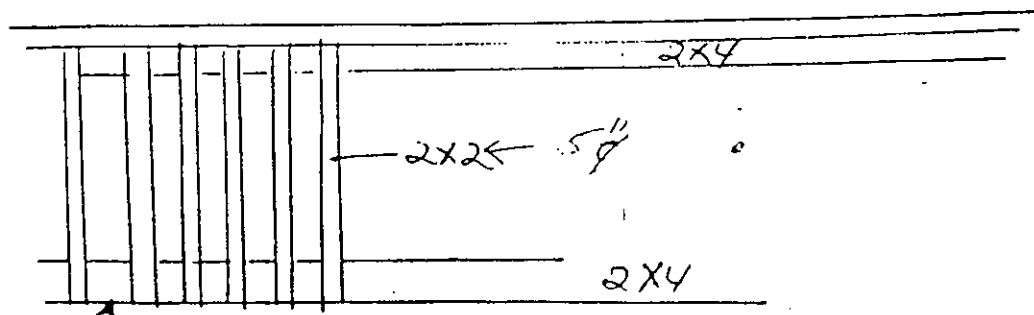

NOT MORE THAN 3 1/2" in Between

6/19/96
JL

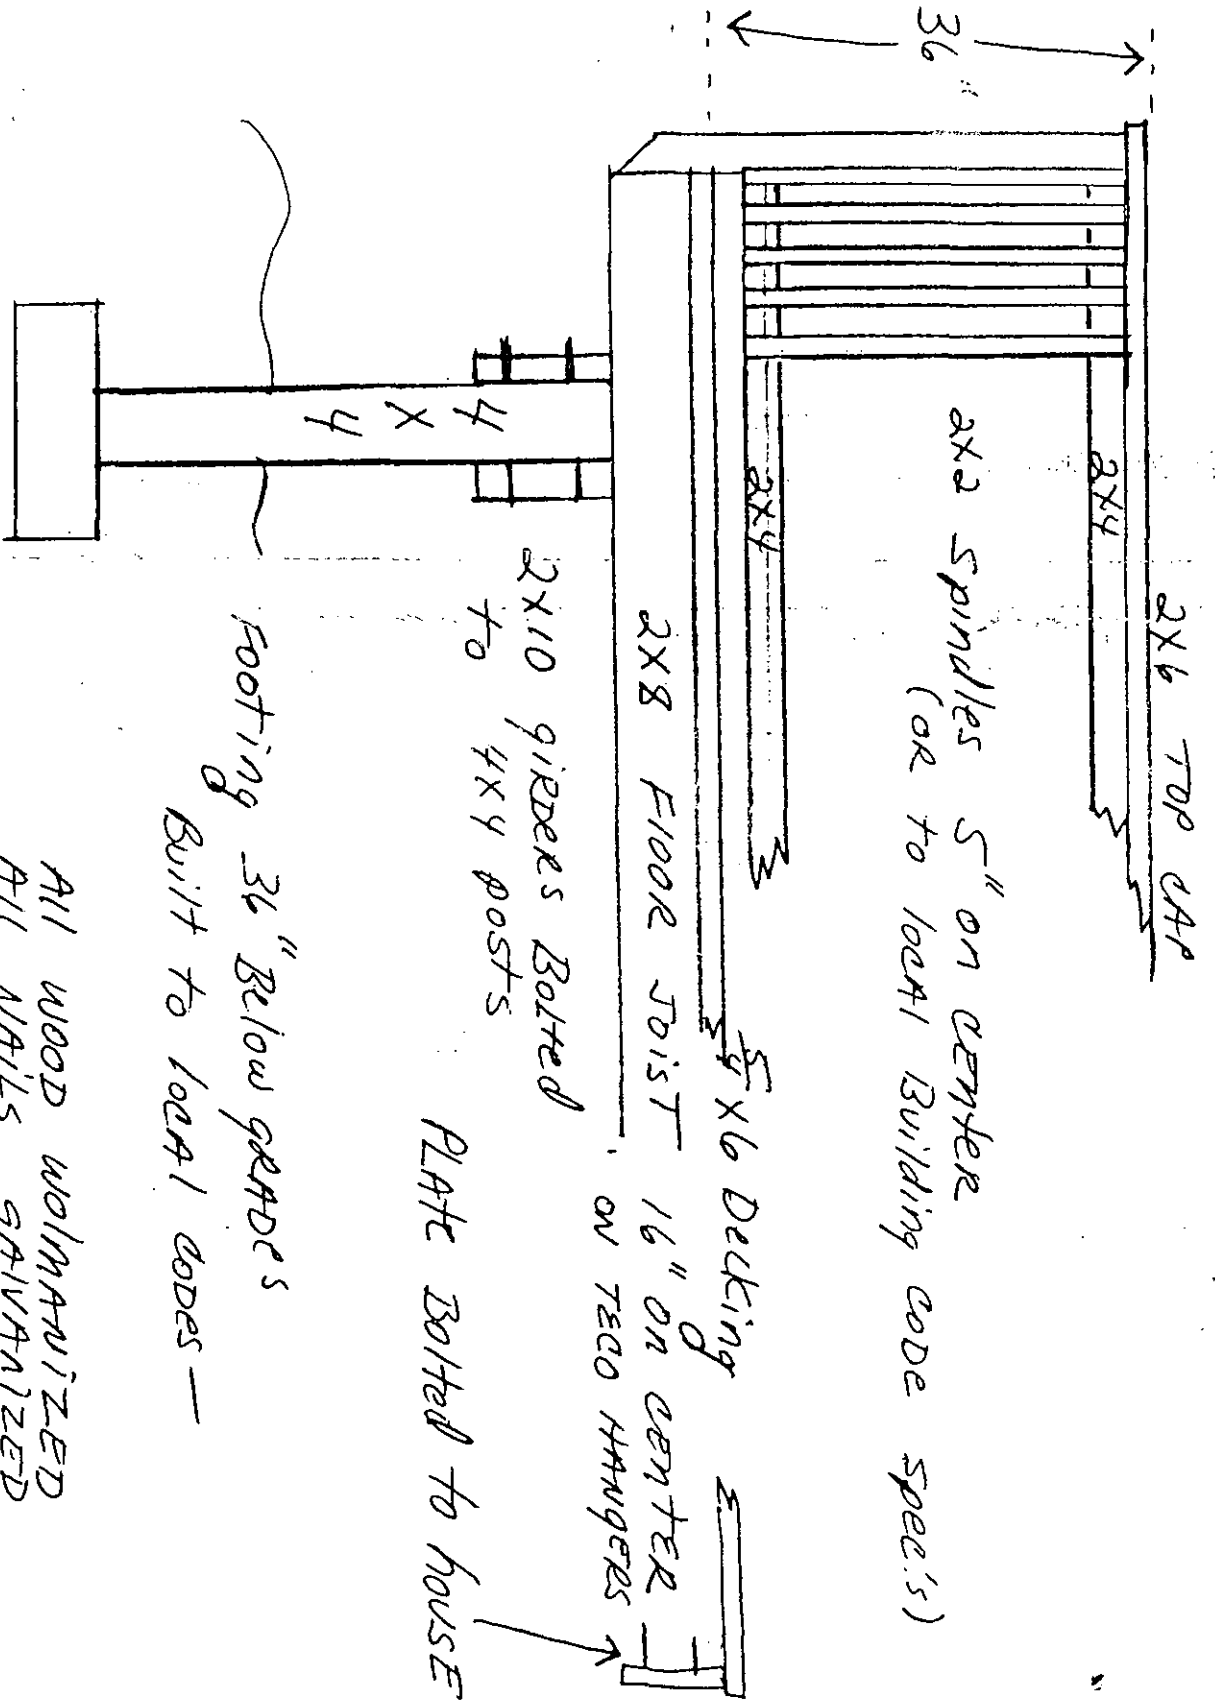

2X10 girders Bolted
to 4X4 posts

PLATE Bolted to house


Footing - 36" Below grade

Built to local codes -

ALL WOOD GALVANIZED
ALL NAILS GALVANIZED

*
Footing Detail on page
DECK DIAGRAM

Notice

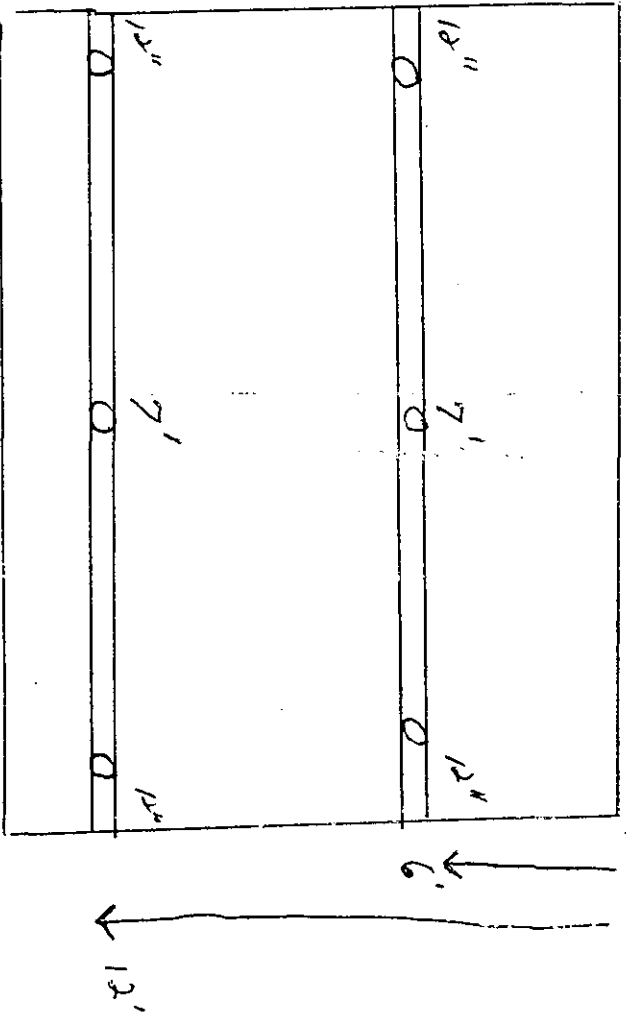


14


14

Back to home 2 guides
1 set at 12' out - 1 set at
6' out - there will be 6 footings.


STAIR DETAIL

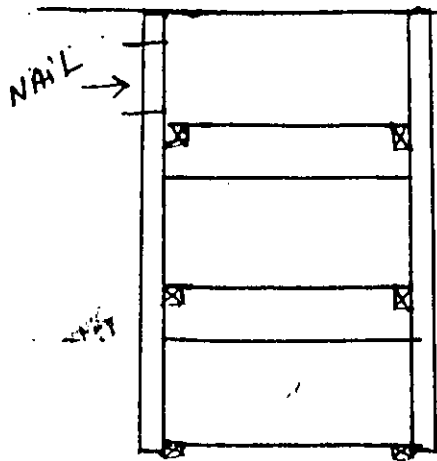

STAIR
2x12 stringer
with 2x12 TREAD
ON 2x4 BLOCKS
36" WIDE

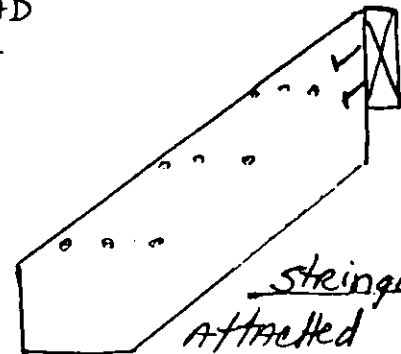


Stringer
Attached to
Box Beam and
top TREAD

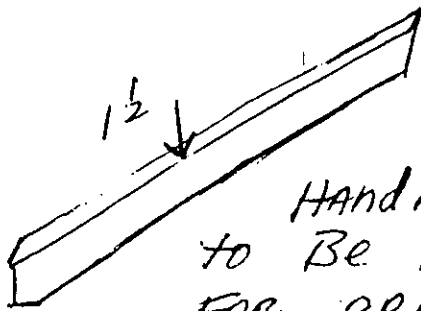


HANDRAIL
to Be 1 1/2" wide
FOR GRIP

RAIL DETAIL

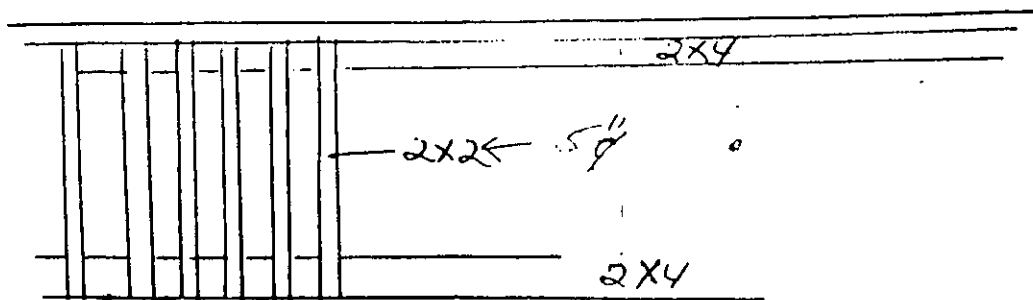


NOT MORE THAN 3 1/2" in Between

6/7/96
gc

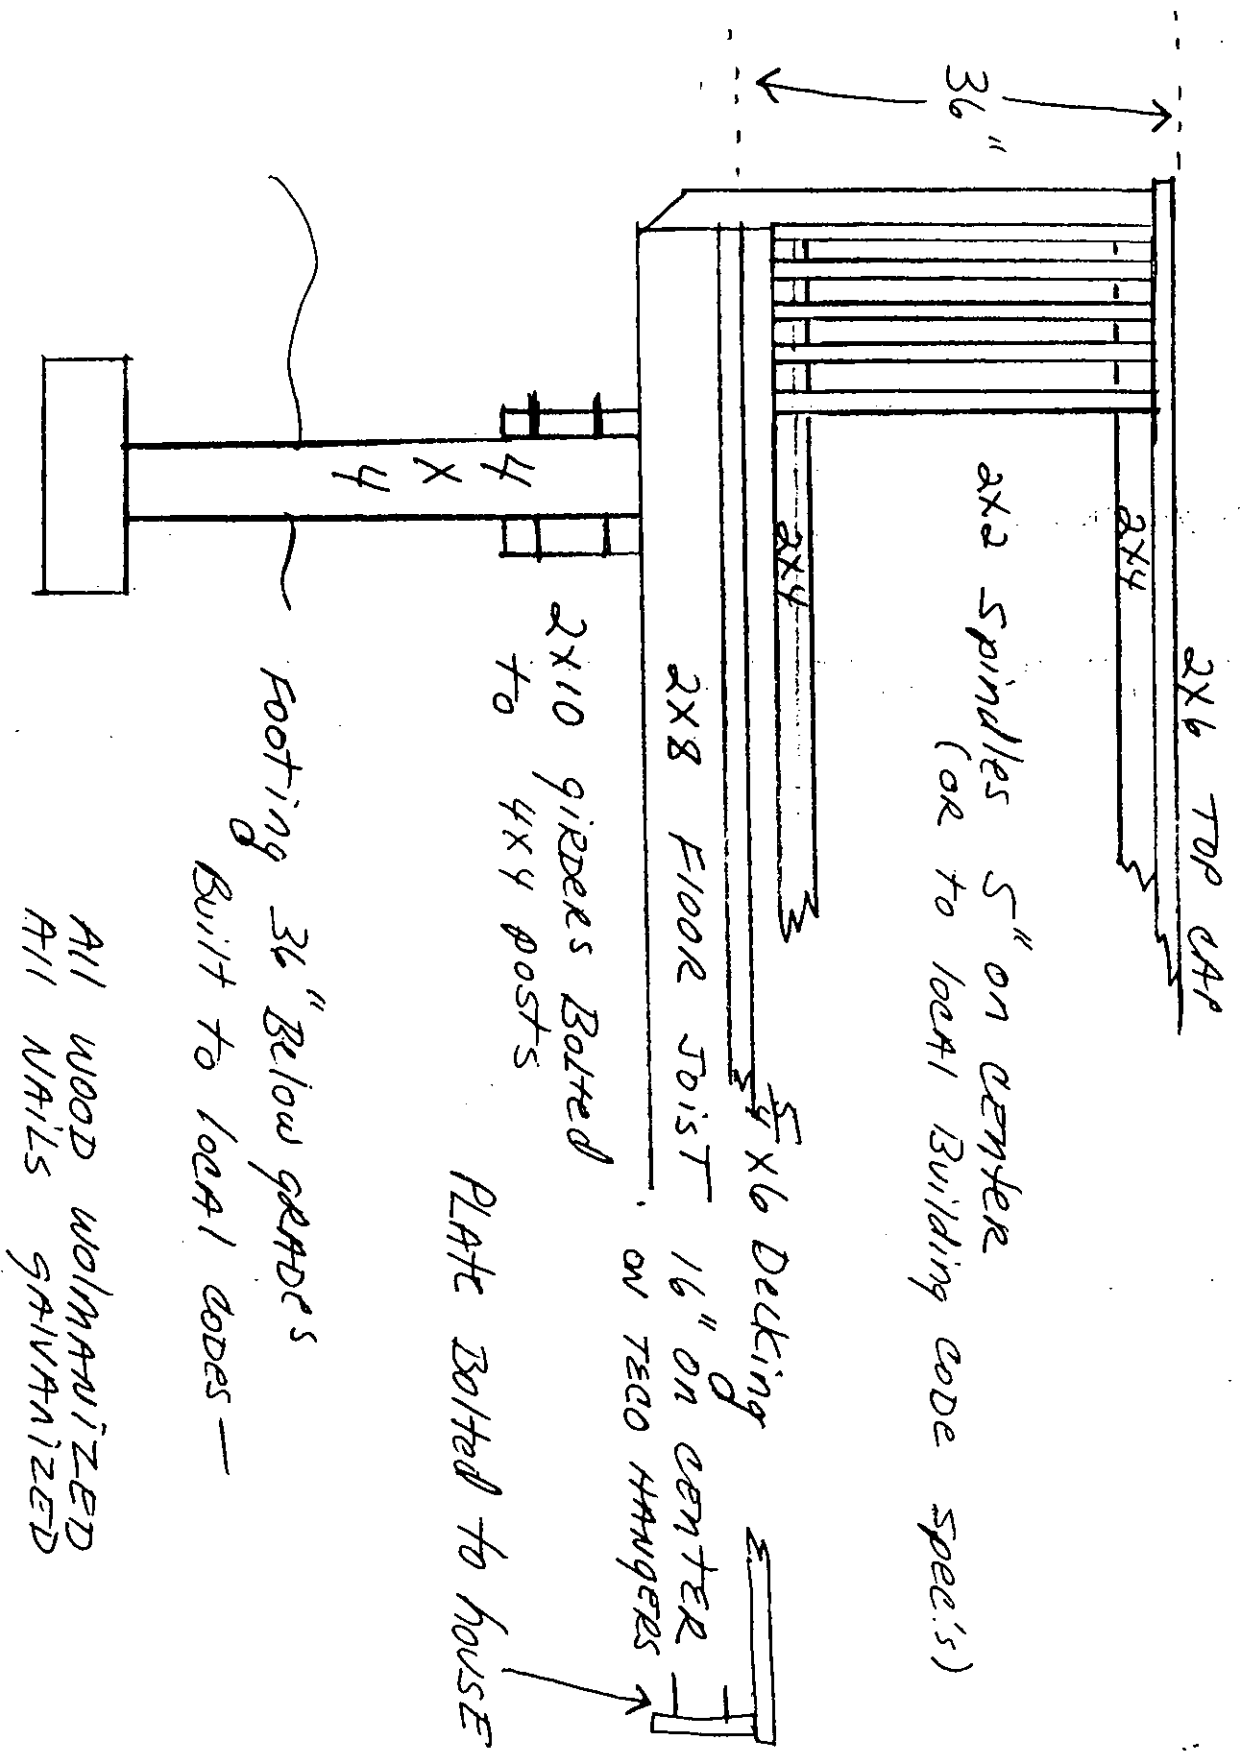

*
 Footing Detail on REME
 DECK DIAGRAM

ALL WOOD GALVANIZED
 ALL NAILS GALVANIZED

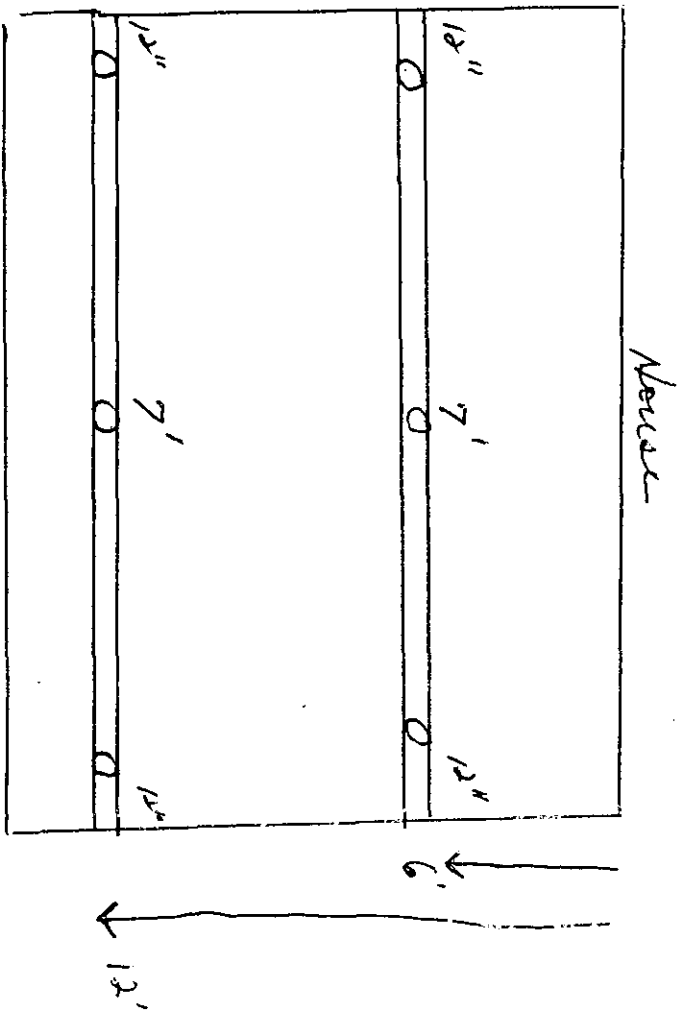

14

Back to have 2 girders
 1 set at 12' out - 1 set at
 6' out. there will be 6 footings.