

**OLD BRIDGE,
TOWNSHIP OF
(BUILDING DEPT.)**



LDS OB-B 10112023

\$55.00
Survey

TOWNSHIP OF OLD BRIDGE
ONE OLD BRIDGE PLAZA
OLD BRIDGE, NJ 08857

APPLICATION FOR FENCE OR ACCESSORY UNIT

DATE: 7/2/10

SITE ADDRESS 103 Summerfield Ave.

BLOCK NO. 1005

LOT NO. 103 & 104.11

Fence under 6 feet*

X 8' X 10'

Accessory Units 100 square feet or less

* Not in association with the installation of a swimming pool

Applicant must submit detailed drawing (s) with application showing size, design, anchorage and materials. Application must show location of unit or fence on property. A property survey is required.

APPLICANT OR BUSINESS REQUESTING AUTHORIZATION:

Name: Angela Geller

Phone no. [REDACTED]

Address 103 Summerfield Avenue

City Lawrence Harbor

State NJ

Zip code 08879

OWNER OF PROPERTY (if other than above)

Name

Phone no. ()

Address Same

City

State

Zip code

PERSON, FIRM OR CORPORATION PERFORMING INSTALLATION:

Name Angela Geller

Phone no. [REDACTED]

Address 103 Summerfield Ave.

City Lawrence Harbor

State NJ

Zip code 08879

Date: 7/2/10

Angela Geller

(Signature of Applicant)

FOR AGENCY USE ONLY:

DATE OF FILING 7-15-10

NON-CONFORMING

DATE

APPROVED

Fee \$55.00

CONFORMING yes / AS-noted

APPROVED FOR INSTALLATION AS-NOTED, yes
(If no, Date of Planning Board)


DISAPPROVED

RECEIPT NO. 393105

Mike Ferdinandy
Code Enforcement Officer

5.4
12.4
8.1
25.9

41
- 26
15
- 3
12
- 8
4

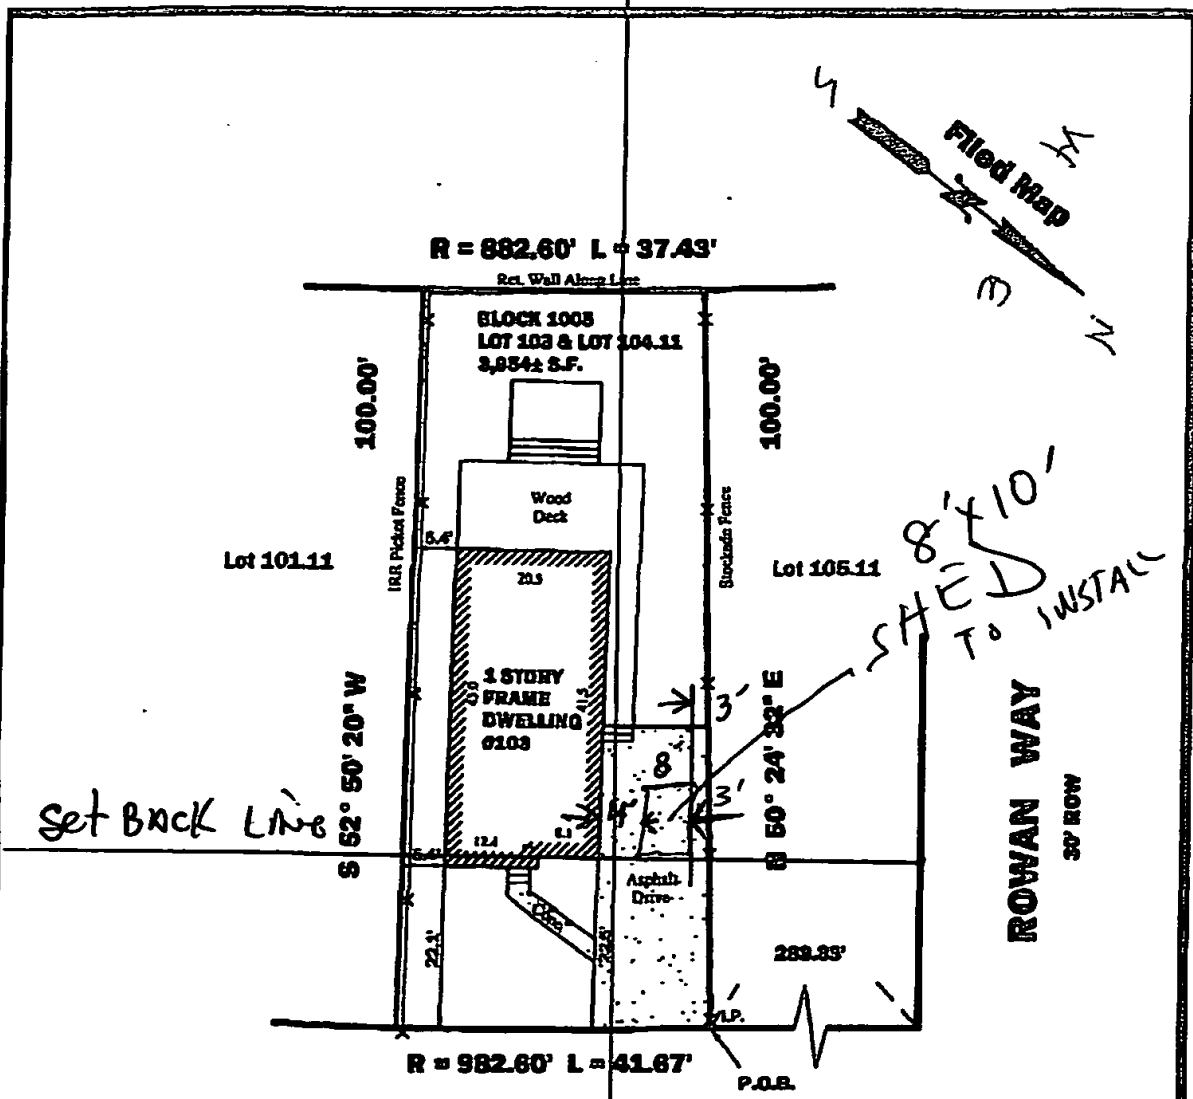

Set Back Line

8'x10'
SHED
TO INSTALL

SUMMERFIELD AVENUE

30' ROW

PROPERTY KNOWN AS LOT 103 & PART OF LOT 104 ON
MAP ENTITLED, "MAP OF LAURENCE HARBOR PARK"
FILED JULY 18, 1930 AS MAP No. 1317 FILE No. 724

WAIVER OF SETTING CORNER MARKERS
OBTAINED FROM ULTIMATE USER
PURSUANT TO N.J.A.C. 13:40-8.1(D)

JUL 14 2010
This Survey is for the exclusive use of those
identified below. It is by any other parties shall
void any and all contractual agreements or
obligations of the surveyor that may be in
effect without the expressed written
permission of the Surveyor

SURVEY OF PROPERTY LOT 103 & 104.11 BLOCK 1005 Situated in OLD BRIDGE TOWNSHIP MIDDLESEX COUNTY NEW JERSEY		
This Survey is Certified To: ANGELA GELLER ATTORNEYS LAND TITLE AGENCIES, INC. STEWART TITLE AND GUARANTY COMPANY HENRY F. WOLFF, III, ESQ. WELLS FARGO BANK, N.A., its successors and/or assigns as their interests may appear		
J Y LAND SURVEYING, INC. Professional Land Surveyors Planners 1 Walnut Drive Jackson NJ 08527 (732) 928 3398 Certificate of Authorization No. 24GA28128900		
BRIAN T. YURO PROFESSIONAL LAND SURVEYOR NJLS No. GS43252	File 16546	Date 4-19-10
Scale 1" = 20'		



More saving. More doing.®

Welcome, (Sign in or Register) New York, NY is your

Share

Email

Print

Handy Home Products Kingston 8 Ft. X 8 Ft. Shed with Floor

Model # 18276-1 Internet # 100626321

~~\$899.00/EA-Each~~**\$829.00/EA-Each**

Price includes shipping

Online Special Valid: 07/01/2010 - 09/29/2010

Special Buy Learn More

This item cannot be shipped to the following state(s): AK, HI


Average Customer Rating

★★★★★ 4.8 out of 5 -

Write a review for a chance to win a \$1,000 Gift Card.

Read Reviews

Write a Review

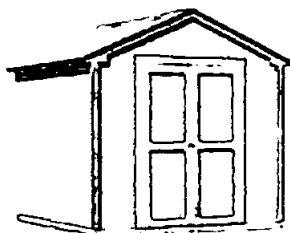

View Larger More Views

Description

The Kingston is an easy storage solution for any yard... any size. This 8 Ft. wide gable-design building features 6 Ft. high sidewalls and an 8 Ft. high peak. The 4 Ft. wide x 6 Ft. high double doors with full-length hinges and swivel hasp make for easy access to all of your outdoor equipment. Select and purchase paint and shingles to match your home. Check with your local code authority before placing your order. Curbside delivery only.

Includes wood floor

Everything is pre-cut, nothing to saw

Easy to assemble with hammer, screwdriver, tape measure, level and stepladder

Sturdy 2 x 3 construction meets demanding snow and wind loads

Price includes delivery to your home! Curbside delivery only. Your order will ship in 5-7 days

MFG Brand Name : Handy Home Products

MFG Model # : 18276-1

MFG Part # : 18276-1

Specifications

Assembled Depth (in.) : 96 in

Assembled Height (in.) : 100 in

Assembled Width (in.) : 102 in

Energy Star Compliant : No

Height : 8 ft

Item Weight : 1178 lb

Length : 8 ft

Width : 8 ft

Window : No

More Info

Warranty

For warranty information on this product, please call our Internet Customer Service Center at 1-800-435-4654.

Shipping

Most orders ship within 5 business days.

Please allow an additional 5-10 business days for Basic Home Delivery in the Continental U.S. Basic Home Delivery service includes delivery to your door or first dry area. Delivery appointments are not required. Freight included.

~~\$899.00/EA-Each~~**\$829.00/EA-Each**

Add to My List

Online Only

YOU MAY ALSO LIKE

~~\$1,249.00/EA-Each~~

Internet Special

\$999.00/EA-EachHandy Home Products
Montana 8 Ft. X 10 Ft.
Shed**\$590.00/EA-Each**

Arrow

Arlington 10 Ft. X 12 Ft.
Storage Building**\$299.00/EA-Each**

Arrow

Branthwood 5 Ft. X 4 Ft.
Storage Building**\$560.00/EA-Each**

Arrow

6 Ft. X 6 Ft. Vinyl Coated
Steel Storage Building**\$549.00/EA-Each**

Arrow

Glenwood 8 Ft. X 6 Ft.
Storage Building