


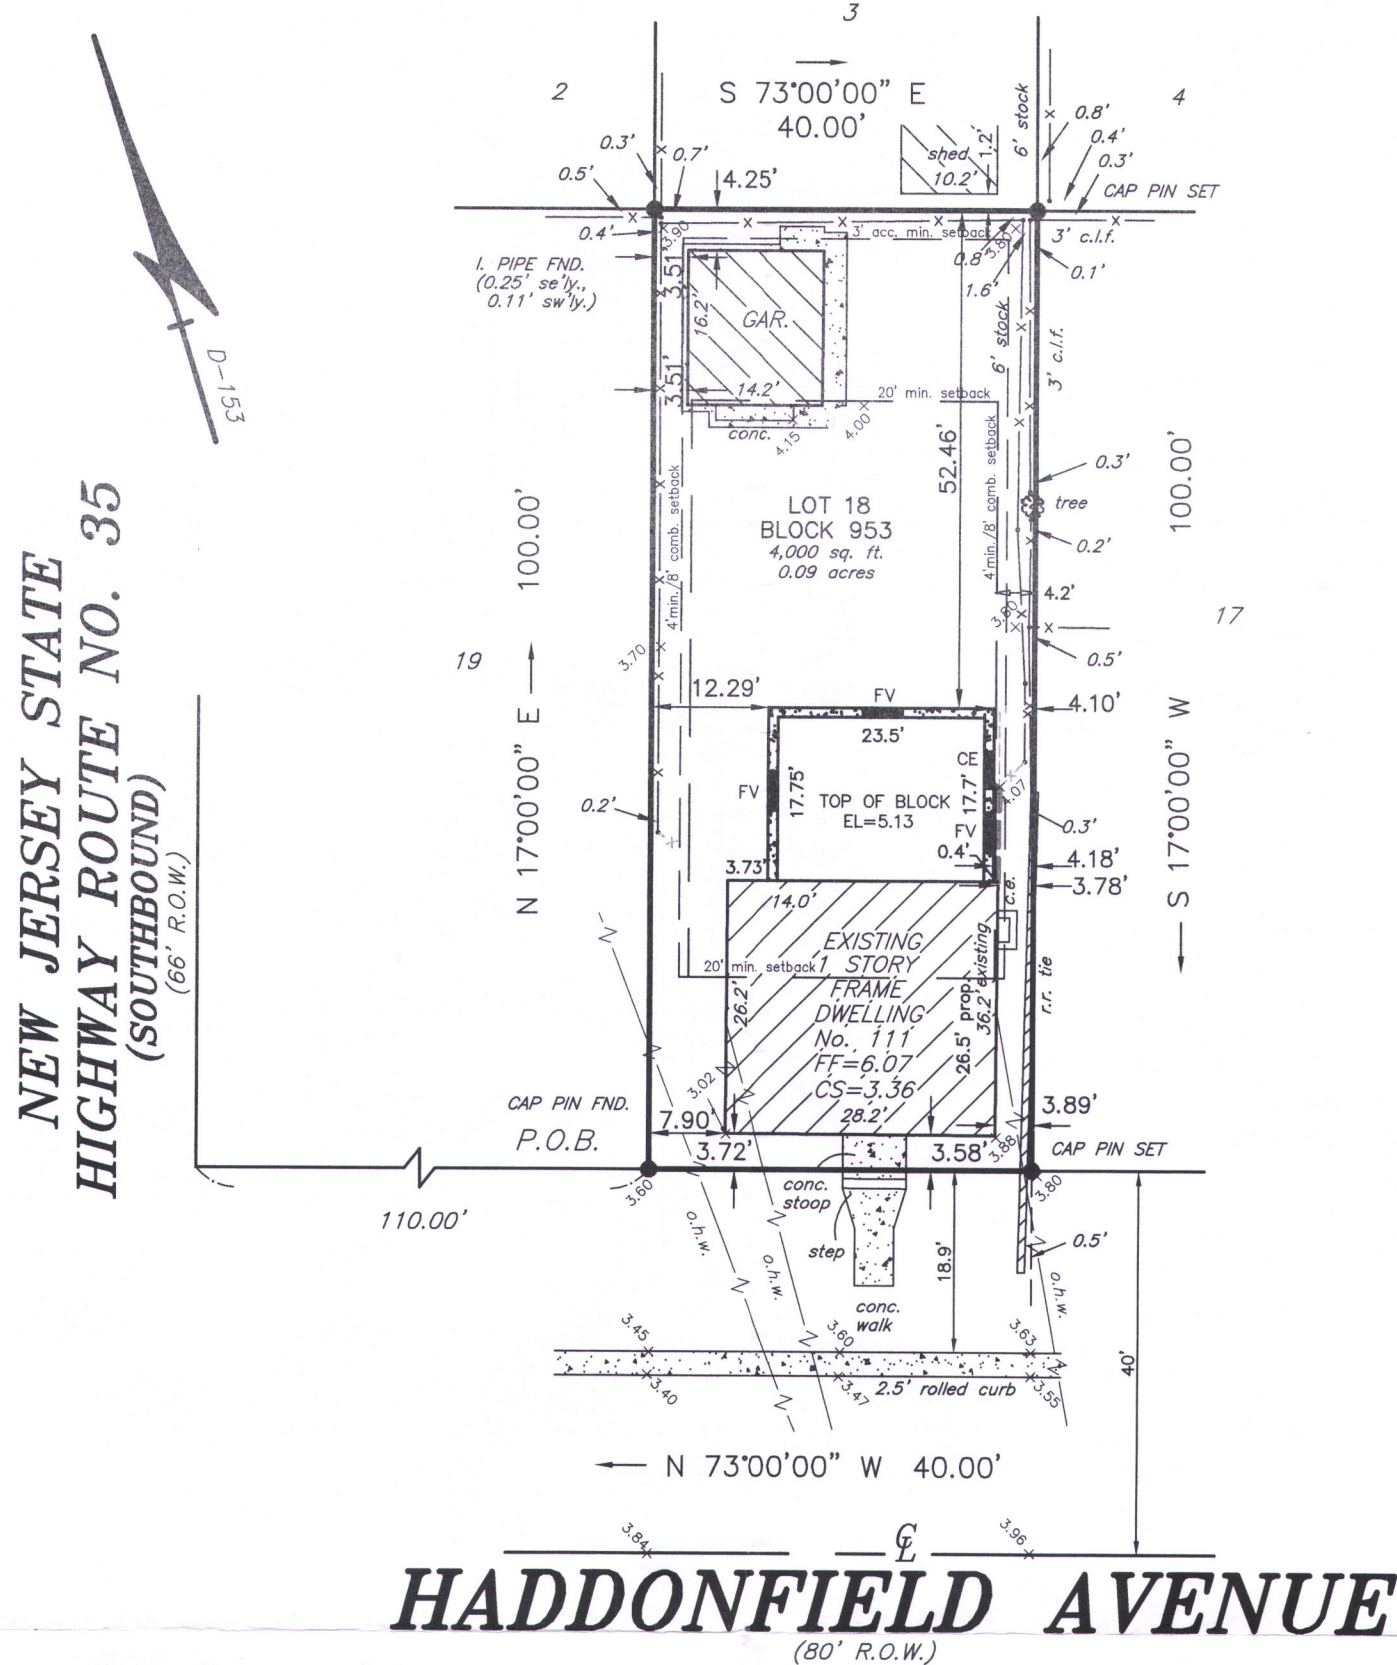


DEED DESCRIPTION:
BEING KNOWN AND DESIGNATED AS LOT 18 IN BLOCK 6 AS SHOWN ON A MAP ENTITLED, "PLAN A OF A SECTION OF NORTH LAVALLETTE, DOVER TOWNSHIP, OCEAN COUNTY, N.J.," WHICH SAID MAP WAS DULY FILED IN THE OCEAN COUNTY CLERK'S OFFICE ON JAN. 13, 1926 AS MAP NO. D-153.

- NOTES:
1. ALSO KNOWN AS LOT 18 IN BLOCK 953 AS SHOWN ON THE OFFICIAL TAX MAP OF THE BOROUGH OF LAVALLETTE, COUNTY OF OCEAN AND STATE OF NEW JERSEY.
 2. THE PREMISES ARE COMMONLY KNOWN AS 111 HADDONFIELD AVENUE, LAVALLETTE, NEW JERSEY.
 3. (2) CORNER MARKERS SET.
 4. UNDERGROUND UTILITIES NOT LOCATED BY THIS SURVEY.
 5. NO WETLANDS EXIST ON SITE.
 6. ELEVATIONS BASED ON 1988 N.A.V.D.
 7. SITE IS SITUATED IN FIRM ZONE AE EL=5, COMMUNITY No. 340379, PANEL 34029c0327F, DATED SEPTEMBER 29, 2006.

THIS SURVEY IS CERTIFIED TO HAVE BEEN PERFORMED IN ACCORDANCE WITH THE STANDARDS OF LAND SURVEYING PROFESSION AS SET FORTH IN N.J.A.C. 13:40-5.1 AND AS PRACTICED IN THE STATE OF NEW JERSEY. IT IS ONLY CERTIFIED TO:

- LEE E. WALSH

ZONING APPROVED
DATE 9-24-08
RWP
ZONING OFFICIAL

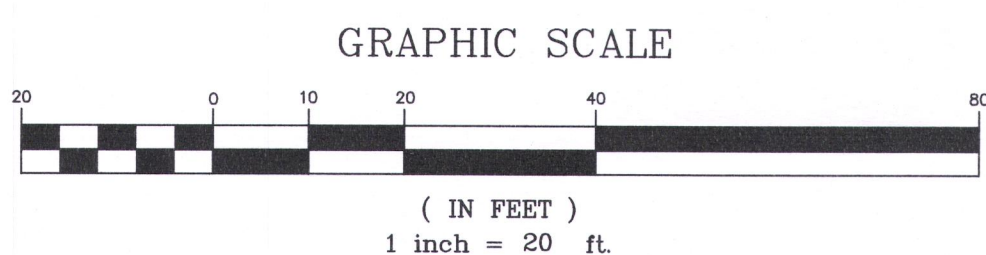

RWP Ronald W. Post Surveying, Inc.
Professional Land Surveying and Planning
1792 Hinds Road, Toms River, NJ, 08753
Phone: (732)-255-9050 Fax: (732)-255-9196

Ronald W. Post
Professional Land Surveyor N.J. Lic. 28534
Professional Planner N.J. Lic. 02940
Certificate of Authorization No. 243A27969400

[Signature] 9-18-2008
date

This survey subject to any easement of record and other pertinent facts which an accurate title search might disclose. Environmentally sensitive areas, if any, are not located by this survey. No attempt was made to determine if a portion of this property is claimed by the State of New Jersey as tidelands. No liability is assumed by the certifying Surveyor for the use of this survey by any party not shown on the certifications hereon or for the use of survey with survey affidavit.

SURVEY OF PROPERTY FOUNDATION AS BUILT				
111 HADDONFIELD AVENUE LOT 18 BLOCK 953 BOROUGH OF LAVALLETTE OCEAN COUNTY, NEW JERSEY				
Scale 1"=20'	Dr. J.J.P.	Chk. RWP	Date 9-18-2008	Job No. 030643