

EIGHTH

80.0' R.O.W.

AVENUE

...BLOCK 209...


24.

25.

26.

27.

28.

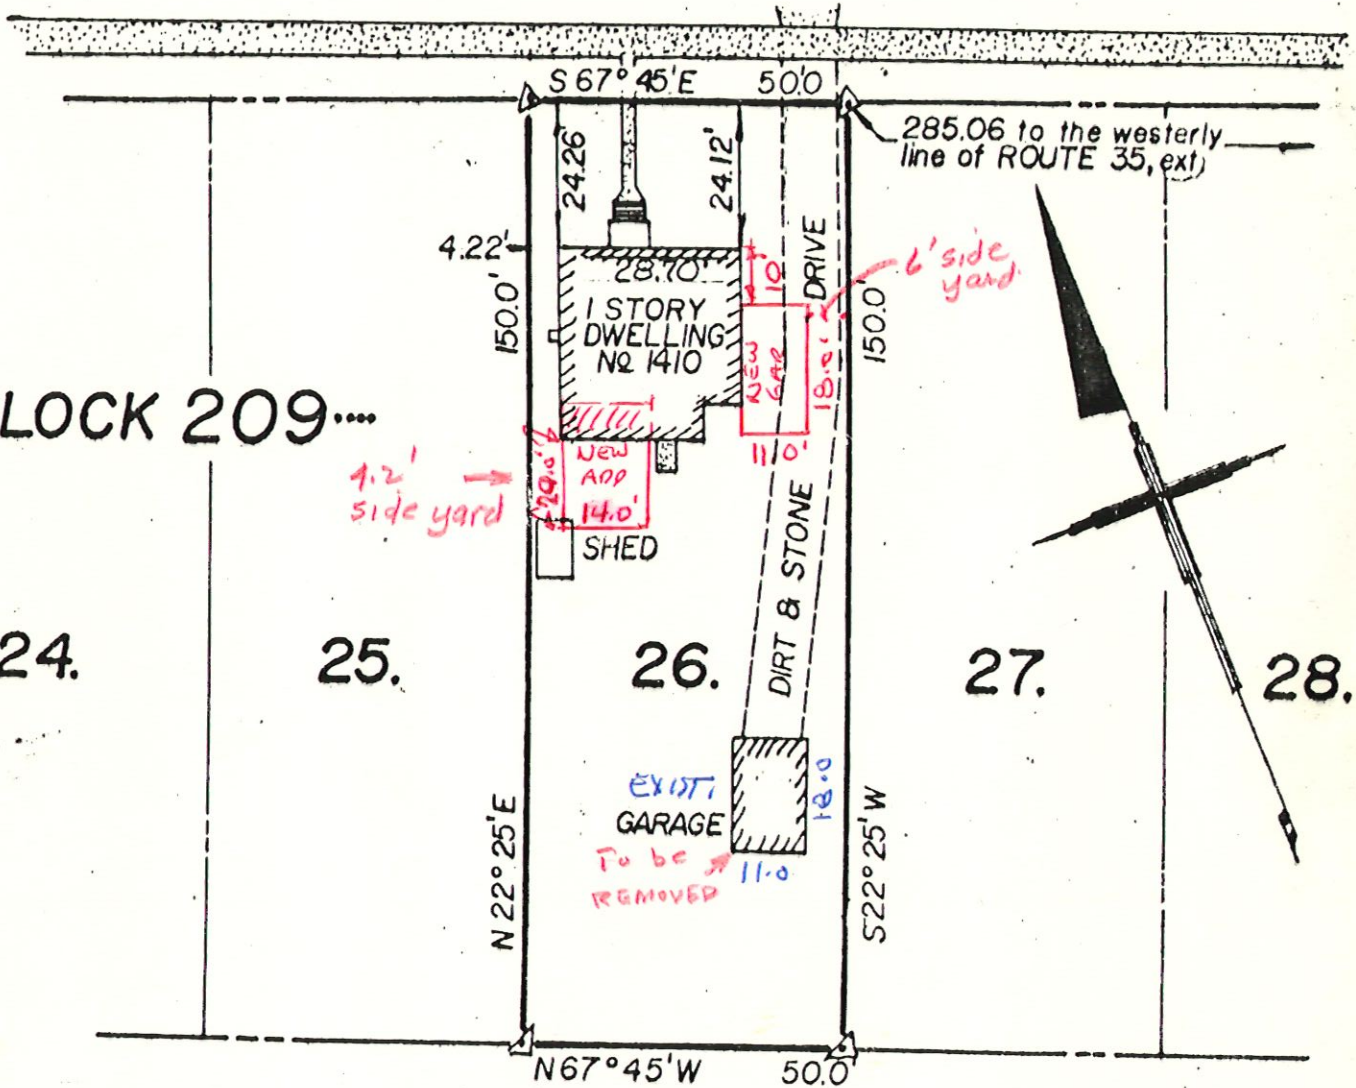

Location Survey For

NAM HOANG NGUYEN & ANA N. BUI

Being Lot 26 Block 209 as shown on the tax assessment map of the Township of Neptune Monmouth County, New Jersey.

I hereby certify to the above purchasers, Margaretten & Company, Inc., and Pioneer National Title Insurance Co., this is a true and accurate survey made on the premises. No encroachments exist except as shown hereon.

Scale: 1"=30'

JOB: 846

Richard E. Stockton, Surveyor
N.J. License No. 15102
P.O. Box 124 Atlantic Highlands

Date: Aug. 3, 1981

FB:18/23

This certification is made only to above named parties for purchase and/or mortgage of herein delineated property by above named purchaser. No responsibility or liability is assumed by Surveyor for use of survey for any other purpose including, but not limited to, use of survey for survey affidavit, resale of property, or to any other person not named in certification, either directly or indirectly.

Richard E. Stockton

DWG: A- 384