



RECEIVED JUN 17 2020

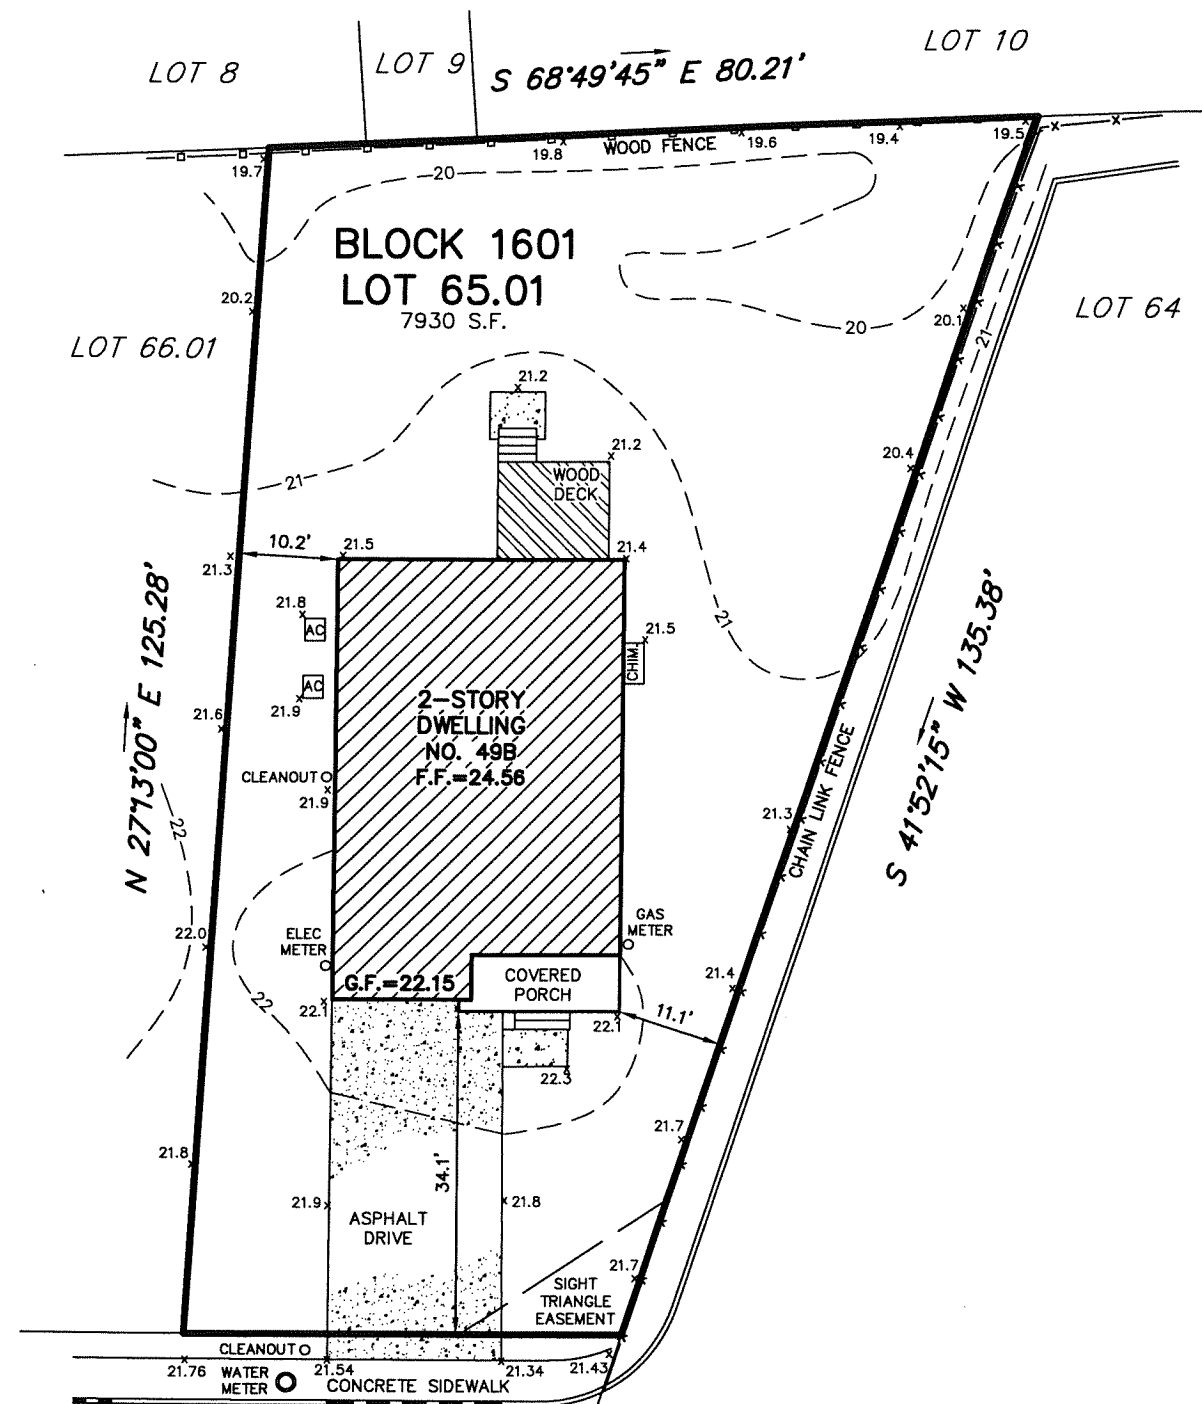

N 66°15'00\"/>

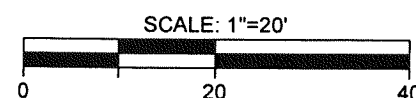

AS-BUILT BUILDING COVERAGE - 1415 S.F. (17.8%)
AS-BUILT LOT COVERAGE - 2260 S.F. (29.5%)
AS-BUILT BUILDING HEIGHT - 34.42 FT.
AS-BUILT FINISHED GRADE (5 FT. OFF FOUNDATION) - 21.55
AS-BUILT ROOF RIDGE ELEVATION - 55.97

AS-BUILT SURVY

49B VICTOR PLACE
LOT 65.01 BLOCK 1601

BOROUGH OF EATONTOWN

MONMOUTH COUNTY

NEW JERSEY

Charles Surmonte P.E. & P.L.S.
New Jersey Professional Engineer and Land Surveyor
License No. 35885

301 Main Street, 2nd Floor
Allenhurst, New Jersey, 07711
Phone 732-660-0606
Fax 732-660-0404

PROJECT No.

19-004-65.01

DATE:

05-28-20

SCALE:

1"=20'

SHEET:

1 OF 1