

I WILL NOT use the requested government records for a commercial purpose.

I AM NOT seeking records in connection with a legal proceeding.

Records requested:

I am interested in purchasing the property located at 47 Burnside Place, Wanaque, NJ 07420 and would like to kindly request any available records related

to this property.

If possible, please include:

~~-Property record card and tax assessment information~~

✓ Building permits (open and closed), along with descriptions of work performed

* Certificates of Occupancy

* Records of any additions, renovations, or structural changes

~~-Septic and/or well records (if applicable)~~

✓ Any records related to oil tanks, including permits or removal documentation (if applicable)

-Survey, plot plans, and zoning information

* Any code violations or notices on file

I would greatly appreciate receiving these records electronically via email, if available.

Thank you very much for your time and assistance.

* No such responsive documents exist

My preferred delivery method for response(s) to this request is by E-mail (as attachments. Please confirm you have received this request. If you are not the custodian of records, please forward my request to that person and provide their email address to me for future reference.

Yours faithfully,


Katarzyna Benitez



1. Permits

(All Data, Location Address Like '47 Burnside' - 5 records)

Permit Number	Permit Issue Date	Control Number	Location Address	Subcodes Used	Work Description Comments	Block	Lot	Application Status
16-385	08/23/2016	92011297	47 BURNSIDE PLACE	B E	INSTALL ROOFTOP SOLAR PANELS	410	27	CA and Close Date Issued
05-495	08/30/2005	92005080	47 BURNSIDE PLACE	B E P F	IN GROUND POOL 17' X 37	410	27	CA and Close Date Issued
05-405	06/23/2005	92004822	47 BURNSIDE PLACE	E	200AMP SERVICE	410	27	Open
05-256	05/18/2005	92004670	47 BURNSIDE PLACE	B	NEW ROOF W/ICE SHIELD	410	27	CA and Close Date Issued
02-66	02/26/2002	92002769	47 BURNSIDE PLACE	B	REMOVAL OF 275 GAL ABOVE GROUND OIL TANK	410	27	CA and Close Date Issued
Grand Totals								

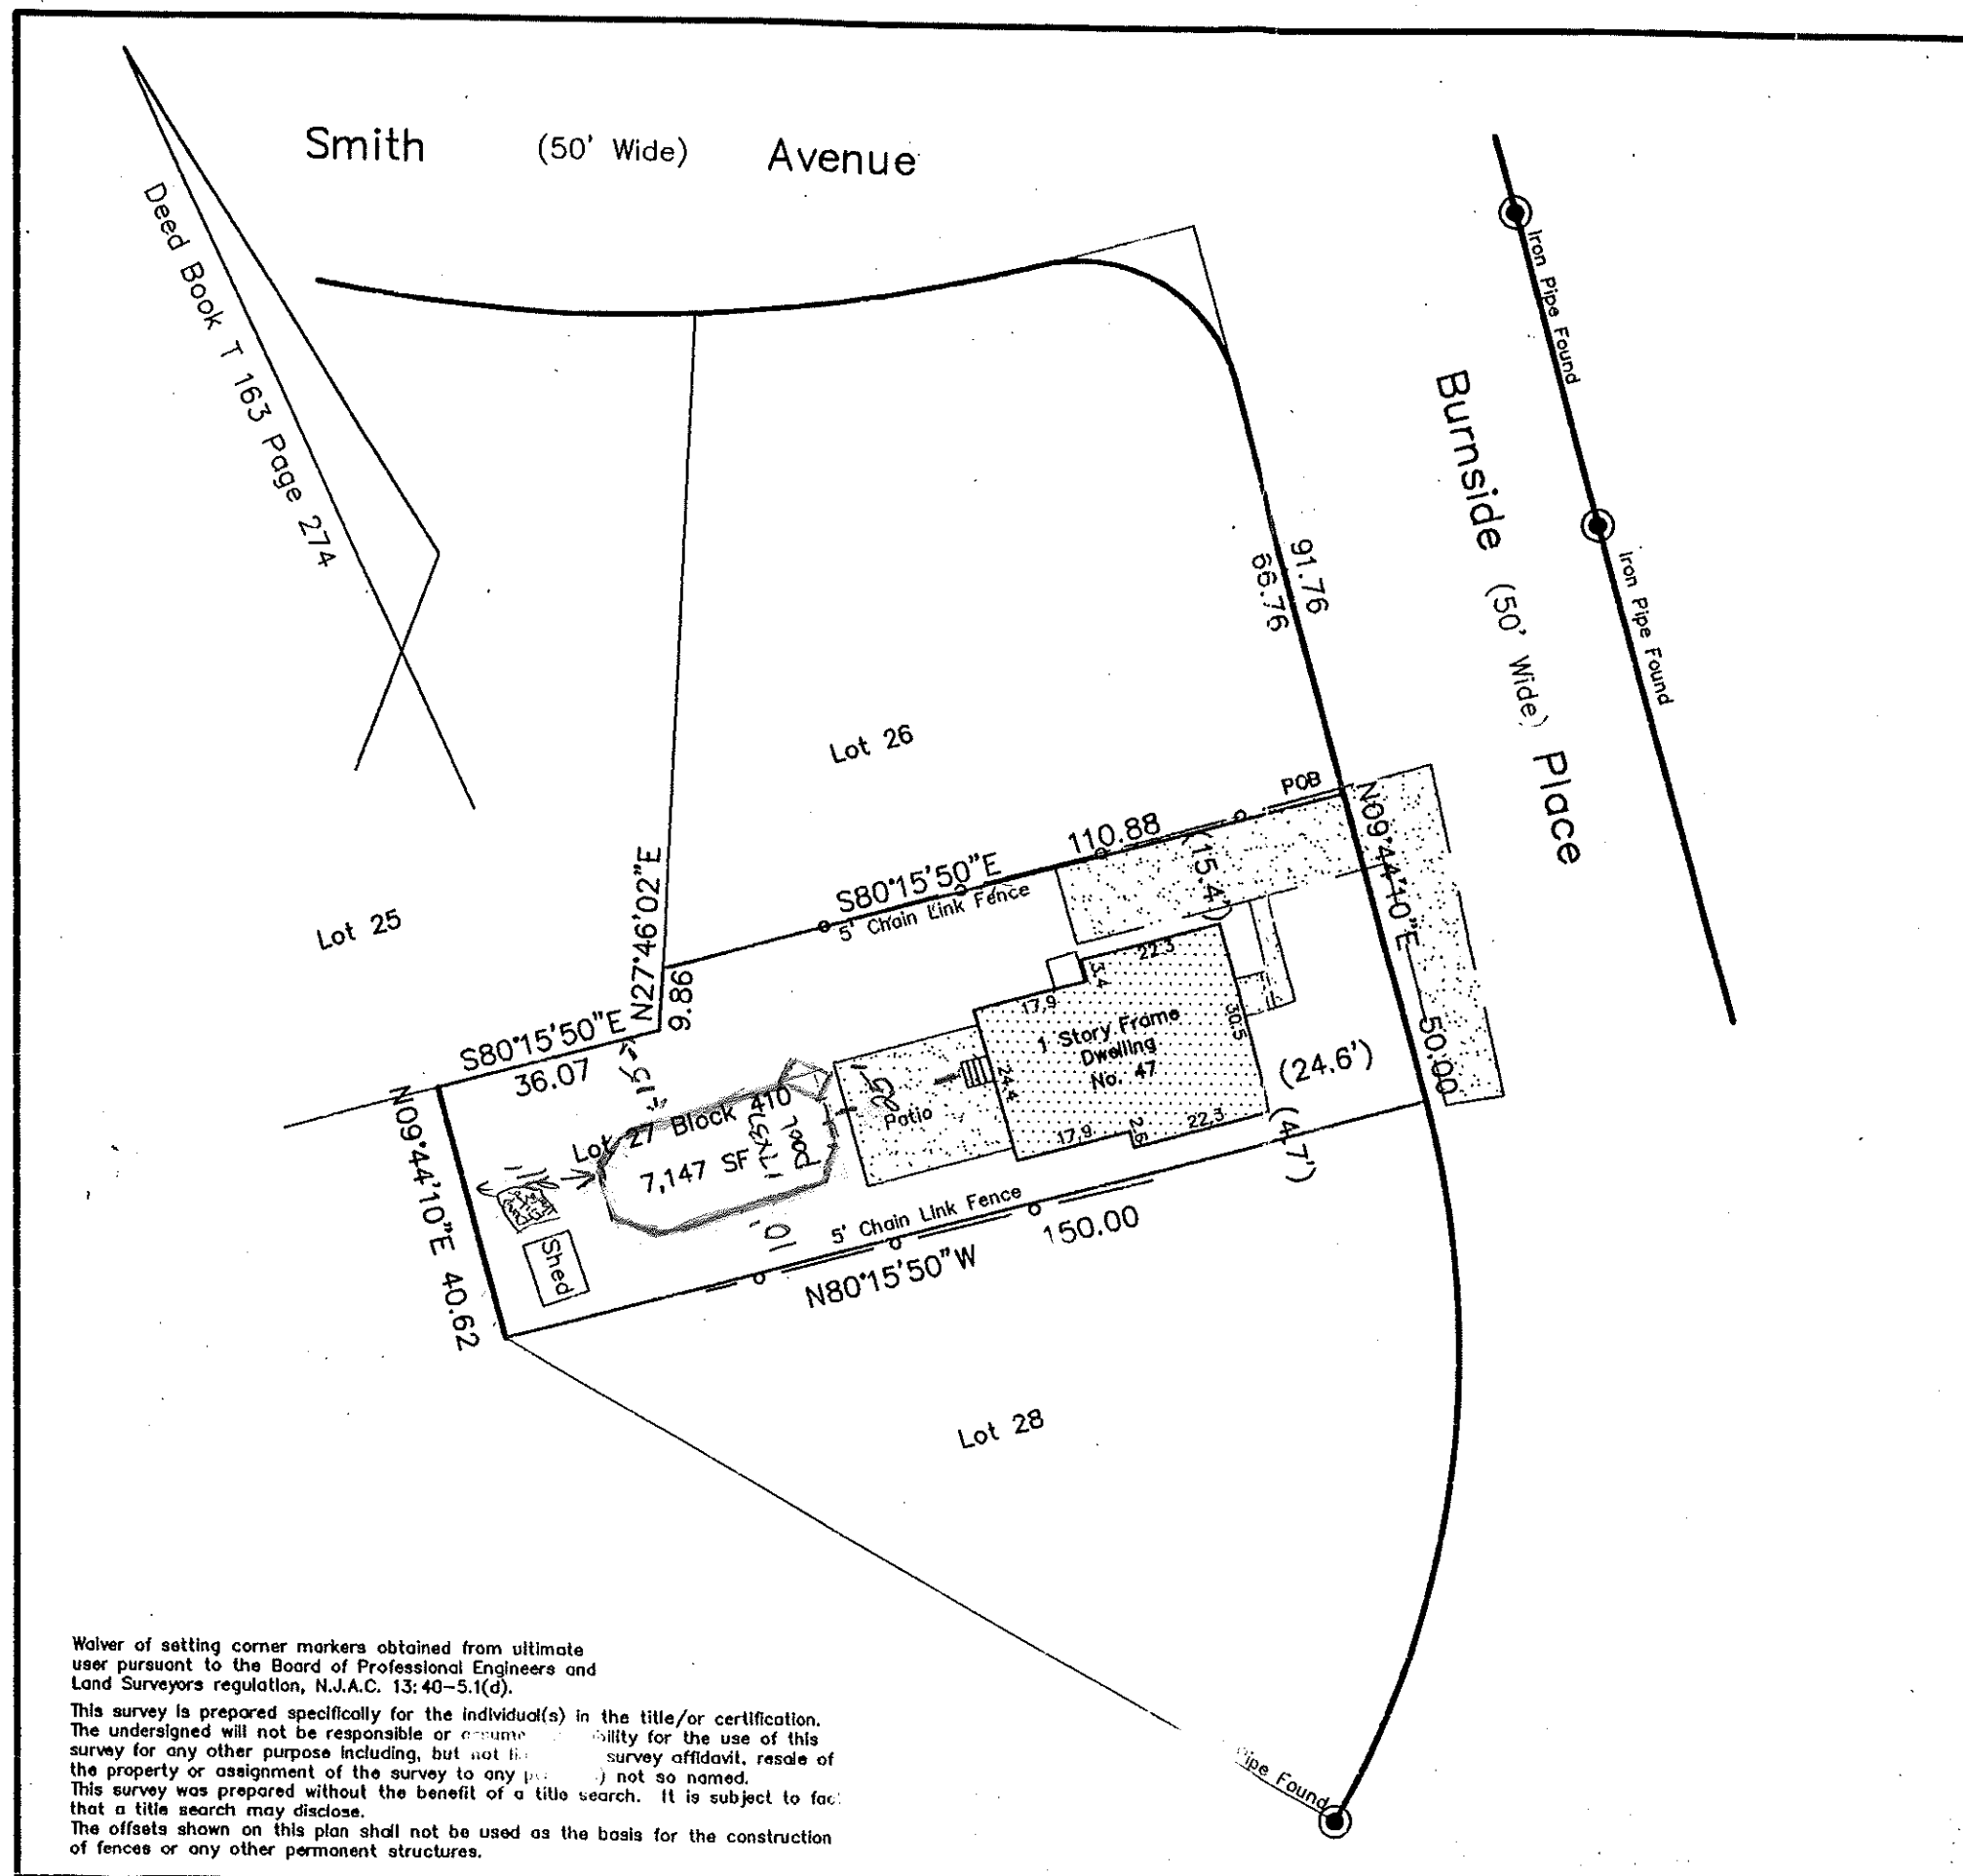

TO: Thomas Egidio and Donna Brown
Commonwealth Land Title Insurance Company
of New Jersey and,
Advantage Title Agency, Inc. (ATA 12350)
Allied Mortgage Capitol Corporation
as their interest may appear
Paul J. Curreri, Esq.

I CERTIFY THAT, TO THE BEST OF MY KNOWLEDGE AND BELIEF, THIS MAP OR PLAN IS THE RESULT OF A FIELD SURVEY MADE ON 04/04/02, BY ME OR UNDER MY DIRECT SUPERVISION, IN ACCORDANCE WITH THE RULES AND REGULATIONS PROMULGATED BY THE "STATE BOARD OF PROFESSIONAL ENGINEERS AND LAND SURVEYORS".

THE INFORMATION SHOWN HEREON CORRECTLY REPRESENTS THE CONDITIONS FOUND AT AND AS OF THE DATE OF THE FIELD SURVEY, EXCEPT SUCH IMPROVEMENTS OR EASEMENTS, IF ANY, BELOW THE SURFACE AND NOT VISIBLE.

THIS CERTIFICATION IS GIVEN SOLELY TO THE ABOVE NAMED PARTIES, EXCEPT AS FOLLOWS:

- A: TO THE TITLE INSURER SO THAT IT MAY INSURE TITLE TO THE PREMISES SHOWN HEREON.
- B: TO THE MORTGAGE HOLDER, THE CERTIFICATION SHALL SURVIVE TO ITS SUCCESSORS OR ASSIGNS.

CAUTION: IF THIS DOCUMENT DOES NOT CONTAIN A RAISED IMPRESSION SEAL OF THE PROFESSIONAL, IT IS NOT AN AUTHORIZED ORIGINAL DOCUMENT AND MAY HAVE BEEN ALTERED.

Joseph F. Barbieri, Jr.
Joseph F. Barbieri, Jr.
Professional Planner, NJ Lic. No. 5000
Land Surveyor, NJ Lic. No. 35350

Dwelling Location Survey for:			
Thomas Egidio and Donna L. Brown			
BY	DATE	REVISION	
		Borough of Wanaque, Passaic County, New Jersey	
DATE	SCALE	FIELD BOOK/PAGE	PROJECT NO.
April 4, 2002	1" = 30'	33	4553
MAP REFERENCE AND LOT DESCRIPTION			
REFERENCE	TAX MAP		
LOT 27	BLOCK D	LOT 27	BLOCK 47C
MAP OF: Map No 1; Property of Wanaque Homes, Inc.			
FILED: October 14, 1949		MAP NO: 1199	

JOSEPH F. BARBIERI & ASSOCIATES, INC.
LAND SURVEYORS - PLANNERS
100 RAIL STREET, TOTOWA, N.J. 07512