

TOWNSHIP OF WASHINGTON

ZONING PERMIT # 98-082

Name MICHAEL GRACE Date _____
Address 1 Amy Ct. Robbinsville N.C. Telephone 609-443-3507
Block 10 Lot 5.02 Zone N/A
Proposed Construction 2 DORMER 7'6" WIDE X 6'
Size _____ Estimated Cost N/A Completion Date N/A
Architect N/A

Remarks: Applicant is advised to obtain all ne _____ Certified Plot Plan
necessary permits from the Construction _____ Diagram
Official prior to construction.

Approved [Signature]
ZONING OFFICER

Date 5/1/96

If work is not started within 90 days, this permit is void.



I certify that the above described building will be built in accordance with the specifications and plans submitted with this application and that all information is correct.

[Signature]
Owner/Agent

NOTE: PERMEABILITY TEST PERFORMED
BY THE IN-PLACE & COMPACTED
SELECT FILL RESULTED IN:

3.0 HPT

FILED MAP NORTH

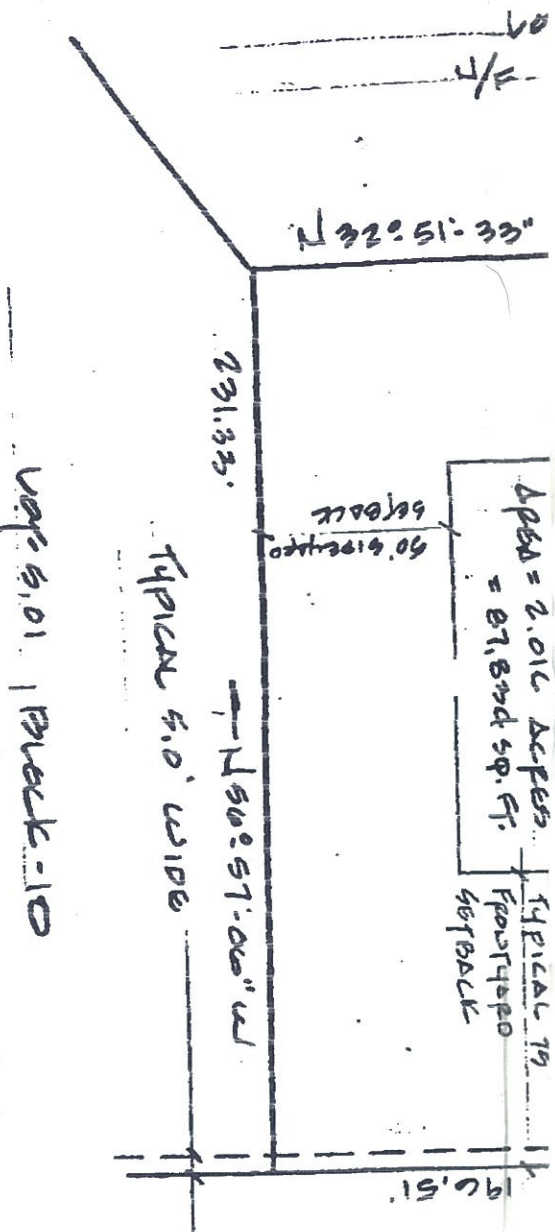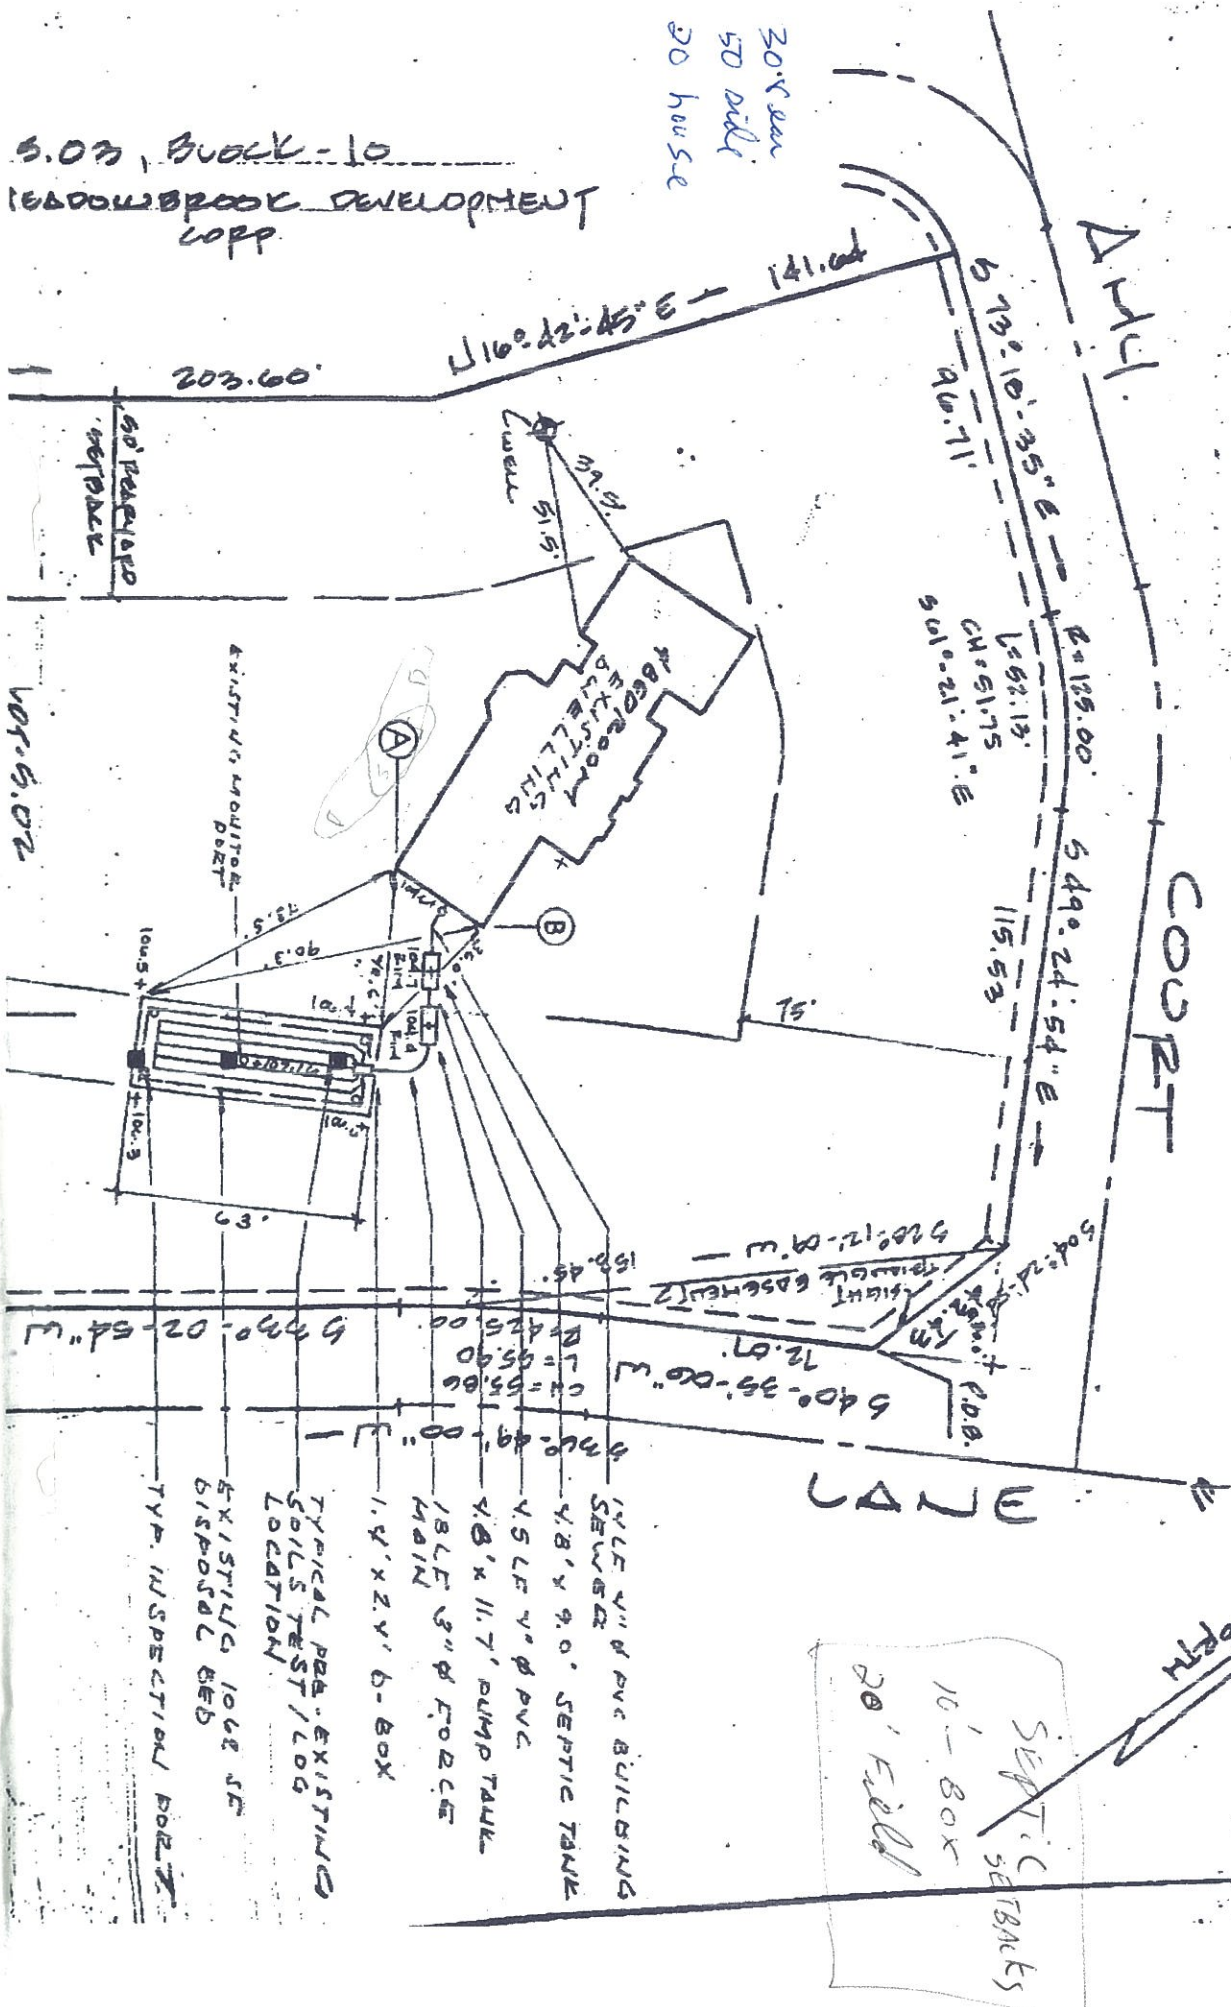

PATRICIA

2' minimum 11' from all components of septic system. 10' from system. 1' from 1\"/>

ASBUILT ELEVATIONS:

6\"/>

6\"/>

FRANK J. FALCONE N.J.L.L.S. NO. 32412, N.J.P.P. NO. 3760
PRINCETON JUNCTION ENGINEERING, P.C.
PROFESSIONAL ENGINEERS & LAND SURVEYORS
P.O. BOX 610 53 NORTH POST RD.
PRINCETON, JUNCTION, NEW JERSEY 08550
(609) 799 1906 (609) 799 1963

DISPOSAL SYSTEM ASBUILT
OF LOT 5.02, BLOCK-10, FOR
WASHINGTON MAJOR ESTATES, INC.

WASHINGTON Township, Mercer County, New Jersey


D. GEOFFREY BROWN
PROFESSIONAL ENGINEER &
LAND SURVEYOR #24327

4-26-95

ADJ.

COOPT

Filed Map North

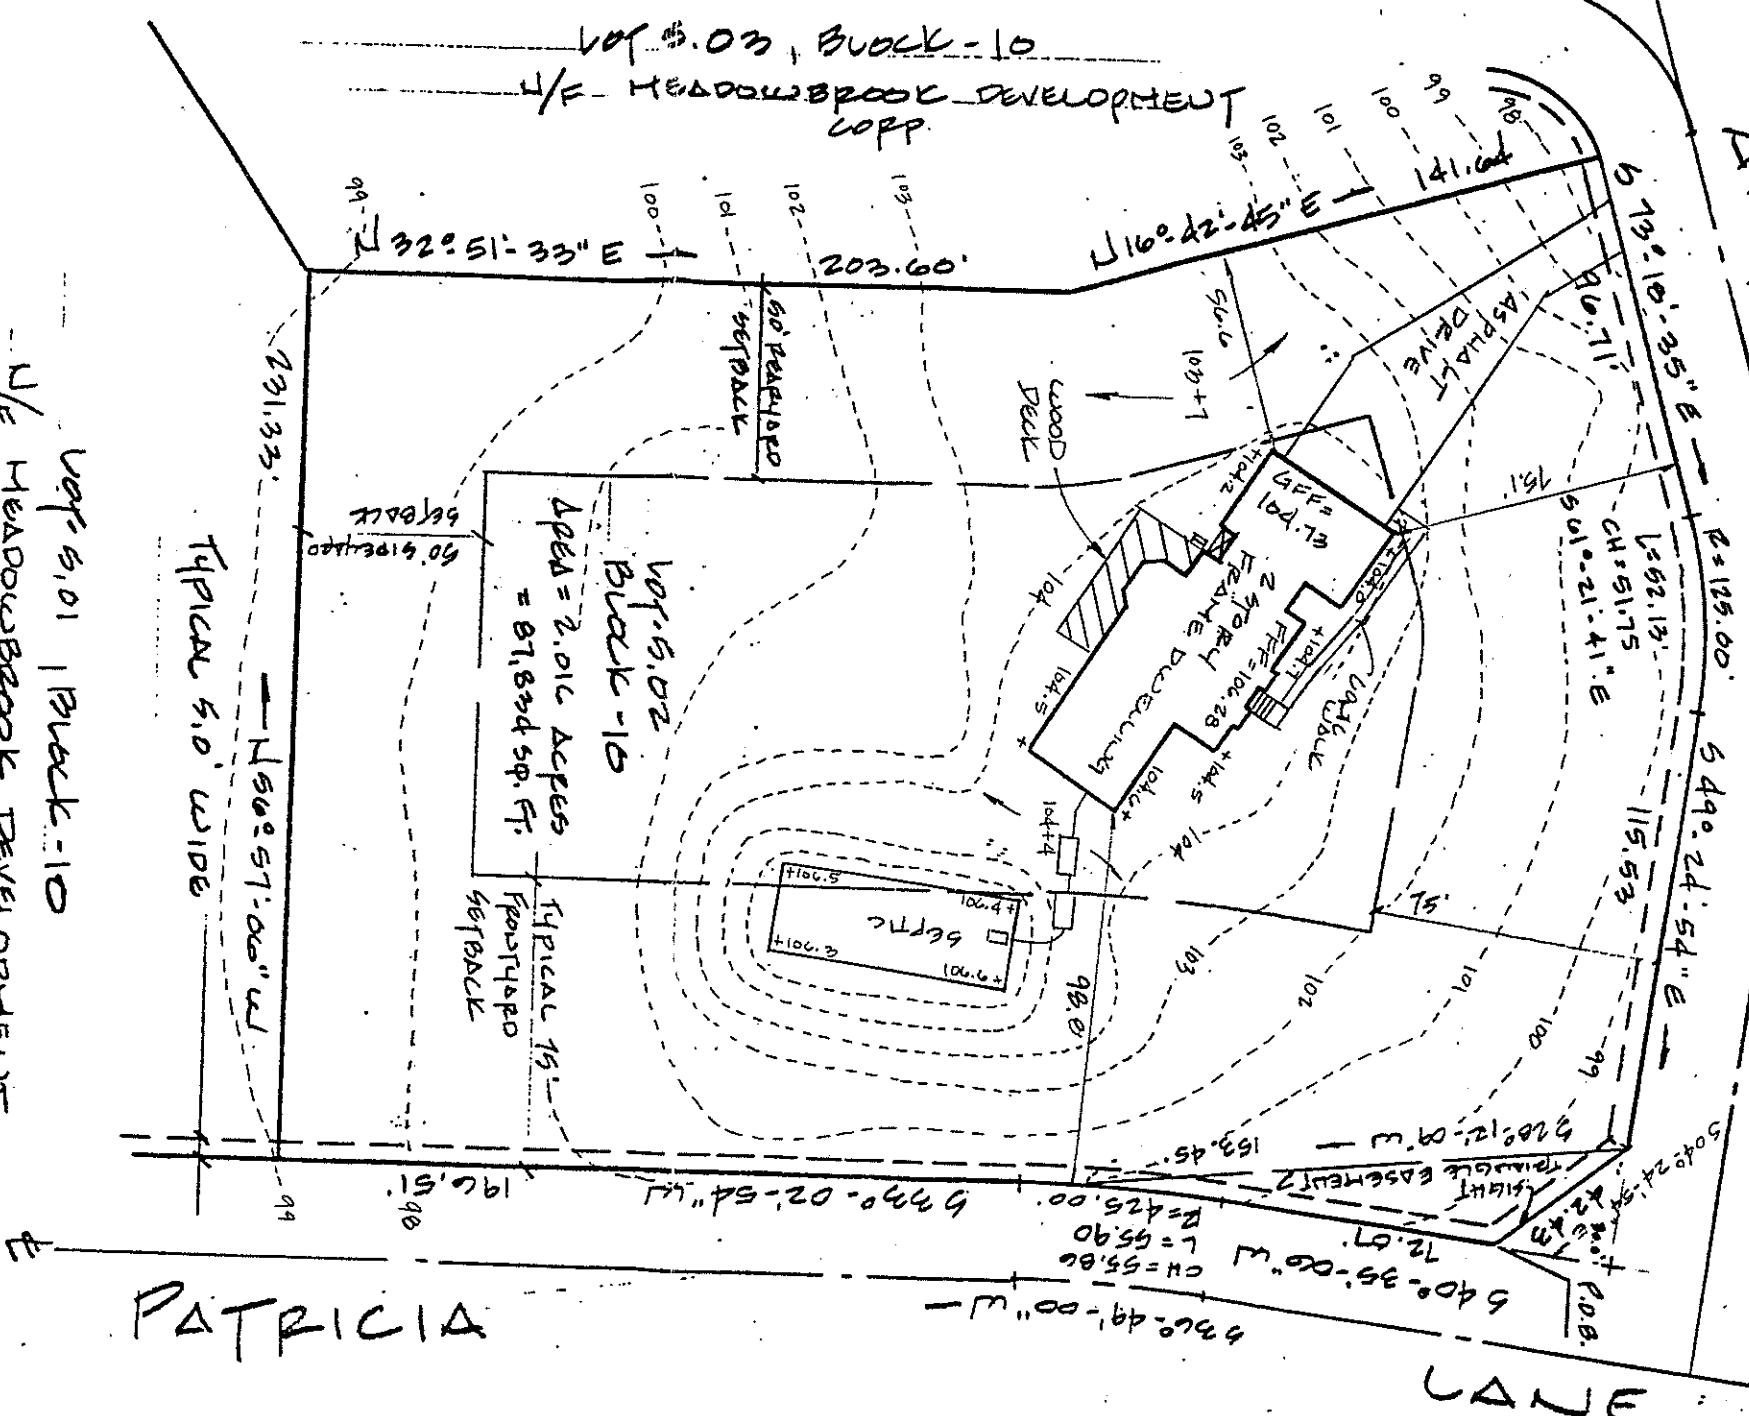

W/F HEDDOWBROOK DEVELOPMENT
COPT.

FRANK J. FALCONE N.J.L.L.S. NO. 32112, N.J.P.P. NO. 3760
PRINCETON JUNCTION ENGINEERING, P.C.
PROFESSIONAL ENGINEERS & LAND SURVEYORS
P.O. BOX 610 53 NORTH POST RD.
PRINCETON JUNCTION, NEW JERSEY 08550
(609) 799 1906
(609) 799 1963

FINAL ASBUILT SURVEY
OF W/F 5.02, Block-10, FOR
WASHINGTON TOWNSHIP ESTATES
SIGNED IN
WASHINGTON TOWNSHIP, Mercer County, New Jersey

D. COFFERT ANOMI
ARNOUD ROZE, JR.
WESLEY J. LAM
FRANK J. FALCONE
PETER EBERHART
ED. W. PROVINCIA
MARIN D. KATZ

P.E. L.S.
No. 21027 No. 13453
No. 12123 No. 12123
No. 12123 No. 12123
DATE 4/20/95

DRAWN
FJF
CHECK
FJF
REV.
SCALE
1"=50'

TOWNSHIP OF WASHINGTON
COUNTY OF MERCER
ZONING PERMIT

REFERENCE: LAND USE AND DEVELOPMENT CODE: Chapter 103

ZONING CASE NUMBER: 98-023

APPLICANT Anthony & Sylvan Pools

MAILING ADDRESS 350 Hwy. 9 North, Englishtown, NJ 07726

PHONE NUMBERS (Home) (Office) (732) 536-1010

LOT ADDRESS

BLOCK NO. 10 LOT NO. 5.02 PAGE NO.

ZONE

USE Construction of inground pool 26' x 42' with 4' chain link fence

APPROVED xxx DENIED

BACKGROUND/NOTATIONS/MODIFICATIONS REQUIRED/APPLICABLE CIRCUMSTANCES:

Applicant is advised to obtain all necessary permits from the Construction

Official prior to construction.

VARIANCE REQUIRED THROUGH THE ZONING BOARD OF ADJUSTMENT: ☐ YES ☒ NO

If YES is checked, contact the ADMINISTRATIVE OFFICER at (609) 259-7082 for information and application requirements.

TYPE OF VARIANCE REQUIRED: USE HARDSHIP

INTERPRETATION OR SPECIAL QUESTIONS

DATE 3/30/98

Detlev M. ...
ZONING OFFICER

APPLICATION FOR ZONING PERMIT
TOWNSHIP OF WASHINGTON
COUNTY OF MERCER

Anthony & Sylvan Pools

350 Hwy 9 North

Englishtown, N.J. 07726

1. Name of Applicant _____
2. Mailing Address of Applicant _____
English town, N.J. 07726
3. Home Phone Number _____
4. Office Phone Number _____
(732) 536-1018
5. Name and Address of Owner if different from Applicant _____
Cory Calet, Ashburnville
Cottage
6. Block No. 10 Lot No. 502 Page No. _____
7. Have the above premises been the subject of any prior application to the Zoning Board of Adjustment or Planning Board? If yes, please state which Board and when. _____

8. Dimensions of Principal Building _____
9. Dimensions of Accessory Building(s) _____

10. Please provide a brief description of the proposed project. Include dimensions of any proposed structures and proposed front, side and rear yard setbacks if applicable. Applications for fences should include height and type.

Amateur 26' x 43' in ground completely
pool - 3' x 8' depth - 14' chain link fence

Applicant must submit two (2) copies of a plan of sufficient accuracy to be used for the purpose of determining if the requirements of Chapter 103 Land Use and Development Ordinance have been met.

Applicant must also submit a \$15.00 Zoning Permit fee prior to the issuance of the permit.

I hereby certify that the information and exhibits submitted are true and correct to the best of my knowledge.

Ashley Summerville
(Signature of Applicant) 3/13/98
(Date)

*** DO NOT WRITE IN THIS SPACE ***

Zoning Permit No. 98-028

Fee Paid \$15.00

Date 3/17/98

Applicant is advised to obtain necessary permits from the Construction Official prior to construction.

Approved
F. Melis
3/30/98