


**Columbia**

SASH • DOORS • TRIM  
LUMBER • SPECIAL MILLWORK

**Lumber and Millwork Co.**

AS-BOLT-83-2 Blk 32

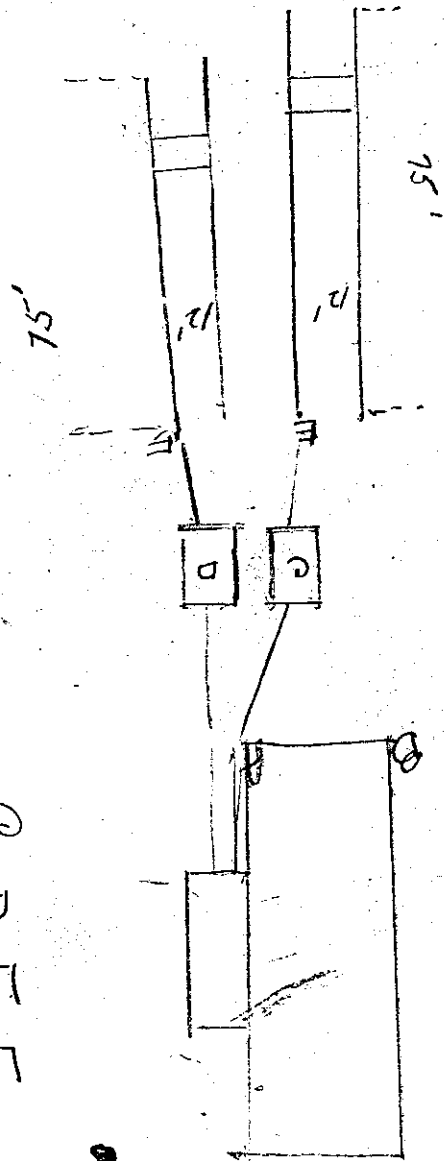

| A     |        | C D E F |       |
|-------|--------|---------|-------|
| 39.4' | 38     | 54'     | 60    |
| 36'   | 39.10' | 40      | 59.8' |

MAIN OFFICE & YARD  
MAPLE & SPRINGFIELD AVES.  
SPRINGFIELD, N.J.  
TELS. 376-5950 686-8600



BRANCH OFFICE & YARD  
COLUMBIA RD. OFF READINGTON RD.  
BRANCHBURG, N.J.  
722-8844