

HEALTH DEPT. APPROVAL REQUIRED FOR THE ISSUANCE OF CERTIFICATE OF OCCUPANCY

As built Septic design

Well Inspection report

Pump installation report

Water analysis report - bacterial

- chemical

The above information complies with all state and local ordinances required by this office.

Block 435 Lot 1

Owner Sagehen

Location Blue Spruce + Elm Ridge

*Record of above for
after 1 hour
water only required*

(date)

(date)

*3-27-85
3-28-85
NO3*

Jay L. [Signature]

*water results - valid
from Quality Control - first
test < 2.2
NO3 3.14 mg/l*

DWR-133M
5/06

STATE OF NEW JERSEY
DEPARTMENT OF ENVIRONMENTAL PROTECTION
TRENTON, NJ

43.24/41
2600059276

Mail To:
NJDEP
BUREAU OF WATER SYSTEMS
AND WELL PERMITTING
PO BOX 426
TRENTON, NJ 08625-0426

MONITORING WELL PERMIT

Permit No. _____

VALID ONLY AFTER APPROVAL BY THE D.E.P.

COORD #: 29.11.184

Owner George DeMartino
Address 2 Blue Spruce Drive
Pennington, NJ 08534
Name of Facility DeMartino Residence
Address 2 Blue Spruce Drive
Pennington, NJ 08534


Driller Environmental Management Associates, Inc.
Address 5303 Route 33/34
Farmingdale, NJ 07727

Diameter of Well(s)	2	Inches	Proposed Depth of Well(s)	20	Feet
# of Wells	1		Will pumping equipment be utilized?	YES ☐ NO ☐	
Applied for (max. 10)					
Type of Well (see reverse)	Monitoring		If Yes, give pump capacity		cumulative GPM


LOCATION OF WELL(S)

Lot #	Block #	Municipality	County
41	43-24	Highland Twp	Mersey

State Atlas Map No. 28

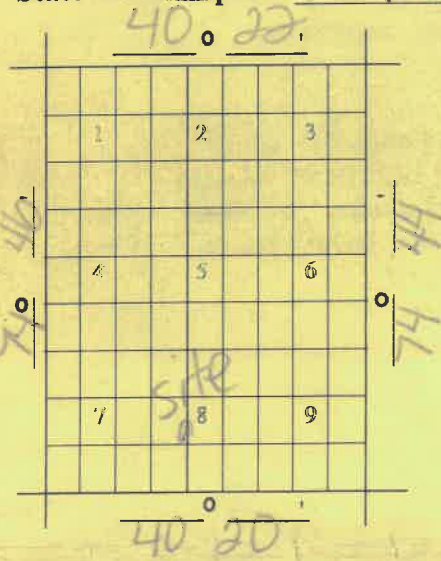

Draw sketch of well(s) nearest roads, buildings, etc. with marked distances in feet. Each well MUST be labeled with a name and/or number on the sketch.

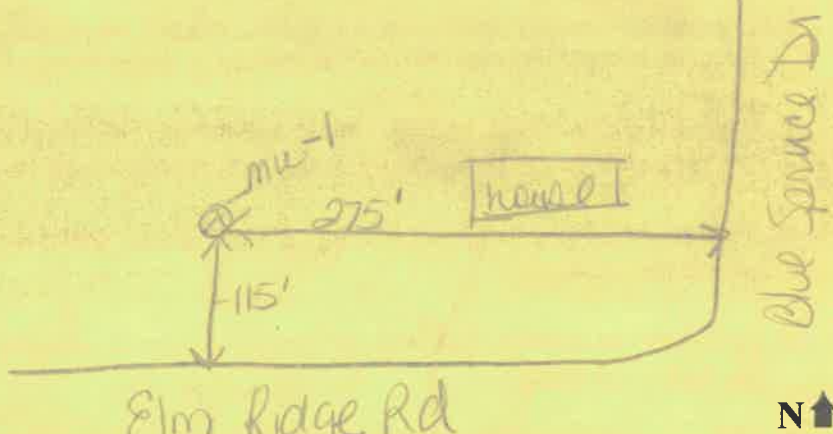

PROPOSED WELL LOCATION (NAD 83 HORIZONTAL DATUM)
NJ STATE PLANE COORDINATE IN US SURVEY FEET

NORTHING: _____ EASTING: _____
LATITUDE: _____ OR _____ LONGITUDE: _____

FOR MONITORING WELLS, RECOVERY WELLS, OR PIEZOMETERS, THE FOLLOWING MUST BE COMPLETED BY THE APPLICANT. PLEASE INDICATE WHY THE WELLS ARE BEING INSTALLED:

- ☐ RCRA Site ☐ Spill Site
☐ Underground Storage Tank Site ☐ ISRA Site
☐ Operational Ground Water Permit Site ☐ CERCLA (Superfund) Site
☐ Pretreatment and Residuals Site
☐ Water and Hazardous Waste Enforcement Case
☐ Water Supply Aquifer Test Observation Well
☐ Other (explain) _____

CASE I.D. Number

00-01-05-0940-416

This Space for Approval Stamp

WELL PERMIT APPROVED
N.J. D.E.P.

MAR 26 2006

BUREAU OF WATER SYSTEMS

FOR D.E.P. USE ☐ Issuance of this permit is subject to the conditions attached. (see next page) ☒ For monitoring purposes only

SEE REVERSE SIDE FOR IMPORTANT PROVISIONS PERTAINING TO THIS PERMIT.

In compliance with N.J.S.A.58:4A-14, application is made for a permit to drill a well as described above.

Date 3/18/08 Signature of Driller [Signature] Registration No. 1-22211
Signature of Property Owner [Signature]

COPIES: Water Systems & Well Permitting - White Health Dept. - Yellow Owner - Blue Driller - White