


COMMUNITY PANEL NO. 340097 00038, 3 OF 10
 ZONE "A" (UNDETERMINED)
 HAZ FLOOD ELEV. = 62.00 (AS PER TOWN...)
 LOWEST FLOOR ELEVATION = 78.24

NOTE:

1. PROPERTY CORNERS NOT SET AS PER WRITTEN CONTRACTUAL AGREEMENT WITH CLIENT.
2. UTILITIES NOT ASBUILT AT TIME OF SURVEY.

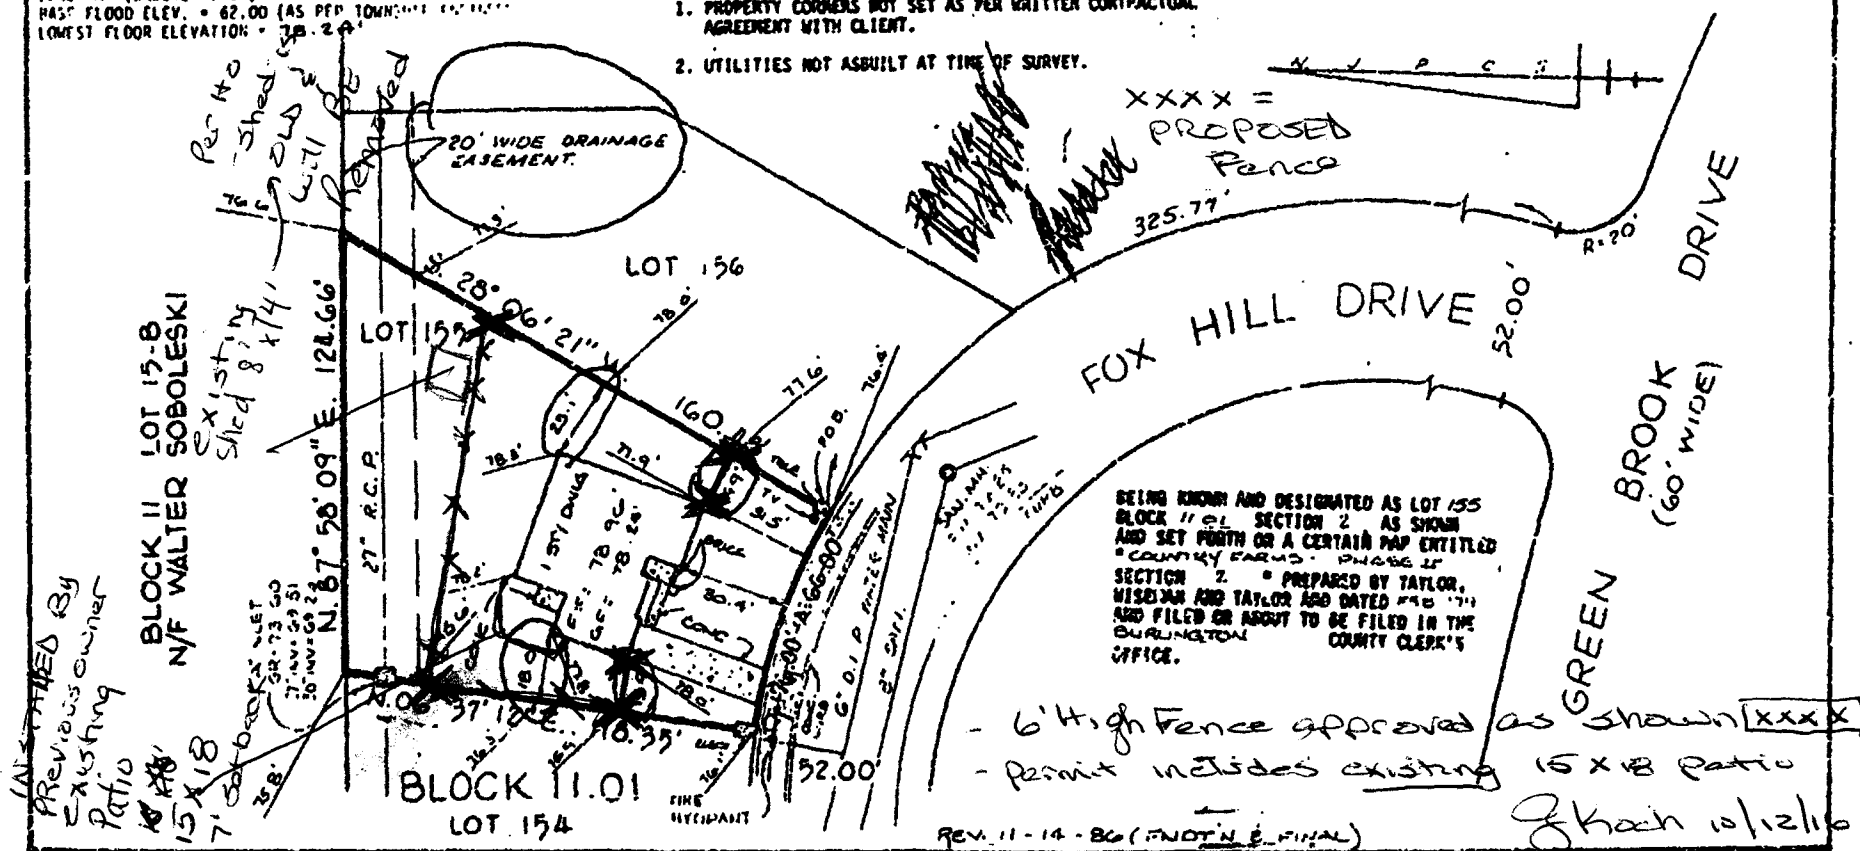

CERTIFIED TO: JAMES AND MICHELE BRUNO,
 COUNTY ABSTRACT COMPANY,
 AND SEARS MORTGAGE COMPANY.

IN CONSIDERATION OF THE FEE PAID FOR MAKING THIS SURVEY,
 I HEREBY CERTIFY TO ITS ACCURACY (EXCEPT SUCH EASEMENTS,
 IF ANY, THAT MAY BE LOCATED BELOW THE SURFACE OF THE LANDS
 OR ON THE SURFACE OF THE LANDS AND NOT VISIBLE) AS AN
 INDUCEMENT FOR ANY INSUROR OF TITLE TO INSURE THE TITLE TO
 THE LANDS AND PREMISES SHOWN THEREON.

John T. Butler
 N.J. LAND SURVEYOR LICENSE NO. 23338

JOHN T. BUTLER

BLDG TIES TO FNDTN

COUNTRY FARMS

PHASE II
 SURVEY OF LOT 155, BLOCK 11.01 SECTION 2
 EVESHAM TOWNSHIP
 BURLINGTON COUNTY, NEW JERSEY

TAYLOR • WISEMAN & TAYLOR
 CONSULTING ENGINEERS • SURVEYORS
 PLANNERS • LANDSCAPE ARCHITECTS
 306 FELLOWSHIP ROAD, MOUNT LAUREL, N.J. 08054

DATE: 5-20-86

SCALE 1" = 50'

DRAWING NO
 16174