

✓ BLOCK 1158.15 LOT 5, 6, 7, 8 ADDRESS (SITE) 2 BEDFORD AVE. PERMIT NO. 2204-93

RECEIVED

SEP 14 1993

Applicant Completes: Sections I, II, III (optional), IV, VI and VII

DIV. OF IDENTIFICATION



CONSTRUCTION PERMIT
APPLICATION

1. Proposed Work-site at: INSTALL PRE BUILT WOODEN SHED. Cur
2. Name of Owner in Fee: FRANK A. TALLARIDA
Address 2 BEDFORD AVE. BRICK NJ 08124
street municipality zip code
3. Ownership in Fee: Public _____ Private ☒
4. Principal Contractor: _____ Tel. (____) _____
Address _____
License No. OR, if new home, Builder Reg. No. _____ Exp. Date _____
Federal Emp. No. _____ Social Security No. _____
5. Architect or Engineer _____ Tel. (____) _____
Address _____
6. Responsible Person In Charge of Work FRANK A. TALLARIDA

V. FEE SUMMARY (for office use only)

		Update	Update
1. Building	\$ <u>8-</u>		
2. Electrical			
3. Plumbing			
4. Fire Protection			
5. Other			
6. Subtotal	\$ <u>8-</u>		
7. Less 20% for State Plan Review	<u>5-</u>		
8. Subtotal	\$		
9. DCA Training Fee			
10. Subtotal	\$		
11. Cert. of Occupancy	<u>20-</u>		
12. Other			
13. TOTAL	\$ <u>33</u>		

VI. BUILDING/SITE CHARACTERISTICS

1. Number of Stories 1
2. Height of Structure 7 ft.
3. Area—Largest Floor 128 sq. ft.
4. Building Area—All Floors 128 sq. ft.
5. Volume of Structure 896 cu. ft.
6. Construction Classification STORAGE SHED
7. Total Land Area Disturbed 0 sq. ft.
8. Flood Hazard Zone _____
Elevation _____ ft.
es _____ sq. ft.
o _____
12. Max. Live Load _____
13. Max. Occupancy Load _____

II. PROPOSED WORK

1. ☒ Minor Work (single trade)
2. ☐ Small Job (\$5,000 and no prior approvals)
3. ☐ New Building
4. ☐ Addition
5. ☐ Alteration
6. ☐ Fire Protection
7. ☐ Plumbing
8. ☐ Electrical
9. ☐ Asbestos Abatement
10. ☐ Demolition

Est. Cost

\$400.00

TOTAL COSTS

\$400.00

OPTIONAL (for office use only)

Plans Rec'd By	Date Rec'd	Rejection Date	Approval Date	Re-viewer	Resubmission Dates Approval	Rejection	Re-viewer
<u>JJ</u>			<u>9/14/93</u>	<u>9/14/93</u>	<u>10/26/93</u>		<u>JJ</u>
<u>Py</u>	<u>9/15/93</u>	<u>ENH</u>					

III. DO YOU WANT: (optional) 1. ☐ Partial Releases 2. ☐ Prototype Processing

IV. DOES OR WILL YOUR BUILDING CONTAIN ANY OF THE FOLLOWING?

1. ☐ Elevators/Escalators/Lifts/Dumbwaiters/Moving Walks
2. ☐ High Pressure Boilers
3. ☐ Pressure Vessels
4. ☐ Refrigeration Systems
5. ☐ Cross-Connections/Backflow Preventers
6. ☐ Hazardous Uses/Places of Assembly
7. ☐ Sprinklers
8. ☐ Smoke Control Systems in Open Wells
9. ☐ Underground Storage Tanks

VII. DESCRIPTION OF BUILDING USE

A. RESIDENTIAL

1. ☐ Hotels (R-1)
2. ☐ Multi-Family (R-2)
3. ☐ Two-Family (R-3) BOCA
4. ☐ Two-Family (R-4) CABO
5. ☒ One-Family (R-3) BOCA
6. ☐ One-Family (R-4) CABO
No of dwelling units:
Before Construction _____
After Construction _____
Net gain or loss _____

B. NON-RESIDENTIAL

1. State Specific Use:
2. Use Group:
3. Change in Use Group, Indicate Former:

LDS BR 10213939

20K

CERTIFICATION IN LIEU OF OATH

I. OWNER SECTION (to be completed if the applicant is the owner in fee)

I hereby certify that I am the owner in fee of the property listed on Page 1.

Mark the following applicable boxes:

- A. ☐ I further certify that a new home (private residence) will be constructed on this property for my own use and occupancy. This dwelling is to be occupied by myself and is not to be used for any purpose other than single family residential use. I attest that all construction, plumbing, or electrical work will be done, in whole or in part, by me or by subcontractors under my supervision, in accordance with all applicable laws; and, I further acknowledge that said new home is not covered under the New Home Warranty and Builders Registration Act (N.J.S.A. 46:3B-1 et seq.) and that such fact shall be disclosed to any person purchasing this property within ten years of the date of issuance of a certificate of occupancy.

I UNDERSTAND THAT IN MARKING BOX A, I ACKNOWLEDGE THAT I AM ASSUMING RESPONSIBILITY FOR THE WORK DONE ON SAID PROPERTY, THE CONDITION OF THE PROPERTY PRIOR TO, DURING, AND AFTER ANY WORK PERFORMED, AND FOR THE PERFORMANCE OF THE SUBCONTRACTORS I HIRE, EMPLOY, OR OTHERWISE CONTRACT OR WITH WHOM I MAKE AGREEMENTS TO PERFORM WORK. I AM VOLUNTARILY AND KNOWINGLY ASSUMING THIS RESPONSIBILITY.

- B. ☐ I further certify the following as required by the New Jersey Uniform Construction Code, N.J.A.C. 5:23-2.15(e)1.vii:

I personally prepared the plans submitted for: 1) the new home referred to in A.; or, 2) an addition, alteration, renovation, or repair to an existing single family residence owned and occupied by myself and located on the property listed on Page 1; or, 3) a new structure that will be physically separate from, but that will be deemed part of, an existing single family residence that is owned and occupied by myself and located on the property listed on Page 1.

- C. ☐ I further certify that I will perform or supervise the following work:

C.1. ☐ Building C.2. ☐ Fire Protection

I further certify that I will perform the following work:

C.3. ☐ Electrical C.4. ☐ Plumbing

- D. ☐ I agree to advise all contractors on this project that they are required to be registered with the New Jersey Division of Taxation and to comply with all New Jersey tax laws.

I further certify the following as required by the Uniform Construction Code, N.J.A.C. 5:23-2.15(a)5: All required State, county, and local prior approvals have been given, including such certification as the construction official may require.

I understand that if any of the above statements are willfully false, I am subject to punishment.

Signature Amelia Tallarida Date 9-14-93

II. AGENT SECTION

(to be completed if the applicant is not the owner in fee)

I hereby certify the following as required by the New Jersey Uniform Construction Code, N.J.A.C. 5:32-2.15(d): the proposed work is authorized by the owner in fee; and I have been authorized by the owner in fee to make this application as his agent.

I further certify the following as required by the Uniform Construction Code, N.J.A.C. 5:23-2.15(a)5: All required State, county, and local prior approvals have been given, including such certification as the construction official may require.

I agree to advise all contractors on this project that they are required to be registered with the New Jersey Division of Taxation and to comply with all New Jersey tax laws.

I understand that if any of the above statements are willfully false, I am subject to punishment.

☐ Check if contractor.

Agent Name _____

Address _____

Telephone (_____) _____

Signature _____ Date _____

OFFICE DATE RECEIVED: _____

COMMENTS

IMPORTANT
A.H.B.T. - EXEMPT

NP 9-15-93

VIII. PRIOR APPROVALS CHECKLIST (office use only)	LOCAL APPROVAL		COUNTY APPROVAL		REGIONAL APPROVAL		STATE APPROVAL	
	Prelim. Initial	Final Date	Prelim. Initial	Final Date	Prelim. Initial	Final Date	Prelim. Initial	Final Date
☐ Planning Board								
☐ Zoning Board								
☐ Sewer Authority								
☐ Water Authority								
☐ Fire Department								
☐ Police Department								
☐ Health Department								
☐ Soil Conservation								
☐ N.J. Dept. of Community Affairs								
☐ N.J. Department of Transportation								
☐ N.J. Dept. of Environmental Protect.								
☐ Utility Dig No.								
☒ Other <i>ins</i>	<i>JK</i>	<i>9/14/93</i>	<i>SK</i>					
☐								
☐								

IX. SUBCODES AND SPECIAL REGULATIONS APPLICABLE (office use only—optional)

Name of Code & Edition

Name of Code & Edition

Other

Building _____
 Electrical _____
 Plumbing _____
 Fire Protection _____
 Mechanical _____

Energy _____
 Barrier Free _____
 Flood Hazard _____
 As Built Elevation Cert. _____
 Other _____

X. CERTIFICATES ISSUED (office use only)

- ☐ Temporary Certificate of Occupancy
- ☐ Temporary Certificate of Occupancy
- ☐ Continued Certificate of Occupancy
- ☐ Certificate of Occupancy
- ☐ Certificate of Approval

No. _____
 No. _____
DATE EXPIRED



CONSTRUCTION PERMIT

Date Issued

Control #

Permit #

9/20/93
2204-93IDENTIFICATION Block 1158.15 Lot 5-8Work Site Location 2 Bedford Ave.

Contractor

Owner in Fee

Address

Address

Tele. ()

Lic. No. or Bids. Reg. No.

Exp. Date

Tele. ()

Federal Emp. No.

or Social Security No.

is hereby granted permission to perform the following work:

[☒] BUILDING [] PLUMBING [] OTHER
[] ELECTRICAL [] FIRE PROTECTION


DESCRIPTION OF WORK:

NOTE: If construction does not commence within one (1) year of date of issuance, or if construction ceases for a period of six (6) months, this permit is void.

Estimated Cost of Work \$

PAYMENTS (Office Use Only)

Building	<u>8</u>	2204##	
Plumbing	<u>BLK</u>		1.00
Electrical	<u>1158 #</u>		
Fire Protection	<u>LOT</u>		1.00
Other	<u>5-5 #</u>		
Other	<u>BUILDING</u>		1.00
DCA Training Fee	<u>2 PLAN RW</u>		5.00
Cert. of Occ.	<u>C / D</u>		20.00
Other	<u>TOTAL</u>		33.00
Total	<u>3 CHECK</u>		33.00
Check No.	<u># 300002</u>		1.00
Cash			
Collected By	<u>NO 7.8</u>	<u>0030005</u>	12.11

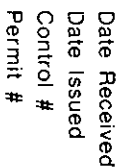

9/20/93
2204-93

Block 1158-15 Lot 5, 6, 7, 8
Work Site Location 2 B&D Ford Ave

Owner in Fee FRANK A. TALLARIDA
Address 2 BEDFORD AVE

Tele. (

Contractor	
Address	

Tele () _____
 Lic. No. or Bids. Reg. No. _____
 Federal Emp. No. _____ or Social Security No. _____

JOB SUMMARY (Office Use Only)

PLAN REVIEW		Date	Initial	INSPECTIONS	Dates (Month/Day)		Initial
☒	No Plans Req.	9/14/93	AL	Type: Footing	Failure	Failure	Approval
☒	All				Not Renda	9/23/93	
☐	Footing						
☐	Foundation						
☐	Frame						
☐	Other						
Joint Plan Review Required:							
☐	Elec.	☐	Plumb.	☐	Fire		
SUBCODE APPROVAL							
☐	CO	☐	CCO	CA	93		
Date:	9/16/93						
Approved By:	[Signature]						

B. BUILDING CHARACTERISTICS

Use Group	Present	Proposed	Est. Cost of Bldg.	Work
Constr. Class	Present	Proposed	1. New Bldg.	\$ <u>400.00</u>
No. of Stories	<u>1</u>		2. Alteration	\$ <u>—</u>
Height of Structure	<u>7</u>		3. Total (1+2)	\$ <u>400.00</u>
Height of Structure				
Area—Largest Floor	<u>128</u>			
Total Bldg. Area/All Floors	<u>128</u>			
Volume of Structure	<u>896</u>			
Total Land Area Disturbed	<u>0</u>			

C. CERTIFICATION IN LIEU OF OATH

I hereby certify that I am the (agent of) owner of record and am authorized to make this application.

Signature Frank A. Vallante

D. TECHNICAL SITE DATA

INSTALL A PRE-BUILT 8'X16'
WOODEN SHED.

(Office Use Only)

TYPE OF WORK: ☒ New Building

☐ Addition

☐ Alteration

☐ Roofing

☐ Siding

☐ Other _____

☐ Demolition

☒ Miscellaneous

☐ Fence _____ Height _____

☐ Sign _____ Sq. Ft. _____

☐ Pool

☐ Elevator

☐ Asbestos Abatement

☐ Other SHED, WOODEN


\$ _____

FEE _____

Administrative Surcharge	\$	_____
Paid [] Check #	\$	_____
Minimum Fee	\$	_____
Collected by: _____	TOTAL FEE	\$ _____

ANCHORING METHOD (ALL 4 CORNERS)

SHED IS ANCHORED TO EARTH
BY A VERTICAL P.T. 2x4,
LAG BOLTED TO THE FLOOR
FRAMING HEADER & BURIED
IN A HOLE 32" DEEP W/ AN
8" CONCRETE FOOTING

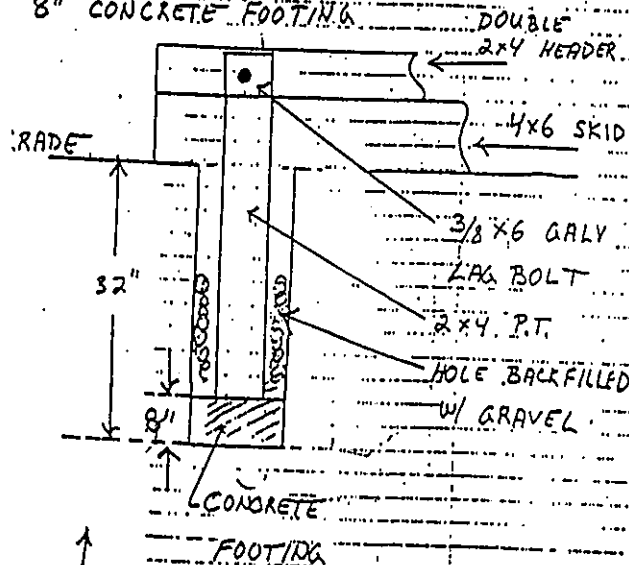


✓ this one

*Revised
9/16/93
all*

SHED ISOMETRIC

NO SCALE

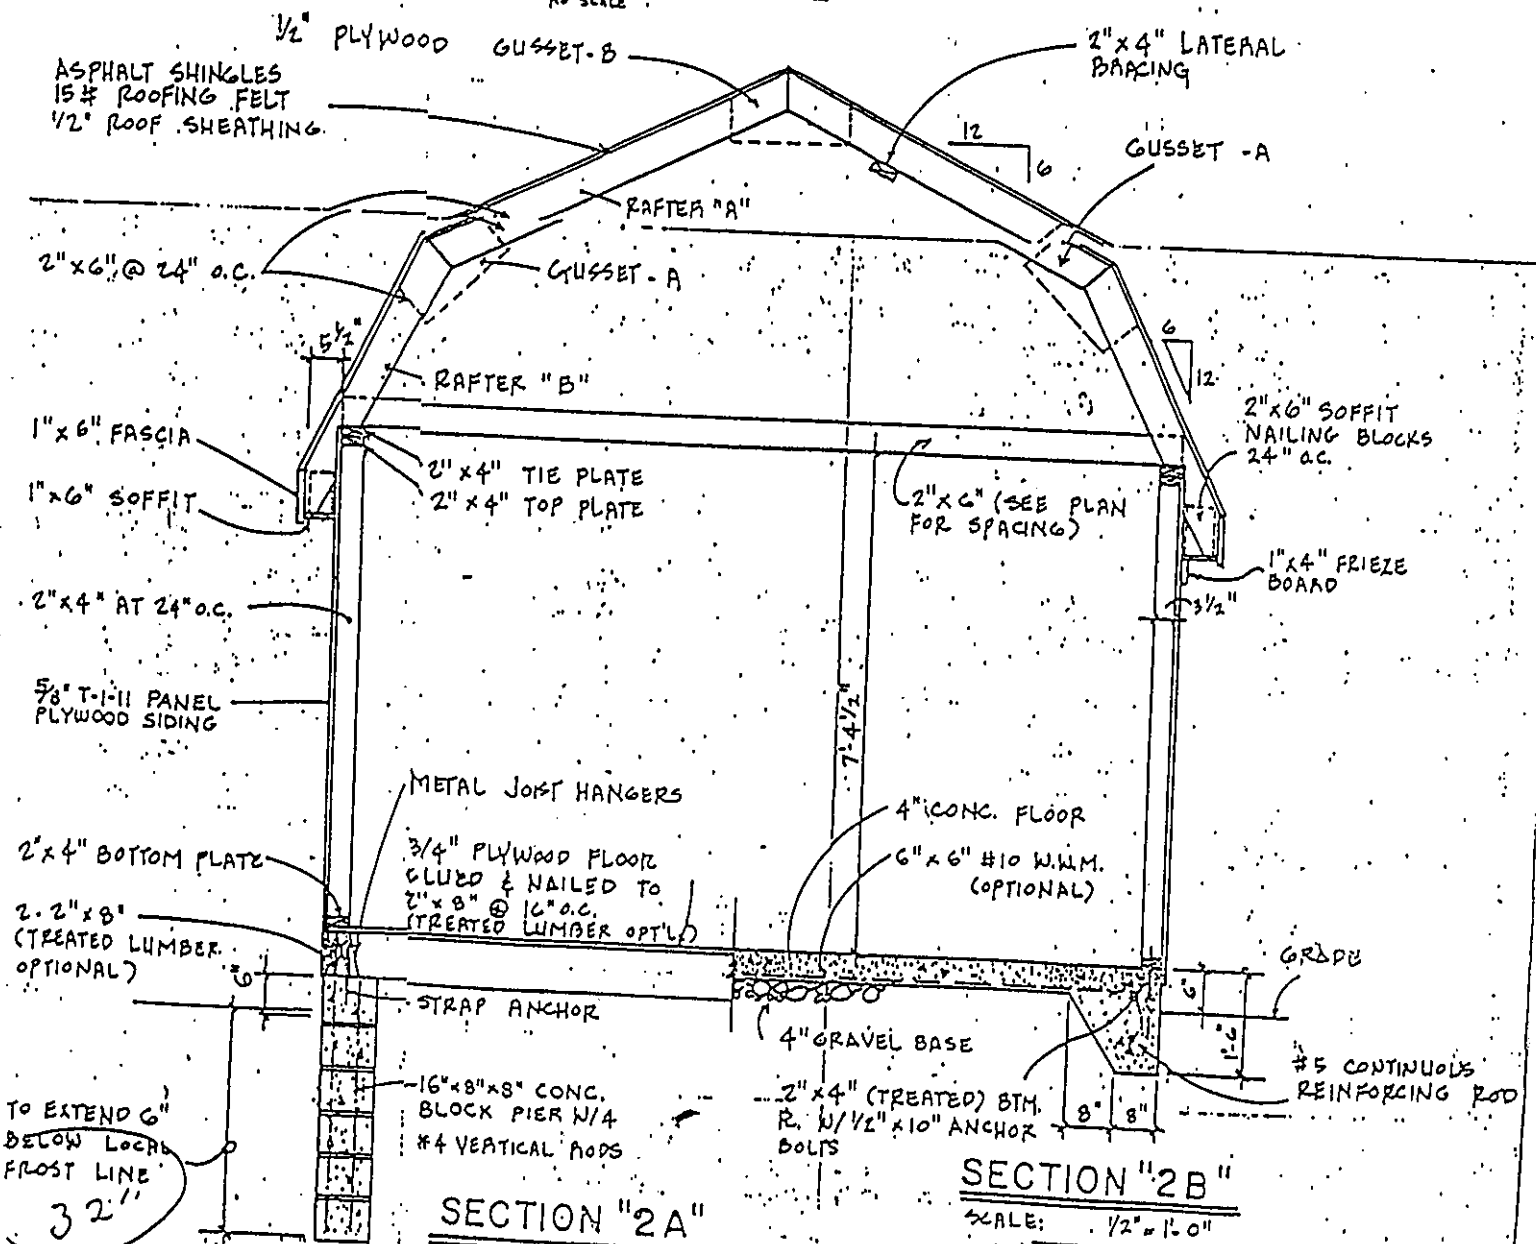


9/85

B-2042

SHEET 2
TOTAL 5

FILED MAP
BEDFORD AVENUE
(BRENTWOOD AVENUE)
(40' R.O.W.)

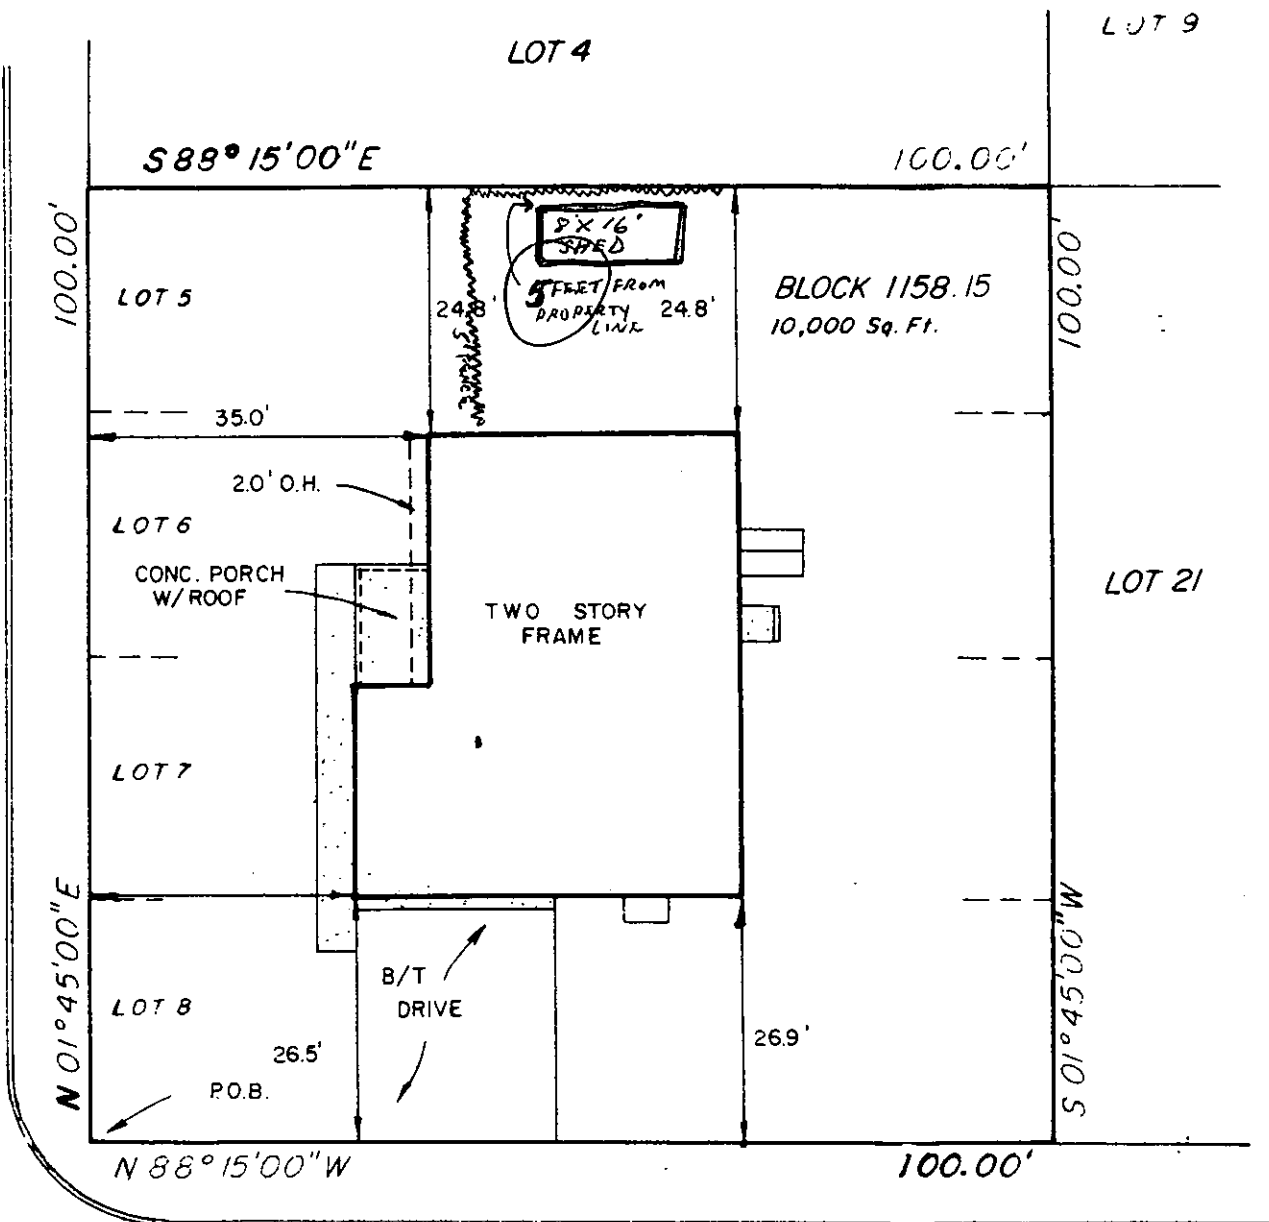

ALBERT CUCCI DRIVE
(FORMERLY LAKEWOOD AV.)
(40' R.O.W.)

CERTIFIED TO:

FRANK A. TALLARIDA AND AMELIA S. TALLARIDA, H/W
THE DIME REAL ESTATE SERVICES-NEW JERSEY, INC.
TRIDENT ABSTRACT COMPANY
SHARKEY AND SACKS, ESQ.

SURVEY NOTE

1. ALSO BEING KNOWN AS LOTS 5, 6, 7
AND 8 IN BLOCK 9, AS SHOWN ON
THE MAP ENTITLED LAKEWOOD GARDENS
SUBDIVISION "C" OCEAN COUNTY, NEW
JERSEY, AND FILED AS MAP NO. 8-71 ON
DEC. 19, 1910.

NOTE:
NO PROPERTY CORNERS REQUESTED

TAX MAP SHEET 60A

APPROVED FOR RECORDING ONLY
CEAN KINNEY, RECORDING OFFICER
DATE 9/14/93
Shed

SURVEY OF
LOTS 5, 6, 7, 8, BLOCK 1158.15
TOWNSHIP OF BRICK
OCEAN COUNTY, NEW JERSEY

Charles W. Thomas
CHARLES W. THOMAS P.L.S. # 27495
P.P. # 03188

SCHOOR, DePALMA & GILLEN, INC.
(a member of the Schoor Engineering Group)

CONSULTING & MUNICIPAL ENGINEERS • (201) 840-1700
1466 ROUTE NO. 88 WEST • BRICK, NEW JERSEY 08723

DATE SEPT. 8, 1986 REVISIONS FINAL SURVEY ORDER NO. E.J.H.

SCALE 1" = 20' DATE AUGUST 5, 1985 DRAWN BY E.J.H. CHECK'D BY C.W.T. FILE NO. 584014 FIELD BK. 252