

Brick

Permit Without a Jacket

Permit Number_____

LDS BR 10309654

Construction Permit # 231

2/18/1988

Owner Batullo, Robert G.

Location 990 Cedarbridge Ave.

Block 469 Lot 12

Contractor All-Lite Sign

Fee \$ 90.00 Use Sign

BUILDING SUB-CODE INSPECTIONS

VIOLATIONS

Footing/Trench

Foundation

Slab

Sheathing

Framing

Insulation

Sheet Rock

Plumbing

Fire Inspection

Final

C.O. Issued

PLUMBING SUB-CODE INSPECTIONS

Slab

Rough

Septic/Sewer

Water

Final

Electrical Final

Use reverse side for additional remarks

RECEIVED

FEB 18 REC'D

CONSTRUCTION PERMIT APPLICATION
BRICK TOWNSHIP, NEW JERSEY

BUILDING

IMPORTANT — Complete ALL items. Mark boxes where applicable

1. LOCATION OF BUILDING	Number and street	Section	Lot	Block
	990 Cedar Bridge Ave		12	469
	N S	N S		
	E W side offeet E W from intersection of			
	(Other local geographic, political, or legal subdivision identification)			

II. TYPE AND COST OF BUILDING — All applicants complete Parts A - D

A. TYPE OF IMPROVEMENT

- 1 ☐ New buildings
- 2 ☐ Addition (If residential, enter number of new housing units added, if any, in Part D, 13)
- 3 ☐ Alteration (See 2 above)
- 4 ☐ Repair, replacement
- 5 ☐ Demolition
- 6 ☐ Moving (relocation)
- 7 ☐ Garage
 - ☐ Swim Pool ☐ in ☐ out
 - ☐ Fence

D. PROPOSED USE — For "Wrecking" most recent use

Residential

- 12 ☐ One family
- 13 ☐ Two or more family — Enter number of units
- 14 ☐ Transient hotel, motel, or dormitory — Enter number of units
- 15 ☐ Garage
- 16 ☐ Carport
- 17 ☐ Other — Specify

Nonresidential

- 18 ☐ Amusement, recreational
- 19 ☐ Church, other religious
- 20 ☐ Industrial
- 21 ☐ Parking garage
- 22 ☐ Service station, repair garage
- 23 ☐ Hospital, institutional
- 24 ☐ Office, bank, professional
- 25 ☐ Public utility
- 26 ☐ School, library, other educational
- 27 ☒ Stores, mercantile
- 28 ☐ Tanks, towers
- 29 ☐ Other - Specify

B. OWNERSHIP

- 8 ☐ Private (Individual, corporation, nonprofit institution, etc.)
- 9 ☐ Public (Federal, State, or local government)

C. COST

- 10: Cost of Improvement \$ 5,500.
- To be installed but not included in the above cost
- a. Electrical (# Fixtures, Outlets)
- b. Plumbing (# of Fixtures)
- c. Heating, air conditioning
- d. Other (elevator, etc.)

(Omit cents)

\$ 5,500.

Nonresidential — Describe in detail proposed use of buildings, e.g., food processing plant, machine shop, laundry building at hospital, elementary school, secondary school, college, parochial school, parking garage for department store, rental office building, office building at industrial plant. If use of existing building is being changed, enter proposed use.

Towne Hall Shops

11. TOTAL COST OF IMPROVEMENT \$ 5,500.00.

III. SELECTED CHARACTERISTICS OF BUILDING —

For new buildings and additions, complete Parts E - I; for wrecking, complete only Part H, for all others skip to IV.

E. PRINCIPAL TYPE OF FRAME ☐ Masonry (wall bearing) ☐ Wood frame ☐ Structural steel ☐ Reinforced concrete ☐ Other - Specify	H. DIMENSIONS Number of stories Total square feet of floor area, all floors, based on exterior dimensions Total land area, sq. ft.	FEE COMPUTATIONS VOLUME OF BUILDING 5794 9054 BUILDING SUB CODE ELECTRICAL CODE PLUMBING CODE PLAN REVIEW CERTIFICATE OF OCCUPANCY STATE TRAINING FUND CONSTRUCTION CK 90 PERMIT FEE #731 190
F. TYPE OF HEATING SYSTEM Specify Air Cond. Yes ☐ No ☐	1. RESIDENTIAL BUILDING ONLY Number of bedrooms Number of bathrooms { Full Partial	
G. TYPE OF SEWERAGE DISPOSAL ☐ Public ☐ Individual		

SEE REVERSE

SUB CONTRACTORS

NAME	TRADE	ADDRESS	ZIP CODE	PHONE #
1.				
2.				
3.				
4.				
5.				
6.				
7.				
8.				

PERSON TO BE IN CHARGE OF CONSTRUCTION

NAME

ALL-LITE SIGN

ADDRESS

P.O. Box 1320 Toms River NJ 08754

IV. IDENTIFICATION — To be completed by all applicants

Name	Mailing address — Number, street, city, and State	ZIP code	Tel. No.
1. Owner Agent Robert G. Battillo	15 N. Gateway Toms River NJ	08753	341-8733
2. Contractor			
3. Architects			

The owner of this building and the undersigned agree to conform to all applicable laws of Township of Brick and that all required state, county and local prior approvals have been given.

Signature of applicant

Robert G. Battillo

Address

15 N. Gateway Toms River

Application date

2/18/88

DO NOT WRITE IN THIS SPACE — FOR OFFICE USE ONLY

Approved by

J. King

Date permit issued


2-18-88

Permit Number


I agree to construct said building in conformity with the plans and specifications filed with the Construction Official and in compliance with the provisions of the Building Code whether shown on plans or not.

FACADE - 56'3" x 11' = 618.75 sq ft x 15% = 92.81 sq ft. *See permit*

SIGNAGE: LOGO = 38" x 21" = 6 sq ft
 LTRS. = 2' x 42' = 84 sq ft
90 sq TOTAL
 90 < 92.81
 OK.

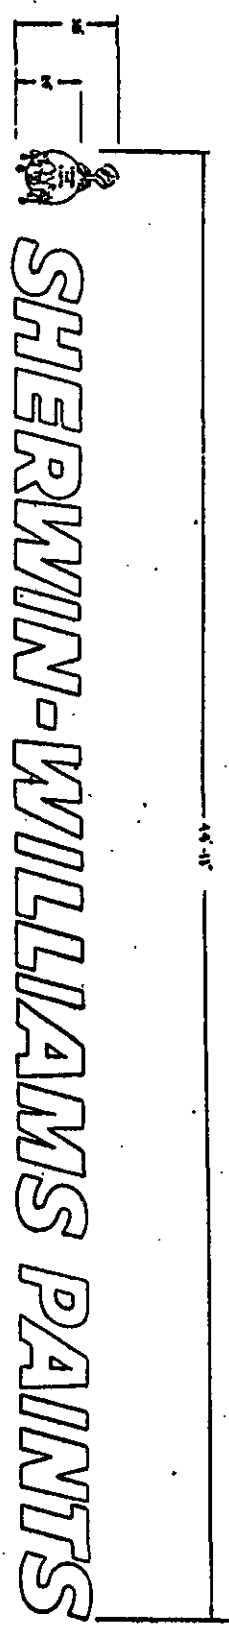

RECEIVED
 DEC 2 1987

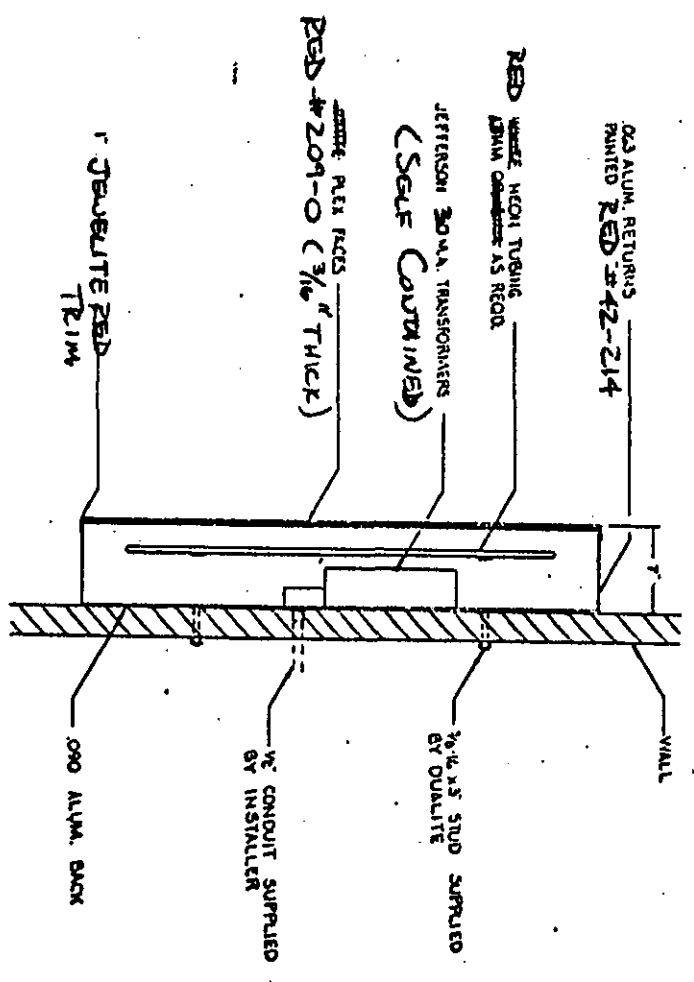

FOR: Sherwin Williams Co. #5035
 Towne Hall Shoppes
 Brick Blvd. - Cedar Ridge
 Bricktown, New Jersey

(3) 110' x 20' x 20' CONG. CIRCUITS ROAD

REV	DATE	DESCRIPTION
1		DUALITE, INC. - WILLIAMSBURG, OH.
2		PROPOSED FOR PROPOSAL ONLY
3		REDA 24' INDIVIDUAL NEON LETTERS
4		REDA NOTED
5		DATE DEC 1, 1987
6		DRAWN BY E.H. Giff
7		SHEET NO 2
8		DRAWING NO 3653

FACADE - 56'3" x 11' = 618.75 sq ft x 15% = 92.81 sq ft. *sign painted*

SIGNAGE : 6060 = 38" x 21" = 6 sq ft

LETTERS : 2' x 42' = 84 sq ft


90 sq TOTAL

90 < 92.81
OK.



SHERWIN-WILLIAMS PAINTS

ELEVATION VIEW
SEE ELEVATION

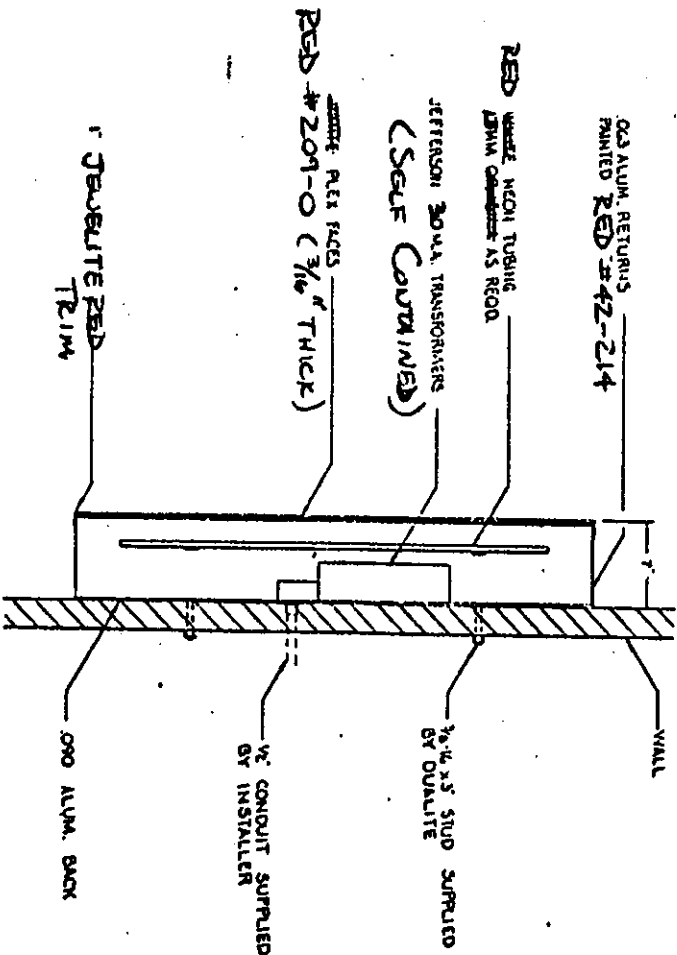

TYP. SECTION
SEE ELEVATION

FOR: Sherwin Williams Co. #5035

Towne Hall Shoppes
Brick Blvd. - Cedar Ridge
Bricktown, New Jersey

(3) 10% 20% 30% CIRCUITS REQD.

REVISIONS		DATE		BY	
1	PREPARED FOR PROPOSAL ONLY				
2	REDA 24" INDIVIDUAL NEON LETTERS				
3	SCALE NOTED				
4	DATE DEC. 1, 1987				
5	DRAWN BY E.H. GILL				
6	CHECKED BY J.B. CO				

RECEIVED
DEC 2 1987