

BLOCK 819 LOT 10 ADDRESS (SITE) 1591 W. Hinkley PERMIT NO. 1728-96

RECEIVED

JUN 27 1996



CONSTRUCTION PERMIT APPLICATION

Applicant Completes: Sections I, II, III (optional), IV, VI and VII

I. IDENTIFICATION

1. Proposed Work-site at: Detached Deck 1591 W. Princeton Ave.
2. Name of Owner in Fee: Thomas Trafer Tel. [REDACTED]
- Address 1591 W Princeton Ave [REDACTED]
street municipality zip code
3. Ownership in Fee: Public _____ Private ☒
4. Principal Contractor: SELF Tel. () _____
- Address _____
- License No. OR, if new home, Builder Reg. No. _____
- Federal Emp. No. _____ Social Security [REDACTED]
5. Architect or Engineer _____ Tel. () _____
- Address _____
6. Responsible Person In Charge of Work Thomas Trafer Tel. () _____

V. FEE SUMMARY (for office use only)

		Update	Update
1. Building	\$ 35-		
2. Electrical			
3. Plumbing			
4. Fire Protection			
5. Elevator Devices			
6. Subtotal	\$ 35-		
7. Less 20% for State Plan Review			
8. Subtotal	\$		
9. DCA Training Fee			
10. Subtotal	\$		
11. Cert. of Occupancy			
12. Other 214	\$ 15.		
13. TOTAL	\$ 50.00		

VI. BUILDING/SITE CHARACTERISTICS

1. Number of Stories _____
2. Height of Structure _____ ft.
3. Area—Largest Floor _____ sq. ft.
4. New Building Area _____ sq. ft.
5. Volume of New Structure _____ cu. ft.
6. Construction Classification _____
7. Total Land Area Disturbed _____ sq. ft.
8. Flood Hazard Zone _____
9. Base Flood Elevation _____ ft.
10. Wetlands yes _____ sq. ft.
 no _____
11. Max. Live Load _____
12. Max. Occupancy Load _____

(office use only)

II. PROPOSED WORK

1. ☐ Minor work
(single trade)
 2. ☐ Small Job (\$5,000
and no prior approvals)
 3. ☐ New Building
 4. ☐ Addition
 5. ☐ Alteration
 6. ☐ Fire Protection
 7. ☐ Plumbing
 8. ☐ Electrical
 9. ☐ Elevator Devices
 10. ☐ Asbestos Abatement
 11. ☐ Demolition
- TOTAL COSTS**

Est Cost

Jack

OPTIONAL (for office use only)

Plans Rec'd By	Date Rec'd	Rejection Date	Approval Date	Re- view	Resubmission Dates Approval Rejection	Re- view
W8	6/27/96		7/11/96	7/11/96	7/25/96	✓
ENG.	7/5/96		N/A	<i>[Signature]</i>		

III. DO YOU WANT: (optional) 1 ☐ Partial Releases 2. ☐ Prototype Processing

IV. DOES OR WILL YOUR BUILDING CONTAIN ANY OF THE FOLLOWING?

1. ☐ Elevators/Escalators/Lifts/
Dumbwaiters/Moving Walks
2. ☐ High Pressure Boilers
3. ☐ Pressure Vessels
4. ☐ Refrigeration Systems
5. ☐ Cross-Connections/Backflow
Preventers
6. ☐ Hazardous Uses/Places of Assembly
7. ☐ Sprinklers
8. ☐ Smoke Control Systems in Open Wells
9. ☐ Underground Storage Tanks

VII. DESCRIPTION OF BUILDING USE

RESIDENTIAL

1. ☐ Hotels (R-1)
2. ☐ Multi-Family (R-2)
3. ☐ Two-Family (R-3) BOCA
4. ☐ Two-Family (R-4) CABO
5. ☒ One-Family (R-3) BOCA
6. ☐ One-Family (R-4) CABO

No of dwelling units:

Before Construction _____
After Construction _____
Net gain or loss _____

B. NON-RESIDENTIAL

1. State Specific Use:
2. Use Group:
3. Change in Use Group, Indicate Former:

LDS BR 10411456

CERTIFICATION IN LIEU OF OATH

I. OWNER SECTION (to be completed if the applicant is the owner in fee)

I hereby certify that I am the owner in fee of the property listed on Page 1.

Mark the following applicable boxes:

A. () I further certify that a new home (private residence) will be constructed on this property for my own use and occupancy. This dwelling is to be occupied by myself and is not to be used for any purpose other than single family residential use. I attest that all construction, plumbing, or electrical work will be done, in whole or in part, by me or by subcontractors under my supervision, in accordance with all applicable laws; and, I further acknowledge that said new home is not covered under the New Home Warranty and Builders Registration Act (N.J.S.A. 46:3B-1 et seq.) and that such fact shall be disclosed to any person purchasing this property within ten years of the date of issuance of a certificate of occupancy.

I UNDERSTAND THAT IN MARKING BOX A, I ACKNOWLEDGE THAT I AM ASSUMING RESPONSIBILITY FOR THE WORK DONE ON SAID PROPERTY, THE CONDITION OF THE PROPERTY PRIOR TO, DURING, AND AFTER ANY WORK PERFORMED, AND FOR THE PERFORMANCE OF THE SUBCONTRACTORS I HIRE, EMPLOY, OR OTHERWISE CONTRACT OR WITH WHOM I MAKE AGREEMENTS TO PERFORM WORK. I AM VOLUNTARILY AND KNOWINGLY ASSUMING THIS RESPONSIBILITY.

B. () I further certify the following as required by the New Jersey Uniform Construction Code, N.J.A.C. 5:23-2.15(e)1.vii:

I personally prepared the plans submitted for: 1) the new home referred to in A.; or, 2) an addition, alteration, renovation, or repair to an existing single family residence owned and occupied by myself and located on the property listed on Page 1; or, 3) a new structure that will be physically separate from, but that will be deemed part of, an existing single family residence that is owned and occupied by myself and located on the property listed on Page 1.

C. () I further certify that I will perform or supervise the following work:

C.1. () Building C.2. () Fire Protection

I further certify that I will perform the following work:

C.3. () Electrical C.4. () Plumbing

D. () I agree to advise all contractors on this project that they are required to be registered with the New Jersey Division of Taxation and to comply with all New Jersey tax laws.

I further certify the following as required by the Uniform Construction Code, N.J.A.C. 5:23-2.15(a)5: All required State, county, and local prior approvals have been given, including such certification as the construction official may require.

I understand that if any of the above statements are willfully false, I am subject to punishment.

Signature Thomas T. Trefler Date 6/27/96

II. AGENT SECTION

(to be completed if the applicant is not the owner in fee)

I hereby certify the following as required by the New Jersey Uniform Construction Code, N.J.A.C. 5:32-2.15(d): the proposed work is authorized by the owner in fee; and I have been authorized by the owner in fee to make this application as his agent.

I further certify the following as required by the Uniform Construction Code, N.J.A.C. 5:23-2.15(a)5: All required State, county, and local prior approvals have been given, including such certification as the construction official may require.

I agree to advise all contractors on this project that they are required to be registered with the New Jersey Division of Taxation and to comply with all New Jersey tax laws.

I understand that if any of the above statements are willfully false, I am subject to punishment.

() Check if contractor.

Agent Name _____

Address _____

Telephone (_____) _____

Signature _____ Date _____

OFFICE DATE RECEIVED: _____

VIII. PRIOR APPROVALS CHECKLIST (office use only)	LOCAL APPROVAL		COUNTY APPROVAL		REGIONAL APPROVAL		STATE APPROVAL		COMMENTS
	Prelimin. Initial	Final Date	Prelimin. Initial	Final Date	Prelimin. Initial	Final Date	Prelimin. Initial	Final Date	
☐ Zoning Officer									IMPORTANT A.H.B.T. - EXEMPT
☐ Planning Board									
☐ Zoning Board									
☐ Sewer Authority									
☐ Water Authority									
☐ Fire Department									
☐ Police Department									
☐ Health Department									
☐ Soil Conservation									
☐ N.J. Dept. of Community Affairs									
☐ N.J. Department of Transportation									
☐ N.J. Dept. of Environmental Protect.									
☐ Utility Dig No.									
☐									
☐									

IX. SUBCODES AND SPECIAL REGULATIONS APPLICABLE (office use only—optional)

Name of Code & Edition

Name of Code & Edition

Other

Building _____
Electrical _____
Plumbing _____
Fire Protection _____
Mechanical _____

Energy _____
Barrier Free _____
Flood Hazard _____
As Built Elevation Cert. _____
Other _____

X. CERTIFICATES ISSUED (office use only)

DATE ISSUED

DATE EXPIRED

DATE REISSUED

DATE EXPIRED

☐ Temporary Certificate of Occupancy	No. _____	_____	_____	_____
☐ Temporary Certificate of Compliance	No. _____	_____	_____	_____
☐ Continued Certificate of Occupancy	No. _____	_____	_____	_____
☐ Certificate of Compliance	No. _____	_____	_____	_____
☐ Certificate of Occupancy	No. _____	_____	_____	_____
☐ Certificate of Approval	No. _____	_____	_____	_____



CONSTRUCTION PERMIT

Date Issued

Control #

Permit #

17-11-96

1728-96

Same

IDENTIFICATION Block

819

Lot

10

Work Site Location

1591 W. PRINCETON AVE
BRICK, NJ

Contractor

Owner in Fee

THOMAS TAPFER

Address

Same

Address

Tele. ()

Lic. No. or Bldrs. Reg. No.

Exp. Date

Federal Emp. No.

or Social Security No.

149-110-21691

Is hereby granted permission to perform the following work:

☒ BUILDING☐ PLUMBING☐ OTHER☐ ELECTRICAL☐ FIRE PROTECTION

DESCRIPTION OF WORK:

DOTARDED DOCK

NOTE: If construction does not commence within one (1) year of date of issuance, or if construction ceases for a period of six (6) months, this permit is void.

Estimated Cost of Work \$

4700

U.C.C. Form F-170A

CONSTRUCTION OFFICIAL

PAYMENTS (Office Use Only)

Building

35

Plumbing

Electrical

Fire Protection

Other

Other

DCA Training Fee

Cert. of Occ.

Other

2PA 15

Total

50

Check No.

Cash

Collected By:

A. Smith

1728-96
7-11-90

A. IDENTIFICATION—APPLICANT: COMPLETE ALL APPLICABLE INFORMATION. WHEN CHANGING CONTRACTORS, NOTIFY THIS OFFICE. CALL UTILITY DIG NO: 1-800-272-1000.

Block 819 Lot 10
Work Site Location 1591 W. Paricester Ave
Owner in Fee Thomas Trafer
Address 1591 W. Paricester Ave
Tele. [REDACTED]
Contractor [REDACTED]
Address _____
Tele. (____) _____
Lic. No. or Bldrs. Reg. No. _____
Federal Emp. No. _____ or Social Security No. _____

C. CERTIFICATION IN LIEU OF OATH

I hereby certify that I am the (agent of) owner of record and am authorized to make this application.
Signature Thomas Trafer

D. TECHNICAL SITE DATA

DESCRIPTION OF WORK
Detached Deck 48" high - 36" Railing
fan style-front 12' Back 16' x 6 foot
out from pool side self closing gate
footings 32" deep. concrete 12" in diameter
with self closing gate latch above 48"

JOB SUMMARY (Office Use Only)

PLAN REVIEW	Date	Initial	INSPECTIONS	Dates (Month/Day)
☐ No Plans Req.			Failure	Failure
☒ All	7/11/90	[Signature]	Approval	7-18-90
☐ Footing				
☐ Foundation				
☐ Frame				
☐ Other				
Joint Plan Review Required:			Insulation	
☐ Elec. ☐ Plumb. ☐ Fire			Finishes:	7/15/90
SUBCODE APPROVAL			Mechanical	
☐ CO ☐ CCA ☐ SA			TCO	
Date: <u>7-13-90</u>			Other	
Approved By: [Signature]			Final	

B. BUILDING CHARACTERISTICS

Use Group	Present	Proposed
Constr. Class	Present	Proposed
No. of Stories		
Height of Structure		
Area—Largest Floor		
New Bldg. Area/All Floors		
Volume of New Structure		
Total Land Area Disturbed		

Est. Cost of Bldg. Work:

1. New Bldg. \$ _____
2. Alteration \$ _____
3. Total (1+2) \$ _____

(Office Use Only)
FEE

TYPE OF WORK:	FEE
☐ New Building	
☐ Addition	
☐ Alteration	
☐ Roofing	
☐ Siding	
☐ Fence	
☐ Sign	
☐ Pool	
☐ Asbestos Abatement	
☐ Other	
☐ Demolition	

Administrative Surcharge \$ _____
Minimum Fee \$ _____
DCA TRAINING FEE \$ _____
TOTAL FEE \$ _____



**BUILDING
SUBCODE
TECHNICAL SECTION**



Date Received
Date Issued
Control #
Permit #

1998-96
7-11-90

A. IDENTIFICATION—APPLICANT: COMPLETE ALL APPLICABLE INFORMATION, WHEN CHANGING CONTRACTORS, NOTIFY THIS OFFICE. CALL UTILITY DIG NO: 1-800-272-1000.

Block 819 Lot 10
Work Site Location 1591 W. Peirce Ave
Owner in Fee Thames Trafen
Address 1591 W. Peirce Ave
Contractor [Redacted]
Address [Redacted]
Tele. () [Redacted]
Tele. () [Redacted]
Lic. No. or Bids. Reg. No. [Redacted]
Federal Emp. No. [Redacted] or Social Security No. [Redacted]

JOB SUMMARY (Office Use Only)

PLAN REVIEW	Date	Initial	INSPECTIONS	Dates (Month/Day)	Initial
☐ No Plans Req.					
☒ All	<u>7/11/90</u>	<u>[Signature]</u>	Foundation		
☐ Footing			Slab		
☐ Foundation			Frame		
☐ Other			Insulation		
Joint Plan Review Required:			Finishes:		
☐ Elec. ☐ Plumb. ☐ Fire			Energy		
SUBCODE APPROVAL			Mechanical		
☐ CO ☐ CCO ☐ CA			TCO		
Date:			Other		
Approved By:			Final		

B. BUILDING CHARACTERISTICS

Use Group	Present	Proposed	Est. Cost of Bldg. Work:
Constr. Class	Present	Proposed	1. New Bldg. \$
No. of Stories			2. Alteration \$
Height of Structure			3. Total (1+2) \$
Area—Largest Floor			
New Bldg. Area/All Floors			
Volume of New Structure			
Total Land Area Disturbed			

C. CERTIFICATION IN LIEU OF OATH

I hereby certify that I am the (agent of) owner of record and am authorized to make this application.

Signature [Signature]

D. TECHNICAL SITE DATA

DESCRIPTION OF WORK
Detached Deck 48" high - 36" Railing
For Style-Font 12' Back 12' x 6 Foot
Out From Pool Side Self Closing Gate
Footings 32" deep. concrete 12" in Diameter
WITH SELF CLOSING GATE LATCH ABOVE 49"

TYPE OF WORK:	(Office Use Only)
☐ New Building	\$
☐ Addition	\$
☐ Alteration	\$
☐ Roofing	\$
☐ Siding	\$
☐ Fence	\$
☐ Sign	\$
☐ Pool	\$
☒ Asbestos Abatement	\$
☐ Other	\$
☐ Demolition	\$

	Administrative Surcharge	Minimum Fee	DCA TRAINING FEE	TOTAL FEE
Paid ☐ Check #	\$	\$	\$	\$
Collected by:	\$	\$	\$	\$


TOWNSHIP OF BRICK
ZONING PERMIT


Date of Issue: July 5, 1996 1996 - 0955
Block 819 Lot 10 zone R-7.5
Property Address: 1591 West Princeton Ave.
Owner: Thomas Trafer (Phone): [REDACTED]
Applicant: Same (Phone):
Use: Single Family Residential
Proposed Construction (if any): Deck attached to swimming pool.

Conditions: Deck must be setback at least 5' from the side and rear
property lines.


Please note that a Construction Permit, as well as a Zoning Permit, must be obtained prior to any construction. You will be notified by the Division of Inspections to pick up and pay for your entire Construction Permit.

This permit shall be null, void and of no effect if any of the facts contained in the application upon the basis of which this permit was granted are false or untrue in any material respect. This permit shall expire one (1) year after the date of issuance if the use or substantial construction has not been commenced.

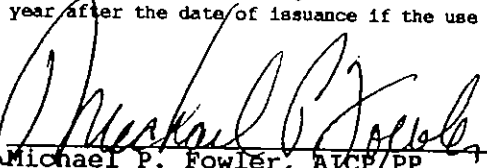
Michael P. Fowler, AICP/PP
Administrative Officer

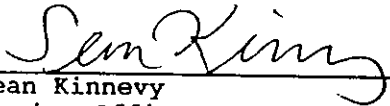

Sean Kinnevy
Zoning Officer

- 1 GATE TO BE SELF CLOSING
- 2 ALL RAILS 36" HIGH MIN.
- 3 ALL FLOOR JOIST 2x6

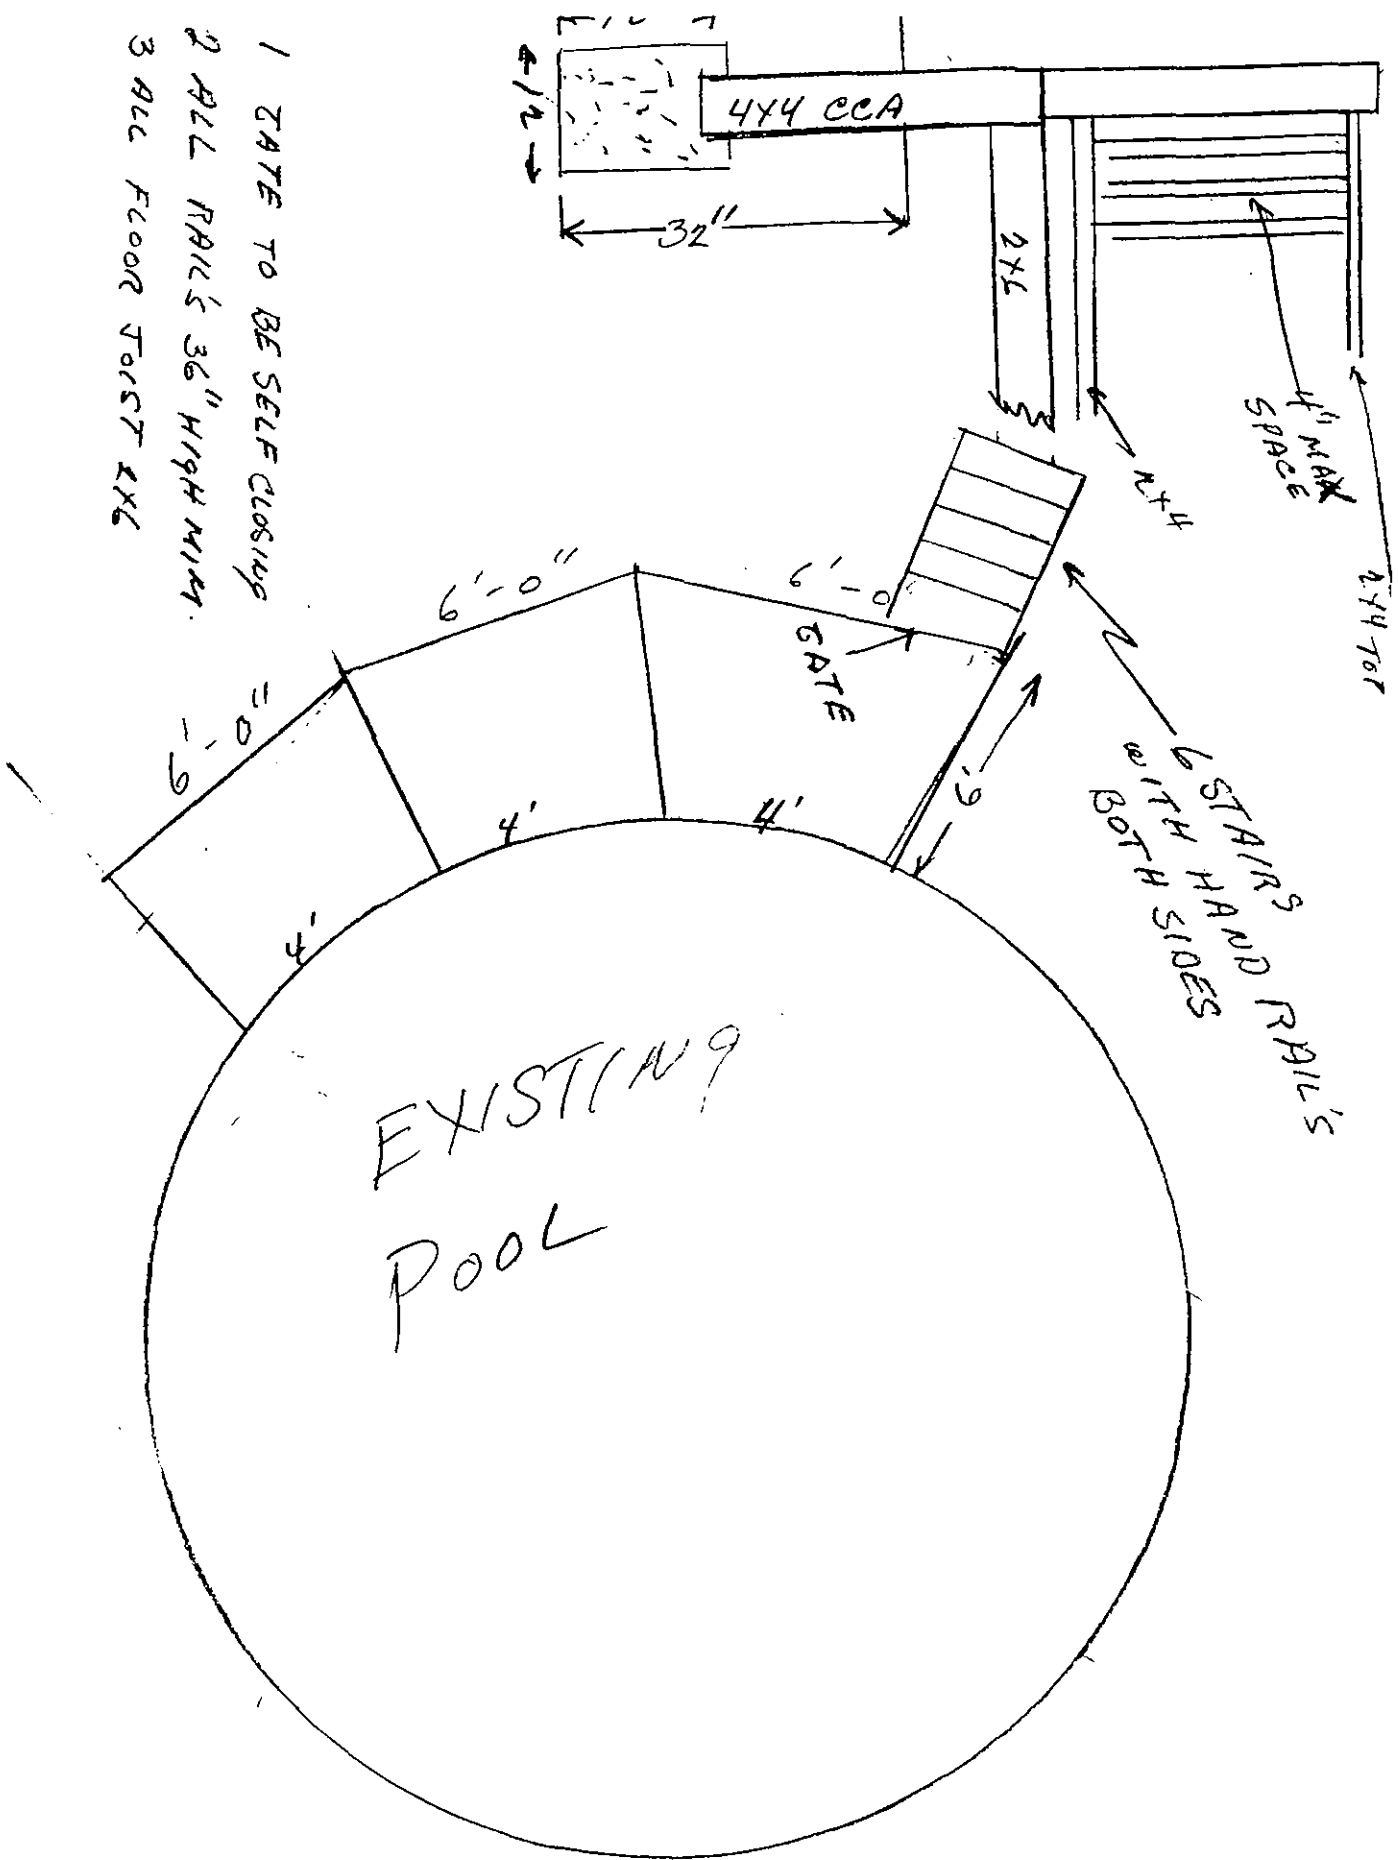

J. Jordan

- 1 GATE TO BE SELF CLOSING
- 2 RAIL 36" HIGH MIN.
- 3 ALL FLOOR JOIST 2x6

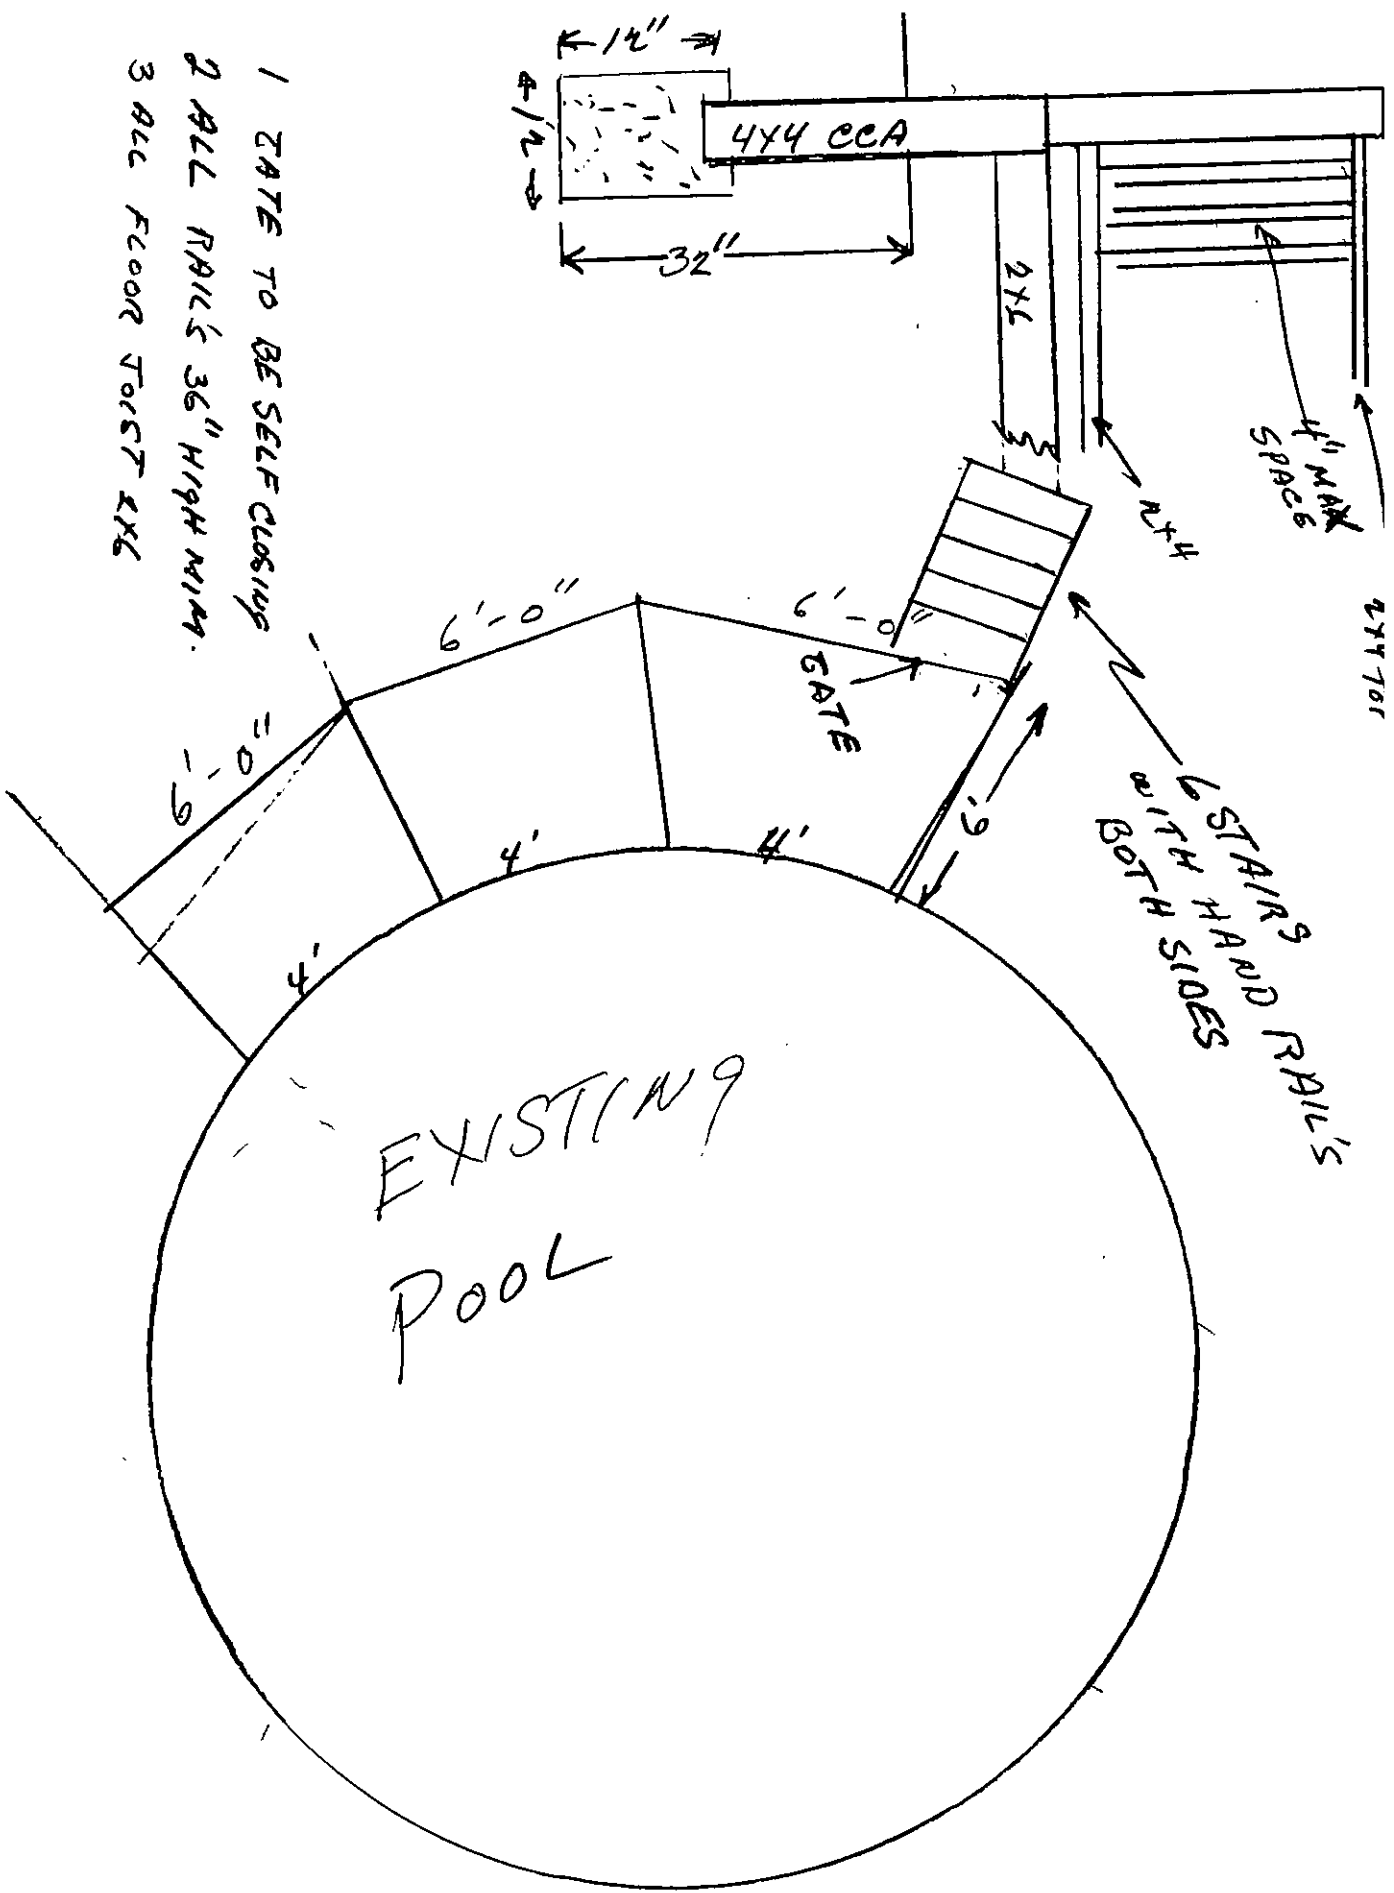

J. J. Jordan

NOTES:

1. CONTRACTUAL AGREEMENT STATES THAT PROPERTY CORNERS ARE NOT TO BE SET BY THIS SURVEY.
2. UNDERGROUND UTILITIES NOT LOCATED BY THIS SURVEY.
3. NO ATTEMPT WAS MADE TO DETERMINE IF ANY PORTION OF THIS PROPERTY IS CLAIMED BY THE STATE OF N.J. AS TIDELANDS.
4. DEED REFERENCE: BOOK 4589, PAGE 748
5. ENVIRONMENTALLY SENSITIVE AREAS ARE NOT LOCATED BY THIS SURVEY
6. THIS SURVEY IS SUBJECT TO CONDITIONS WHICH AN ACCURATE TITLE SEARCH MIGHT DISCLOSE


Title Co. File No. MS-55214

Job No. S-11607

A.K.A. 1591 W. PRINCETON AVE.

FILED MAP REF.

LARSEN (50' R.O.W.) STREET
(A.K.A. SEVENTH STREET)

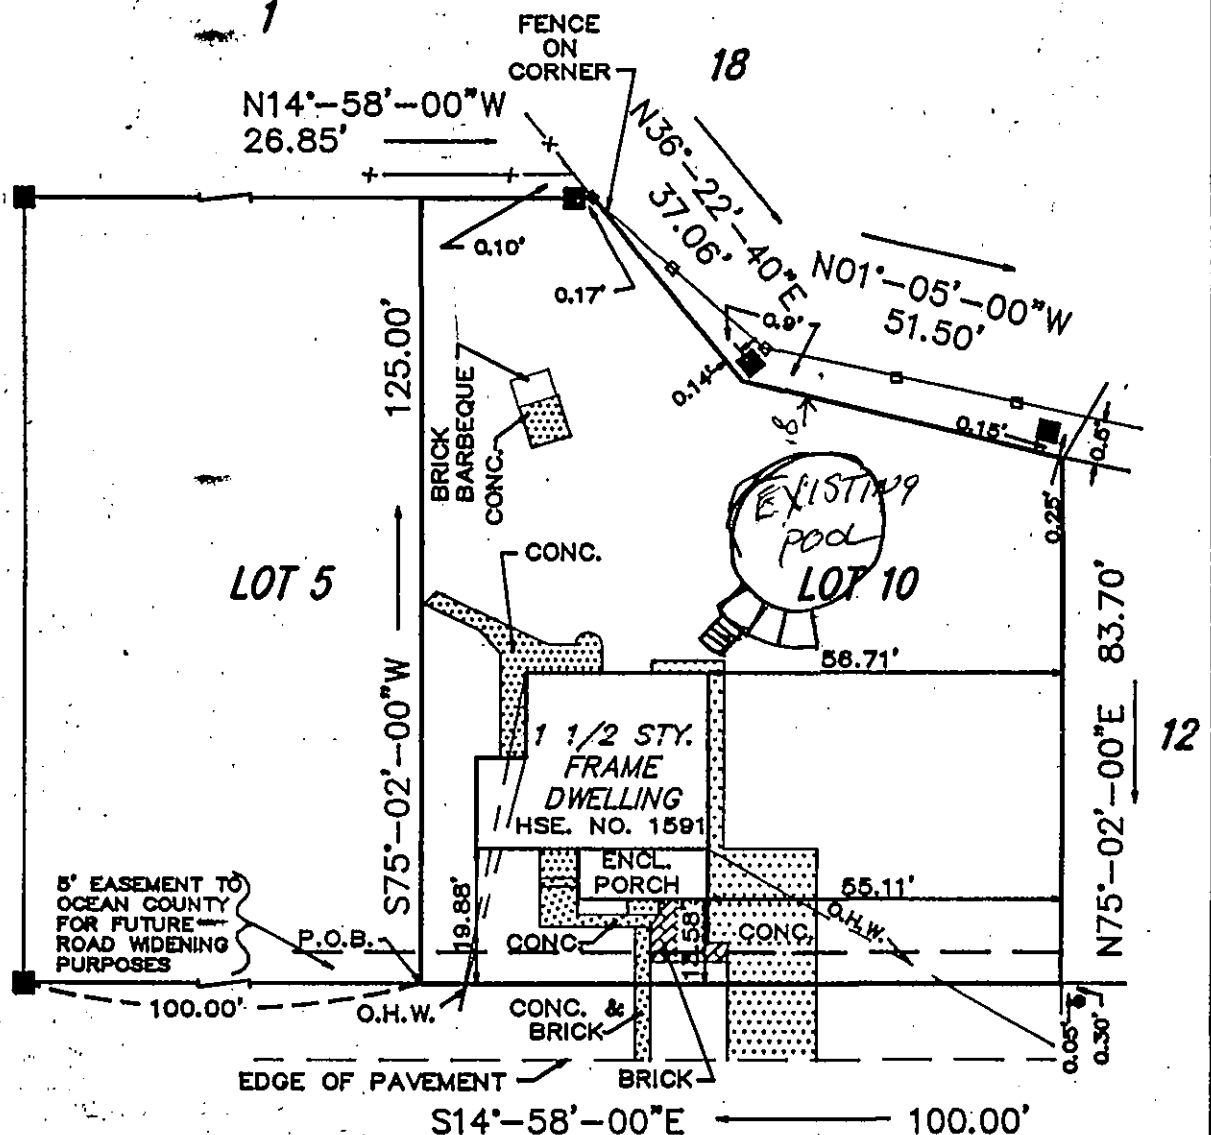

WEST PRINCETON (50' R.O.W.) AVENUE

Legend:

- - PIPE FOUND
- - MONUMENT FOUND
- - STOCKADE FENCE
- × - CHAIN LINK FENCE

Certification:

I hereby certify this survey was made under my immediate supervision to:
THOMAS & JOANNA TRAFER
H/W

MID-STATE ABSTRACT
COMPANY/FIRST AMERICAN
TITLE INSURANCE COMPANY

WILBERT & MONTENEGRO,
P.A.

LUMBERMEN'S MORTGAGE
CORPORATION ITS
SUCCESSORS AND/OR
ASSIGNEES

Map of Survey

REV. 3/27/91

LOT 10, BLOCK 819, TAX MAP
BRICK TOWNSHIP --- OCEAN COUNTY --- NEW JERSEY

A.K.A. NEW LOT 10, BLOCK 24, AS SHOWN ON A MAP ENTITLED
"MINOR SUBDIVISION LOT 5 THRU 11 INCL., BLOCK 819.24, ON THE
OFFICIAL TAX MAP, TOWNSHIP OF BRICK, OCEAN COUNTY, NEW JERSEY."
FILED FEBRUARY 15, 1990, AS MAP NO. 1-2269.

DELCO Land Surveying Corp.

917 North Main Street
Toms River, N.J. 08753
(908) 341-4200

SCALE
1" = 30'
DRAWN BY
R.L.R.

DATE
3/19/91
SHEET
1 OF 1

David J. Von Steenburg

LICENSED LAND SURVEYOR N.J. LIC. # 34500
PROFESSIONAL PLANNER N.J. LIC. # 04875

David J. Von Steenburg

DATE 3-27-91