

called 4/14/94
BLOCK
4-6



1. IDENTIFICATION

6. Responsible Person
In Charge of Work Reg. Hopping Tel. (908) 840-1273

Deck

III. DO YOU WANT: (optional) 1. ☐ Partial Releases 2. ☐ Prototype Processing

20K

CERTIFICATION IN LIEU OF OATH

I. OWNER SECTION (to be completed if the applicant is the owner in fee)

I hereby certify that I am the owner in fee of the property listed on Page 1.

Mark the following applicable boxes:

A. ☐ I further certify that a new home (private residence) will be constructed on this property for my own use and occupancy. This dwelling is to be occupied by myself and is not to be used for any purpose other than single family residential use. I attest that all construction, plumbing, or electrical work will be done, in whole or in part, by me or by subcontractors under my supervision, in accordance with all applicable laws; and, I further acknowledge that said new home is not covered under the New Home Warranty and Builders Registration Act (N.J.S.A. 46:3B-1 et seq.) and that such fact shall be disclosed to any person purchasing this property within ten years of the date of issuance of a certificate of occupancy.

I UNDERSTAND THAT IN MARKING BOX A, I ACKNOWLEDGE THAT I AM ASSUMING RESPONSIBILITY FOR THE WORK DONE ON SAID PROPERTY, THE CONDITION OF THE PROPERTY PRIOR TO, DURING, AND AFTER ANY WORK PERFORMED, AND FOR THE PERFORMANCE OF THE SUBCONTRACTORS I HIRE, EMPLOY, OR OTHERWISE CONTRACT OR WITH WHOM I MAKE AGREEMENTS TO PERFORM WORK. I AM VOLUNTARILY AND KNOWINGLY ASSUMING THIS RESPONSIBILITY.

B. ☐ I further certify the following as required by the New Jersey Uniform Construction Code, N.J.A.C. 5:23-2.15(e)1.vii:

I personally prepared the plans submitted for: 1) the new home referred to in A.; or, 2) an addition, alteration, renovation, or repair to an existing single family residence owned and occupied by myself and located on the property listed on Page 1; or, 3) a new structure that will be physically separate from, but that will be deemed part of, an existing single family residence that is owned and occupied by myself and located on the property listed on Page 1.

C. ☐ I further certify that I will perform or supervise the following work:

C.1. ☐ Building C.2. ☐ Fire Protection

I further certify that I will perform the following work:

C.3. ☐ Electrical C.4. ☐ Plumbing

D. ☐ I agree to advise all contractors on this project that they are required to be registered with the New Jersey Division of Taxation and to comply with all New Jersey tax laws.

I further certify the following as required by the Uniform Construction Code, N.J.A.C. 5:23-2.15(a)5: All required State, county, and local prior approvals have been given, including such certification as the construction official may require.

I understand that if any of the above statements are willfully false, I am subject to punishment.

Signature Ron Hopping Date 4-2-94

II. AGENT SECTION

(to be completed if the applicant is not the owner in fee)

I hereby certify the following as required by the New Jersey Uniform Construction Code, N.J.A.C. 5:32-2.15(d): the proposed work is authorized by the owner in fee; and I have been authorized by the owner in fee to make this application as his agent.

I further certify the following as required by the Uniform Construction Code, N.J.A.C. 5:23-2.15(a)5: All required State, county, and local prior approvals have been given, including such certification as the construction official may require.

I agree to advise all contractors on this project that they are required to be registered with the New Jersey Division of Taxation and to comply with all New Jersey tax laws.

I understand that if any of the above statements are willfully false, I am subject to punishment.

☒ Check if contractor.

Agent Name Ron Hopping

Address 702 Christopher st

Telephone (908) 840-8273

Signature Ron Hopping Date 4-2-94

OFFICE DATE RECEIVED: _____

COMMENTS

IMPORTANT
A.H.B.T. - EXEMPT
2/8/94

VIII. PRIOR APPROVALS CHECKLIST (office use only)	LOCAL APPROVAL		COUNTY APPROVAL		REGIONAL APPROVAL		STATE APPROVAL	
	Prelimin. Initial	Final Date	Prelimin. Initial	Final Date	Prelimin. Initial	Final Date	Prelimin. Initial	Final Date
☐ Planning Board								
☐ Zoning Board								
☐ Sewer Authority								
☐ Water Authority								
☐ Fire Department								
☐ Police Department								
☐ Health Department								
☐ Soil Conservation								
☐ N.J. Dept. of Community Affairs								
☐ N.J. Department of Transportation								
☐ N.J. Dept. of Environmental Protection								
☐ Utility Dig No.								
☒ Other 204145	JK	4/6/94	deck					
☐ A.H. Exempt								
☐								

IX. SUBCODES AND SPECIAL REGULATIONS APPLICABLE (office use only—optional)

Name of Code & Edition

Name of Code & Edition

Other

Building _____
Electrical _____
Plumbing _____
Fire Protection _____
Mechanical _____

Energy _____
Barrier Free _____
Flood Hazard _____
As Built Elevation Cert. _____
Other _____

X. CERTIFICATES ISSUED (office use only)

DATE EXPIRED

- ☐ Temporary Certificate of Occupancy
- ☐ Temporary Certificate of Occupancy
- ☐ Continued Certificate of Occupancy
- ☐ Certificate of Occupancy
- ☐ Certificate of Approval

No. _____
No. _____
CONSTRUCTION PERMIT

Date Issued

Control #

Permit #

4/18/94
647-94

IDENTIFICATION Block 819.24 Lot 5

Work Site Location 1586 Larson St.

Contractor Ron Hoppin

Owner in Fee Pete Kreimer

Address 712 Cherokee

Address 1586 Larson

Tele. (911) 840 - 1273

Tele. (911) 840 - 4082

Lic. No. or Bldrs. Reg. No. 0000794 Exp. Date 04/94

Federal Emp. No. 04794

or Social Security No. BLOCK 0.00

Is hereby granted permission to perform the following work:

- [] BUILDING [] PLUMBING [] OTHER _____
[] ELECTRICAL [] FIRE PROTECTION

DESCRIPTION OF WORK:

Deck

NOTE: If construction does not commence within one (1) year of date of issuance, or if construction ceases for a period of six (6) months, this permit is void.

Estimated Cost of Work \$ 1000

CONSTRUCTION OFFICIAL

PAYMENTS (Office Use Only) 819.24 #

Building 8 INT 0.00

Plumbing 5 #

Electrical BUILDING 8.00

Fire Protection PLAN RUN 5.00

Other S.F.A. 1.00

Other C.I.O. 10.00

DCA Training Fee TOTAL 34.00

Cert. of Occ. 2 CASH 4.00

Other CHANGE 0.00

Total 4/18/94 NO. 34 00234085 2:29

Check No. _____

Cash _____

Collected By: PK



Date Received 4/11/89
Date Issued
Control #
Permit # 6417-94

A. IDENTIFICATION—APPLICANT: COMPLETE ALL APPLICABLE INFORMATION WHEN CHANGING CONTRACTORS. NOTIFY THIS OFFICE. CALL UTILITY DIG NO: 1-800-272-1000.

Block 819 24 Lot 5
Work Site Location Los Angeles

Owner in Fee Pete Weimer
Address 1586 LACSEA

Tele [REDACTED]

Contractor Big Hoppings
Address 202 Chesapeake

Tax 425 846 1222

F.C. No. of Bldgs. Reg. No. [REDACTED] or Social Security No. [REDACTED]

C. CERTIFICATION IN LIEU OF OATH

I hereby certify that I am the (agent of) owner of record and am authorized to make this application.

Signature Ken Hoppings

D. TECHNICAL SITE DATA DESCRIPTION OF WORK

12125 Deck

JOB SUMMARY (Office Use Only)	
PLAN REVIEW	Date Initial
☐ No Plans Req.	
☒ All	4/13/89
☒ Footing	
☐ Foundation	
☐ Slab	
☐ Frame	
☐ Insulation	
☐ Joint Plan Review Required	
☐ Elec. ☐ Plumb. ☐ Fire	
SUBCODE APPROVAL	
☐ CO ☐ CCO ☐ CA	
Date	
Approved By	

TYPE OF WORK:	
☐ New Building	
☐ Addition	
☐ Alteration	
☐ Roofing	
☐ Siding	
☒ Other <u>Decks</u>	
☐ Demolition	
☐ Miscellaneous	
☐ Fence	Height
☐ Sign	Sq. Ft.
☐ Pool	
☐ Elevator	
☐ Asbestos Abatement	
☐ Other	


B. BUILDING CHARACTERISTICS

Use Group Present _____ Proposed _____
Constr. Class Present _____ Proposed _____
No. of Stories 1
Height of Structure 3 Ft.
Area—Largest Floor _____ Sq. Ft.
Total Bldg. Area/All Floors _____ Sq. Ft.
Volume of Structure _____ Cu. Ft.
Total Land Area Disturbed _____ Sq. Ft.

Est. Cost of Bldg. Work:

1. New Bldg. \$ _____
2. Alteration \$ _____
3. Total (1+2) \$ 1,000

Administrative Surcharge	
Paid ☐ Check # _____	Minimum Fee \$ _____
Collected by: _____	TOTAL FEE \$ _____

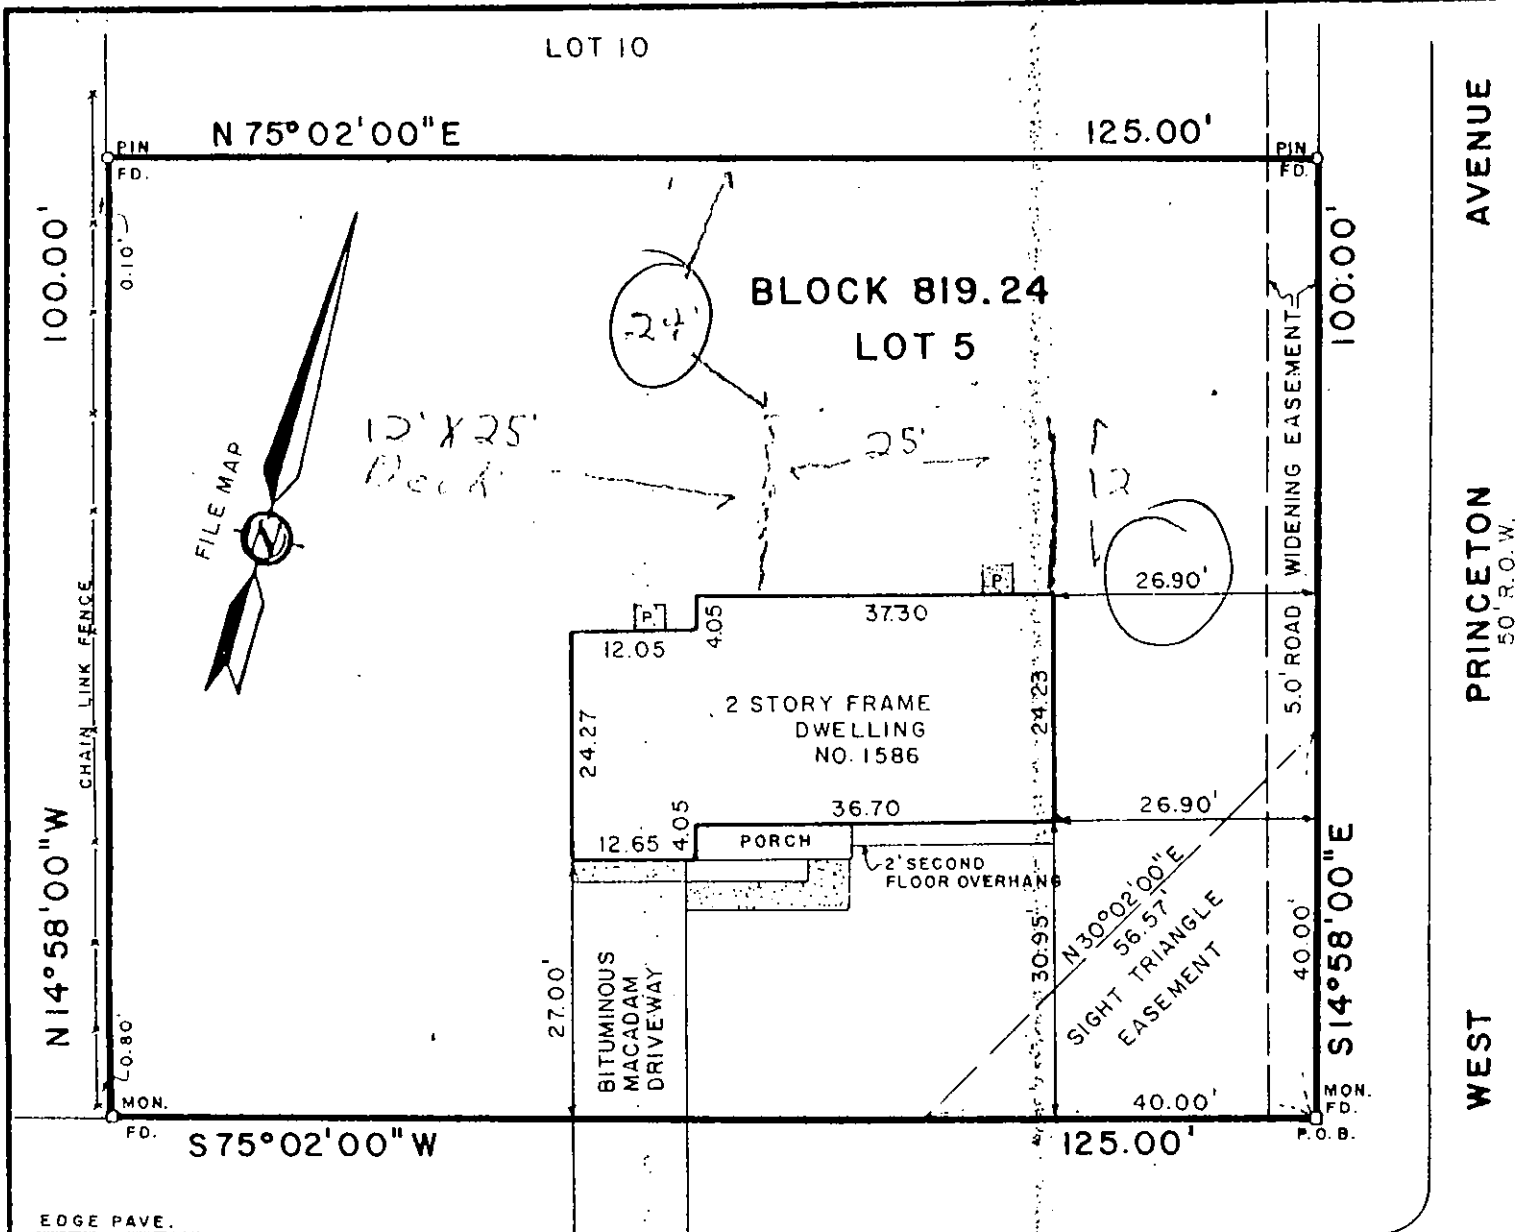

LARSEN

50' R.O.W.

STREET

PROPERTY ALSO KNOWN AS NEW LOT 5, BLOCK 819.24, AS SHOWN ON "MAP OF MINOR SUBDIVISION LOTS 5 THROUGH 11" FILED IN THE OCEAN COUNTY CLERK'S OFFICE ON FEBRUARY 15, 1990 AS MAP I-2269.

APPROVED FOR ZONING ONLY
SEAN KIRBY, ZONING OFFICER
DATE 4/6/94 Sean Kirby
deck

SURVEY OF PROPERTY FOR PETER T. WEIMER AND WENDY C. HOCKINS


SITUATED IN TOWNSHIP OF BRICK OCEAN COUNTY NEW JERSEY


FILE NO. 2023

SCALE 1" = 20'

DATE 06-16-92

12' x 25'
Deck

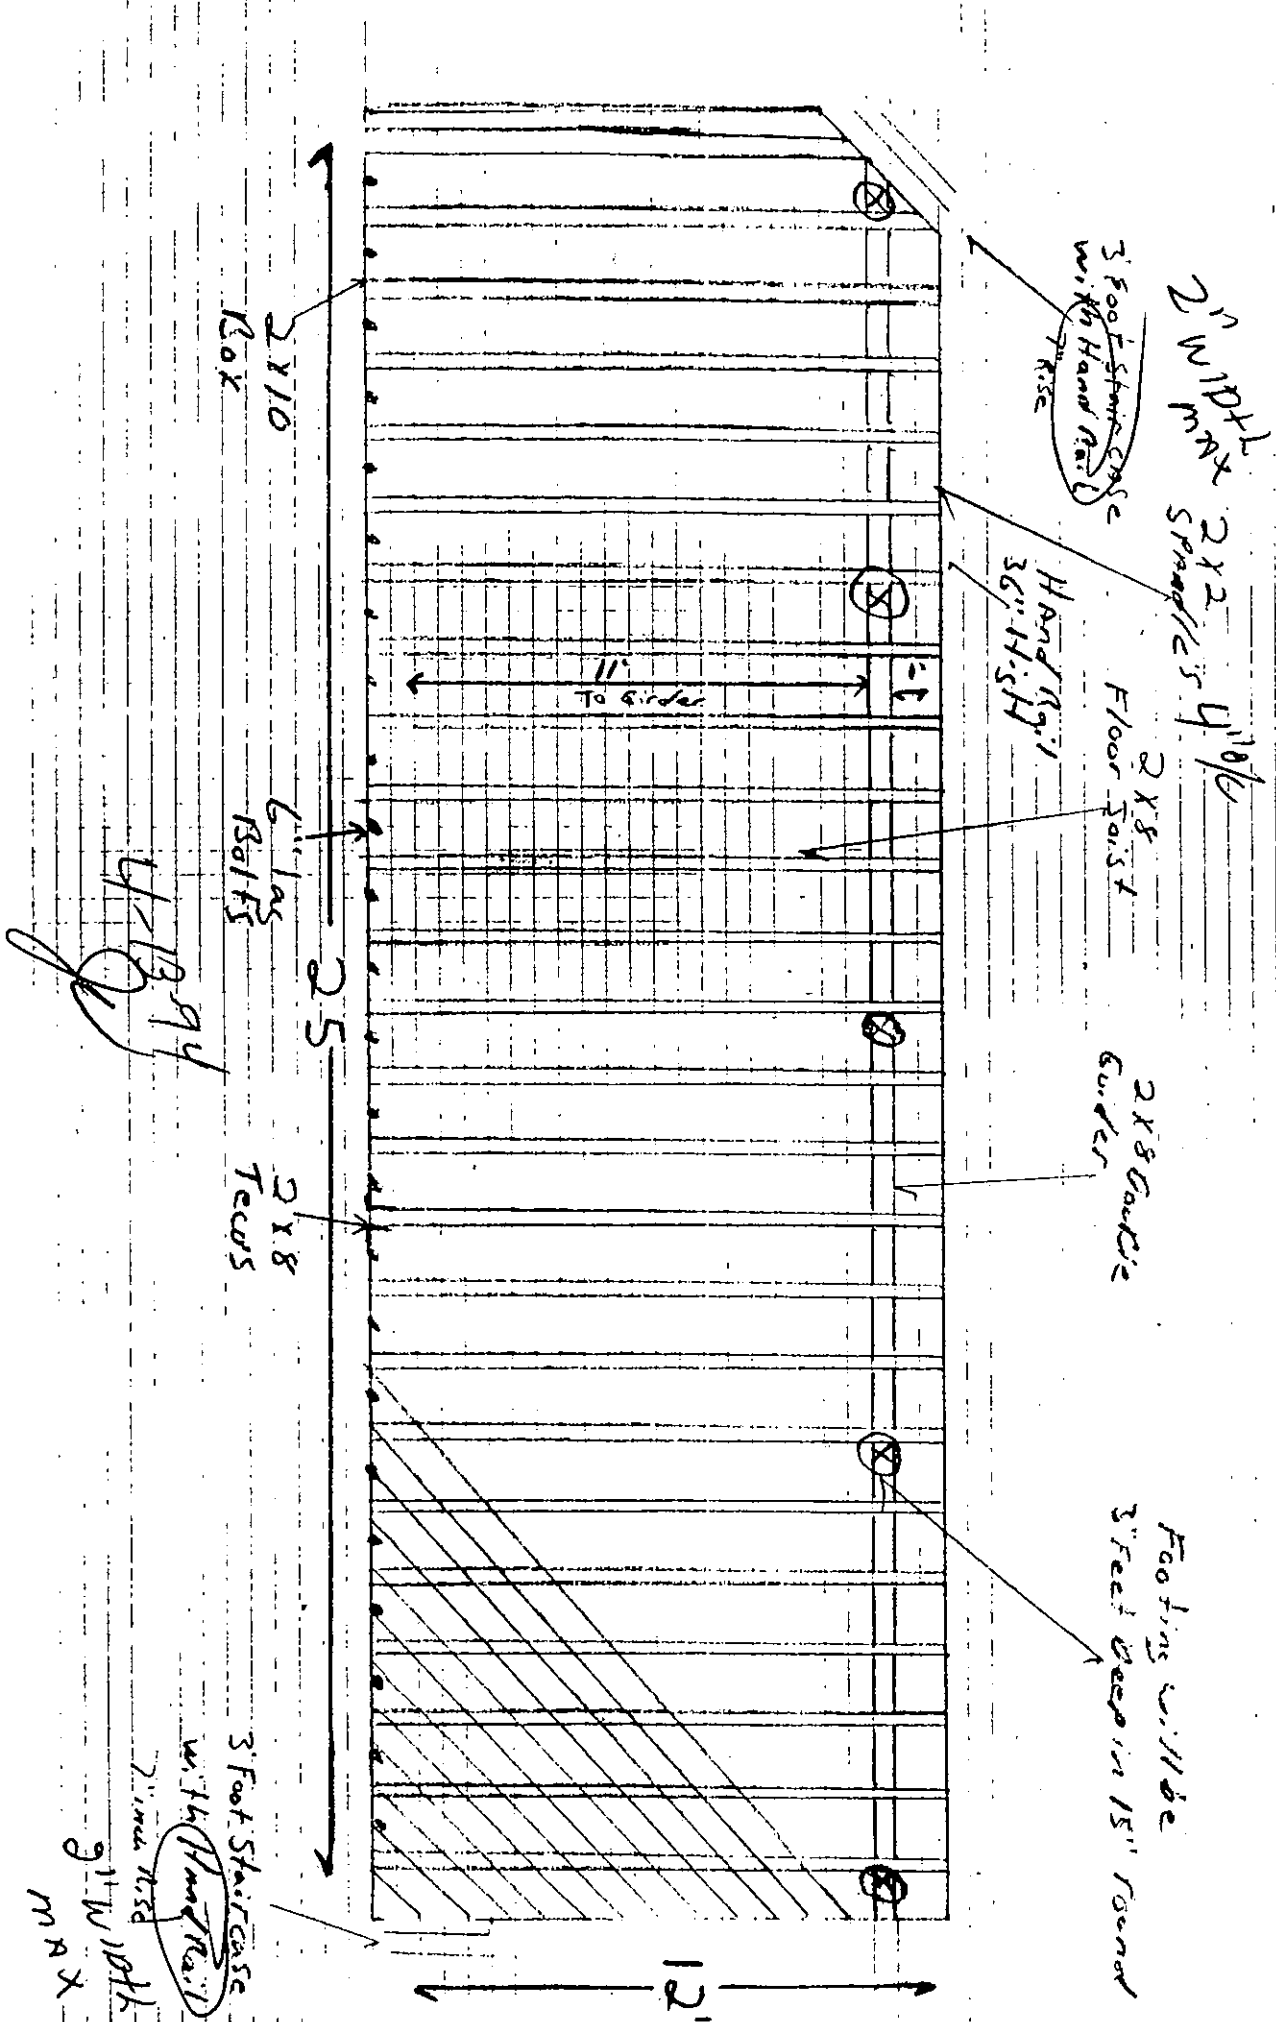

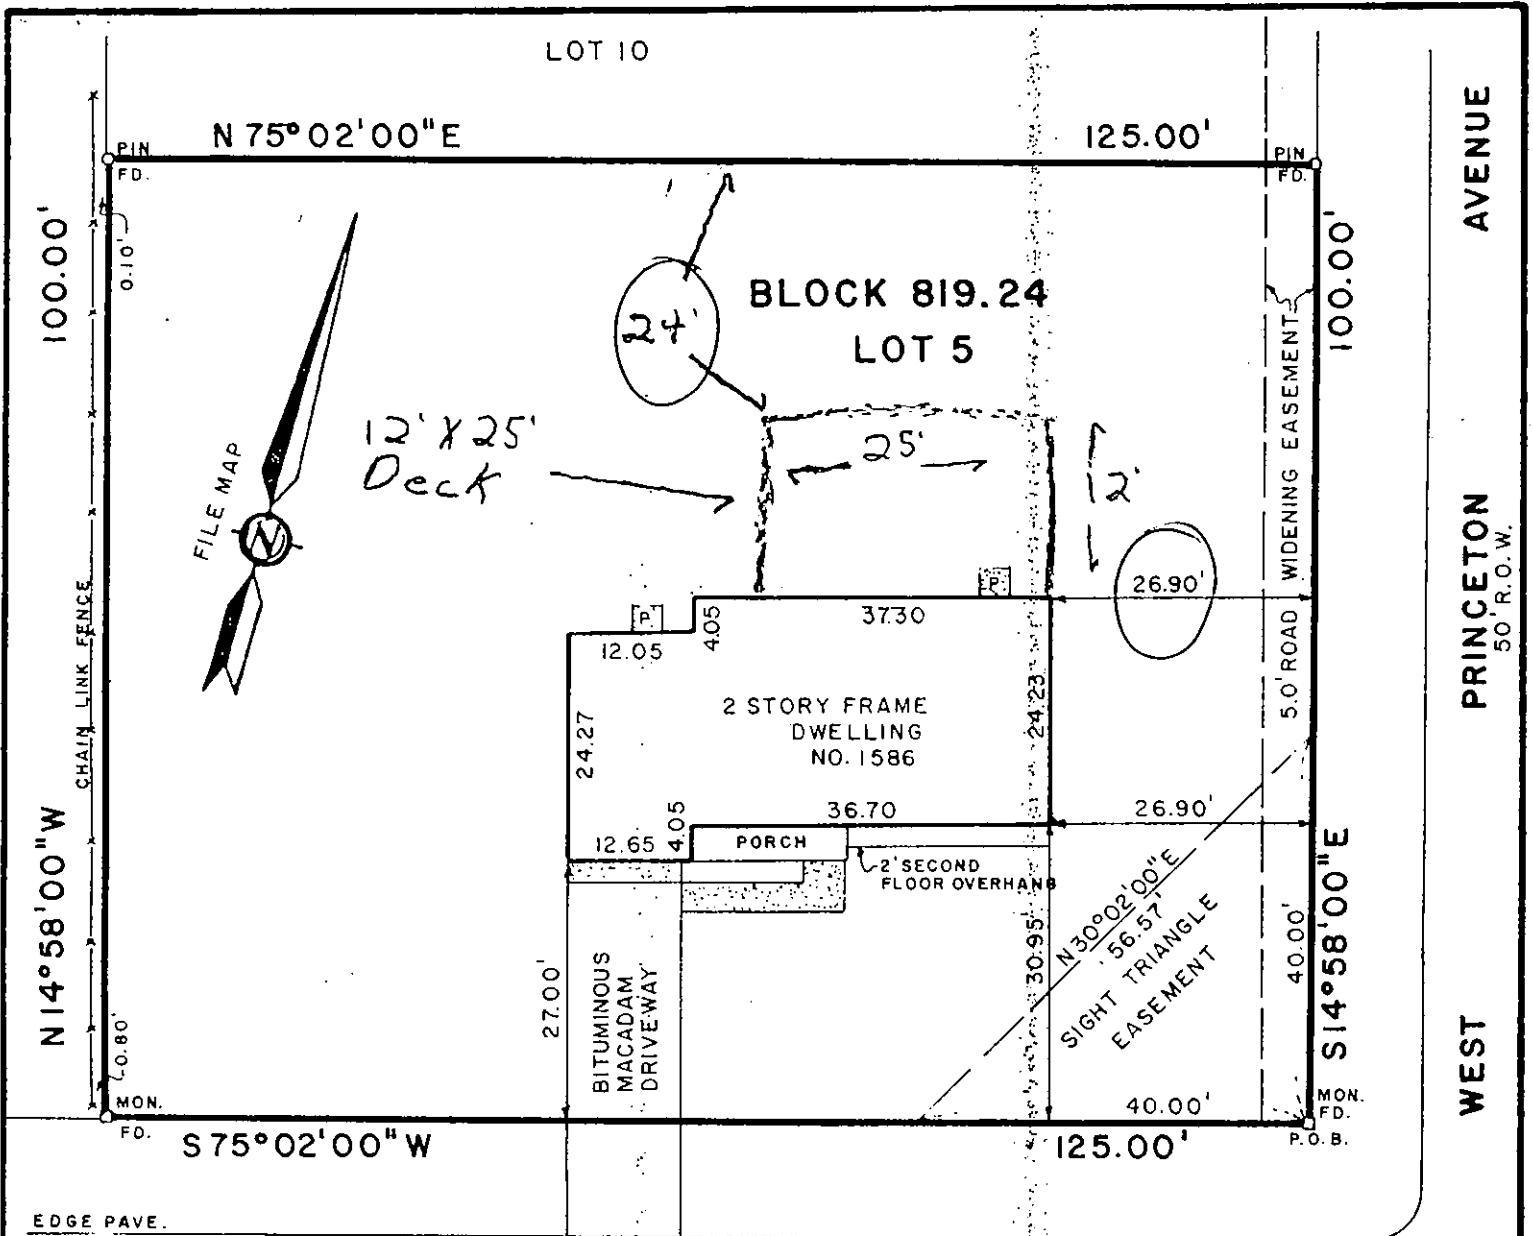

LARSEN

50' R.O.W.

STREET

PROPERTY ALSO KNOWN AS NEW LOT 5, BLOCK 819.24, AS SHOWN ON "MAP OF MINOR SUBDIVISION LOTS 5 THROUGH 11" FILED IN THE OCEAN COUNTY CLERK'S OFFICE ON FEBRUARY 15, 1990 AS MAP I-2269.

APPROVED FOR ZONING ONLY
SEAM KINNEY, ZONING OFFICER
DATE 4/6/94 Seam Kinney
deck

SURVEY OF PROPERTY FOR PETER T. WEIMER AND WENDY C. HOCKINS

SITUATED IN TOWNSHIP OF BRICK OCEAN COUNTY NEW JERSEY

FILE NO. 2023

SCALE 1" = 20'

DATE 06-16-92

CERTIFIED TO:

Peter T. Weimer,

Wendy C. Hockins,

Colonial State Bank, and/or its assigns or successors,

Alliance Title Agency

Thomas H. Stuart Jr
THOMAS H. STUART JR.
PROFESSIONAL LAND SURVEYOR LIC NO. 18593

1223 NARRUMSON ROAD MANASQUAN, N.J.

201-528-6625

This certification is made only to above named parties for purchase and/or mortgage of herein delineated property by above named purchaser. No responsibility or liability is assumed by Surveyor for use of survey for any other purpose including, but not limited to, use of survey for survey affidavit, resale of property, or to any other person not listed in certification either directly or indirectly.