

BLOCK 547.01 LOT 15 ADDRESS (SITE) _____ PERMIT NO. 2259-92

RECEIVED

MAR 16 1992



CONSTRUCTION PERMIT APPLICATION

DIV. 16 INSPECTION Applicant Completes: Sections I, II, III (optional), IV, VI and VII

I. IDENTIFICATION

1. Proposed Work-site at: 371 Brick Blvd

2. Name of Owner in Fee: CARVEL STORE #795 Tel. (908) 477-7221

Address 371 Brick Blvd Brick, NR 08723

street municipality zip code

3. Ownership in Fee: Public _____ Private A

4. Principal Contractor: Same Tel. (____) _____

Address _____

License No. OR, if new home, Builder Reg. No. _____ Exp. Date _____

Federal Emp. No. _____ Social Security No. _____

5. Architect or Engineer _____ Tel. (____) _____

Address _____

6. Responsible Person In Charge of Work JACK VERBEKE Tel. (____) _____

V. FEE SUMMARY (for office use only)

		Update	Update
1. Building	\$		
2. Electrical			
3. Plumbing			
4. Fire Protection			
5. Other <u>Sigs</u>	<u>88.00</u>		
6. Subtotal	\$		
7. Less 20% for State Plan Review	<u>5.-</u>		
8. Subtotal	\$		
9. DCA Training Fee			
10. Subtotal	\$		
11. Cert. of Occupancy	<u>20.-</u>		
12. Other			
13. TOTAL	\$	<u>113.-</u>	

VI. BUILDING/SITE CHARACTERISTICS

	(office use only)
1. Number of Stories	
2. Height of Structure	_____ ft.
3. Area—Largest Floor	_____ sq. ft.
4. Building Area—All Floors	_____ sq. ft.
5. Volume of Structure	_____ cu. ft.
6. Construction Classification	
7. Total Land Area Disturbed	_____ sq. ft.
8. Flood Hazard Zone	
9. Base Flood Elevation	_____ ft.
10. Wetlands yes _____ sq. ft.	
no _____	
11. Fire Grading	
12. Max. Live Load	
13. Max. Occupancy Load	

II. PROPOSED WORK

1. ☐ Minor Work (single trade)
2. ☐ Small Job (\$5,000 and no prior approvals)
3. ☐ New Building
4. ☐ Addition
5. ☐ Alteration
6. ☐ Fire Protection
7. ☐ Plumbing
8. ☐ Electrical
9. ☐ Asbestos Abatement
10. ☐ Demolition

TOTAL COSTS 500

Est. Cost

OPTIONAL (for office use only)

Plans Rec'd By	Date Rec'd	Rejection Date	Approval Date	Re-viewer	Resubmission Dates Approval	Rejection	Re-viewer
<u>Sign</u>			<u>10/30/92</u>	<u>RA</u>			

III. DO YOU WANT: (optional) 1. ☐ Partial Releases 2. ☐ Prototype Processing

IV. DOES OR WILL YOUR BUILDING CONTAIN ANY OF THE FOLLOWING?

1. ☐ Elevators/Escalators/Lifts/Dumbwaiters/Moving Walks
2. ☐ High Pressure Boilers
3. ☐ Pressure Vessels
4. ☐ Refrigeration Systems
5. ☐ Cross-Connections/Backflow Preventers
6. ☐ Hazardous Uses/Places of Assembly
7. ☐ Sprinklers
8. ☐ Smoke Control Systems in Open Wells
9. ☐ Underground Storage Tanks

VII. DESCRIPTION OF BUILDING USE

A. RESIDENTIAL

1. ☐ Hotels (R-1)
2. ☐ Multi-Family (R-2)
3. ☐ Two-Family (R-3) BOCA
4. ☐ Two-Family (R-4) CABO
5. ☐ One-Family (R-3) BOCA
6. ☐ One-Family (R-4) CABO

No of dwelling units:

Before Construction _____

After Construction _____

Net gain or loss _____

B. NON-RESIDENTIAL

1. State Specific Use:

2. Use Group: Retail

3. Change in Use Group. Indicate Former:

LDS BR 10310374

20K

CERTIFICATION IN LIEU OF OATH

I. OWNER SECTION (to be completed if the applicant is the owner in fee)

I hereby certify that I am the owner in fee of the property listed on Page 1.

Mark the following applicable boxes:

- A. () I further certify that a new home (private residence) will be constructed on this property for my own use and occupancy. This dwelling is to be occupied by myself and is not to be used for any purpose other than single family residential use. I attest that all construction, plumbing, or electrical work will be done, in whole or in part, by me or by subcontractors under my supervision, in accordance with all applicable laws; and, I further acknowledge that said new home is not covered under the New Home Warranty and Builders Registration Act (N.J.S.A. 46:3B-1 et seq.) and that such fact shall be disclosed to any person purchasing this property within ten years of the date of issuance of a certificate of occupancy.

I UNDERSTAND THAT IN MARKING BOX A, I ACKNOWLEDGE THAT I AM ASSUMING RESPONSIBILITY FOR THE WORK DONE ON SAID PROPERTY, THE CONDITION OF THE PROPERTY PRIOR TO, DURING, AND AFTER ANY WORK PERFORMED, AND FOR THE PERFORMANCE OF THE SUBCONTRACTORS I HIRE, EMPLOY, OR OTHERWISE CONTRACT OR WITH WHOM I MAKE AGREEMENTS TO PERFORM WORK. I AM VOLUNTARILY AND KNOWINGLY ASSUMING THIS RESPONSIBILITY.

- B. () I further certify the following as required by the New Jersey Uniform Construction Code, N.J.A.C. 5:23-2.15(e)1.vii:

I personally prepared the plans submitted for: 1) the new home referred to in A.; or, 2) an addition, alteration, renovation, or repair to an existing single family residence owned and occupied by myself and located on the property listed on Page 1; or, 3) a new structure that will be physically separate from, but that will be deemed part of, an existing single family residence that is owned and occupied by myself and located on the property listed on Page 1.

- C. () I further certify that I will perform or supervise the following work:

C.1. () Building C.2. () Fire Protection
I further certify that I will perform the following work:
C.3. () Electrical C.4. () Plumbing

- D. () I agree to advise all contractors on this project that they are required to be registered with the New Jersey Division of Taxation and to comply with all New Jersey tax laws.

I further certify the following as required by the Uniform Construction Code, N.J.A.C. 5:23-2.15(a)5: All required State, county, and local prior approvals have been given, including such certification as the construction official may require.

I understand that if any of the above statements are willfully false, I am subject to punishment.

Signature _____ Date _____

II. AGENT SECTION

(to be completed if the applicant is not the owner in fee)

I hereby certify the following as required by the New Jersey Uniform Construction Code, N.J.A.C. 5:32-2.15(d): the proposed work is authorized by the owner in fee; and I have been authorized by the owner in fee to make this application as his agent.

I further certify the following as required by the Uniform Construction Code, N.J.A.C. 5:23-2.15(a)5: All required State, county, and local prior approvals have been given, including such certification as the construction official may require.

I agree to advise all contractors on this project that they are required to be registered with the New Jersey Division of Taxation and to comply with all New Jersey tax laws.

I understand that if any of the above statements are willfully false, I am subject to punishment.

() Check if contractor.

Agent Name Don Newman

Address 371 Brick Blvd
Brick, NJ 08723

Telephone (908) 471-7327

Signature Don Newman Date 3/16/92

OFFICE DATE RECEIVED: _____

VIII. PRIOR APPROVALS CHECKLIST (office use only)	LOCAL APPROVAL		COUNTY APPROVAL		REGIONAL APPROVAL		STATE APPROVAL		COMMENTS
	Prelimin. Initial	Final Date	Prelimin. Initial	Final Date	Prelimin. Initial	Final Date	Prelimin. Initial	Final Date	
☐ Planning Board									
☐ Zoning Board									
☐ Sewer Authority									
☐ Water Authority									
☐ Fire Department									
☐ Police Department									
☐ Health Department									
☐ Soil Conservation									
☐ N.J. Dept. of Community Affairs									
☐ N.J. Department of Transportation									
☐ N.J. Dept. of Environmental Protect.									
☐ Utility Dig No.									
☒ Other <i>2010</i>	<i>SK</i>	<i>3/16/92</i>	<i>5/9/95</i>						
☐									
☐									

IX. SUBCODES AND SPECIAL REGULATIONS APPLICABLE (office use only—optional)

Name of Code & Edition

Name of Code & Edition

Other

Building _____
 Electrical _____
 Plumbing _____
 Fire Protection _____
 Mechanical _____

Energy _____
 Barrier Free _____
 Flood Hazard _____
 As Built Elevation Cert. _____
 Other _____

X. CERTIFICATES ISSUED

(office use only)

DATE EXPIRED

- ☐ Temporary Certificate of Occupancy
- ☐ Temporary Certificate of Occupancy
- ☐ Continued Certificate of Occupancy
- ☐ Certificate of Occupancy
- ☐ Certificate of Approval
- ☐ None

No. _____
 No. _____
CONSTRUCTION PERMIT

Date Issued 11-2-92
Control #
Permit # 2259-92

IDENTIFICATION Block 547.01 Lot 1.5
Work Site Location 371 Brick Blvd. Contractor Sumo
Owner in Fee Canal Store 795 Address _____
Address same Tele. (____) _____
Lic. No. or Bldrs. Reg. No. _____ Exp. Date _____
Federal Emp. No. _____ or Social Security No. _____

is hereby granted permission to perform the following work:

☐ BUILDING ☐ PLUMBING ☒ OTHER Sign
☐ ELECTRICAL ☐ FIRE PROTECTION

DESCRIPTION OF WORK:

NOTE: If construction does not commence within one (1) year of date of issuance, or if construction ceases for a period of six (6) months, this permit is void.

Estimated Cost of Work \$ 500.

CONSTRUCTION OFFICIAL

PAYMENTS (Office Use Only)	
Building	1.00
Plumbing	1.00
Electrical	15 #
Fire Protection	SIGNS 8.00
Other	PLAN RVW 3.00
Other	C / O 2.00
DCA Training Fee	TOTAL 11.00
Cert. of Occ.	CHECK 11.00
Other	CHANGE 1.00
Total	11.00
Check No.	0028A005 11:45
Cash	
Collected By:	



Date Received 11-2-92
Date Issued
Control #
Permit # 2259-92

A. IDENTIFICATION—APPLICANT: COMPLETE ALL APPLICABLE INFORMATION, WHEN CHANGING CONTRACTORS, NOTIFY THIS OFFICE. CALL UTILITY DIG: 1-800-272-1000.

Block 547.01 Lot 18
Work Site Location 371 Brook Blvd

Owner in Fee CARVEL STORE # 799
Address 371 Brook Blvd, Brook, VT 05723

Tele. (905) 477-7377
Contractor Sana
Address

Tele. ()
Lic. No. or Bldrs. Reg. No.
Federal Emp. No. or Social Security No.

JOB SUMMARY (Office Use Only)		PLAN REVIEW		Date		Initial		INSPECTIONS		Type		Failure		Failure		Approval		Initial	
☒	All	☐	No. Plans Req.																
☒	Footing																		
☐	Foundation																		
☐	Frame																		
☐	Other																		
Joint Plan Review Required:								Insulation											
☐ Elec. ☐ Plumb. ☐ Fire								Finishes:											
SUBCODE APPROVAL								Energy											
☐ CO ☐ CCO ☐ CA								Mechanical											
Date:								TCO											
Approved By:								Other											
								Final											

B. BUILDING CHARACTERISTICS

Use Group Present Proposed
Constr. Class Present Proposed
No. of Stories
Height of Structure Ft.
Area—Largest Floor Sq. Ft.
Total Bldg. Area/All Floors Sq. Ft.
Volume of Structure Cu. Ft.
Total Land Area Disturbed Sq. Ft.

Est. Cost of Bldg. Work:
1. New Bldg. \$
2. Alteration \$
3. Total (1+2) \$

C. CERTIFICATION IN LIEU OF OATH

I hereby certify that I am the (agent of) owner of record and am authorized to make this application.

Signature

D. TECHNICAL SITE DATA
DESCRIPTION OF WORK

Sign (3)

TYPE OF WORK:		(Office Use Only)	
☐	New Building		\$
☐	Addition		\$
☐	Alteration		\$
☐	Roofing		\$
☐	Siding		\$
☐	Other		\$
☐	Demolition		\$
☐	Miscellaneous		\$
☐	Fence	Height	\$
☐	Sign	Sq. Ft.	\$
☐	Pool		\$
☐	Elevator		\$
☐	Asbestos Abatement		\$
☐	Other		\$

Administrative Surcharge		FEE	
Paid ☐ Check #	Minimum Fee		\$
Collected by:	TOTAL FEE		\$



Date Received 11-2-92
Date Issued
Control #
Permit # 2259-92

A. IDENTIFICATION—APPLICANT: COMPLETE ALL APPLICABLE INFORMATION. WHEN CHANGING CONTRACTORS, NOTIFY THIS OFFICE. CALL UTILITY DIG NO: 1-800-272-1000.

Block _____ Lot _____
Work Site Location 371 Brick Blvd
Owner in Fee CARVEL STORE # 799
Address 371 BRICK BLVD
BRICK, NJ 08723
Tele. (908) 477-7377
Contractor Sims
Address _____
Tele. (_____) _____
Lic. No. or Bldrs. Reg. No. _____
Federal Emp. No. _____ or Social Security No. _____

JOB SUMMARY (Office Use Only)

PLAN REVIEW	Date	Initial	INSPECTIONS	Dates (Month/Day)	Initial
			Type	Failure	Approval
☒ No Plans Req.			Footings		
☒ All			Foundation		
☐ Footing			Slab		
☐ Foundation			Frame		
☐ Other			Insulation		
Joint Plan Review Required:			Finishes:		
☐ Elec. ☐ Plumb. ☐ Fire			Energy		
SUBCODE APPROVAL			Mechanical		
☐ CO ☐ CCO ☐ CA			TCO		
Date: _____			Other		
Approved By: _____			Final		

B. BUILDING CHARACTERISTICS

Use Group Present _____ Proposed _____
Constr. Class Present _____ Proposed _____
No. of Stories _____
Height of Structure _____ Ft.
Area—Largest Floor _____ Sq. Ft.
Total Bldg. Area/All Floors _____ Sq. Ft.
Volume of Structure _____ Cu. Ft.
Total Land Area Disturbed _____ Sq. Ft.

Est. Cost of Bldg. Work:
1. New Bldg. \$ _____
2. Alteration \$ _____
3. Total (1+2) \$ _____

C. CERTIFICATION IN LIEU OF OATH

I hereby certify that I am the (agent of) owner of record and am authorized to make this application.

Signature _____

D. TECHNICAL SITE DATA
DESCRIPTION OF WORK

Sigrid (3)

TYPE OF WORK:

- ☐ New Building
- ☐ Addition
- ☐ Alteration
- ☐ Roofing
- ☐ Siding
- ☐ Other _____
- ☐ Demolition
- ☐ Miscellaneous
- ☐ Fence _____ Height _____
- ☐ Sign _____ Sq. Ft. _____
- ☐ Pool
- ☐ Elevator
- ☐ Asbestos Abatement
- ☐ Other _____

(Office Use Only)

FEE

Administrative Surcharge \$ _____
Paid ☐ Check # _____ Minimum Fee \$ _____
Collected by: _____ TOTAL FEE \$ _____

TOWNSHIP OF
BRICK NJ

11/03/92 NO. 5

0004

2259**#

BLOCK 0.00
547 #

LOT 0.00
LOT 0.00

15 #

SIGNS 88.00

PLAN RVW 5.00

C / O 20.00

TOTAL 113.00

CHECK 113.00

CHANGE 0.00

0028A005 16:44

TOWNSHIP OF BRICK

OCEAN COUNTY, NEW JERSEY

401 CHAMBERS BRIDGE ROAD, BRICK, N.J. 08723

Daniel F. Newman, Mayor

Members of Township Council

Mary Anne L. Butler, Council President

Charles E. Anderson

Patrick L. Bottazzi

Edmund H. Hibbard

Joseph C. Scarpelli

Warren H. Wolf

David W. Wolfe



Division of Inspection

A.J. Cierzo,

Construction Official

(201) 477-3000, ext.

CARVEL
STORE CHECK LIST

*Called 4/18/93
left word
with worker*

RE: Block 54701 Lot 15 Address 371 Brick

6441

Please be advised that your application for a construction permit for the subject property has been rejected due to deficiencies in the following areas:

Administrative

Zoning

Engineering

Building

Plumbing

Electric

Fire

*NO SEAC or
UL*


See attached review check list(s) for details as to the reason your submission has been rejected. Please revise your application accordingly and resubmit to this office.

There is a 20 working day time limit for review of all documents submitted with a construction permit application. This time limit ceases in the event of a rejection of any type, and starts over again when the rejection(s) have been corrected and the application resubmitted.


Arthur J. Cierzo,
Construction Official

Date

NAH. NEWNAH

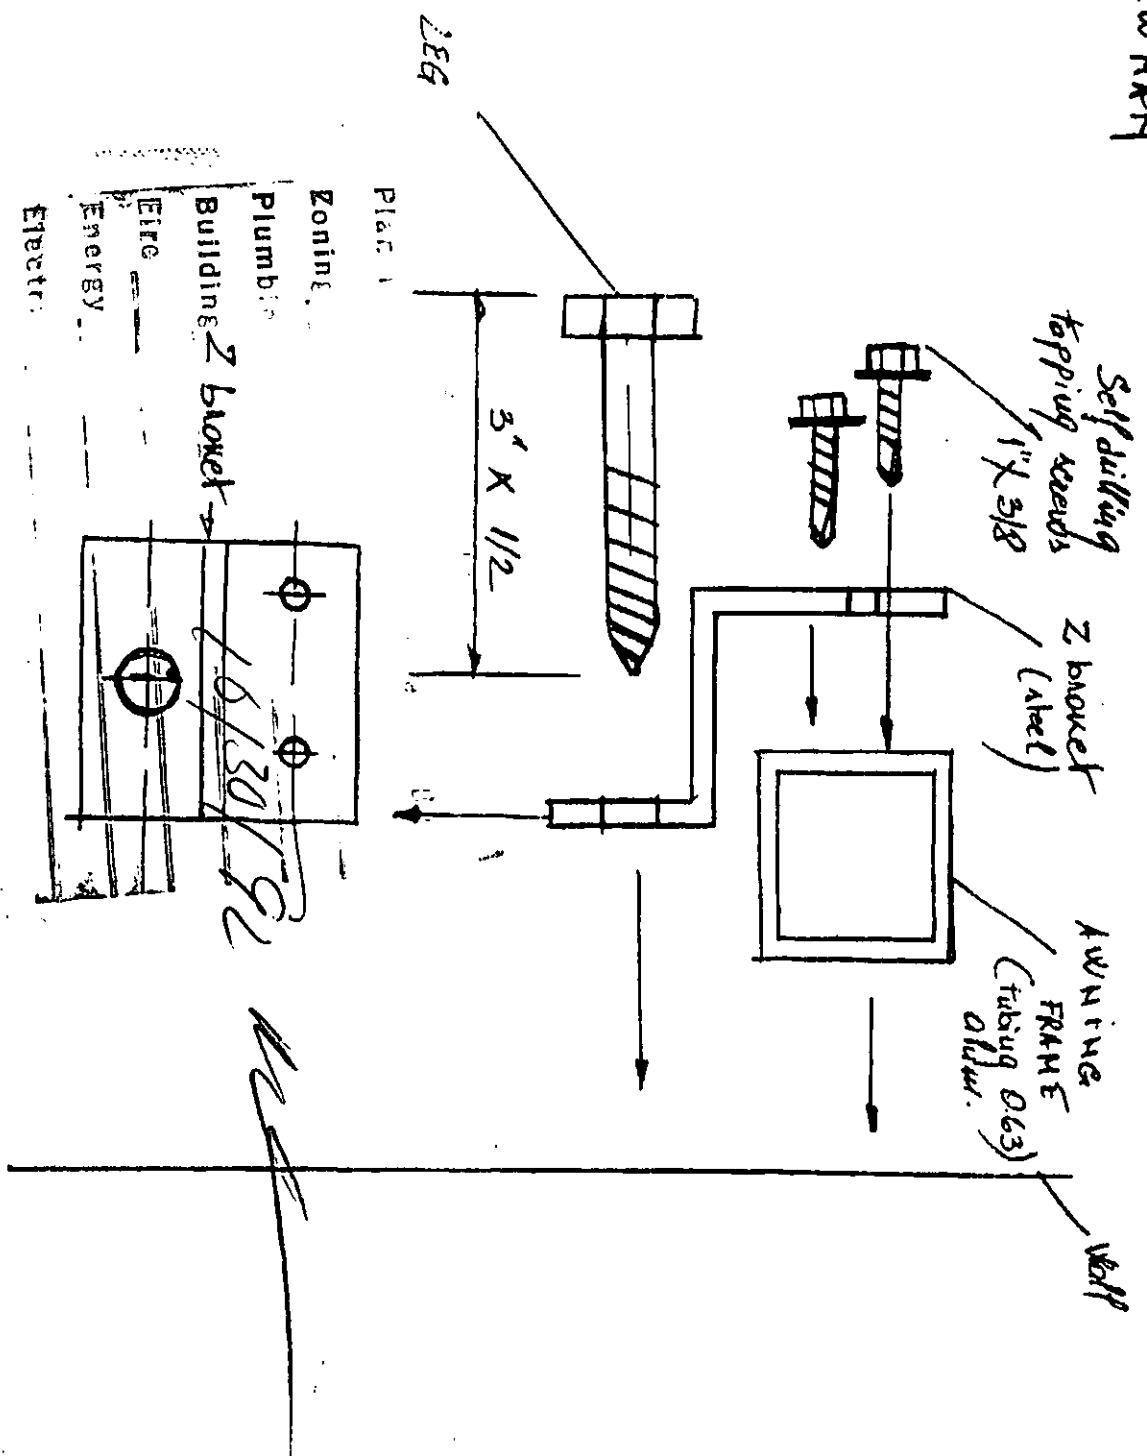


DAN. NEWARK

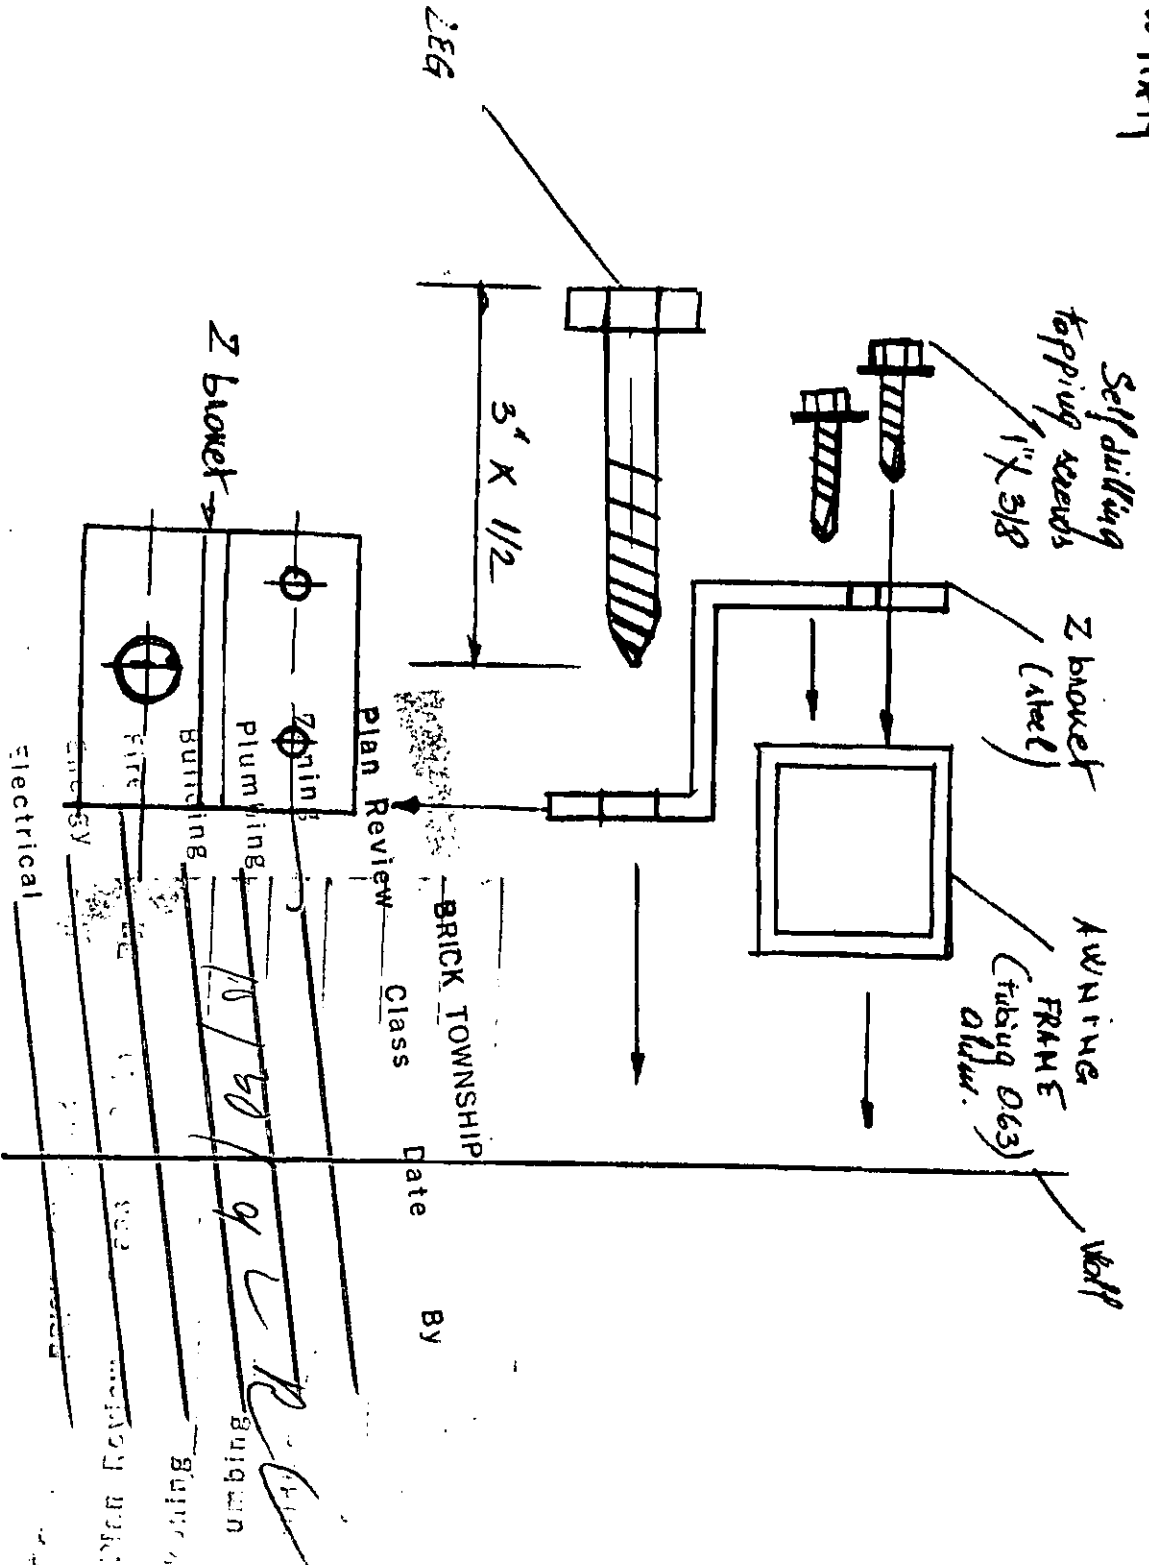

Carvel Store #799
Drumpoint Plaza
371 Brick Blvd.
Brick, NJ 08723

West Wall-Facing Brick Blvd.

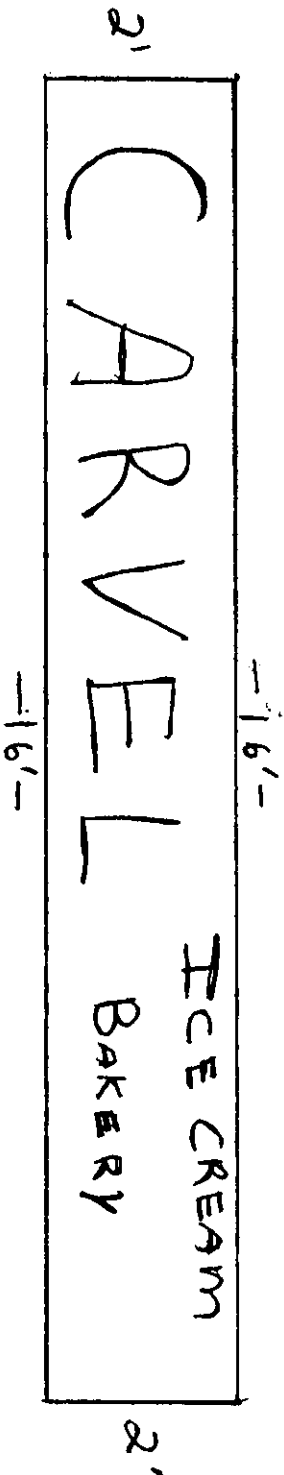

Neon sign w/raceway and lower bar
bolted to the facade w/ power
supplied from the right side of
sign.

APPROVED FOR ZONING ONLY
CITY ENGINEER/PLANNING OFFICER
DATE Jan King 3/16/92
facade

Carvel Store #799
Drumpoint Plaza
3771 Brick Blvd.
Brick, NJ 08723

Outside Canopy

14'

2'

CARVEL ICE CREAM
BAKERY

2'

14'

Aluminum Frame
Canvas Cover
Lighting Under Cover

Permanent sign, bolted to facade

APPROVED FOR ZONING ONLY

SEAL: PLANNING & ZONING OFFICER

DATE Sean Young 3/16/98

facade

Carvel Store #799
Drumpoint Plaza
371 Brick Blvd.
Brick, NJ 08723

Outside Canopy




3/8 Painted Plywood

Temporary sign, no lighting, bolted to facade



APPROVED FOR ZONING ONLY
CEAL KIMMEL, ZONING OFFICER
DATE Jan 11/1992
facade

Carvel

ice cream
bakery

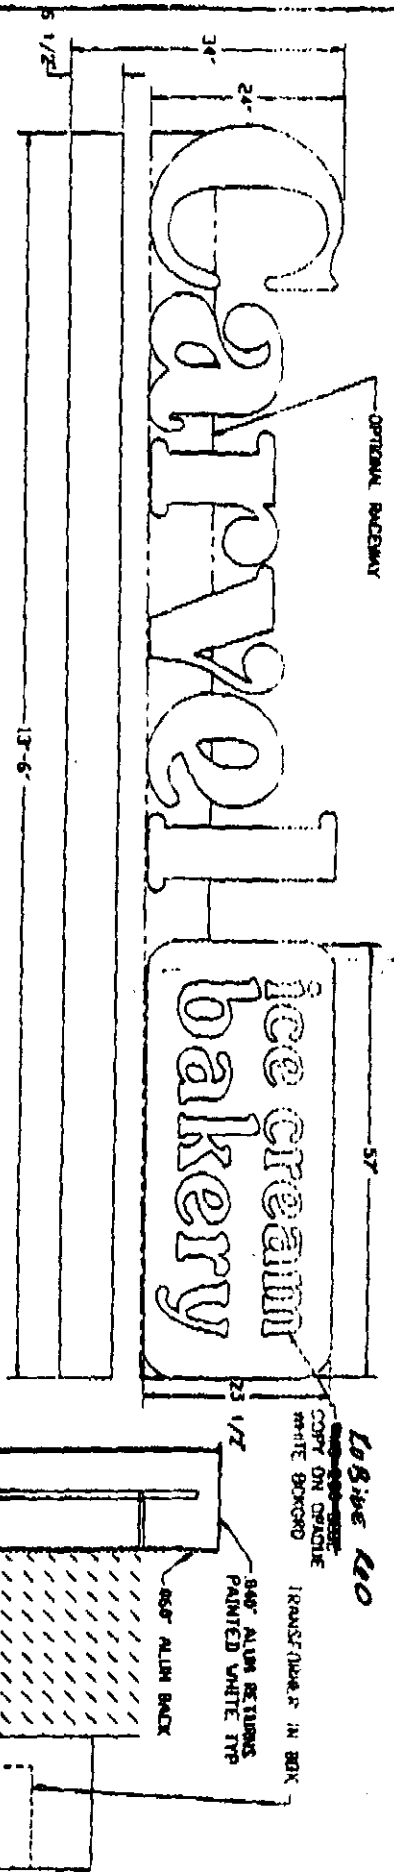

ELEVATION

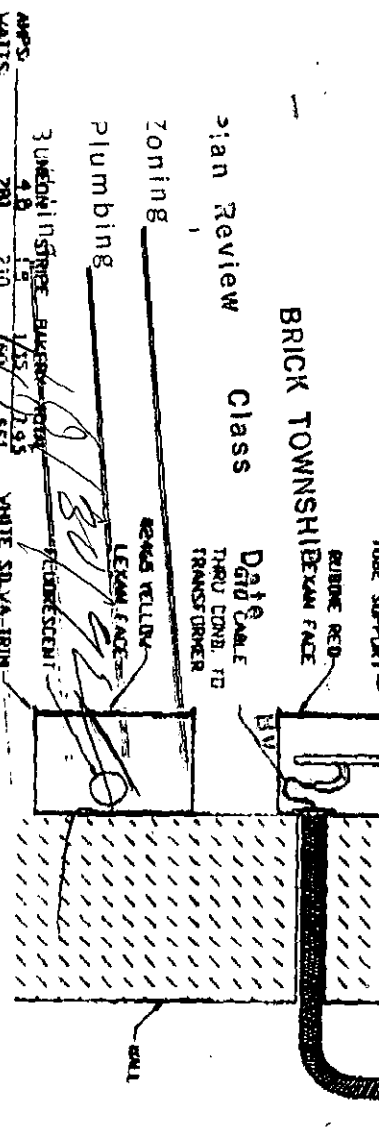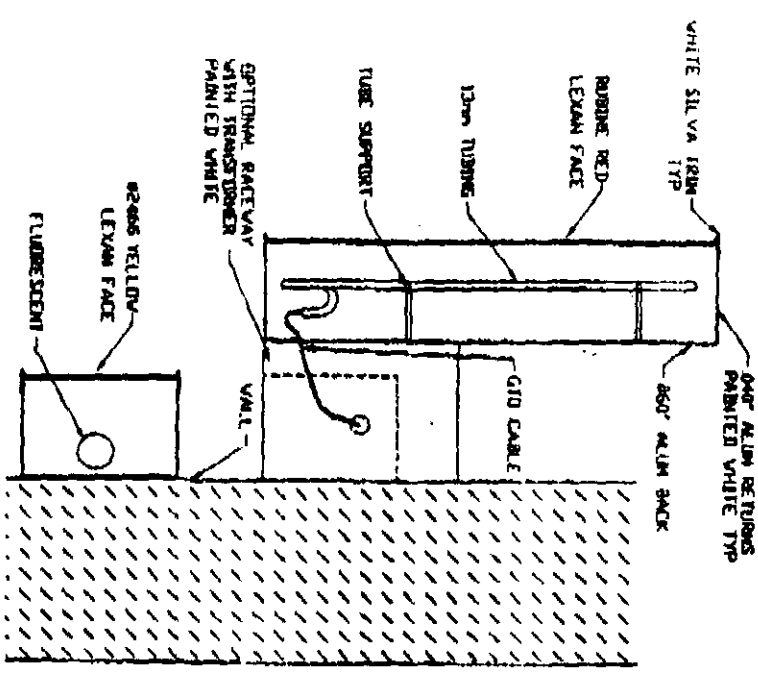

Signs to be installed & lettered (inset B)

APPS	WATTS	VDC	TYPE	WHITE SILVA IRON TYP
3	4.0	281	1/2	500
1	1.5	210	1/2	500
1	1.5	210	1/2	500
1	1.5	210	1/2	500

Electric

REVISIONS

DUALITE, INC. WILLIAMSBURG, OH.
PREPARED FOR INSTALLATION USE ONLY

MODEL: CARVEL 24' & 15 1/4" NEON LETTERS

SCALE: NOTED

DATE: 7/29/91
SHEET NO: 1
DRAWING NO: 4291

TYP SEC W/RACEWAY

TYP SEC W/REMOTE TRANSFORMER

Log:inc 420
COPY ON GRAPHIC WHITE BOARD

TRANSFORMER IN BOX