

1. State Specific Use:

CERTIFICATION IN LIEU OF OATH

I. OWNER SECTION (to be completed if the applicant is the owner in fee)

I hereby certify that I am the owner in fee of the property listed on Page 1.

Mark the following applicable boxes:

A. ☐ I further certify that a new home (private residence) will be constructed on this property for my own use and occupancy. This dwelling is to be occupied by myself and is not to be used for any purpose other than single family residential use. I attest that all construction, plumbing, or electrical work will be done, in whole or in part, by me or by subcontractors under my supervision, in accordance with all applicable laws; and, I further acknowledge that said new home is not covered under the New Home Warranty and Builders Registration Act (N.J.S.A. 46:3B-1 et seq.) and that such fact shall be disclosed to any person purchasing this property within ten years of the date of issuance of a certificate of occupancy.

I UNDERSTAND THAT IN MARKING BOX A, I ACKNOWLEDGE THAT I AM ASSUMING RESPONSIBILITY FOR THE WORK DONE ON SAID PROPERTY, THE CONDITION OF THE PROPERTY PRIOR TO, DURING, AND AFTER ANY WORK PERFORMED, AND FOR THE PERFORMANCE OF THE SUBCONTRACTORS I HIRE, EMPLOY, OR OTHERWISE CONTRACT OR WITH WHOM I MAKE AGREEMENTS TO PERFORM WORK. I AM VOLUNTARILY AND KNOWINGLY ASSUMING THIS RESPONSIBILITY.

B. ☐ I further certify the following as required by the New Jersey Uniform Construction Code, N.J.A.C. 5:23-2.15(e)1.vii:

I personally prepared the plans submitted for: 1) the new home referred to in A.; or, 2) an addition, alteration, renovation, or repair to an existing single family residence owned and occupied by myself and located on the property listed on Page 1; or, 3) a new structure that will be physically separate from, but that will be deemed part of, an existing single family residence that is owned and occupied by myself and located on the property listed on Page 1.

C. ☐ I further certify that I will perform or supervise the following work:

C.1. ☐ Building C.2. ☐ Fire Protection

I further certify that I will perform the following work:

C.3. ☐ Electrical C.4. ☐ Plumbing

D. ☐ I agree to advise all contractors on this project that they are required to be registered with the New Jersey Division of Taxation and to comply with all New Jersey tax laws.

I further certify the following as required by the Uniform Construction Code, N.J.A.C. 5:23-2.15(a)5: All required State, county, and local prior approvals have been given, including such certification as the construction official may require.

I understand that if any of the above statements are willfully false, I am subject to punishment.

Signature Mrs. Michael Bailey Date Nov. 14, 1996

II. AGENT SECTION

(to be completed if the applicant is not the owner in fee)

I hereby certify the following as required by the New Jersey Uniform Construction Code, N.J.A.C. 5:32-2.15(d): the proposed work is authorized by the owner in fee; and I have been authorized by the owner in fee to make this application as his agent.

I further certify the following as required by the Uniform Construction Code, N.J.A.C. 5:23-2.15(a)5: All required State, county, and local prior approvals have been given, including such certification as the construction official may require.

I agree to advise all contractors on this project that they are required to be registered with the New Jersey Division of Taxation and to comply with all New Jersey tax laws.

I understand that if any of the above statements are willfully false, I am subject to punishment.

☐ Check if contractor.

Agent Name _____

Address _____

Telephone (____) _____

Signature _____ Date _____

OFFICE DATE RECEIVED: _____

VIII. PRIOR APPROVALS CHECKLIST (office use only)	LOCAL APPROVAL		COUNTY APPROVAL		REGIONAL APPROVAL		STATE APPROVAL		COMMENTS
	Prelimin. Initial	Final Date	Prelimin. Initial	Final Date	Prelimin. Initial	Final Date	Prelimin. Initial	Final Date	
☐ Zoning Officer									IMPORTANT A.H.B.T. - EXEMPT
☐ Planning Board									
☐ Zoning Board									
☐ Sewer Authority									
☐ Water Authority									
☐ Fire Department									
☐ Police Department									
☐ Health Department									
☐ Soil Conservation									
☐ N.J. Dept. of Community Affairs									
☐ N.J. Department of Transportation									
☐ N.J. Dept. of Environmental Protect.									
☐ Utility Dig No.									
☐									
☐									

IX. SUBCODES AND SPECIAL REGULATIONS APPLICABLE (office use only—optional)

Name of Code & Edition Building _____ Electrical _____ Plumbing _____ Fire Protection _____ Mechanical _____	Name of Code & Edition Energy _____ Barrier Free _____ Flood Hazard _____ As Built Elevation Cert. _____ Other _____	Other _____
---	---	-------------

X. CERTIFICATES ISSUED ☐ Temporary Certificate of Occupancy ☐ Temporary Certificate of Compliance ☐ Continued Certificate of Occupancy ☐ Certificate of Compliance ☐ Certificate of Occupancy ☐ Certificate of Approval	(office use only) DATE ISSUED _____ DATE EXPIRED _____ DATE REISSUED _____ DATE EXPIRED _____
--	--



**BUILDING
SUBCODE
TECHNICAL SECTION**



Date Received
Date Issued
Control #
Permit #

1/21/96
2989-96

C. CERTIFICATION IN LIEU OF OATH

I hereby certify that I am the (agent of) owner of record and am authorized to make this application.

Signature

Michael Bailey

D. TECHNICAL SITE DATA

DESCRIPTION OF WORK

Vinyl Siding on entire house.
Free-Standing Deck
Abutting House.

A. IDENTIFICATION—APPLICANT: COMPLETE ALL APPLICABLE INFORMATION, WHEN CHANGING CONTRACTORS, NOTIFY THIS OFFICE. CALL UTILITY DIG NO: 1-800-272-1000.

Block 848 Lot 1723 W Princeton Ave
Work Site Location 1723 W Princeton Ave
Owner in Fee Michael Bailey
Address 1723 W Princeton Ave
Brick N.J. 08724-9918
Tel [REDACTED]
Contractor Homeowner Michael Bailey
Address _____
Tele. (____) _____
Lic. No. or Bids. Reg. No. _____
Federal Emp. No. _____ or Social Security No. _____

JOB SUMMARY (Office Use Only)

PLAN REVIEW	Date	Initial	INSPECTIONS	Dates (Month/Day)	Approval	Initial
☐ No Plans Req.	11/21/96	<i>[Signature]</i>	Foundation	9/5/97	<i>[Signature]</i>	
☐ All			Footings			
☐ Footing			Foundation			
☐ Foundation			Slab			
☐ Frame			Frame			
☐ Other			Insulation			
Joint Plan Review Required:			Finishes:			
☐ Elec. ☐ Plumb. ☐ Fire			Energy			
SUBCODE APPROVAL			Mechanical			
☐ CO ☐ CCO ☒ CA			TCO			
Date: _____			Other			
Approved By: <i>[Signature]</i>			Final			

B. BUILDING CHARACTERISTICS

Use Group Present _____ Proposed _____
Constr. Class Present _____ Proposed _____
No. of Stories _____
Height of Structure _____ Ft.
Area—Largest Floor _____ Sq. Ft.
New Bldg. Area/All Floors _____ Sq. Ft.
Volume of New Structure _____ Cu. Ft.
Total Land Area Disturbed _____ Sq. Ft.

Est. Cost of Bldg. Work:
1. New Bldg. \$ _____
2. Alteration \$ _____
3. Total (1+2) \$ _____

(Office Use Only)
FEE

TYPE OF WORK:	
☐ New Building	
☐ Addition	
☐ Alteration	
☐ Roofing	
☒ Siding	
☐ Fence	Height (6' or over)
☐ Sign	Sq. Ft.
☐ Pool	
☐ Asbestos Abatement	
☒ Other	<i>Deck</i>
☐ Demolition	

Paid ☐ Check # _____
Collected by: _____
Administrative Surcharge \$ _____
Minimum Fee \$ _____
DCA TRAINING FEE \$ _____
TOTAL FEE \$ _____



**BUILDING
SUBCODE
TECHNICAL SECTION**



Date Received
Date Issued
Control #
Permit #

1/21/96
2989-96

A. IDENTIFICATION—APPLICANT: COMPLETE ALL APPLICABLE INFORMATION. WHEN CHANGING CONTRACTORS, NOTIFY THIS OFFICE. CALL UTILITY DIG NO: 1-800-272-1000.

Block 848 1723 W Polk Polk Polkton Ave
Work Site Location
Owner in Fee Michael Bailey
Address 1723 W Polkton Ave
Polk N.J. 08724-2918
Tele. ()
Contractor Homeowner Michael Bailey
Address
Tele. ()
Lic. No. or Bids. Reg. No. _____
Federal Emp. No. _____ or Social Security No. _____

JOB SUMMARY (Office Use Only)

PLAN REVIEW	Date	Initial	INSPECTIONS	Dates (Month/Day)	Approval	Initial
☐ No Plans Req.	11/21/96	J. Bailey	Footings	9/5/92	J. Bailey	
☐ All			Foundation			
☐ Footing			Slab			
☐ Foundation			Frame			
☐ Other			Insulation			
Joint Plan Review Required:			Finishes:			
☐ Elec.			Energy			
☐ Plumb.			Mechanical			
SUBCODE APPROVAL			TCO			
☐ CO			Other			
☐ CC			Final			

B. BUILDING CHARACTERISTICS

Use Group Present _____ Proposed _____
Constr. Class Present _____ Proposed _____
No. of Stories _____
Height of Structure _____ Ft.
Area—Largest Floor _____ Sq. Ft.
New Bldg. Area/All Floors _____ Sq. Ft.
Volume of New Structure _____ Cu. Ft.
Total Land Area Disturbed _____ Sq. Ft.

Est. Cost of Bldg. Work:

1. New Bldg. \$ _____
2. Alteration \$ _____
3. Total (1 + 2) \$ _____

C. CERTIFICATION IN LIEU OF OATH

I hereby certify that I am the (agent of) owner of record and am authorized to make this application.

Signature

Michael Bailey

D. TECHNICAL SITE DATA

DESCRIPTION OF WORK

Vinyl Siding on entire house.
Free-standing Deck
Abutting House.

TYPE OF WORK:

☐ New Building
☐ Addition
☐ Alteration
☒ Roofing
☒ Siding
☐ Fence
☐ Sign
☐ Pool
☐ Asbestos Abatement
☒ Other Deck
☐ Other
☐ Demolition

Height (6' or over)
Sq. Ft.

(Office Use Only)

FEE

Administrative Surcharge \$ _____
Paid ☐ Check # _____ Minimum Fee \$ _____
Collected by: _____ DCA TRAINING FEE \$ _____
TOTAL FEE \$ _____



Date Received
Date Issued
Control #
Permit #

1/21/96
2989-96

A. IDENTIFICATION—APPLICANT: COMPLETE ALL APPLICABLE INFORMATION WHEN CHANGING CONTRACTORS. NOTIFY THIS OFFICE. CALL UTILITY DIG NO. 1-800-272-1000.

Block 848 Lot 1
Work Site Location 1723 W Pringle Ave

Owner in Fee Michael Bailey
Address 1723 W Pringle Ave
Rt. 1, N 08724.3910

Contractor Homeowner Michael Bailey

Address _____

Tele. (____) _____

Lic. No. or Bldg. Reg. No. _____
Federal Emp. No. _____ or Social Security No. _____

C. CERTIFICATION IN LIEU OF OATH

I hereby certify that I am the (agent of) owner of record and am authorized to make this application.

Signature Michael Bailey

D. TECHNICAL SITE DATA

DESCRIPTION OF WORK

Vinyl Siding on entire house.
Free-standing Deck
Abutting House.

JOB SUMMARY (Office Use Only)	
PLAN REVIEW	INSPECTIONS
Date	Initial
☐ No Plans Req.	☐ No Plans Req.
☐ All	☐ All
☐ Footing	☐ Footing
☐ Foundation	☐ Foundation
☐ Frame	☐ Frame
☐ Other	☐ Other
Joint Plan Review Required:	Insulation
☐ Elec. ☐ Plumb. ☐ Fire	Finishes
SUBCODE APPROVAL	Energy
☐ CO ☐ CCO ☐ CA	Mechanical
Date: _____	TCO
Approved By: _____	Other
	Final

TYPE OF WORK:	
☐ New Building	
☐ Addition	
☐ Alteration	
☐ Roofing	
☒ Siding	Height (6' or over)
☐ Fence	Sq. Ft.
☐ Sign	
☐ Pool	
☐ Asbestos Abatement	
☒ Other <u>Deck</u>	
☐ Other	
☐ Demolition	

B. BUILDING CHARACTERISTICS

Use Group Present Proposed
Constr. Class Present Proposed
No. of Stories _____
Height of Structure _____ Ft.
Area—Largest Floor _____ Sq. Ft.
New Bldg. Area/All Floors _____ Sq. Ft.
Volume of New Structure _____ Cu. Ft.
Total Land Area Disturbed _____ Sq. Ft.

Est. Cost of Bldg. Work:

1. New Bldg. \$ _____
2. Alteration \$ _____
3. Total (1+2) \$ _____

Administrative Surcharge	
Paid ☐ Check # _____	Minimum Fee \$ _____
Collected by: _____	DCA TRAINING FEE \$ _____
	TOTAL FEE \$ _____

(Office Use Only)
FEE


TOWNSHIP OF BRICK
ZONING PERMIT


Date of Issue: 11/18/96 1996 - 1628
Block 848 Lot 20 & 21 Zone R-10
Property Address: 1723 West Princeton Avenue
Owner: Michael Bailey (Phone: [REDACTED])
Applicant: Same as above (Phone): _____
Use: Single Family Residential
Proposed Construction (if any): Detached deck - 160 sq ft.


Conditions: The deck must be setback a minimum of 10 feet
from the side and rear property lines.

Please note that a Construction Permit, as well as a Zoning Permit, must be obtained prior to any construction. You will be notified by the Division of Inspections to pick up and pay for your entire Construction Permit.


This permit shall be null, void and of no effect if any of the facts contained in the application upon the basis of which this permit was granted are false or untrue in any material respect. This permit shall expire one (1) year after the date of issuance if the use or substantial construction has not been commenced.

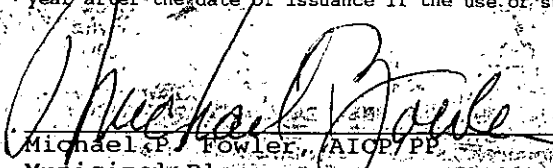
Michael P. Fowler, AICP/PP
Municipal Planner

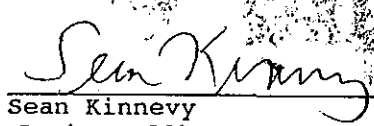

Sean Kinnevy
Zoning Officer

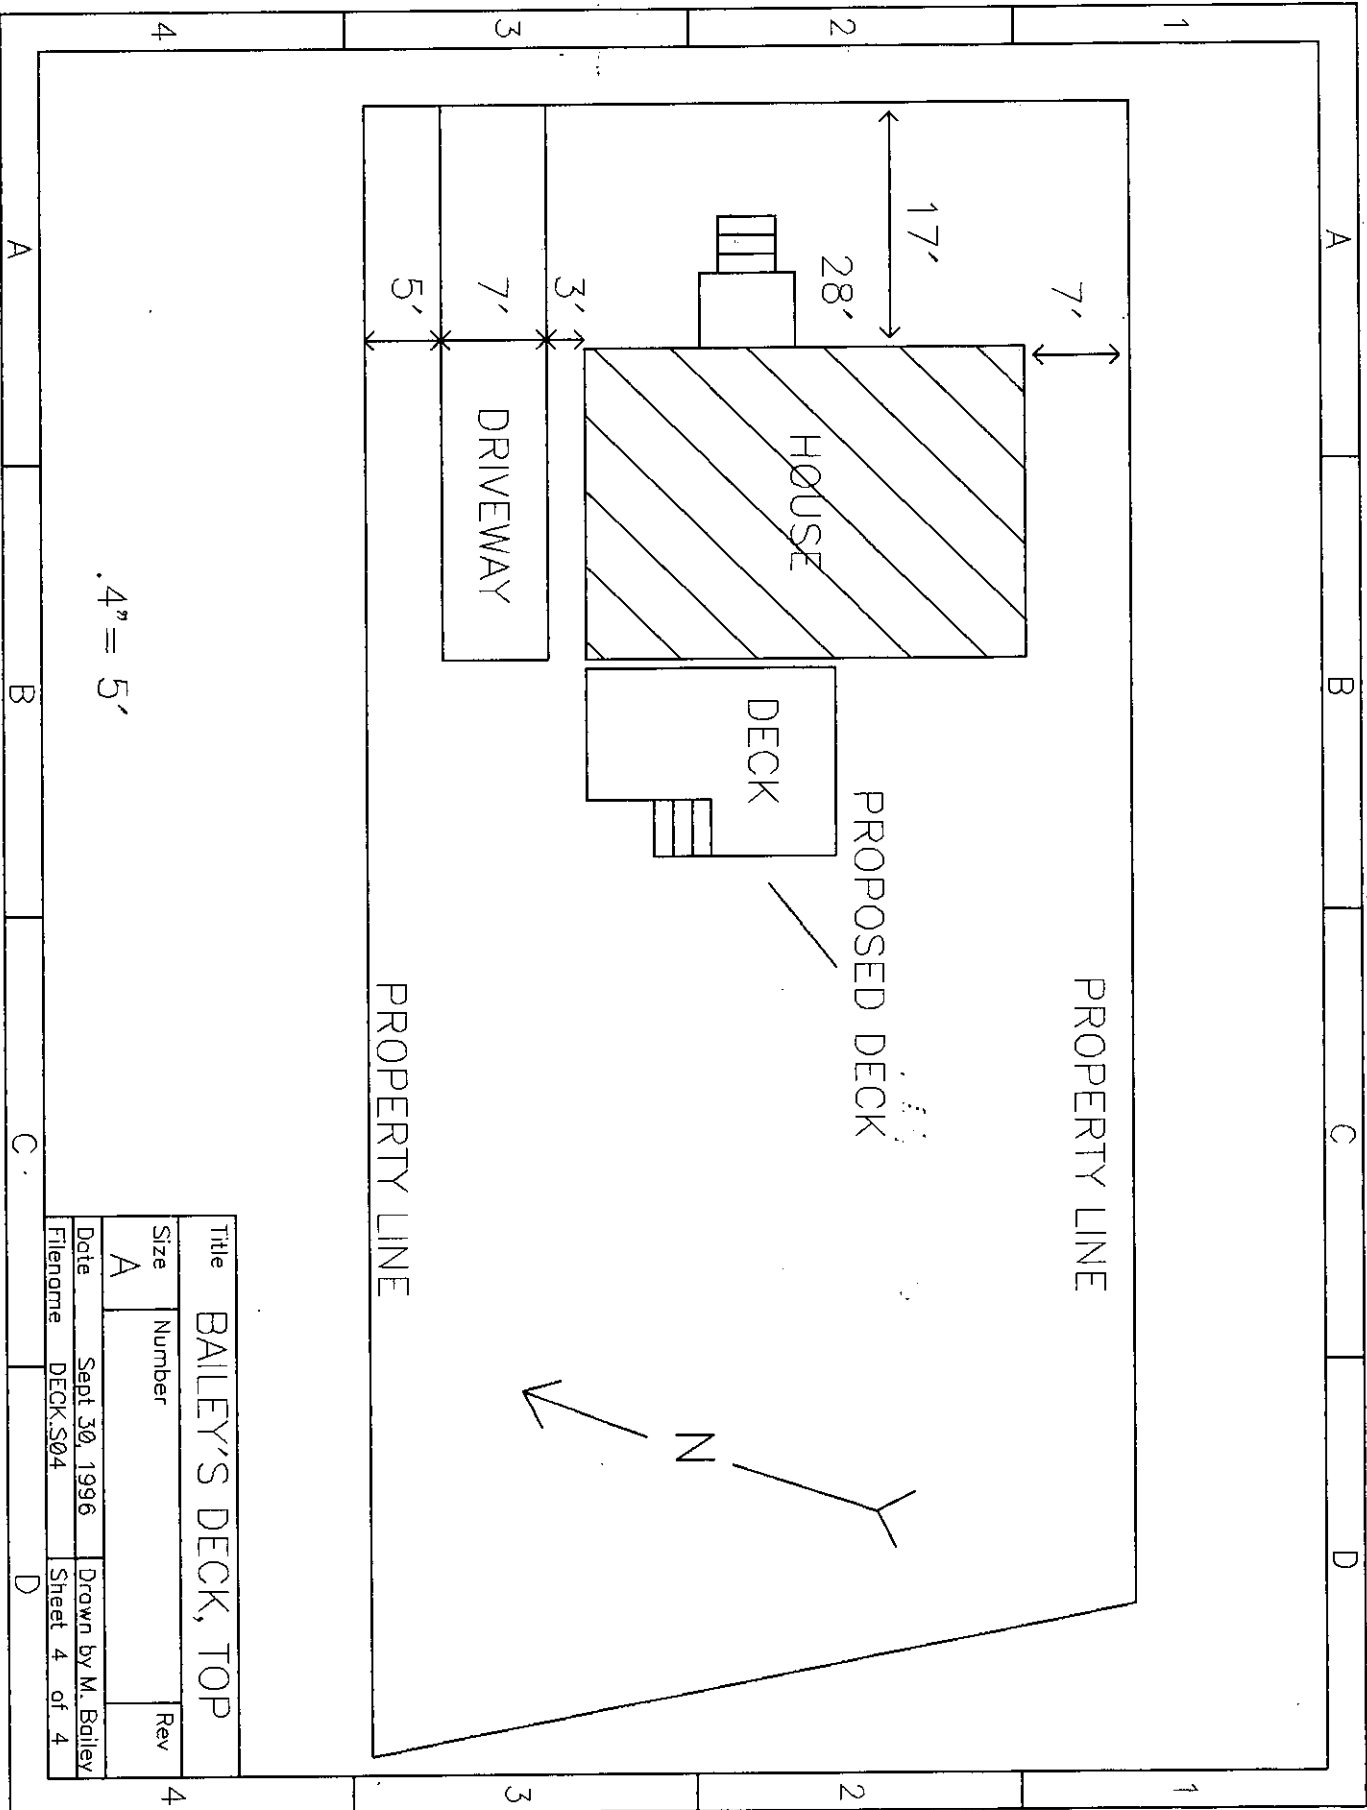


Mrs. Michael Bailey

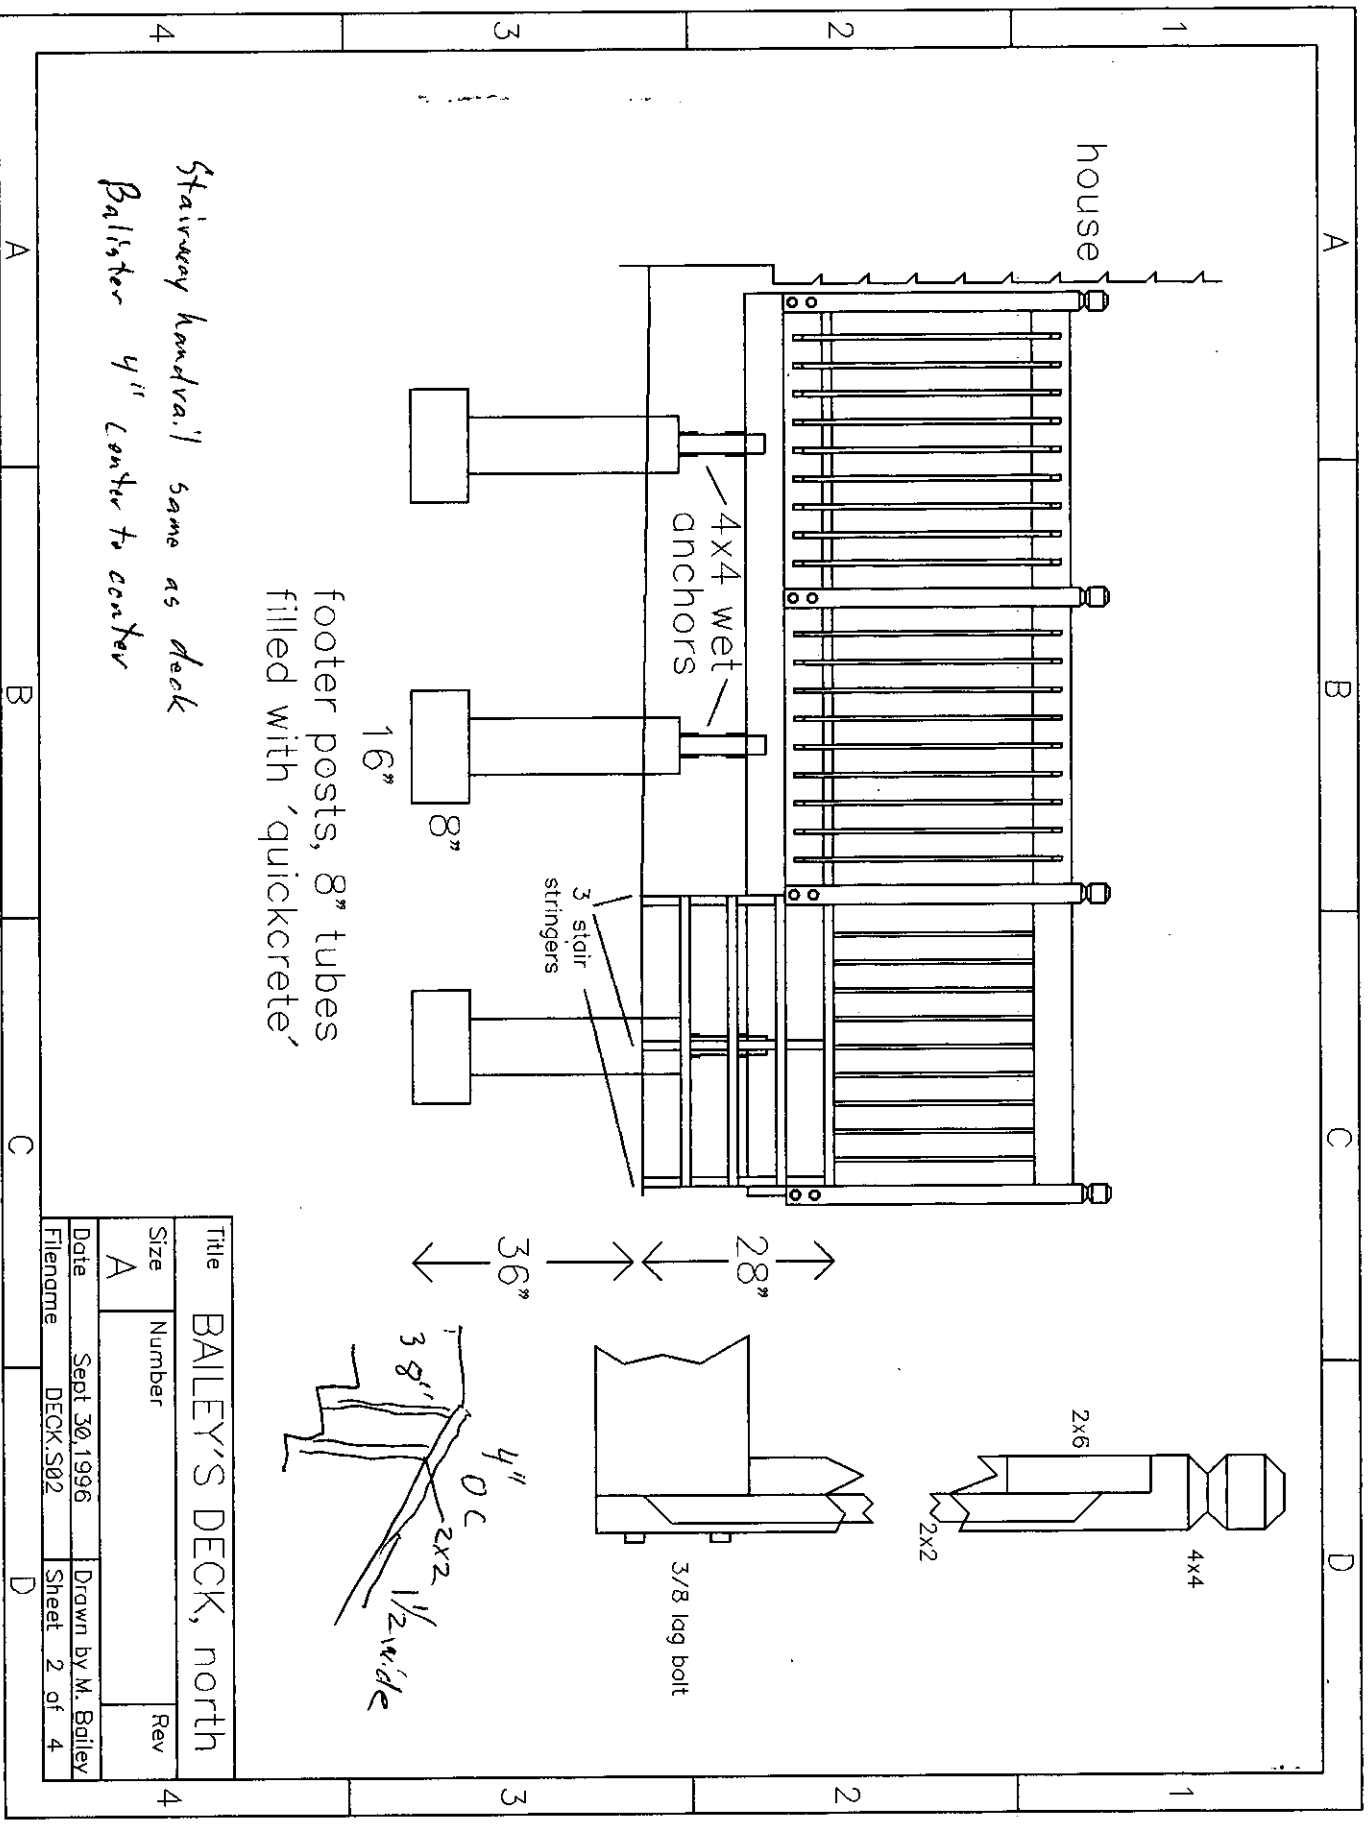

Mrs. Michael Bailey

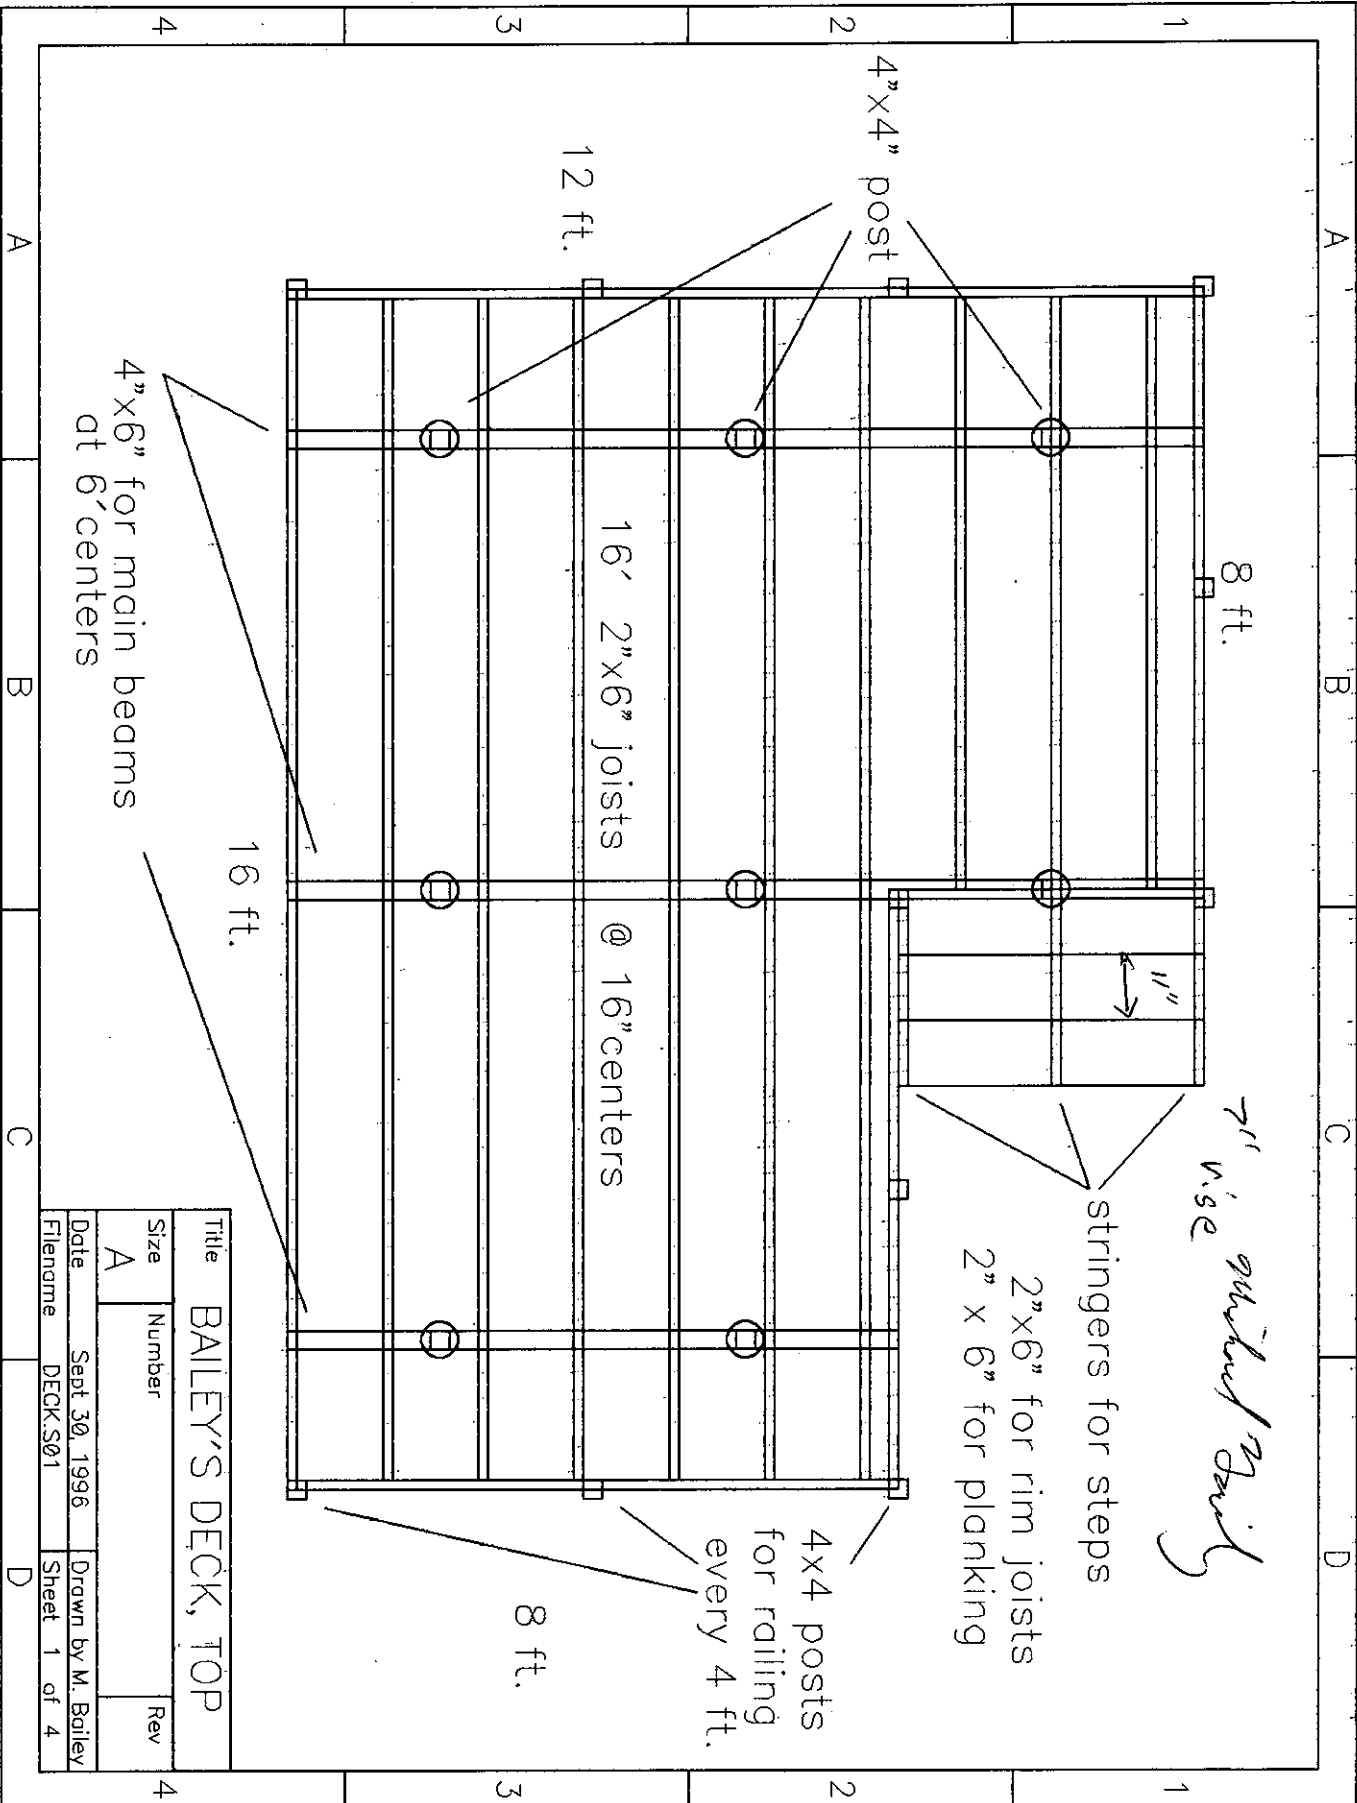

Mrs. Michael Bailey

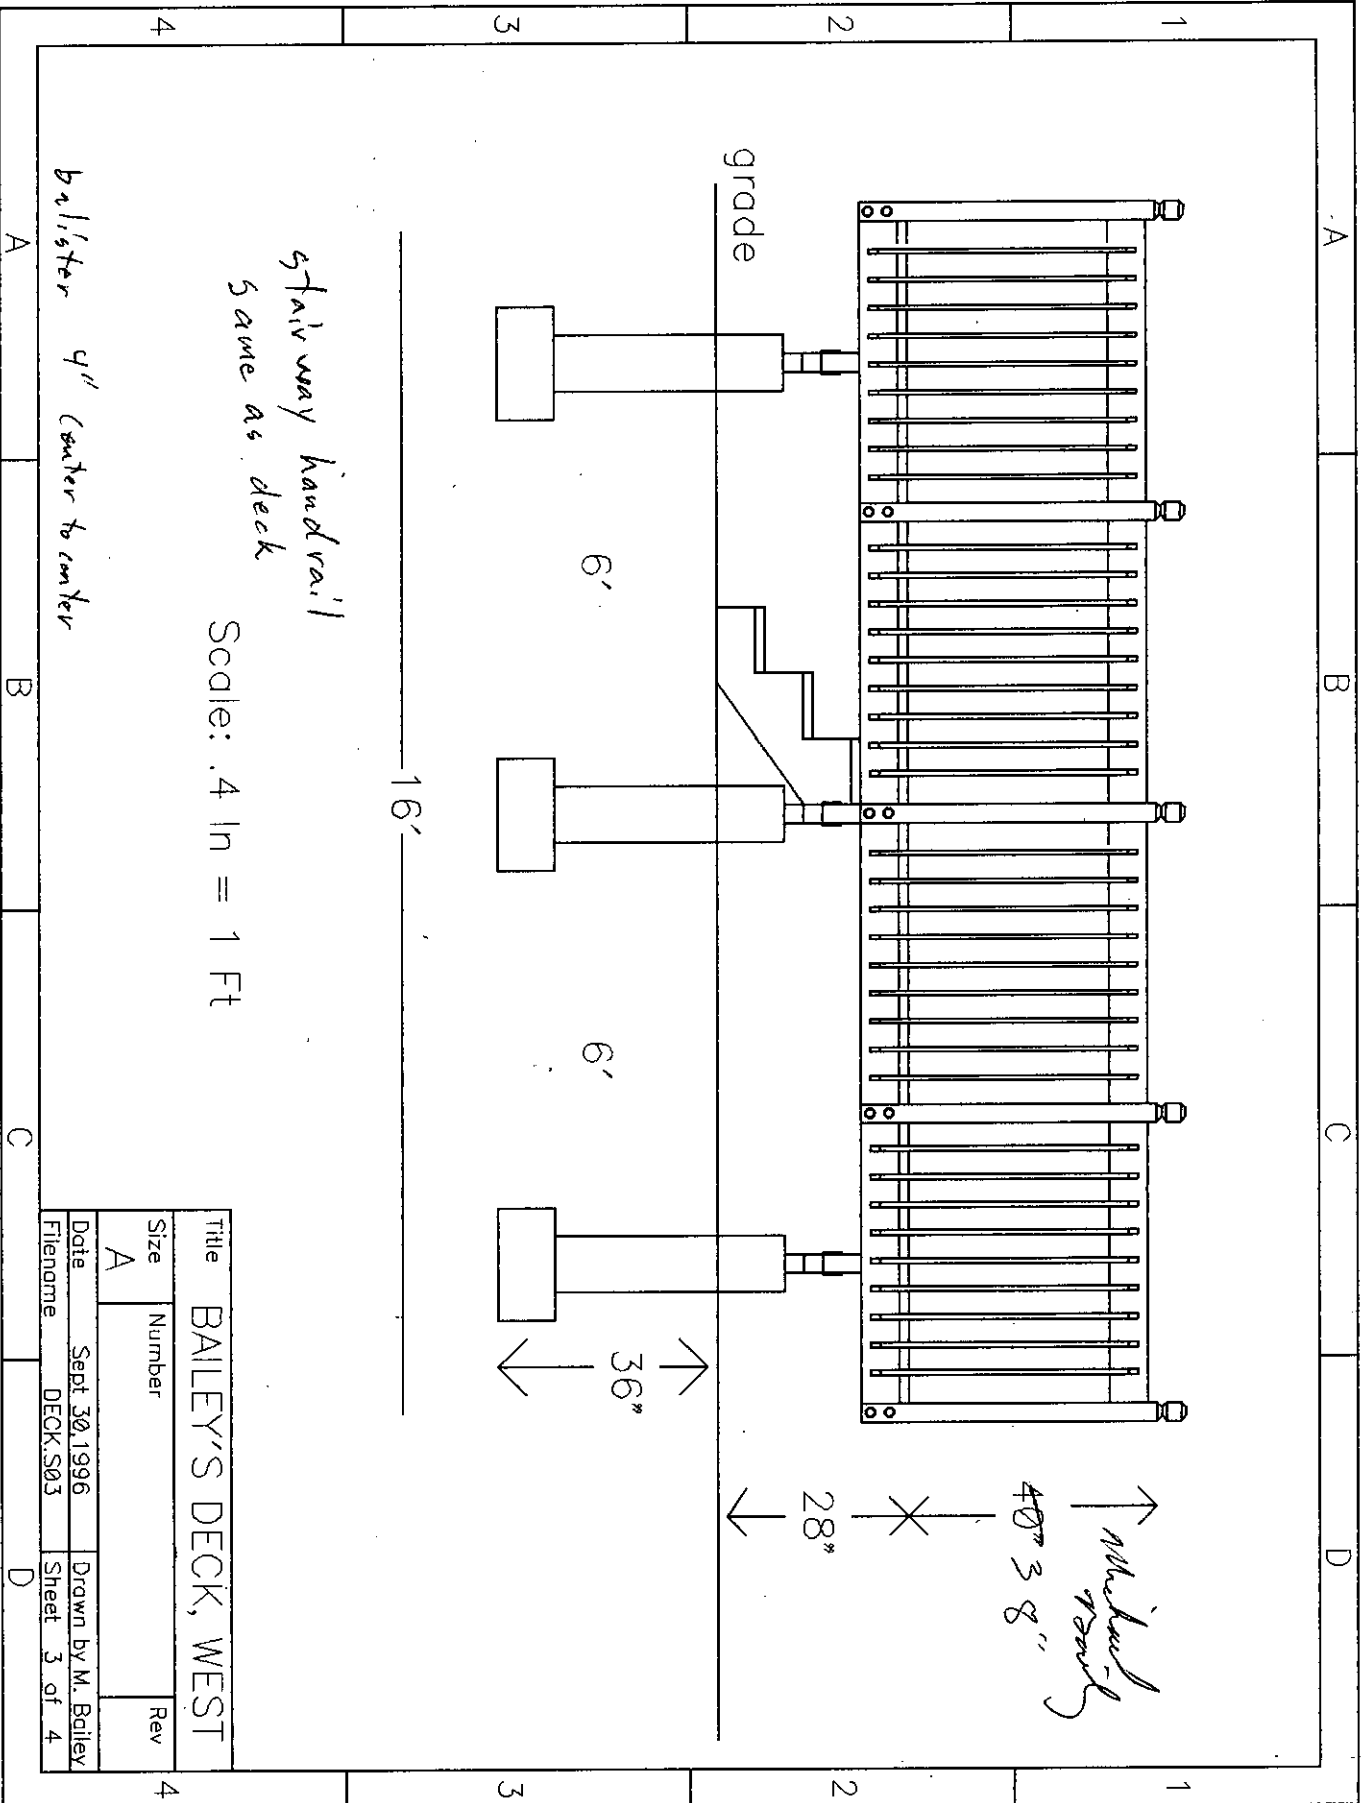

Mo. Michael Bailey

BRICK TOWNSHIP

Plan Review Class Date By

Zoning _____

Plumbing _____

Building 11/21/96 J. Hays

Fire _____

Energy _____

Electrical _____

BOCA® PLAN REVIEW RECORD

Valuation: _____

Plan Review #: _____

Fee: _____

NATIONAL BUILDING CODE
(All Articles except 24, 28, 29, 30, 31 and 32)

Date: _____

JURISDICTION: _____

(City, County, Township, etc.)

BUILDING LOCATION: 1723 W. Puncato Ave

(Street address)

BUILDING DESCRIPTION: _____

REVIEWED BY: _____

Numerals indicated in parenthesis are applicable code sections of the 1987 BOCA National Building Code.

CORRECTION LIST

No.	DESCRIPTION	Code Section
1	Need info on guardrail baluster spacing? 4" center	
2	Need height and details of handrail on steps. width? 1 1/2" height? 40" > 38" spacing? 4" Sliding width? 4 feet	
	Called 11-20-96. OK. Left Message	

The plan review accomplished as indicated in this record is limited to those code sections specifically identified herein. Copyright, 1987, Building Officials and Code Administrators International, Inc. Reproduction by any means is prohibited. BOCA® is a trademark of Building Officials and Code Administrators International, Inc., and is registered in the U.S. Patent and Trademark Office. NOTE: In order that we might develop other programs and provide additional services of benefit to the Code Administration profession, please re-order additional copies of this form from:



BUILDING OFFICIALS AND CODE ADMINISTRATORS INTERNATIONAL, INC.
4051 W. FLOSSMOOR ROAD COUNTRY CLUB HILLS, ILLINOIS 60477-5795

Applicable to Ordinance 728-92

This form must be handed in with permit application or a permit will not be issued.

TOWNSHIP OF BRICK

1723 W. Princeton Avenue, Brick 848 20,21
Work Site Address Block Lot

Michael Bailey, 1723 W. Princeton Avenue, Brick, NJ
Owner's Name, Address, Phone

Home owner.
Contractor's Name, Address, Phone

Construction Deck
Describe type (Single -family home, etc.)

Demolition Back Porch
Describe type (Structure, roof, siding, etc.)

Describe type and estimated quantity of material 1 yard concrete

Name, address and phone of party responsible for removal of debris:

Home owner

Size of dumpster: _____

Destination of discarded debris: _____

Hauler's DEP Permit No.: _____

****Note:** Any recyclable material, including, but not limited to: corrugated cardboard, vegetative waste, concrete, asphalt, clean wood, etc., must be delivered to an approved recycling center, and receipts provided to the Township of Brick along with tipping receipts for non-recyclable material.

Generator's Certification: Under penalty of criminal and civil prosecution, for the making or submission of false statements, representations or omissions, I declare, on behalf of the generator that the contents of this document are fully and accurately described above and have been disposed or recycled in accordance with all applicable State and Federal laws and regulations, and that I have been authorized, in writing, to make such declarations by the person in charge of the generator's operation.

Michael Bailey Michael Bailey 10/2/96
Printed/Typed Name Signature Date

FOR OFFICE USE ONLY

MUST BE COMPLETED BEFORE CERTIFICATE OF OCCUPANCY OR CERTIFICATION OF APPROVAL IS ISSUED

Recycling tonnage receipts attached? _____

Certified tipping receipts attached? _____


****Note:** Receipts must show certified weights, date of disposal and name and address of disposal center.

DISTRIBUTION LIST:

1. Original to Code Enforcement Officer
2. Construction Code Office
3. Applicant

NOTE: NO ATTEMPT WAS MADE OR IT IS ASSUMED TO DETERMINE IF ANY PORTION OF THIS PROPERTY IS CLAIMED BY THE STATE OF NEW JERSEY AS TIDELANDS. ENVIRONMENTALLY SENSITIVE AREAS ARE NOT LOCATED BY THIS SURVEY.

THIS SURVEY IS SUBJECT TO CONDITIONS WHICH AN APPROPRIATE TITLE SEARCH MIGHT DISCLOSE.

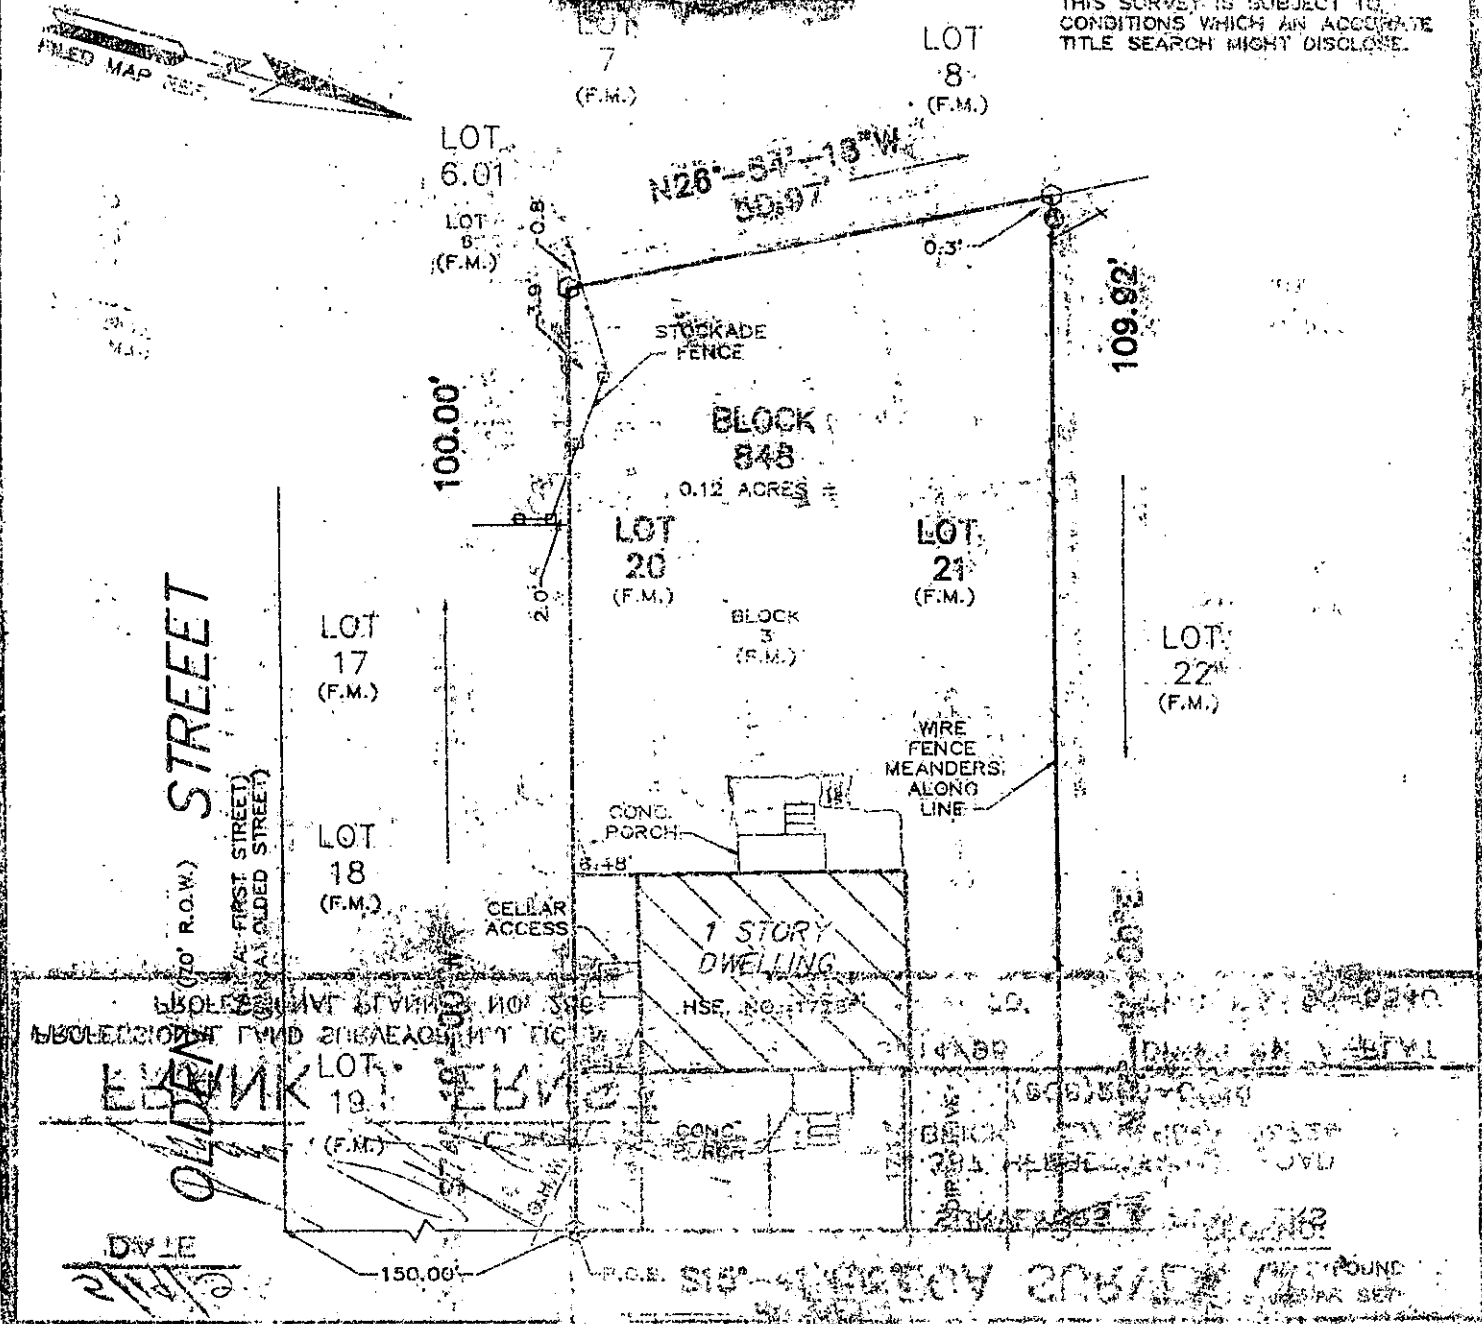

WEST PRINCETON, NEW JERSEY

THIS SURVEY WAS COMPLETED BY FRANK J. ERNST, A PROFESSIONAL LAND SURVEYOR AND PLANNER, ON BEHALF OF MICHAEL P. BAILEY & SUZAN M. BAILEY. THE SURVEY WAS CONDUCTED ON THE DATE OF 5/14/95. THE SURVEY WAS COMPLETED IN ACCORDANCE WITH THE NEW JERSEY SURVEYING ACT. THE SURVEY WAS COMPLETED IN ACCORDANCE WITH THE NEW JERSEY SURVEYING ACT. THE SURVEY WAS COMPLETED IN ACCORDANCE WITH THE NEW JERSEY SURVEYING ACT.

5/14/95
DATE

FRANK J. ERNST
PROFESSIONAL LAND SURVEYOR N.J. LIC. NO. 2208
PROFESSIONAL PLANNER NO. 2834

SENeca SURVEYING & PLANNING
387 HERBERTSVILLE ROAD
BRICK, NEW JERSEY 08724
(908) 266-0366

Drawn by: A-PLAT
Proj. No. 95-5540