

BLOCK

828

LOT

16

ADDRESS (SITE)

1626 Harvard Ave Brick

PERMIT NO.

1276-92

RECEIVED

JUN 10 1992

CONSTRUCTION PERMIT
APPLICATION

Applicant Completes: Sections I, II, III (optional), IV, VI and VII

DIV I IDENTIFICATION

1. Proposed Work-site at: 1626 Harvard Ave
2. Name of Owner in Fee: John or Cheryl Castiglia Tel. [REDACTED]
- Address 1626 Harvard Ave Brick 08724
- street municipality zip code
3. Ownership in Fee: Public ☐ Private ☒
4. Principal Contractor: Sam Tel. ()
- Address
- License No. OR, if new home, Builder Reg. No. Exp. Date
- Federal Emp. No. Social Security No.
5. Architect or Engineer Tel. ()
- Address
6. Responsible Person In Charge of Work Tel. ()

V. FEE SUMMARY (for office use only)

		Update	Update
1. Building	\$	8	
2. Electrical			
3. Plumbing			
4. Fire Protection			
5. Other			
6. Subtotal	\$	8	
7. Less 20% for State Plan Review			
8. Subtotal	\$		
9. DCA Training Fee			
10. Subtotal	\$		
11. Cert. of Occupancy			
12. Other			
13. TOTAL	\$	8	

VI. BUILDING/SITE CHARACTERISTICS

	(office use only)
1. Number of Stories	
2. Height of Structure	ft.
3. Area—Largest Floor	sq. ft.
4. Building Area—All Floors	sq. ft.
5. Volume of Structure	cu. ft.
6. Construction Classification	
7. Total Land Area Disturbed	sq. ft.
8. Flood Hazard Zone	
9. Base Flood Elevation	ft.
10. Wetlands yes	sq. ft.
no	
11. Fire Grading	
12. Max. Live Load	
13. Max. Occupancy Load	

II. PROPOSED WORK

1. ☐ Minor Work (single trade)
2. ☐ Small Job (\$5,000 and no prior approvals)
3. ☐ New Building
4. ☐ Addition
5. ☐ Alteration
6. ☐ Fire Protection
7. ☐ Plumbing
8. ☐ Electrical
9. ☐ Asbestos Abatement
10. ☐ Demolition

TOTAL COSTS

Est. Cost

force

OPTIONAL (for office use only)

Plans Rec'd By	Date Rec'd	Rejection Date	Approval Date	Re-viewer	Resubmission Dates Approval	Rejection	Re-viewer
<u>[Signature]</u>			<u>6/15/92</u>	<u>RJH</u>			

III. DO YOU WANT: (optional) 1. ☐ Partial Releases 2. ☐ Prototype Processing

IV. DOES OR WILL YOUR BUILDING CONTAIN ANY OF THE FOLLOWING?

1. ☐ Elevators/Escalators/Lifts/ Dumbwaiters/Moving Walks
2. ☐ High Pressure Boilers
3. ☐ Pressure Vessels
4. ☐ Refrigeration Systems
5. ☐ Cross-Connections/Backflow Preventers
6. ☐ Hazardous Uses/Places of Assembly
7. ☐ Sprinklers
8. ☐ Smoke Control Systems in Open Wells
9. ☐ Underground Storage Tanks

VII. DESCRIPTION OF BUILDING USE

A. RESIDENTIAL

1. ☐ Hotels (R-1)
2. ☐ Multi-Family (R-2)
3. ☐ Two-Family (R-3) BOCA
4. ☐ Two-Family (R-4) CABO
5. ☒ One-Family (R-3) BOCA
6. ☐ One-Family (R-4) CABO

No of dwelling units:

Before Construction

After Construction

Net gain or loss

B. NON-RESIDENTIAL

1. State Specific Use:
2. Use Group:
3. Change in Use Group, Indicate Former:

LDS BR 10208574

20K

CERTIFICATION IN LIEU OF OATH

I. OWNER SECTION (to be completed if the applicant is the owner in fee)

I hereby certify that I am the owner in fee of the property listed on Page 1.

Mark the following applicable boxes:

- A. () I further certify that a new home (private residence) will be constructed on this property for my own use and occupancy. This dwelling is to be occupied by myself and is not to be used for any purpose other than single family residential use. I attest that all construction, plumbing, or electrical work will be done, in whole or in part, by me or by subcontractors under my supervision, in accordance with all applicable laws; and, I further acknowledge that said new home is not covered under the New Home Warranty and Builders Registration Act (N.J.S.A. 46:3B-1 et seq.) and that such fact shall be disclosed to any person purchasing this property within ten years of the date of issuance of a certificate of occupancy.

I UNDERSTAND THAT IN MARKING BOX A, I ACKNOWLEDGE THAT I AM ASSUMING RESPONSIBILITY FOR THE WORK DONE ON SAID PROPERTY, THE CONDITION OF THE PROPERTY PRIOR TO, DURING, AND AFTER ANY WORK PERFORMED, AND FOR THE PERFORMANCE OF THE SUBCONTRACTORS I HIRE, EMPLOY, OR OTHERWISE CONTRACT OR WITH WHOM I MAKE AGREEMENTS TO PERFORM WORK. I AM VOLUNTARILY AND KNOWINGLY ASSUMING THIS RESPONSIBILITY.

- B. () I further certify the following as required by the New Jersey Uniform Construction Code, N.J.A.C. 5:23-2.15(e)1.vii:

I personally prepared the plans submitted for: 1) the new home referred to in A.; or, 2) an addition, alteration, renovation, or repair to an existing single family residence owned and occupied by myself and located on the property listed on Page 1; or, 3) a new structure that will be physically separate from, but that will be deemed part of, an existing single family residence that is owned and occupied by myself and located on the property listed on Page 1.

- C. () I further certify that I will perform or supervise the following work:

C.1. () Building C.2. () Fire Protection

I further certify that I will perform the following work:

C.3. () Electrical C.4. () Plumbing

- D. () I agree to advise all contractors on this project that they are required to be registered with the New Jersey Division of Taxation and to comply with all New Jersey tax laws.

I further certify the following as required by the Uniform Construction Code, N.J.A.C. 5:23-2.15(a)5: All required State, county, and local prior approvals have been given, including such certification as the construction official may require.

I understand that if any of the above statements are willfully false, I am subject to punishment.

Signature _____ Date _____

II. AGENT SECTION

(to be completed if the applicant is not the owner in fee)

I hereby certify the following as required by the New Jersey Uniform Construction Code, N.J.A.C. 5:32-2.15(d): the proposed work is authorized by the owner in fee; and I have been authorized by the owner in fee to make this application as his agent.

I further certify the following as required by the Uniform Construction Code, N.J.A.C. 5:23-2.15(a)5: All required State, county, and local prior approvals have been given, including such certification as the construction official may require.

I agree to advise all contractors on this project that they are required to be registered with the New Jersey Division of Taxation and to comply with all New Jersey tax laws.

I understand that if any of the above statements are willfully false, I am subject to punishment.

() Check if contractor.

Agent Name _____

Address _____

Telephone (_____) _____

Signature _____ Date _____

OFFICE DATE RECEIVED: _____

VIII. PRIOR APPROVALS CHECKLIST (office use only)	LOCAL APPROVAL		COUNTY APPROVAL		REGIONAL APPROVAL		STATE APPROVAL		COMMENTS
	Prelimin. Initial	Final Date	Prelimin. Initial	Final Date	Prelimin. Initial	Final Date	Prelimin. Initial	Final Date	
☐ Planning Board									
☐ Zoning Board									
☐ Sewer Authority									
☐ Water Authority									
☐ Fire Department									
☐ Police Department									
☐ Health Department									
☐ Soil Conservation									
☐ N.J. Dept. of Community Affairs									
☐ N.J. Department of Transportation									
☐ N.J. Dept. of Environmental Protect.									
☐ Utility Dig No.									
☒ Other <i>Permit</i>	<i>JK</i>	<i>6/12/92</i>	<i>Shud</i>						
☐									
☐									

IX. SUBCODES AND SPECIAL REGULATIONS APPLICABLE (office use only—optional)

Name of Code & Edition

Name of Code & Edition

Other

Building _____
Electrical _____
Plumbing _____
Fire Protection _____
Mechanical _____

Energy _____
Barrier Free _____
Flood Hazard _____
As Built Elevation Cert. _____
Other _____

X. CERTIFICATES ISSUED (office use only)

DATE EXPIRED

☐ Temporary Certificate of Occupancy	No. _____	_____
☐ Temporary Certificate of Occupancy	No. _____	_____
☐ Continued Certificate of Occupancy	No. _____	_____
☐ Certificate of Occupancy	No. _____	_____
☐ Certificate of Approval	No. _____	_____



CONSTRUCTION PERMIT

Date Issued
Control #
Permit #

6-17-92
1276-92

IDENTIFICATION Block 828.17 Lot 16
Work Site Location 1626 Harvard Rd Contractor Same
Owner in Fee John Castiglia Address _____
Address same Tele. (____) _____
Tele. (____) _____ Lic. No. or Bldrs. Reg. No. _____ Exp. Date _____
Federal Emp. No. _____ or Social Security No. xx0002xx
1276xx

Is hereby granted permission to perform the following work:

☒ BUILDING [] PLUMBING [] OTHER _____
[] ELECTRICAL [] FIRE PROTECTION

DESCRIPTION OF WORK:

Same

NOTE: If construction does not commence within one (1) year of date of issuance, or if construction ceases for a period of six (6) months, this permit is void.

Estimated Cost of Work \$ 1000.

A. J. Peiza
CONSTRUCTION OFFICIAL

PAYMENTS (Office Use Only)	
Building <u>8</u>	16 #
Plumbing _____	BUILDING
Electrical _____	TOTAL
Fire Protection _____	CASH
Other _____	CHANGE
Other <u>06/18/92 NO. 5</u>	<u>0014A005</u>
DCA Training Fee _____	
Cert. of Occ. _____	
Other _____	
Total _____	
Check No. _____	
Cash _____	
Collected By: _____	

0.00
8.00
8.00
8.00
0.00
14:09



Date Received
Date Issued
Control #
Permit #

10-17-92
1276-92

A. IDENTIFICATION—APPLICANT: COMPLETE ALL APPLICABLE INFORMATION. WHEN CHANGING CONTRACTORS, NOTIFY THIS OFFICE. CALL UTILITY DIG NO. 1-800-272-1000.

Block 828-17 Lot 16
Work Site Location 1636 Howard Ave.
Brick NJ

Owner in Fee J. M. or Cheryl C. Cichla
Address _____

Tele. () _____
Contractor _____
Address _____

Tele. () _____
Lic. No. or Bldrs. Reg. No. _____
Federal Emp. No. _____ or Social Security No. _____

JOB SUMMARY (Office Use Only)

PLAN REVIEW	Date	Initial	INSPECTIONS	Dates (Month/Day)	Initial
			Type:	Failure	Approval
☐ No Plans Req.					
☒ All	<u>11/92</u>	<u>1636</u>	Footings		
☐ Footing			Foundation		
☐ Foundation			Slab		
☐ Frame			Frame		
☐ Other			Insulation		
Joint Plan Review Required:			Finishes:		
☐ Elec. ☐ Plumb. ☐ Fire			Energy		
SUBCODE APPROVAL			Mechanical		
☐ CO ☐ CCO ☐ CA			TCO		
Date: _____			Other		
Approved By: _____			Final		

B. BUILDING CHARACTERISTICS

Use Group Present _____ Proposed _____
Constr. Class Present _____ Proposed _____
No. of Stories _____ Ft.
Height of Structure _____ Ft.
Area—Largest Floor _____ Sq. Ft.
Total Bldg. Area/All Floors _____ Sq. Ft.
Volume of Structure _____ Cu. Ft.
Total Land Area Disturbed _____ Sq. Ft.

Est. Cost of Bldg. Work:
1. New Bldg. \$ _____
2. Alteration \$ _____
3. Total (1+2) \$ _____

C. CERTIFICATION IN LIEU OF OATH

I hereby certify that I am the (agent of) owner of record and am authorized to make this application.

Signature Cheryl Cichla

D. TECHNICAL SITE DATA
DESCRIPTION OF WORK

floor etc
11-26-92
6 ft.

(Office Use Only)

FEE

\$ _____

\$ _____

\$ _____

TYPE OF WORK:
☐ New Building
☐ Addition
☐ Alteration
☐ Roofing
☐ Siding
☐ Other _____

☐ Demolition
☒ Miscellaneous
☐ Fence _____ Height _____ Sq. Ft.

☐ Sign _____ Height _____ Sq. Ft.
☐ Pool
☐ Elevator
☐ Asbestos Abatement
☐ Other _____

Administrative Surcharge


Paid ☐ Check # _____ Minimum Fee \$ _____

Collected by: _____ TOTAL FEE \$ _____

U.C.C. Form F-110A

1 White=Inspector Copy
3 Pink=Office Copy

2 Canary=Office Copy
4 Gold=Applicant Copy

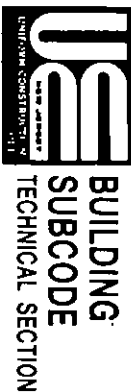

Date Received
Date Issued
Control #
Permit #

10-17-92
1276-92

A. IDENTIFICATION—APPLICANT: COMPLETE ALL APPLICABLE INFORMATION, WHEN CHANGING CONTRACTORS, NOTIFY THIS OFFICE. CALL UTILITY DIG NO: 1-800-272-1000.

Block 622-17 Lot 1b

Work Site Location

Owner in Fee
Address

Tele.

Contractor

Address

Tele. ()

Lic. No. or Bids. Reg. No.

Federal Emp. No. or Social Security No.

JOB SUMMARY (Office Use Only)

PLAN REVIEW	Date	Initial	INSPECTIONS	Dates (Month/Day)	Initial
☐ No Plans Req.			Type:	Failure	Approval
☐ All			Footings		
☐ Footing			Foundation		
☐ Foundation			Slab		
☐ Frame			Frame		
☐ Other			Insulation		
Joint Plan Review Required:			Finishes:		
☐ Elec. ☐ Plumb. ☐ Fire			Energy		
SUBCODE APPROVAL			Mechanical		
☐ CO ☐ CCO ☐ CA			TCO		
Date:			Other		
Approved By:			Final		

B. BUILDING CHARACTERISTICS

Use Group	Present	Proposed	Est. Cost of Bldg. Work:
Constr. Class			1. New Bldg. \$
No. of Stories			2. Alteration \$
Height of Structure			3. Total (1+2) \$
Area—Largest Floor			Sq. Ft.
Total Bldg. Area/All Floors			Sq. Ft.
Volume of Structure			Cu. Ft.
Total Land Area Disturbed			Sq. Ft.

C. CERTIFICATION IN LIEU OF OATH

I hereby certify that I am the (agent of) owner of record and am authorized to make this application.

Signature

D. TECHNICAL SITE DATA

DESCRIPTION OF WORK

(Office Use Only)


FEE

\$

U.C.C. Form F-110A

1 White=Inspector Copy
3 Pink=Office Copy

2 Canary=Office Copy
4 Gold=Applicant Copy

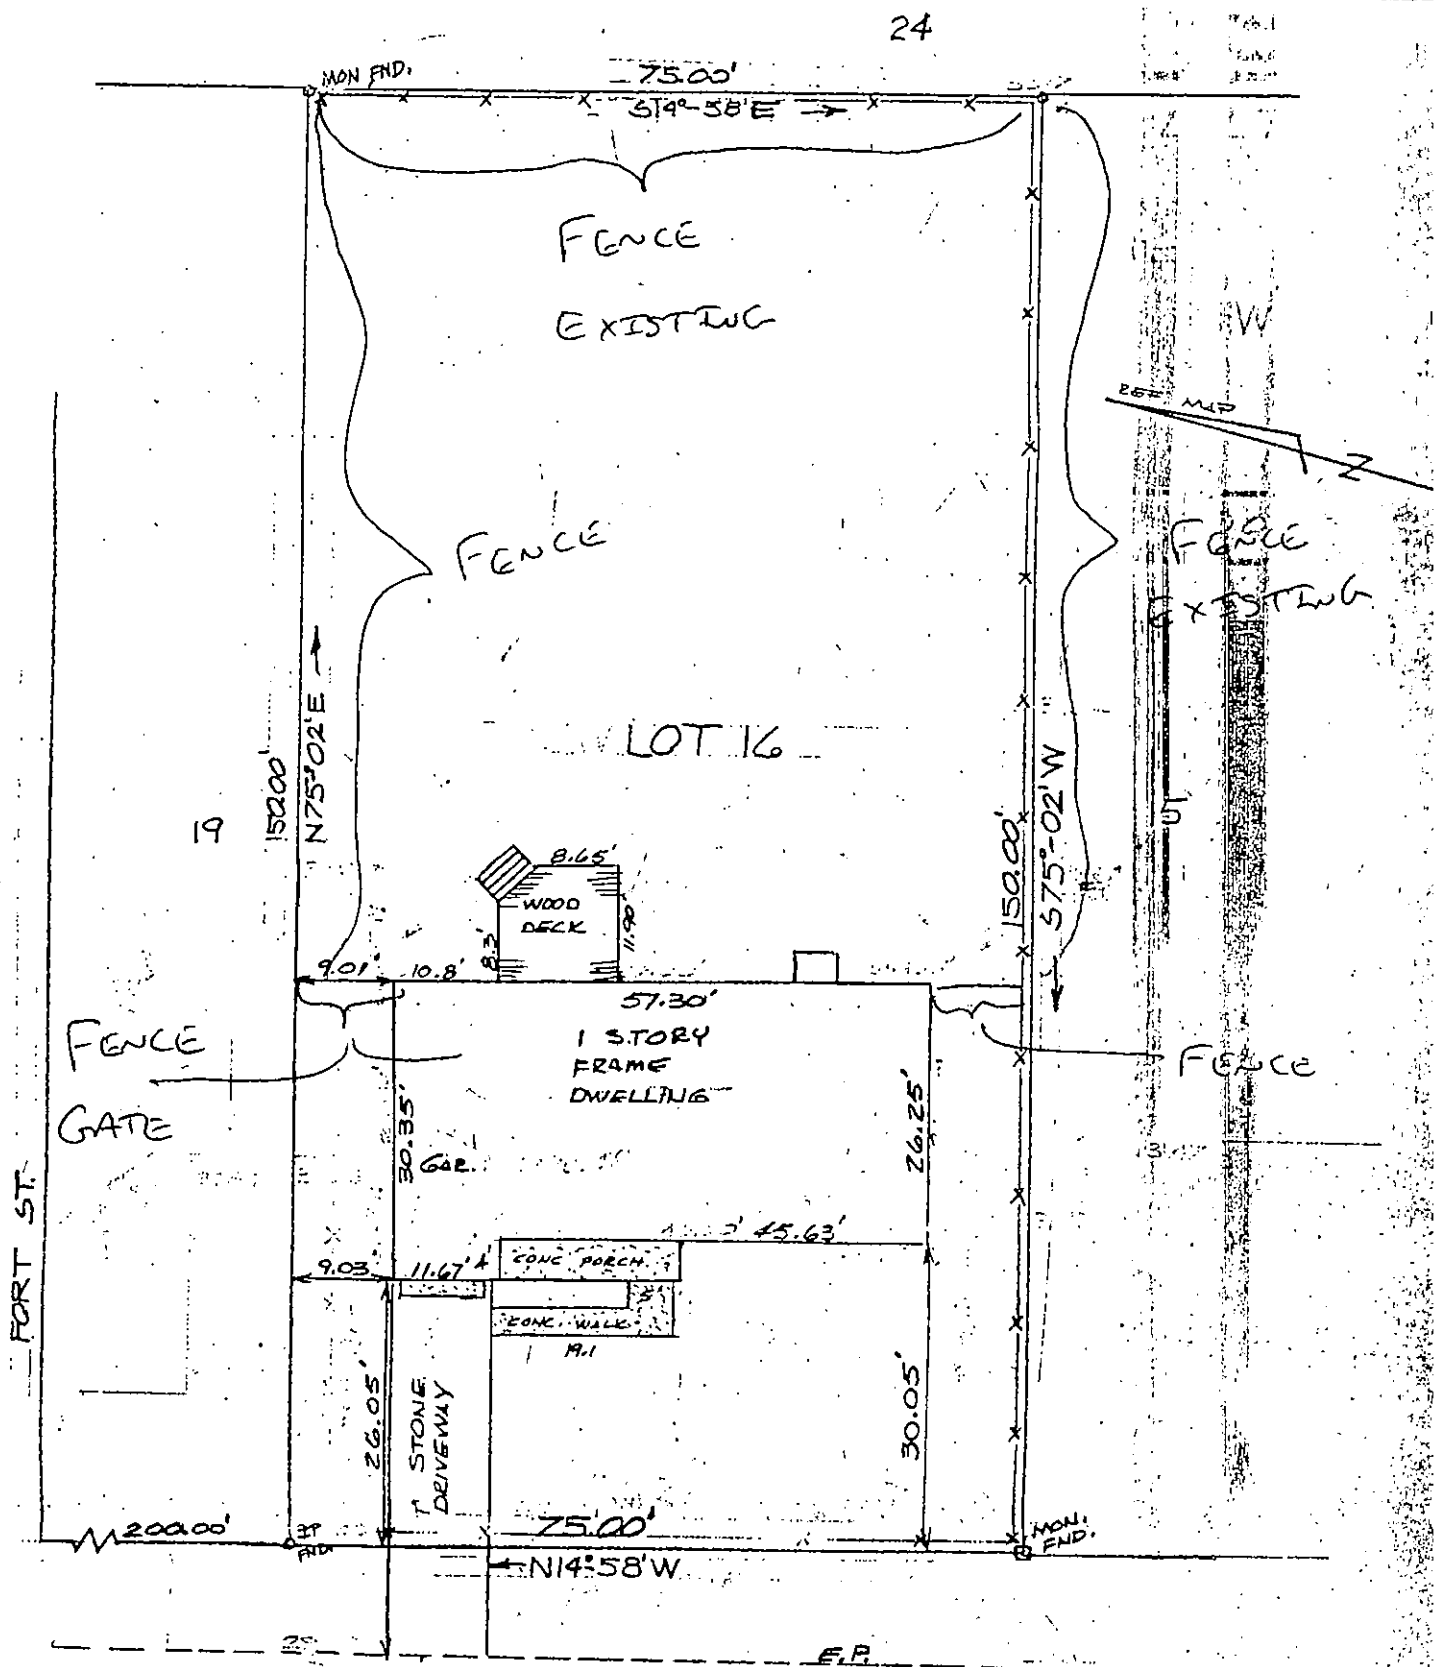

KNOWN AS LOT 16 BLOCK 828.17

AS SHOWN ON MINOR SUBDIVISION

LOTS 16-20, BLOCK 828.17

BY GEORGE W. HENN

FILE MAP # H 1339

HARVARD AVENUE ZONING ONLY

SEAN KINNEVY, ZONING OFFICER

DATE Sean King 6/12/92

CERTIFIED TO :

MIDSTATE ABSTRACT

RIVERSIDE SAVINGS BANK,

SLA AND/OR ITS ASSIGNS

JOHN CASTIGLIA

CHERYL Y. CANNOTA

TRAVELERS MORTGAGE SERVICE

AND/OR ITS ASSIGNS

① REV. 5-24-88 ASBUILT ② REV. CERT. & BRG.

STEVEN E. ZIMMERMAN P.L.S.

PROFESSIONAL LAND SURVEYOR

NEW JERSEY LIC. NO. 27515

33 CURTIS AVENUE

MANASQUAN, NEW JERSEY

SURVEY-ASBUILT

LOT 16

BLOCK 828-17

BRICK TOWNSHIP

OCEAN COUNTY, NEW JERSEY

10-20-87

Date

Dwn. L.P.T.

Date 10-11-87

Fid. Bk.

Ckd.

Dwg. No. 60-17

Scale 1"=20.00'