

51492

MAR 30 1992



CONSTRUCTION PERMIT APPLICATION

Applicant Completes Sections I, II, III (optional), IV, VI and VII

1. Proposed Work-site at: 1680 Forge Pond Rd, BRICK

2. Name of Owner in Fee: Ruth A. Cotta Tel. [REDACTED]

Address 1680 Forge Pond Rd BRICK 08724
street municipality zip code

3. Ownership in Fee: Public _____ Private ☒ _____

4. Principal Contractor: self Tel. (____) _____

Address _____

License No. OR, if new home, Builder Reg. No. _____ Exp. Date _____

Federal Emp. No. _____ Social Security No. _____

5. Architect or Engineer _____ Tel. (____) _____

Address _____

6. Responsible Person
In Charge of Work SON [REDACTED]

TOTAL COSTS

	Est. Cost
1000	1000
2000	2000
3000	3000
100000	100000

Deck

[illegible]

III. DO YOU WANT: (optional) 1. ☐ Partial Releases 2. ☐ Prototype Processing

1. ☐ Elevators/Escalators/Lifts/
Dumbwaiters/Moving Walks
2. ☐ High Pressure Boilers

- 3. ☐ Pressure Vessels
- 4. ☐ Refrigeration Systems
- 5. ☐ Cross-Connections/Backflow Preventers

6. ☐ Hazardous Uses/Places of Assembly
7. ☐ Sprinklers
8. ☐ Smoke Control Systems in Open Wells
9. ☐ Underground Storage Tanks

1. Building
2. Electrical
3. Plumbing
4. Fire Protection
5. Other _____
6. Subtotal
7. Less 20% for
State Plan Review
8. Subtotal
9. DCA Training Fee
10. Subtotal
11. Cert. of Occupancy
12. Other _____
13. TOTAL

Update

Update

1. Number of Stories _____
2. Height of Structure _____ ft.
3. Area—Largest Floor _____ sq. ft.
4. Building Area—All Floors _____ sq. ft.
5. Volume of Structure _____ cu. ft.
6. Construction Classification _____
7. Total Land Area Disturbed _____ sq. ft.
8. Flood Hazard Zone _____
9. Base Flood Elevation _____ ft.
10. Wetlands yes _____ sq. ft.
 no _____
11. Fire Grading _____
12. Max. Live Load _____
13. Max. Occupancy Load _____

(office use only)

1. ☐ Hotels (R-1)
2. ☐ Multi-Family (R-2)
3. ☐ Two-Family (R-3) BOCA
4. ☐ Two-Family (R-4) CABO
5. ☒ One-Family (R-3) BOCA
6. ☐ One-Family (R-4) CABO

No of dwelling units:
Before Construction _____
After Construction _____
Net gain or loss _____

1. State Specific Use:

2. Use Group:
3. Change in Use Group, Indicate Former:

LDS BR 10410177

20K

CERTIFICATION IN LIEU OF OATH

I. OWNER SECTION (to be completed if the applicant is the owner in fee)

I hereby certify that I am the owner in fee of the property listed on Page 1.

Mark the following applicable boxes:

A. () I further certify that a new home (private residence) will be constructed on this property for my own use and occupancy. This dwelling is to be occupied by myself and is not to be used for any purpose other than single family residential use. I attest that all construction, plumbing, or electrical work will be done, in whole or in part, by me or by subcontractors under my supervision, in accordance with all applicable laws; and, I further acknowledge that said new home is not covered under the New Home Warranty and Builders Registration Act (N.J.S.A. 46:3B-1 et seq.) and that such fact shall be disclosed to any person purchasing this property within ten years of the date of issuance of a certificate of occupancy.

I UNDERSTAND THAT IN MARKING BOX A, I ACKNOWLEDGE THAT I AM ASSUMING RESPONSIBILITY FOR THE WORK DONE ON SAID PROPERTY, THE CONDITION OF THE PROPERTY PRIOR TO, DURING, AND AFTER ANY WORK PERFORMED, AND FOR THE PERFORMANCE OF THE SUBCONTRACTORS I HIRE, EMPLOY, OR OTHERWISE CONTRACT OR WITH WHOM I MAKE AGREEMENTS TO PERFORM WORK. I AM VOLUNTARILY AND KNOWINGLY ASSUMING THIS RESPONSIBILITY.

B. () I further certify the following as required by the New Jersey Uniform Construction Code, N.J.A.C. 5:23-2.15(e)1.vii:

I personally prepared the plans submitted for: 1) the new home referred to in A.; or, 2) an addition, alteration, renovation, or repair to an existing single family residence owned and occupied by myself and located on the property listed on Page 1; or, 3) a new structure that will be physically separate from, but that will be deemed part of, an existing single family residence that is owned and occupied by myself and located on the property listed on Page 1.

C. () I further certify that I will perform or supervise the following work:

C.1. () Building C.2. () Fire Protection
I further certify that I will perform the following work:
C.3. () Electrical C.4. () Plumbing

D. () I agree to advise all contractors on this project that they are required to be registered with the New Jersey Division of Taxation and to comply with all New Jersey tax laws.

I further certify the following as required by the Uniform Construction Code, N.J.A.C. 5:23-2.15(a)5: All required State, county, and local prior approvals have been given, including such certification as the construction official may require.

I understand that if any of the above statements are willfully false, I am subject to punishment.

Signature Luth Ann Cotto Date 3/29/92

II. AGENT SECTION

(to be completed if the applicant is not the owner in fee)

I hereby certify the following as required by the New Jersey Uniform Construction Code, N.J.A.C. 5:32-2.15(d): the proposed work is authorized by the owner in fee; and I have been authorized by the owner in fee to make this application as his agent.

I further certify the following as required by the Uniform Construction Code, N.J.A.C. 5:23-2.15(a)5: All required State, county, and local prior approvals have been given, including such certification as the construction official may require.

I agree to advise all contractors on this project that they are required to be registered with the New Jersey Division of Taxation and to comply with all New Jersey tax laws.

I understand that if any of the above statements are willfully false, I am subject to punishment.

() Check if contractor.

Agent Name _____

Address _____

Telephone (_____) _____

Signature _____ Date _____

OFFICE DATE RECEIVED: _____

VIII. PRIOR APPROVALS CHECKLIST (office use only)	LOCAL APPROVAL		COUNTY APPROVAL		REGIONAL APPROVAL		STATE APPROVAL	
	Prelim. Initial	Final Date	Prelim. Initial	Final Date	Prelim. Initial	Final Date	Prelim. Initial	Final Date
☐ Planning Board								
☐ Zoning Board								
☐ Sewer Authority								
☐ Water Authority								
☐ Fire Department								
☐ Police Department								
☐ Health Department								
☐ Soil Conservation								
☐ N.J. Dept. of Community Affairs								
☐ N.J. Department of Transportation								
☐ N.J. Dept. of Environmental Protection								
☐ Utility Dig No.								
☒ Other <i> zoning</i>	<i>SC</i>	<i>3/21/92</i>	<i>check</i>					
☐								
☐								

COMMENTS

IX. SUBCODES AND SPECIAL REGULATIONS APPLICABLE (office use only—optional)

Name of Code & Edition

Name of Code & Edition

Other

Building _____
 Electrical _____
 Plumbing _____
 Fire Protection _____
 Mechanical _____

Energy _____
 Barrier Free _____
 Flood Hazard _____
 As Built Elevation Cert. _____
 Other _____

X. CERTIFICATES ISSUED (office use only)

DATE EXPIRED

- ☐ Temporary Certificate of Occupancy
- ☐ Temporary Certificate of Occupancy
- ☐ Continued Certificate of Occupancy
- ☐ Certificate of Occupancy
- ☐ Certificate of Approval
- ☐ None

No. _____
 No. _____
CONSTRUCTION PERMIT

Date Issued

Control #

Permit #

4/3/92

514-92

Self

IDENTIFICATION Block

838

Lot

Work Site Location

1680 Forge Pond Rd

Contractor

Address

Owner in Fee

Luth A. Catta

Address

same

Tele. ()

Lic. No. or Bldrs. Reg. No.

Exp. Date

Tele. ()

Federal Emp. No.

or Social Security No.

is hereby granted permission to perform the following work:

[4] BUILDING [] PLUMBING [] OTHER
[] ELECTRICAL [] FIRE PROTECTION

DESCRIPTION OF WORK:

Deck

NOTE: If construction does not commence within one (1) year of date of issuance, or if construction ceases for a period of six (6) months, this permit is void.

Estimated Cost of Work \$

430

CONSTRUCTION OFFICIAL

PAYMENTS (Office Use Only)

Building	838	**0000**	
Plumbing		514**	
Electrical	BLCK		0.00
Fire Protection	838 #		
Other	MR 5 LOT		0.00
Other	10 #		
DCA Training Fee	BUILDING		8.00
Cert. of Occ.	20	PLAN ENH	5.00
Other	C / O		20.00
Total	33	TOTAL	33.00
Check No.	29	DEPT	33.00
Cash			
Collected By			



Date Received
Date Issued
Control #
Permit #

4/3/92
514-92

IDENTIFICATION—APPLICANT: COMPLETE ALL APPLICABLE INFORMATION, WHEN CHANGING CONTRACTORS, NOTIFY THIS OFFICE. CALL UTILITY DIG NO: 1-800-272-1000.

Block 838 Lot 10
Work Site Location 1680 Forge Pond Rd, Reick
Owner in Fee Ruth Ann Cotta
Address 1680 Forge Pond Rd
Reick N.E. 08729
Tele. [REDACTED]
Contractor Scm
Address Same as above
Tele. [REDACTED]
Lic. No. or Bldrs. Reg. No. _____
Federal Emp. No. _____ or Social Security No. _____

JOB SUMMARY (Office Use Only)

PLAN REVIEW	Date	Initial	INSPECTIONS	Failure	Failure	Approval	Initial
☒ No Plans Req.	4/2/92	MC	Type: <u>Footings</u>			4/15/92	gc
☒ All			☐ Footing				
☐ Foundation			☐ Slab				
☐ Frame			☐ Frame				
☐ Other			☐ Insulation				
Joint Plan Review Required:			Finishes:				
☐ Elec. ☐ Plumb. ☐ Fire			Energy				
SUBCODE APPROVAL			Mechanical				
☐ CO ☐ SCC ☒ CA			TCO				
Date: <u>5-8-92</u>			Other				
Approved By: <u>[Signature]</u>			Final				

B. BUILDING CHARACTERISTICS

Use Group Present R-3 Proposed _____
Constr. Class Present _____ Proposed _____
No. of Stories _____ Ft. _____
Height of Structure _____ Ft. _____
Area—Largest Floor _____ Sq. Ft. _____
Total Bldg. Area/All Floors _____ Sq. Ft. _____
Volume of Structure _____ Cu. Ft. _____
Total Land Area Disturbed _____ Sq. Ft. _____

Est. Cost of Bldg. Work:
1. New Bldg. \$ _____
2. Alteration \$ _____
3. Total (1+2) \$ _____

C. CERTIFICATION IN LIEU OF OATH

I hereby certify that I am the (agent of) owner of record and am authorized to make this application.

Signature Ruth Ann Cotta

D. TECHNICAL SITE DATA
DESCRIPTION OF WORK

Block

(Office Use Only)
FEE

TYPE OF WORK:	(Office Use Only)
☐ New Building	\$ _____
☐ Addition	\$ _____
☐ Alteration	\$ _____
☐ Roofing	\$ _____
☐ Siding	\$ _____
☐ Other	\$ _____
☐ Demolition	\$ _____
☐ Miscellaneous	\$ _____
☐ Fence _____ Height _____	\$ _____
☐ Sign _____ Sq. Ft. _____	\$ _____
☐ Pool	\$ _____
☐ Elevator	\$ _____
☐ Asbestos Abatement	\$ _____
☐ Other _____	\$ _____

Administrative Surcharge \$ _____
Paid ☐ Check # _____ Minimum Fee \$ _____
Collected by: _____ TOTAL FEE \$ _____



Date Received
Date Issued
Control #
Permit #

4/3/92
514-92

A. IDENTIFICATION—APPLICANT: COMPLETE ALL APPLICABLE INFORMATION. WHEN CHANGING CONTRACTORS, NOTIFY THIS OFFICE. CALL UTILITY DIG NO: 1-800-272-1000.

Block 838 Lot 10
Work Site Location 1680 Forge Pond Rd Reick
Owner in Fee Ruth Ann Cottar
Address 1680 Forge Pond Rd
Reick N.Y. 08724
Tele. [REDACTED]
Contractor UCS
Address Same as above
Tele. [REDACTED]
Lic. No. or Bldrs. Reg. No. _____
Federal Emp. No. _____ or Social Security No. _____

JOB SUMMARY (Office Use Only)

PLAN REVIEW	Date	Initial	INSPECTIONS	Failure	Failure	Approval	Initial
☒ No Plans Req.	4/2/92	[Signature]	Footings				
☒ All			Foundation				
☐ Footing			Slab				
☐ Foundation			Frame				
☐ Other			Insulation				
Joint Plan Review Required:			Finishes:				
☐ Elec. ☐ Plumb. ☐ Fire			*Energy				
SUBCODE APPROVAL			Mechanical				
☐ CO ☐ CCO ☐ CA			TCO				
Date:			Other				
Approved By:			Final				

B. BUILDING CHARACTERISTICS

Use Group Present R-3 Proposed _____
Constr. Class Present _____ Proposed _____
No. of Stories _____
Height of Structure _____ Ft.
Area—Largest Floor _____ Sq. Ft.
Total Bldg. Area/All Floors _____ Sq. Ft.
Volume of Structure _____ Cu. Ft.
Total Land Area Disturbed _____ Sq. Ft.

Est. Cost of Bldg. Work:
1. New Bldg. \$ _____
2. Alteration \$ _____
3. Total (1+2) \$ _____

C. CERTIFICATION IN LIEU OF OATH

I hereby certify that I am the (agent-of) owner of record and am authorized to make this application.

Signature Ruth Ann Cottar

D. TECHNICAL SITE DATA

DESCRIPTION OF WORK

Block

(Office Use Only)

TYPE OF WORK:		FEE
☐ New Building		
☐ Addition		
☐ Alteration		
☐ Roofing		
☐ Siding		
☐ Other		
☐ Demolition		
☐ Miscellaneous		
☐ Fence	Height	
☐ Sign	Sq. Ft.	
☐ Pool		
☐ Elevator		
☐ Asbestos Abatement		
☐ Other		

Administrative Surcharge	Minimum Fee	TOTAL FEE
\$ _____	\$ _____	\$ _____



4/3/92
514-92

15- CERTIFICATION IN LIEU OF OATH

Signature

D. TECHNICAL SITE DATA DESCRIPTION OF WORK

Black

or Social Security No.

PLAN REVIEW	Date	Initial	INSPECTIONS
-------------	------	---------	-------------

Dates (Month/Day)

No Plans Req.	Type:	Failure	Approval	Initial
☒	4			

[All				
49-2174				
<u> </u>				
Footing	<u> </u>	<u> </u>	<u> </u>	<u> </u>

_____ Footing _____ Foundation _____

	Foundation	Slab			
[]	_____	_____	_____	_____	_____

[] Frame _____ Frame _____

[] Other _____ Insulation _____

Joint Plan Review Required: _____

Finishes: _____

☐ Elec.	☐ Plumb.	☐ Fire	☐ Energy	☐ _____	☐ _____
--------------------------------	---------------------------------	-------------------------------	---------------------------------	--------------------------------	--------------------------------

Subcode	Approval	Mechanical	_____	_____
1000	_____	_____	_____	_____
1001	_____	_____	_____	_____
1002	_____	_____	_____	_____
1089	_____	_____	_____</	

Category	CA	CO	CU	Other
1	1	1	1	1
2	1	1	1	1
3	1	1	1	1
Date: _____

Answered By: _____

Final _____

B. BUILDING CHARACTERISTICS

Use Group	Present	Proposed	Est. Cost of Bldg. Work:
Present	<u>8.3</u>	_____	_____

Constr. Class	Present	Proposed	1. New Bldg. \$

No. of Stories _____

2. Alteration \$ _____

Height of Structure _____ Ft. 3. Total (1+2) \$ _____

Area—Largest Floor _____ Sq. Ft.

Total Bldg. Area/All Floors _____ Sq. Ft.

Volume of Structure _____ Cu. Ft.

Total Land Area Disturbed _____ Sq. Ft.

Est. Cost of Bldg. Work:

1. New Bldg. \$ _____

2. Alteration \$ _____

Administrative Surcharge

Minimum Fee _____

TOTAL FEE _____

69

§

§

11 G C Form E-110A

1 White = Inspector Connors


2 Canary - Office Copy

3 Pink = Office Copy

4 Gold = Applicant Copy

BEING KNOWN AS LOTS 10 & 11 IN BLOCK 8 AS SHOWN ON A MAP ENTITLED "LAURELTON PARK" AND FILED IN THE OCEAN COUNTY CLERK'S OFFICE ON SEPTEMBER 25, 1929 AS MAP NUMBER A-328

ALSO KNOWN AS LOT 10 IN BLOCK 838 AS SHOWN ON THE OFFICIAL TAX MAPS OF THE TOWNSHIP OF BRICK, OCEAN COUNTY, NEW JERSEY SHEET NUMBER 45B

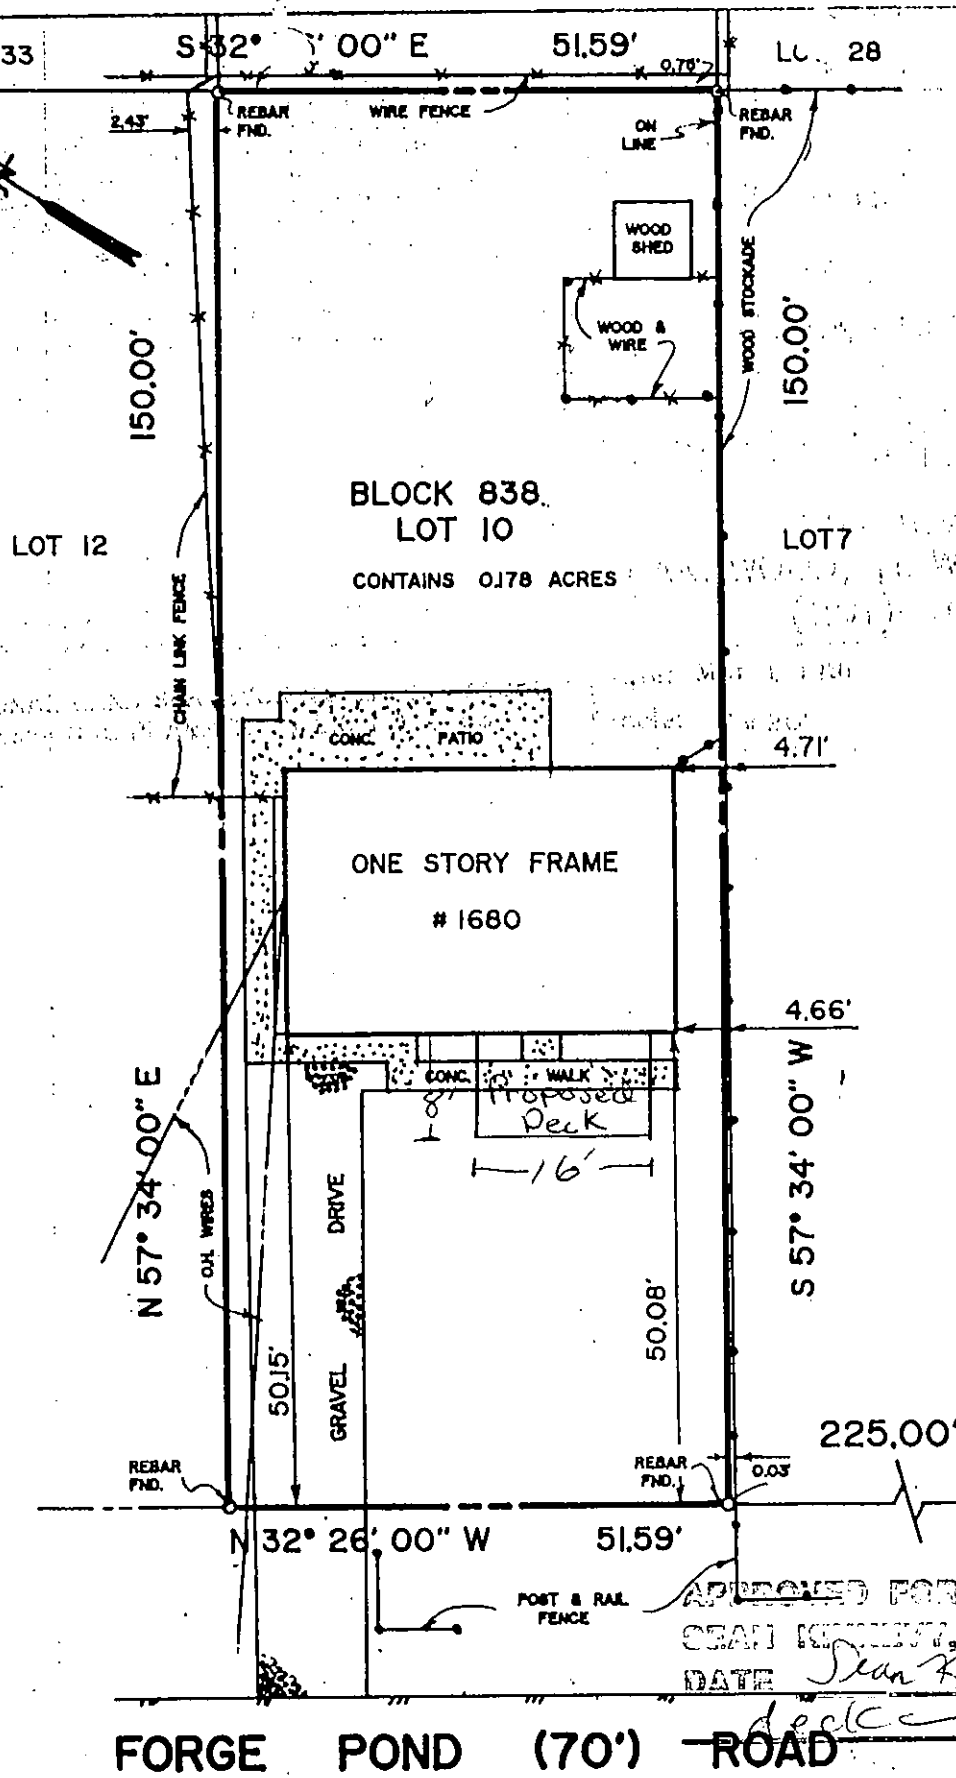

THIS SURVEY IS CERTIFIED ONLY TO:

RUTH ANN COTTA
THE PRUDENTIAL HOME MORTGAGE COMPANY, ITS
SUCCESSORS AND/OR ASSIGNS AS THEIR INTEREST
MAY APPEAR
LAWYERS TITLE INSURANCE COMPANY
ORLOVSKY, GRASSO AND BOLGER
R.E. ABSTRACT COMPANY, INC. (# T-28010-G)

LAURELTON (50') STREET
(A.K.A. THIRD STREET)

APPROVED FOR ZONING ONLY
OCEAN COUNTY, NEW JERSEY
DATE *Sean Kerney 3/31/92*

"TO ANY INSUROR OF TITLE RELYING HEREON AND ANY OTHER PARTY IN INTEREST, IN CONSIDERATION OF THE FEE PAID FOR MAKING THIS SURVEY, I HEREBY CERTIFY TO ITS ACCURACY (EXCEPT SUCH EASEMENTS, IF ANY, THAT MAY BE LOCATED BELOW THE SURFACE OF THE LANDS OR ON THE SURFACE OF THE LANDS THAT ARE NOT VISIBLE) AS AN INDUCEMENT FOR ANY INSUROR OF TITLE TO INSURE THE TITLE TO THE LANDS AND PREMISES SHOWN HEREON. THIS RESPONSIBILITY LIMITED TO THE CURRENT MATTER AS OF THE DATE OF THIS SURVEY.

OFFSETS AS SHOWN HEREON ARE NOT TO BE USED AS A BASIS FOR CONSTRUCTION OF FENCES OR OTHER PERMANENT STRUCTURES.

5/2/91
DATE

Michael D. Fasy
MICHAEL D. FASY

PROFESSIONAL LAND SURVEYOR N.J. LIC. NO. 34850
PROFESSIONAL PLANNER N.J. LIC. NO. 4693


PLAN of SURVEY
for
BLOCK 838 LOT(S) 10
BRICK TOWNSHIP
OCEAN COUNTY, N.J.

SENECA SURVEY Co., Inc.
1054 RIVER ROAD
LAKEWOOD, NEW JERSEY 08701
(201)-901-1555

Date: MAY 1, 1991
Scale: 1" = 20'
Drawn by: DBF
Job No.: 2082

BEING KNOWN AS LOTS 10 & 11 IN BLOCK 8 AS SHOWN ON A MAP ENTITLED "LAURELTON PARK" AND FILED IN THE OCEAN COUNTY CLERK'S OFFICE ON SEPTEMBER 25, 1929 AS MAP NUMBER A-328

ALSO KNOWN AS LOT 10 IN BLOCK 838 AS SHOWN ON THE OFFICIAL TAX MAPS OF THE TOWNSHIP OF BRICK, OCEAN COUNTY, NEW JERSEY SHEET NUMBER 45B

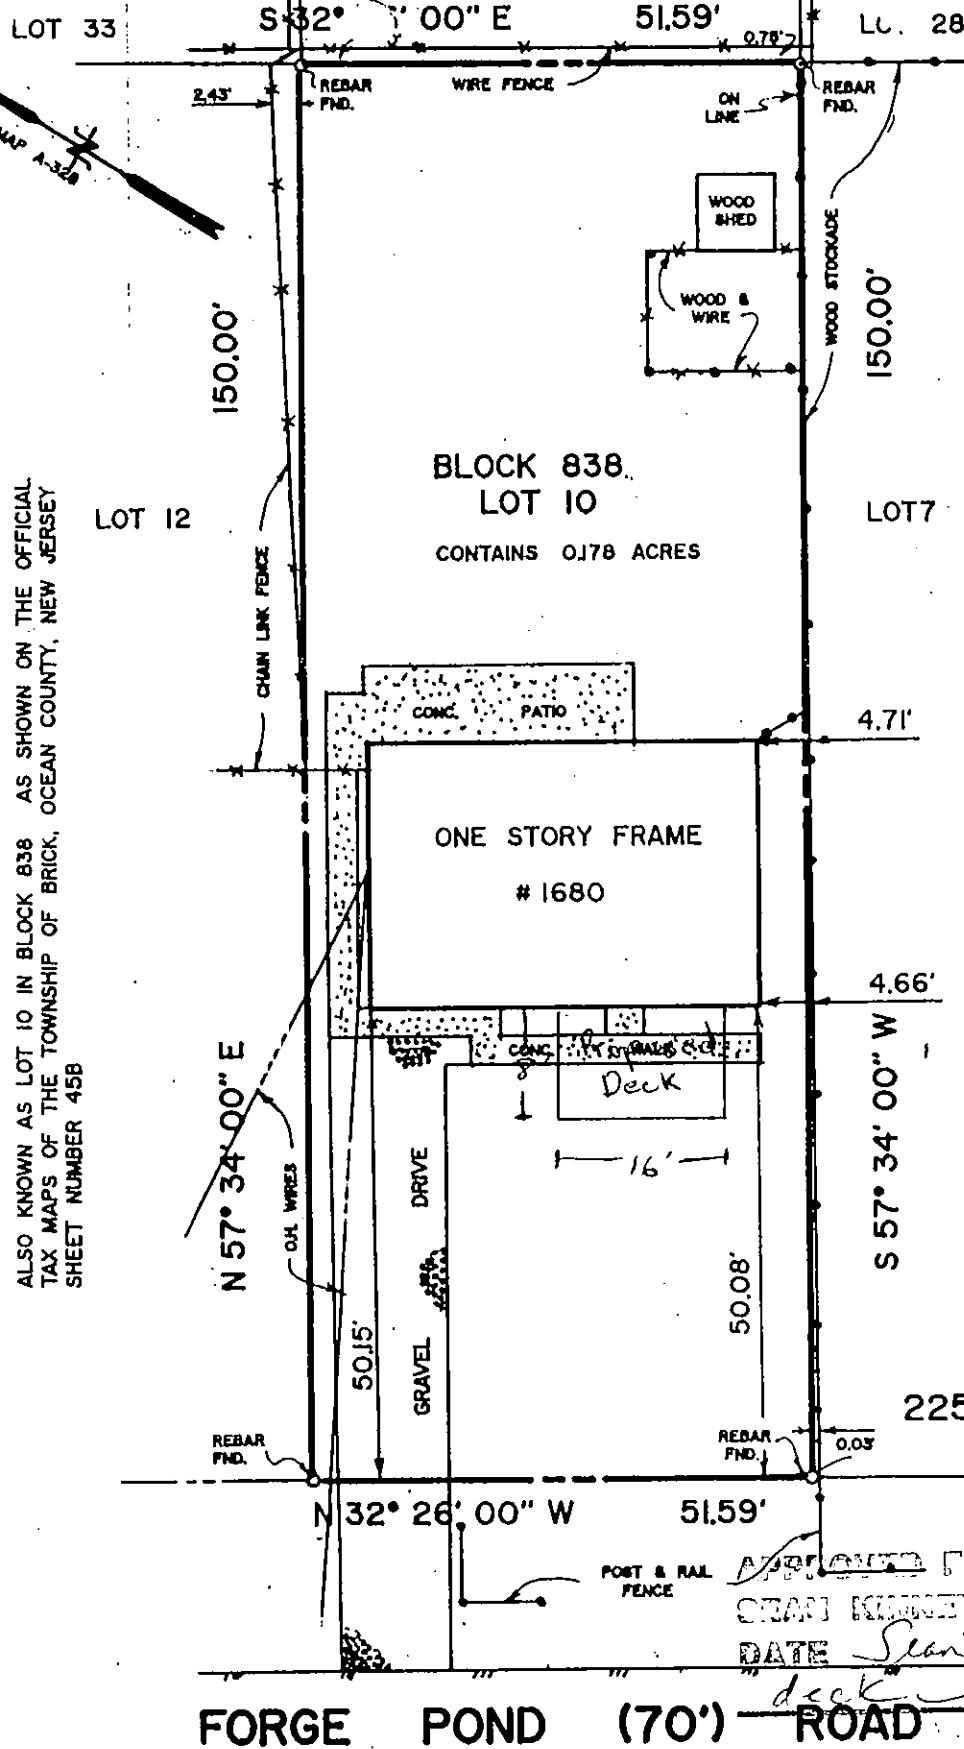

THIS SURVEY IS CERTIFIED ONLY TO:

RUTH ANN COTTA
THE PRUDENTIAL HOME MORTGAGE COMPANY, ITS
SUCCESSORS AND/OR ASSIGNS AS THEIR INTEREST
MAY APPEAR
LAWYERS TITLE INSURANCE COMPANY
ORLOVSKY, GRASSO AND BOLGER
R.E. ABSTRACT COMPANY, INC. (18 T-28010-G)

LAURELTON (50') STREET
(A.K.A. THIRD STREET)

APPROVED FOR ZONING ONLY
SEAN KENNEDY, ZONING OFFICER
DATE *Sean Kennedy 3/31/92*

FORGE POND (70') ROAD

"TO ANY INSUROR OF TITLE RELYING HEREON AND ANY OTHER PARTY IN INTEREST, IN CONSIDERATION OF THE FEE PAID FOR MAKING THIS SURVEY, I HEREBY CERTIFY TO ITS ACCURACY (EXCEPT SUCH EASEMENTS, IF ANY, THAT MAY BE LOCATED BELOW THE SURFACE OF THE LANDS OR ON THE SURFACE OF THE LANDS THAT ARE NOT VISIBLE) AS AN INDUCEMENT FOR ANY INSUROR OF TITLE TO INSURE THE TITLE TO THE LANDS AND PREMISES SHOWN HEREON. THIS RESPONSIBILITY LIMITED TO THE CURRENT MATTER AS OF THE DATE OF THIS SURVEY.

OFFSETS AS SHOWN HEREON ARE NOT TO BE USED AS A BASIS FOR CONSTRUCTION OF FENCES OR OTHER PERMANENT STRUCTURES.

5/2/91
DATE

Michael D. Fasy
MICHAEL D. FASY

PROFESSIONAL LAND SURVEYOR N.J. LIC. NO. 34850
PROFESSIONAL PLANNER N.J. LIC. NO. 4693

PLAN of SURVEY
for

BLOCK 838 LOT(S) 10

BRICK TOWNSHIP
OCEAN COUNTY, N.J.

SENECA SURVEY Co., Inc.

1054 RIVER ROAD
LAKEWOOD, NEW JERSEY 08701
(201)-901-1555


Date: MAY 1, 1991

Scale: 1" = 20'

Drawn by: DBF



Job No.: 2082

Side View 3 + Elevation

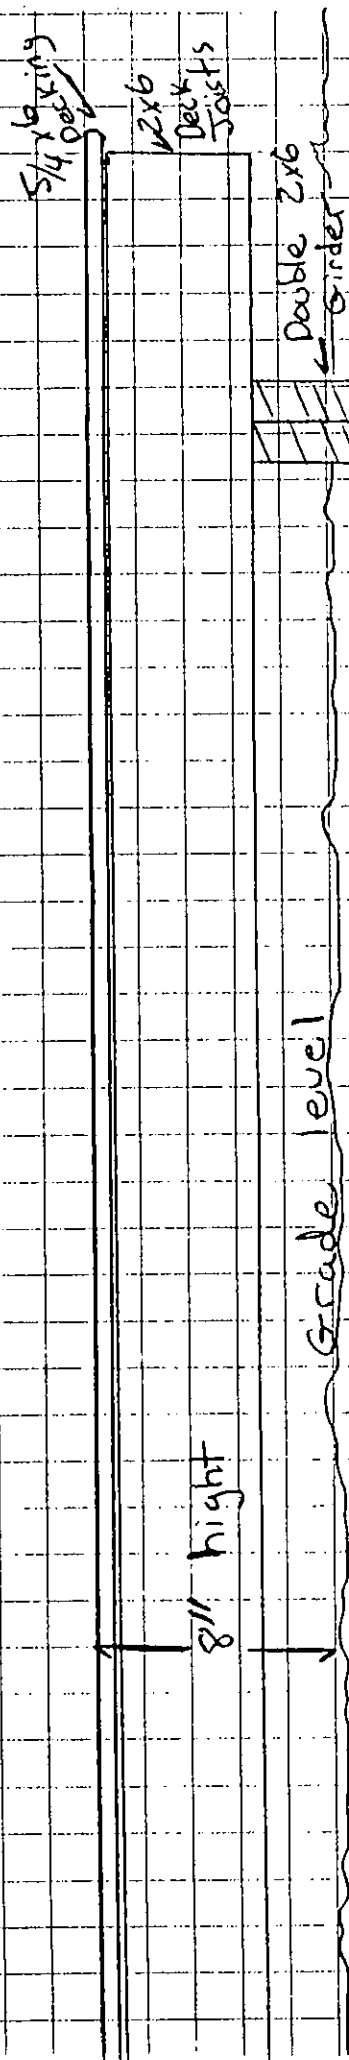[illegible]

Footing Plan


Front of house

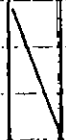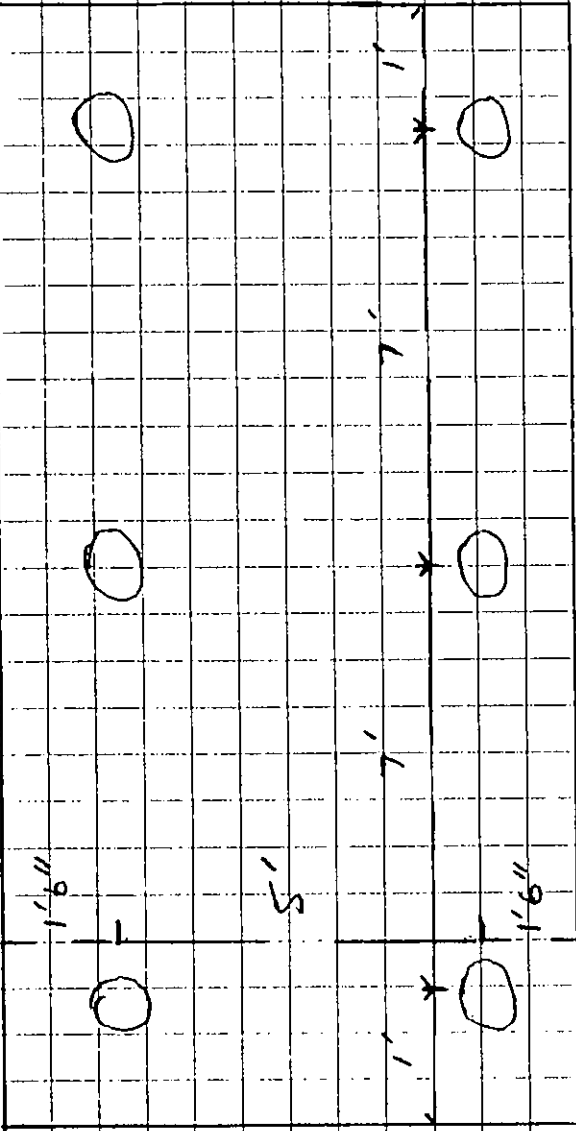

2x6 girder

12" round

Grade level

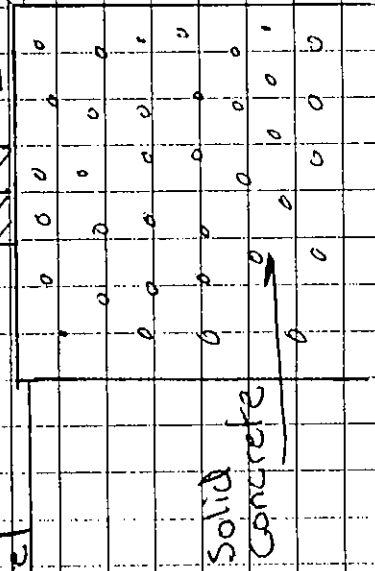

Side View of footing

