

Records requested:

Property Survey

42 Stonegate Drive

Little Egg Harbor Township, NJ 08087

My preferred delivery method for response(s) to this request is by E-mail as attachments. Please confirm you have received this request. If you are not the custodian of records, please forward my request to that person and provide their email address to me for future reference.

Yours faithfully,

Fatema Awad

Please deliver records electronically via email to the below UNIQUE address for all replies to this request:

opra+request-75617-c3632695@requests.opramachine.com

Is clerk@leht.com the wrong address for OPRA requests to Little Egg Harbor Township? If so, please contact us using this form:

https://opramachine.com/change_request/new?body=little_egg_harbor_township

Disclaimer: This message and any reply that you make will be published on the internet. Our privacy and copyright policies:

<https://opramachine.com/help/officers>

View this OPRA request & responses online:


https://opramachine.com/request/property_survey_8

Please note that in some cases publication of requests and responses will be delayed.

If you find this service useful as an OPRA custodian, please ask your web manager to link to us from your organisation's website.

OPRAMachine's mission is to give people easy and affordable access to New Jersey public records.

For more information, contact us at: (732) 707-1628 or PO Box 3180, New Brunswick, NJ 08903."

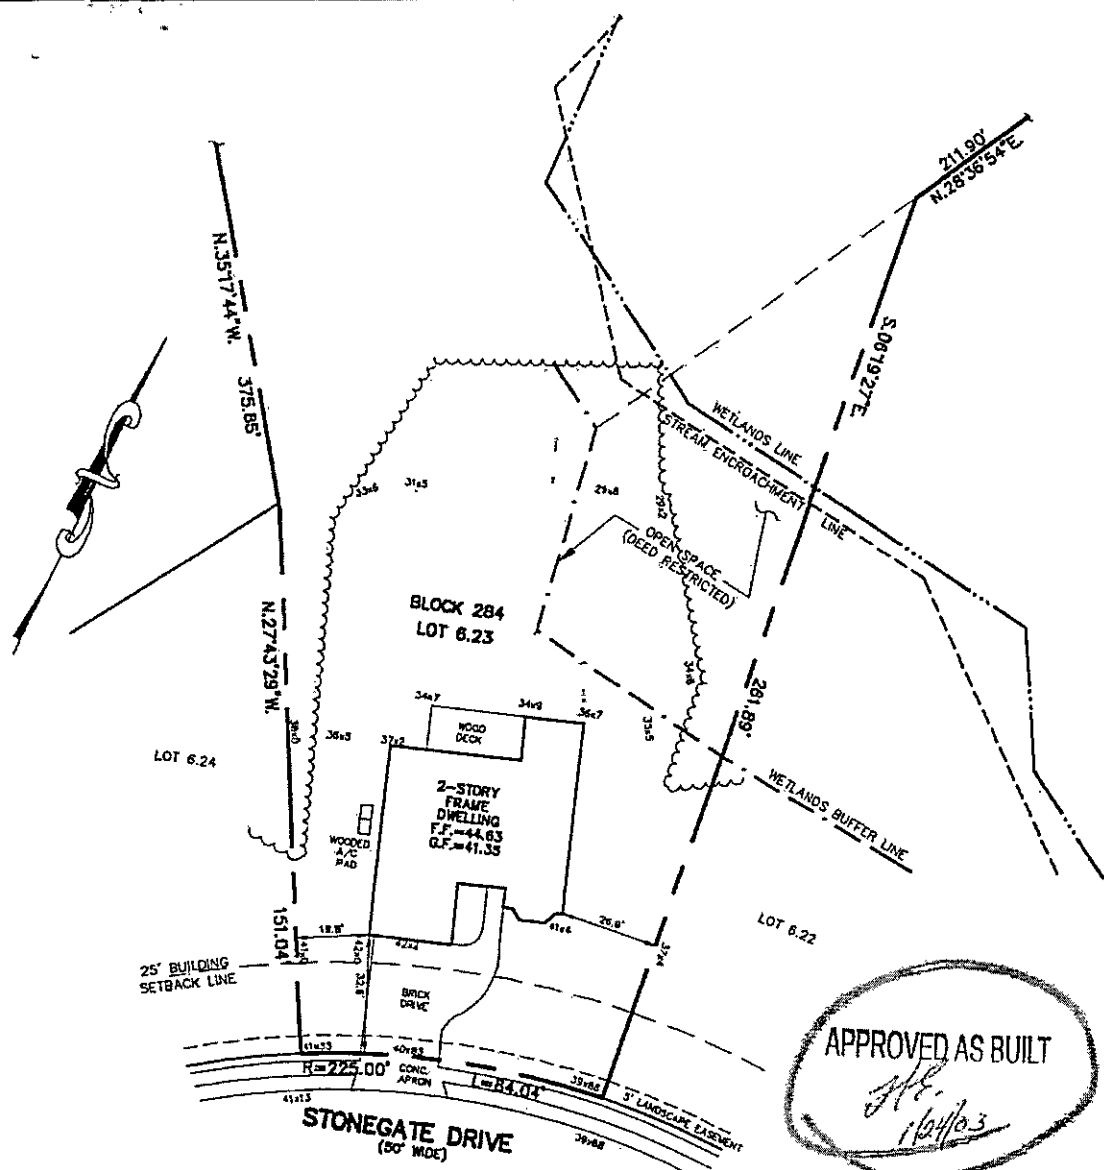

NOTES:

1. BEING KNOWN AND DESIGNATED AS BLOCK 284 LOT 6.23
ON A PLAN ENTITLED "FINAL PLAN FOR BLOCK 284 LOTS 6.01
CROSS CREEK PHASE 1 PHASE 3" PREPARED BY ADAMS REHMAN & HEGGAN
ASSOC. INC. DATED 1-25-02, FILED IN OR ABOUT TO BE FILED IN THE OCEAN
COUNTY CLERKS OFFICE.

BUILDING OFFSET DISTANCES SHOWN ARE FOR
THE PURPOSE OF CHECKING COMPLIANCE WITH
THE ZONING AND DEED RESTRICTIONS. NO LIABILITY
WILL BE ACCEPTED IF THESE DISTANCES ARE USED
FOR ERECTING FENCES OR OTHER IMPROVEMENTS.

IN CONSIDERATION OF THE FEE PAID FOR MAKING THE SURVEY,
I HEREBY CERTIFY TO ITS ACCURACY (EXCEPT SUCH EASEMENTS,
IF ANY, THAT MAY BE LOCATED BELOW THE SURFACE OF THE LANDS
OR ON THE SURFACE OF THE LANDS AND NOT VISIBLE) AS AN IN-
DUCEMENT FOR ANY INSUROR OF THE TITLE TO INSURE THE TITLE TO
THE LANDS AND PREMISES SHOWN THEREON.

REV. BLDG 1/23/03

ASBUILT SURVEY PLAN OF:

BLOCK 284 LOT 6.23

- LITTLE EGG HARBOR TOWNSHIP

OCEAN COUNTY

NEW JERSEY

arh
ENGINEERS
SURVEYORS
PLANNERS

adams, rehmann & heggan

850 south white horse pike, po box 579, hamilton nj 08037

associates inc.

Certificate of Authorization No. 24GA27973300

609-561-0482 fax 609-567-8909

Richard A. Heggan
RICHARD A. HEGGAN
PROFESSIONAL LAND SURVEYOR
NEW JERSEY LICENSE No. 27497

block: 284
lot: 6.23
scale: 1"=40' date: 1/14/03
drawn by: M.C.S.
checked: P.A.S.
project no.: 80-82476