


NOTE: SUBJECT TO ANY STATEMENT OF FACT
A COMPLETE AND UP TO DATE TITLE SEARCH
MIGHT DISCLOSE

DESCRIPTION: All that certain parcel of
land situate in Chester Township, Morris
County, New Jersey known as Lot 80 in
Block 26.01 of that Township being more
particularly described as follows:
All that parcel of land shown as Lot 80 in
Block 26.01 on a certain map entitled "Final
Plat, Applewood Farms" recorded at Morris County
as Map No. 4703.

TIE DISTANCES			
	A	B	C
1		105.5'	107.4'
2		97.0'	91.4'
3		69.5'	64.6'
4		81.4'	86.6'
5		62.0'	53.3'
6	80.7'	83.9'	

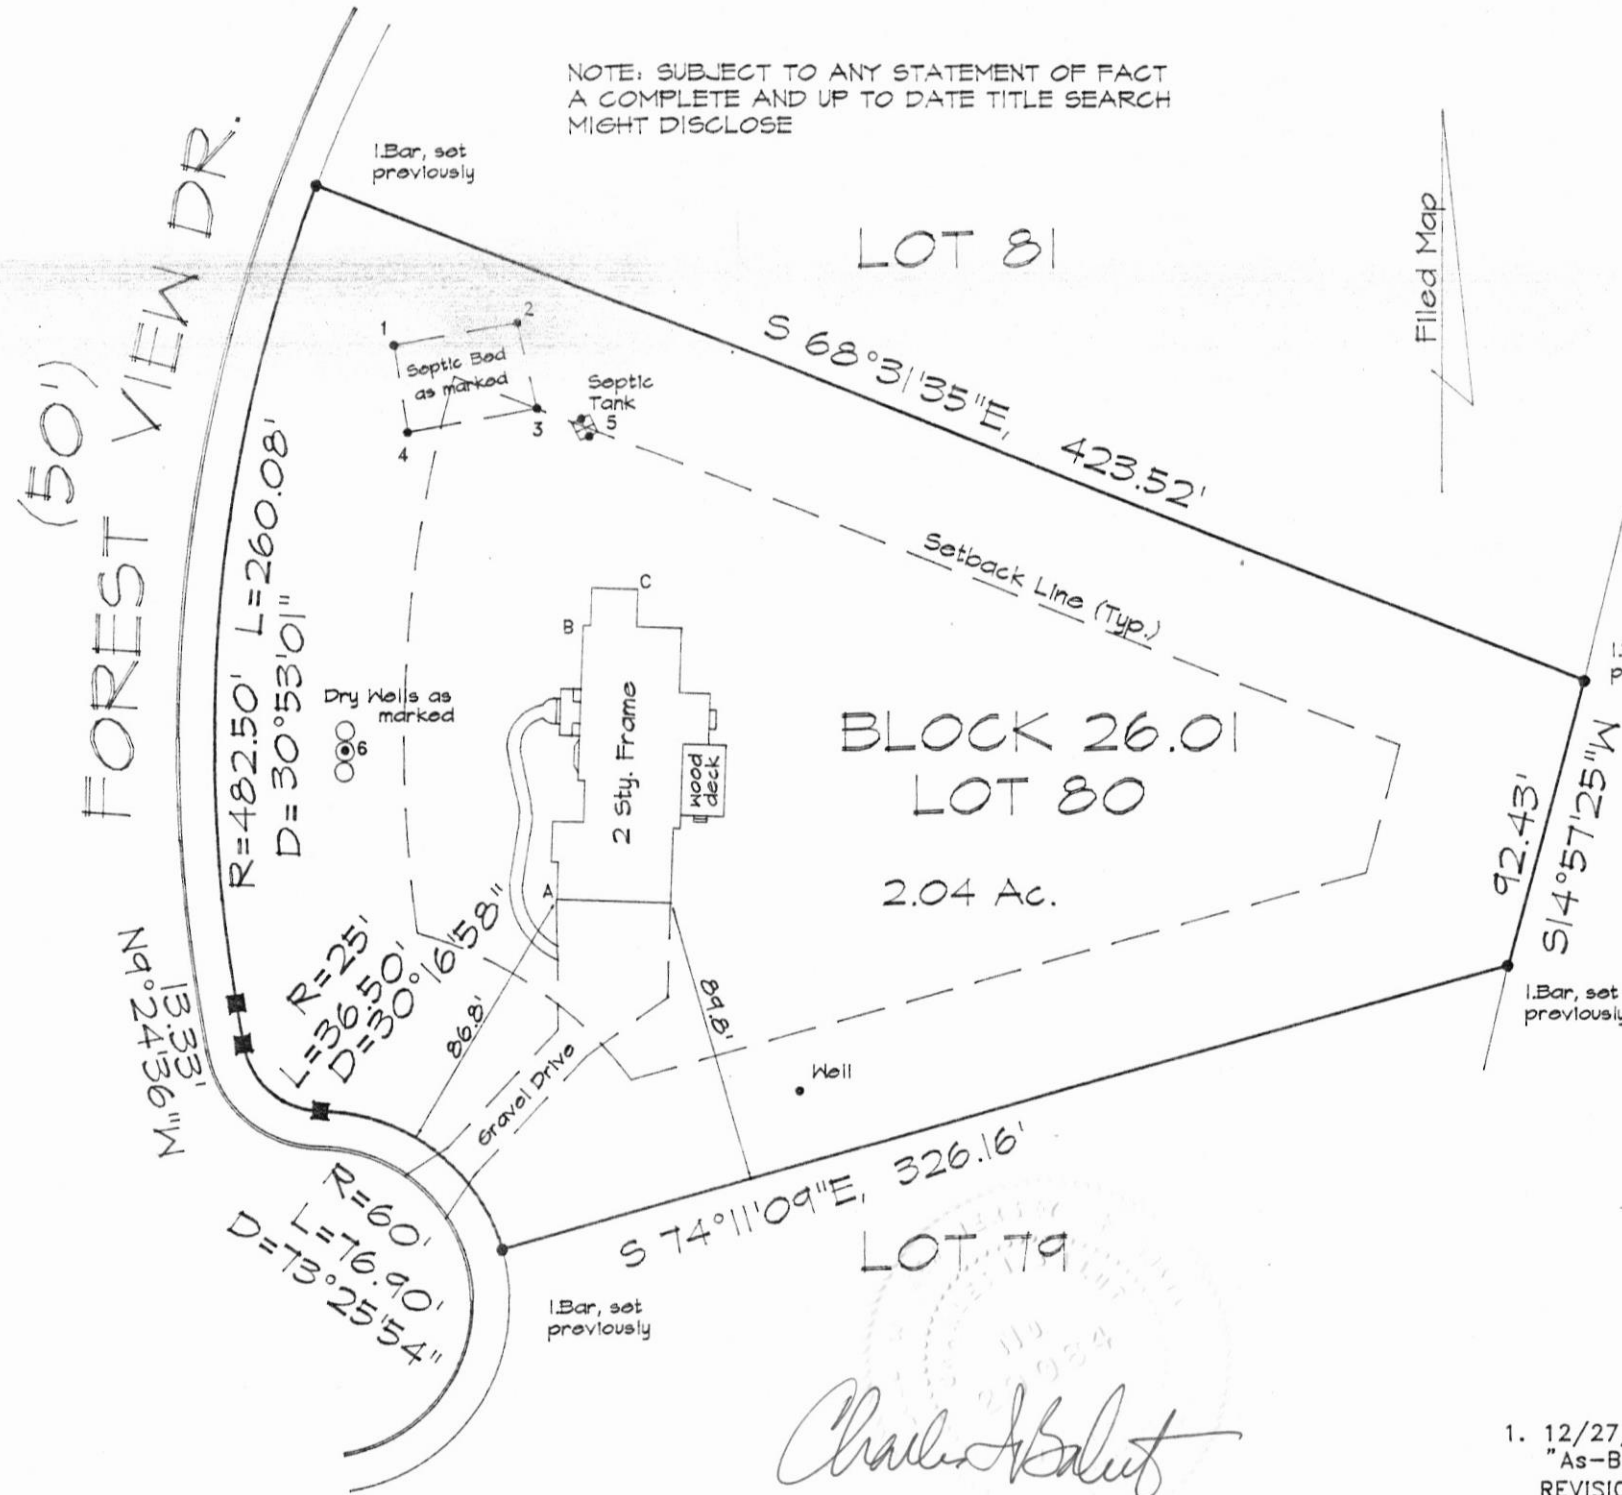

I CERTIFY THAT TO THE BEST OF MY KNOWLEDGE
, INFORMATION AND BELIEF AND IN MY
PROFESSIONAL OPINION, THIS SURVEY IS
CORRECT AND ACCURATE

Certified To: T.R.I.

PROPERTY SURVEY Block 26.01, Lot 80 Chester Twp., Morris Co., N.J.	Job No.
	92-487
RICHARD W. CARLSON & ASSOCIATES, INC. Land Surveyors & Planners P.O. Box 804 Hackettstown, N.J. 07840 (908) 852-8706	Date
	6/14/95
Richard W. Carlson, N.J.L.S. No. 16207	Scale
	1"=60'
1. 12/27/85 "As-Built" REVISIONS	Dwg. No.
	487
	Data File
	487.499
	Drwn. Chk'd
	RWC RWC
	1/1

