

HEALTH DEPARTMENT
TOWNSHIP OF CHESTER

Box 428 Chester, New Jersey 07930

APPLICATION FOR A CERTIFICATE OF COMPLIANCE -- INSTALLATION

PERMIT NO. _____
N.J.S.D.E.P. NO. 25-43991
DATE SUBMITTED _____
OWNER OF PROPERTY TRT Construction Co PHONE _____
ADDRESS AT WHICH WATER SUPPLY HAS BEEN CONSTRUCTED: FOREST VIEW DRIVE
BLOCK NO. 26-01 LOT 80
BRYAN DRILLING CO., INC.
P.O. BOX 274
CHESTER, NJ 07930
PHONE _____
908-879-5671
FAX 908-879-8520

WELL RECORD

TYPE OF WELL INSTALLED: ☒ ROTARY ☐ DRILLED ☐ DRIVEN
METHOD OF SEALING: (Describe) CEMENT Grout
DIAMETER: TOP 10 INCHES BOTTOM 6 INCHES. TOTAL DEPTH OF WELL: 250 FT.
CASING: TYPE black steel DIAMETER: 6 INCHES LENGTH 80 FT.
RECORD OF TEST: DATE: 5/4/95 YIELD 40 GALLONS PER MINUTE.
1. STATIC WATER LEVEL BEFORE PUMPING 40 FT. BELOW SURFACE.
2. PUMPING LEVEL 130 FT. BELOW SURFACE AFTER 4 HOURS PUMPING.
3. DRAW DOWN 90 FT. - SPECIFIC CAPACITY 0.44 GALS./MIN./ FT.
4. HOW PUMPED surge HOW MEASURED well
PERMANENT PUMPING EQUIPMENT:
1. TYPE _____ MANUFACTURER'S NAME: _____
2. CAPACITY _____ G.P.M. HOW DRIVEN _____ H.P. _____ R.P.M.
3. DEPTH TO PUMP IN WELL: _____ FT. DEPTH OF FOOT PIECE IN WELL: _____ FT.
STORAGE FACILITIES: _____
WELL FLUSHED AND DISINFECTED: ☐ YES ☐ NO PUMPING EQUIPMENT DISINFECTED: ☐ YES ☐ NO
GIVE LOG DETAILS BELOW: 0-30 clay 30'-55 weathered rock
55-250' granites

I hereby certify that the aforescribed water supply system has been constructed in accordance with "The Realty Improvement Sewerage and Facilities Act, P.L. 1954, Chapter 199, and Board of Health Ordinance Dated April 18, 1974
DATE _____ SIGNATURE Kabap B. Jz WELL DRILLER
DATE _____ SIGNATURE _____ PROF. ENGINEER

The final inspection of an individual water supply system shall include the collection of a sufficient number of samples for analyses to determine whether the water meets potable water standards adopted by the State Department of Environmental Protection. A certificate of Compliance - Installation, shall not be issued for a water supply system failing to satisfy the potable water standards.

OFFICE USE ONLY: (Do not write below this line)
FEE COLLECTED BY: _____ DATE _____ AS BUILT SUBMITTED BY: _____ DATE _____
FINAL INSPECTION BY: _____ DATE _____ SAMPLE COLLECTED BY: _____ DATE _____
SAMPLE ANALYZED BY: _____ DATE: _____

SERIAL #: 85341

DWR-133
(12/94)

STATE OF NEW JERSEY
DEPARTMENT OF ENVIRONMENTAL PROTECTION
TRENTON, NJ

Mail to
NJDEP
Bureau of Water Allocation
CN 426
Trenton, NJ 08625-0426

PERMIT TO DRILL WELL

Permit No. 2546991

VALID ONLY AFTER APPROVAL BY THE D.E.P.

COORD #: 25124.58

Owner TRI CONSTRUCTION CO
Address 15 TALMADGE RD
MEEDHAM, N.J. 07945
Name of Facility NEW HOME
Address FOREST VIEW DRIVE
CHESTER, N.J. 07730



Driller BRYAN DRILLING & INC
Address P.O. Box 274
CHESTER, N.J. 07730

Diameter of Well	10	Inches	Proposed Depth of Well	50	Feet
Proposed Capacity of Pump	15	GPM	Method of Drilling (cable-tool, Rotary, etc.)	Rotary	
Use of Well (See Reverse)	DOMESTIC				
Drinking Water Supply?	yes	(see # 6 on reverse)			

LOCATION OF WELL

Lot #	Block #	Municipality	County
80	26.01	CHESTER Twp	MORRIS


State Atlas Map No. 25

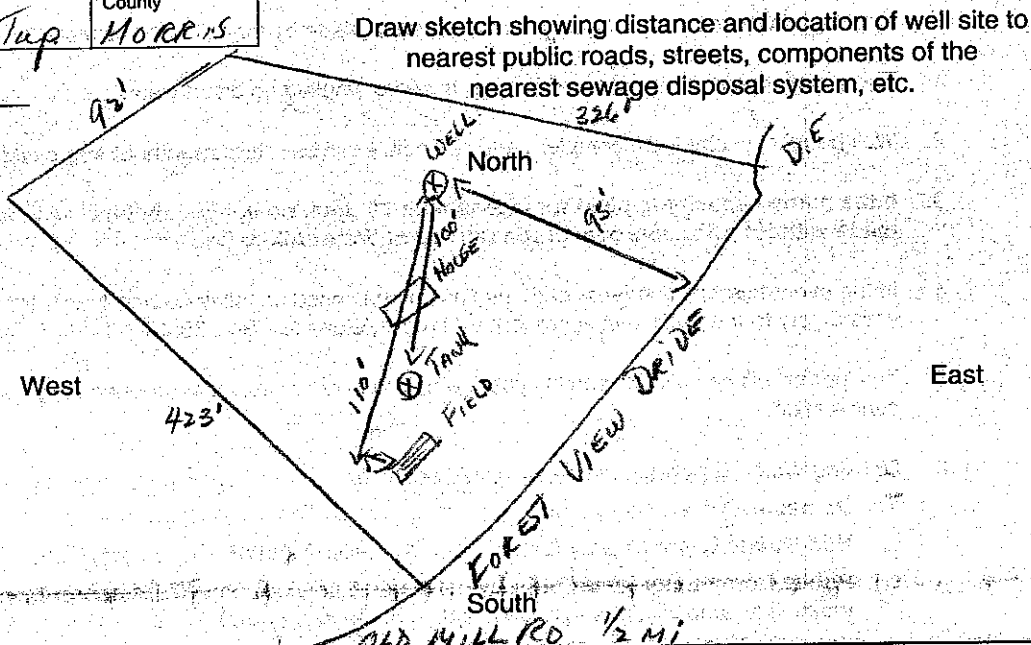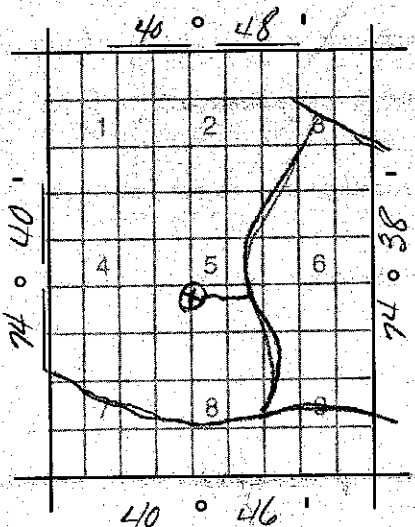

SEE REVERSE SIDE FOR IMPORTANT PROVISIONS AND REGULATIONS PERTAINING TO THIS PERMIT. APPROVAL OF THIS PERMIT IS MADE SUBJECT TO ACCEPTANCE OF AND COMPLIANCE WITH THE FOLLOWING ADDITIONAL CONDITIONS.

- ☒ DOMESTIC/PUBLIC NON-COMMUNITY/NON-PUBLIC Water Supply Wells shall comply with N.J.A.C. 7:10-12.1 et seq.
- ☐ PUBLIC COMMUNITY Water Supply Wells shall obtain construction and operation permits from the Bureau of Safe Drinking Water in accordance with N.J.A.C. 7:10-11.1 et seq.
- ☐ DOMESTIC IRRIGATION SUPPLY - No piping from the well for which the permit applies shall enter any building whose potable water is supplied through a public water system.
- ☐ OPEN LOOP GEOTHERMAL HEAT PUMP WELLS - Wells must be a minimum of 50 feet apart and the water must be returned to the same aquifer as the production well. A two hour pump test must be performed on the return well at a rate of 11/2 times the estimated return flow of water.
- ☐ INDUSTRIAL SUPPLY - A physical connection control permit shall be obtained pursuant to the provisions of N.J.A.C. 7:10-10.1 et seq.
- ☐ REPLACEMENT WELL - Existing well must be sealed by a certified New Jersey licensed well driller upon abandonment.
- ☐ IRRIGATION PURPOSES ONLY
- ☐ TEST PURPOSES ONLY
- ☐ PINELANDS - Well must be drilled and cased to a minimum depth of 100' unless the provisions of N.J.A.C. 7:50-6.84(a)4.v. are met.
- ☐ MINIMUM distance requirements as per N.J.A.C. 7:10-12.13 have not been met - see attached additional condition(s).
- ☐ The well shall be equipped with a totalizing flow meter per N.J.A.C. 7:19-2 et seq.

This Space for Approval Stamp

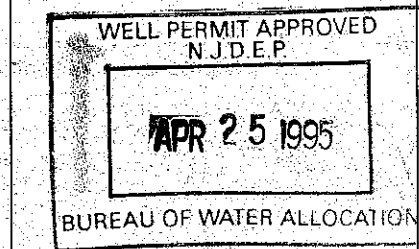

In compliance with N.J.S.A. 58:4A-14, application is made for a permit to drill a well as described above.

Date 4/20/95

Signature of Driller [Signature] License No. 000168541

Signature of Owner [Signature]

COPIES:

Water Allocation — White

Health Dept.—Yellow

Owner—Blue

Driller—White