


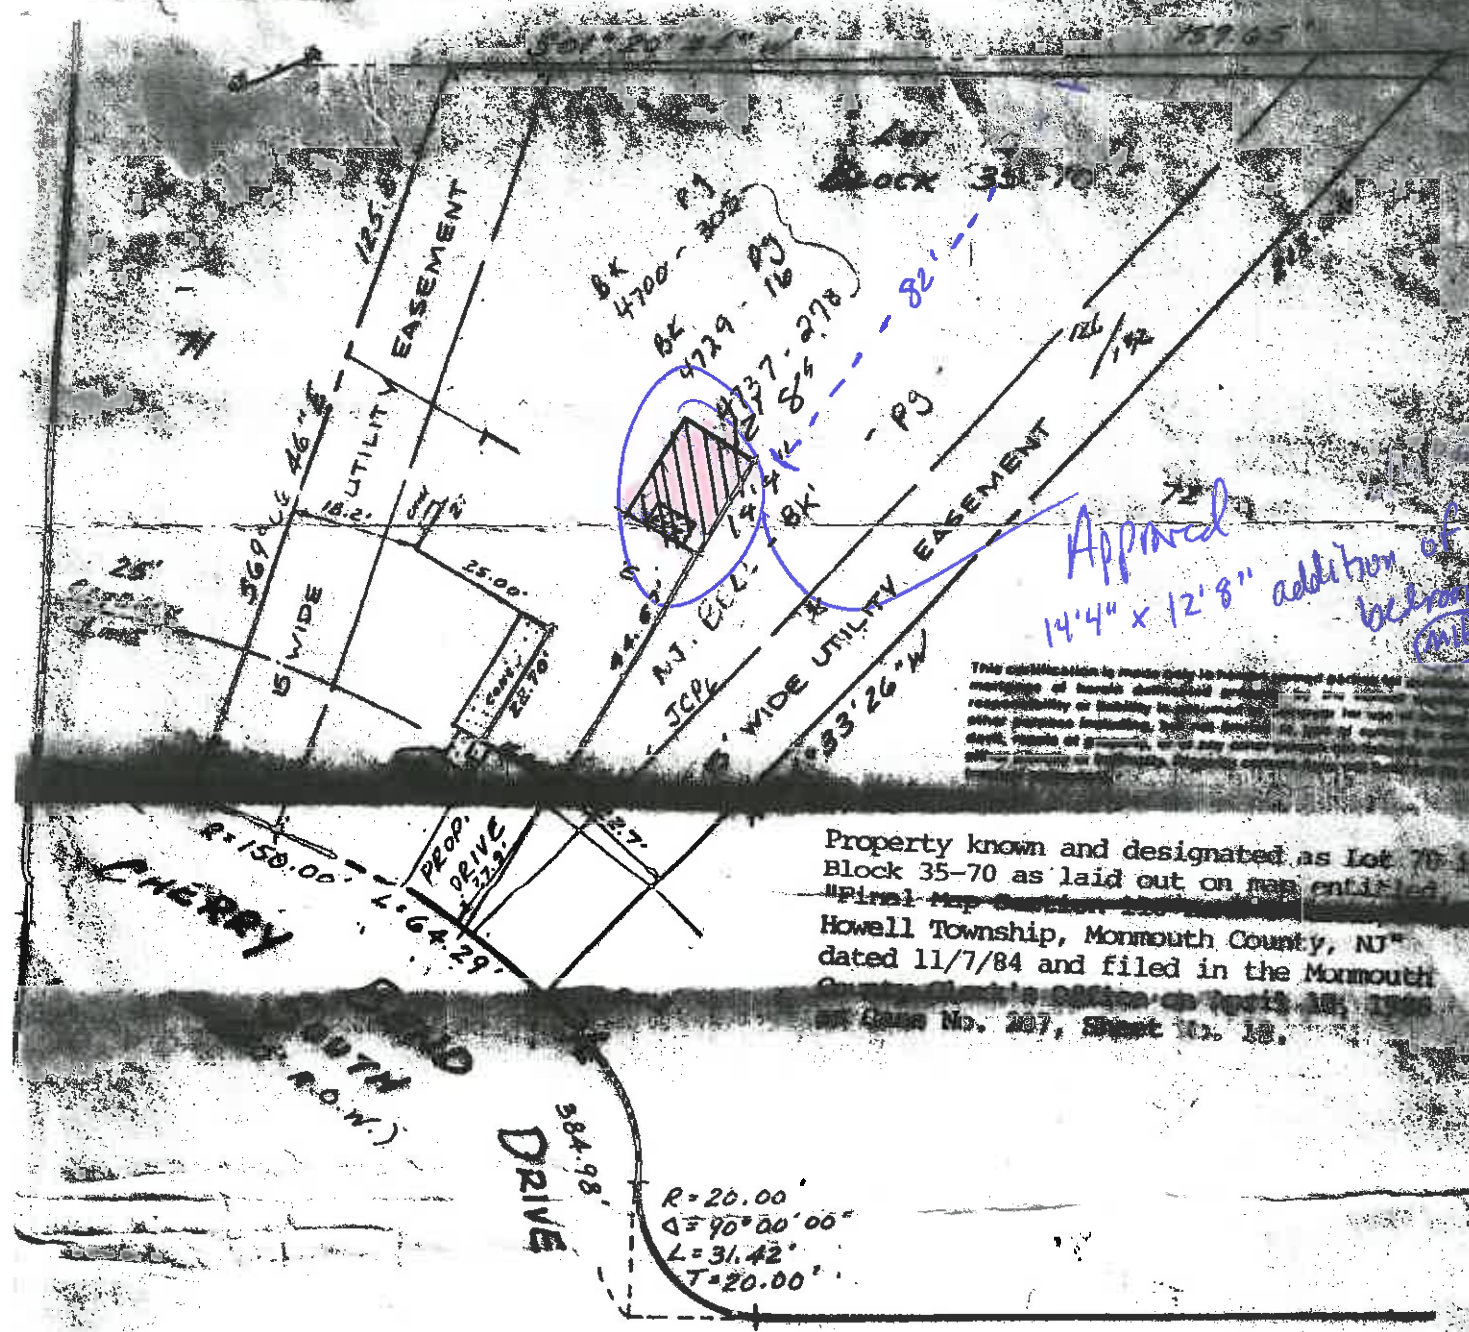

Property known and designated as Lot 70 in Block 35-70 as laid out on map entitled "Final Map Section 110" Howell Township, Monmouth County, NJ" dated 11/7/84 and filed in the Monmouth County Clerk's Office on April 18, 1985 as Case No. 207, Sheet No. 18.

HONEYSUCKLE WAY (50' R.O.W.)

This survey is certified to [redacted] GMAC Mortgage Corporation of PA and/or its assigns; Lawyers Title Insurance Corporation

SKETCH OF PROPERTY SURVEYED FOR: [redacted]

SITUATED IN: HOWELL TWP., MON. CO., N.J.

ENGINEERING SURVEYING PLANNING ASSOCIATES

PROFESSIONAL ENGINEERS, LAND SURVEYORS, AND PLANNERS
BOX 258, U.S. HWY. 9, HOWELL, NEW JERSEY 07731 201-452-7400

JOHN ALLGAIR
P.E. N.J. LIC 12012

SCALE 1" = 30'	DATE 3-9-87	TIME 1:00	FILE NO. 86M4670
-------------------	----------------	--------------	---------------------