

OCEAN COUNTY HEALTH DEPARTMENT

1-11-06

Date

P.O. BOX 2191

TOMS RIVER, N.J. 08754-2191

(732) 341-9700

No. 034613

BOARD OF HEALTH OF

Manchester

CERTIFICATE OF COMPLIANCE

Issued to

Arthur Holst

(Owner or Contractor)

THIS IS TO CERTIFY That the

INDIVIDUAL SEWAGE SYSTEM

Repaired

INDIVIDUAL WATER SYSTEM

Installed at Block No.

1-139

Lot No.

9-12

is in compliance with the

Application for Permit to Locate and Construct or

Alter Such Systems.

No.

034613

dated

1-11-06

The issuance of this certification shall not be construed as a guarantee that the system will function satisfactorily nor shall it in any way restrict the powers or responsibilities of the Board of Health in the enforcement of any law or ordinance relating to public health.

Finer

[Signature]

OCEAN COUNTY HEALTH DEPARTMENT
P.O. Box 2191, Sunset Avenue
Toms River, NJ 08754-2191

APPLICATION FOR A PERMIT TO INSTALL A SEPTIC SYSTEM
AND/OR A WATER SUPPLY SYSTEM

Approved
NO. 08754-2191
HEALTH DEPARTMENT
DATE 03/24/03
Fee Paid 034613

MUNICIPALITY <u>MANCHESTER</u>	(A) To construct both a septic & water supply system (B) To construct a water supply system (C) To replace or alter a water supply system (D) To construct or alter a septic system (E) To replace or repair a septic system	Type of Water System (A) Potable Non-Public (B) Potable Public Non-Community (C) Non-Potable (D) Public Community System
Comm. Code Official Use Only <u>15</u>		
Block <u>1-139</u>		
Lot(s) <u>942</u>		

(Current address of applicant required. All information must be completed.)

NAME OF APPLICANT Arthur Hobst PHONE NO. 349 5652
ADDRESS 608 7th Ave CITY Manahawick STATE NJ ZIP 08057
DIRECTIONS TO LOCATION Common weith to manahawick to 7th Ave

WELL APPLICATION

TYPE OF CASING: Material _____ Diameter _____ Grade _____ Thickness _____

TYPE AND METHODS OF SEALING JOINTS: Type _____ Method _____

METHOD OF INSTALLATION _____ If Rotary or Auger, size of hole _____

GROUTING MATERIAL _____ Depth & Method of grouting: Depth _____

Method _____

STORAGE TANK CAPACITY _____ Model No. _____

WELL DRILLER _____ Lic. # _____ Driller Phone # _____

DRILLER _____ (Signature) _____ State Well Permit # _____

NOTE: Copy of NJDEP "Permit to Drill Well" must be attached. Hose bibs are prohibited on non-potable well, unless such well is sampled. NJDEP's "Well Record" must be immediately submitted to the Health Department upon installation of well.

SEPTIC APPLICATION

TYPE OF BUILDING TO BE SERVED 1 Family Dwelling Unit. No. of Bedrooms 3

EXPANSION ATTIC, DEN OR REC. ROOM: Yes No If yes, calculate as additional bedroom _____

PERCOLATION TEST PERFORMED BY _____ Date _____ Phone _____

WEATHER CONDITIONS AT TIME OF TEST _____

ENGINEER'S SIGNATURE AND SEAL Brewn Sophie 360 mounroe Ave WHITING NJ 08754 732 819 1669

NOTE: All engineering data relating to soils, percolation & system design must be on engineer's drawing. Engineer's drawings must be signed & sealed by the engineer.


STATEMENT: Submit four (4) complete legible copies of applications, including engineer's & well driller's submissions. Final approval will only be granted after all inspections are completed, "as-built" drawings are submitted (where required) and satisfactory water analysis received, and all fees are paid. Permit is valid for one (1) year from date of issuance.

Supervisor (1) Checkpoint right prior to building.
(2) Check station for this approval
after initial system opening. PSA

BREWER SEPTIC & CONSTRUCTION

360 Monroe Avenue, Whiting NJ 08759

Phone 732-849-1669 Fax 732-849-1445

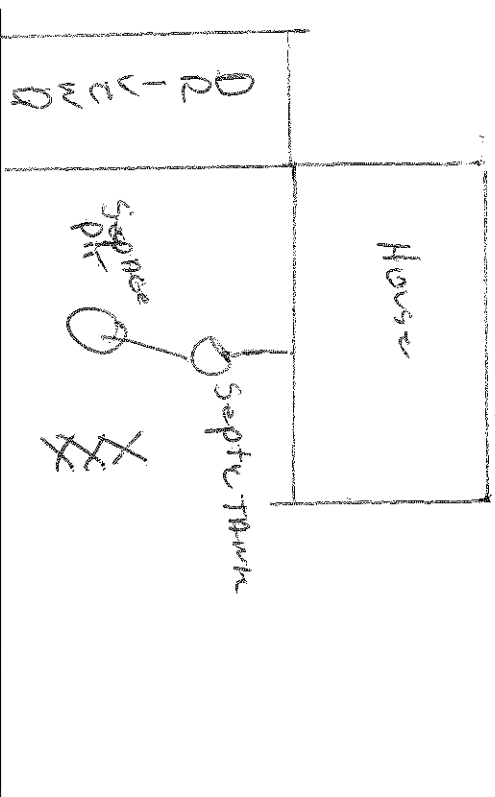

for
608 Seventh Avenue
Manchester, NJ 08757

Restone seepage pit

No well within 100ft.

Water table below 10 ft

XXX Will bury debris

Lot 9-12

Block 1-139