

OCEAN COUNTY
HEALTH DEPARTMENT

OCEAN COUNTY HEALTH DEPARTMENT

11/1/10

Date

P.O. BOX 2191

TOMS RIVER, N.J. 08754-2191

(732) 341-9700

No. 042628

BOARD OF HEALTH OF Lakewood

CERTIFICATE OF COMPLIANCE

Issued to Prince of Pools

(Owner or Contractor)

THIS IS TO CERTIFY That the

INDIVIDUAL SEWAGE SYSTEM Approved - Repair

INDIVIDUAL WATER SYSTEM N/A

Installed at Block No. 12.04

Lot No. 84 is in compliance with the

Application for Permit to Locate and Construct or

Alter Such Systems.

No. 042628 dated 10/29/10

The issuance of this certification shall not be construed as a guarantee that the system will function satisfactorily nor shall it in any way restrict the powers or responsibilities of the Board of Health in the enforcement of any law or ordinance relating to public health.

Final
Approval Rich T. Burr

H.D. 26

OCEAN COU
HEALTH DE
ENVIR HEA

2010 OCT 29

RECEI

OCEAN COUNTY HEALTH DEPARTMENT
P.O. Box 2191, Sunset Avenue
Toms River, NJ 08754-2191

OCEAN COUNTY
HEALTH DEPARTMENT

APPLICATION FOR A PERMIT TO INSTALL A SEPTIC SYSTEM
AND/OR A WATER SUPPLY SYSTEM

NO PERMANENT APPROVED
DATE 10/29/10
Official Use Only

Fee Paid 042628

<u>Lakewood</u> MUNICIPALITY	☐ (A) To construct both a septic & water supply system	Type of Water System
Comm. Code <u>15</u> Official Use Only	☐ (B) To construct a water supply system	☐ (A) Potable Non-Public
Block <u>12.04</u>	☐ (C) To replace or alter a water supply system	☐ (B) Potable Public Non-Community
Lot(s) <u>84</u>	☒ (D) To construct or alter a septic system	☐ (C) Non-Potable
	☐ (E) To replace or repair a septic system	☐ (D) Public Community System

(Current address of applicant required. All information must be completed.)

NAME OF APPLICANT Prince of Pools PHONE NO. 732 905 1400
ADDRESS 810 vally Dr CITY Lakewood STATE NJ ZIP
DIRECTIONS TO LOCATION off Central corner Neuse. on left

WELL APPLICATION

TYPE OF CASING: Material _____ Diameter _____ Grade _____ Thickness _____
TYPE AND METHODS OF SEALING JOINTS: Type _____ Method _____
METHOD OF INSTALLATION _____ If Rotary or Auger, size of hole _____
GROUTING MATERIAL _____ Depth & Method of grouting: Depth _____
Method _____
STORAGE TANK CAPACITY _____ Model No. _____
WELL DRILLER _____ Lic. # _____ Driller Phone # _____
(Print)
DRILLER _____ State Well Permit # _____
(Signature)

NOTE: Copy of NUDEP "Permit to Drill Well" must be attached. Hose bibs are prohibited on non-potable well, unless such well is sampled. NUDEP's "Well Record" must be immediately submitted to the Health Department upon installation of well.

SEPTIC APPLICATION

TYPE OF BUILDING TO BE SERVED Yes Dwelling Unit: No. of Bedrooms 3
EXPANSION ATTIC, DEN OR REC. ROOM: Yes No ✓ If yes, calculate as additional bedroom _____
PERCOLATION TEST PERFORMED BY Princ of Pools Date Oct 28 Phone 732 905 1400
WEATHER CONDITIONS AT TIME OF TEST good
ENGINEER'S SIGNATURE AND SEAL _____

NOTE: All engineering data relating to soils, percolation & system design must be on engineer's drawing. Engineer's drawings must be signed & sealed by the engineer.

STATEMENT: Submit four (4) complete legible copies of applications, including engineer's & well driller's submissions. Final approval will only be granted after all inspections are completed, "as-built" drawings are submitted (where required) and satisfactory water analysis received, and all fees are paid. Permit is valid for one (1) year from date of issuance.

SEPTIC STIPULATIONS: AS CHECKED BELOW


✓ INSPECTION REQUIRED PRIOR TO BACKFILL
✓ ANY DEVIATION FROM THIS APPROVED PLAN
WILL REQUIRE ENGINEERING DESIGN AND
SUBMITTAL OF NEW PLANS.

Block 12.04
Lot 84

810 Vally Dr Lakewood

PRINCE OF POOLS

RESTONE OLD SEPAGE
TANK WITH 1 1/2" WASHED
STONE

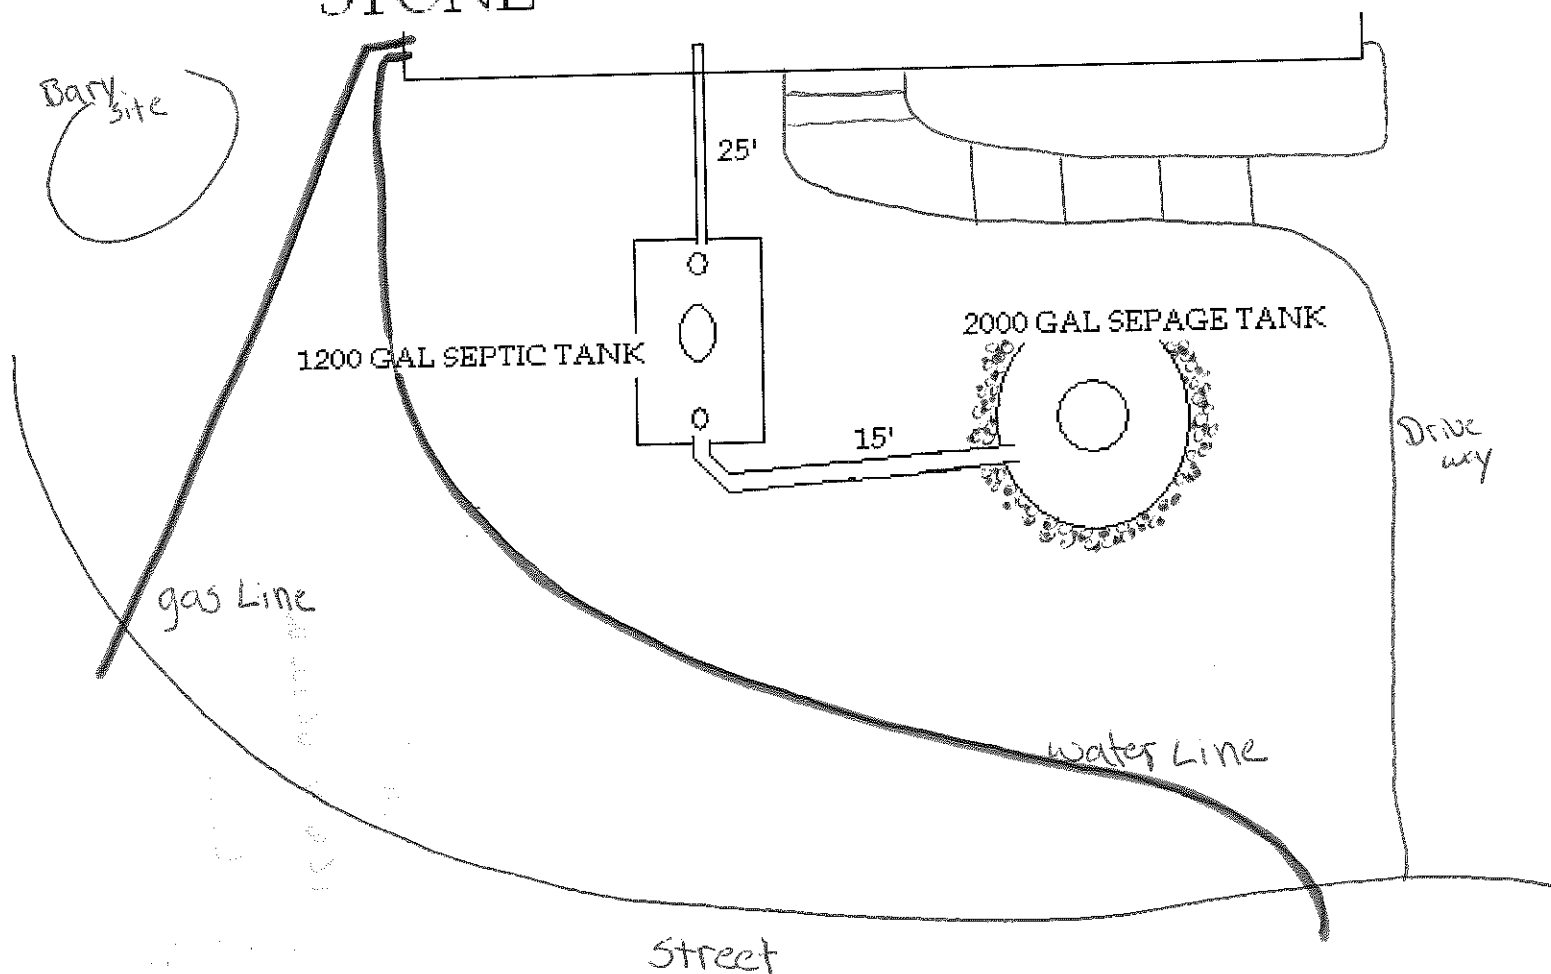

Paul Galli